

O.D.O.T. DISTRICT 2 SURVEY OFFICE (USE ONLY)

PERSONNEL

REFERENCE NO. 14 DE

SHEET 17 OF 63

NOTES RHOADES

DATE 4/20/15

ROUTE SR 65

H.C. WESTFALL

WEATHER WINDY

COUNTY WOOD

R.C. O'DONNELL

TEMP. 55°

TOWNSHIP WASHINGTON

LEU

SECTION 25

T 6 N R 9 E

TYPE MONUMENT P.K./WASHER



ON SURFACE - ~~BELOW~~ ON

LEFT - PAV'T - ~~RIGHT~~ 8.5'

1.0' TOLT EDGE PAVEMENT

S.L.M. 355+79.46

Grid: Northing: 653075.553 Easting: 1618576.342

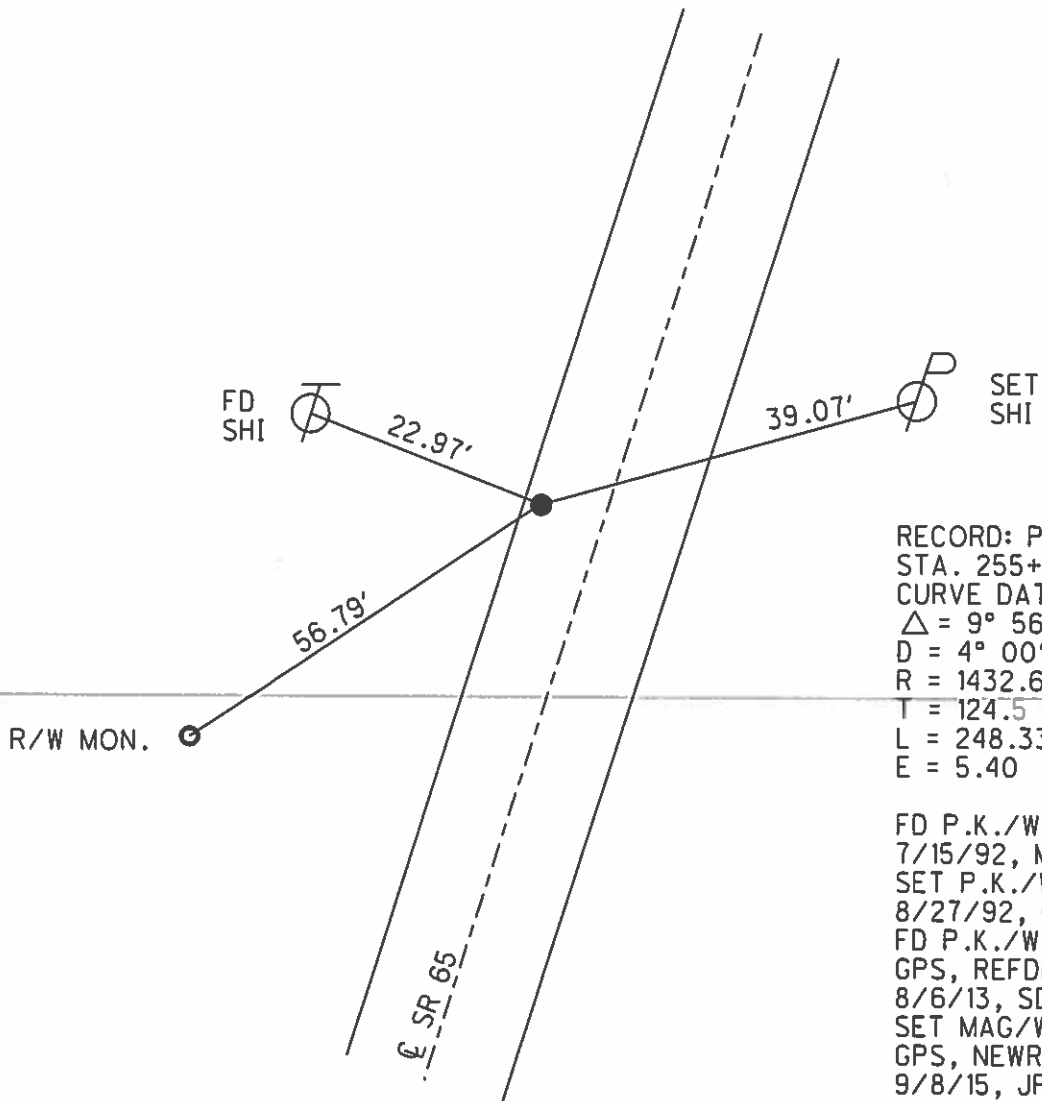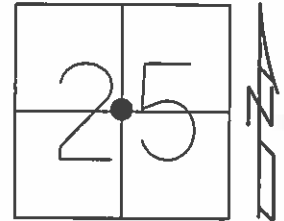

RECORD: P.I.
 STA. 255+52.9
 CURVE DATA 1926
 $\Delta = 9^\circ 56' RT$
 $D = 4^\circ 00'$
 $R = 1432.69$
 $T = 124.5$
 $L = 248.33$
 $E = 5.40$

FD P.K./WASHER
 7/15/92, MB
 SET P.K./WASHER
 8/27/92, CL
 FD P.K./WASHER
 GPS, REFDE14
 8/6/13, SDC
 SET MAG/WASHER
 GPS, NEWREFDE14
 9/8/15, JFO

O.D.O.T. DISTRICT 2 SURVEY OFFICE

PERSONNEL

REFERENCE NO. P.I. = 14-D SHEET 9 OF 34


NOTES BARNHISEL
 H.C. CURTIS
 R.C. RomeTo
Loehrke

DATE 5/14/04
7-15-92
 WEATHER RAIN
 TEMP. +70°

ROUTE 65
 COUNTY Wood
 TOWNSHIP WASHINGTON
 SECTION 25


P.C. P.I. P.T. Fd. P.K.'s / WASHERS T 6 N R 9 E

TYPE MONUMENT PK's + WASHER'S
 ON SURFACE - BELOW yes yes yes
 LEFT- & PAV'T. - RIGHT 1.8 8.5 1.8
- TO LT EDGE PAVEMENT 8.0 1.0 7.8
 S.L.M. 353+46 354+70 355+94

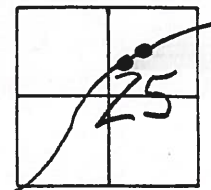

RECORD:
 CURVE DATA 1926
 PI = 255+52.9
 A = 9°-56' Rt.
 D = 4°-00'
 R = 1432.69
 T = 124.5
 L = 248.33
 E = 5.40

RECORD:
 P.T. = 256+76.73
 SET PK 1972

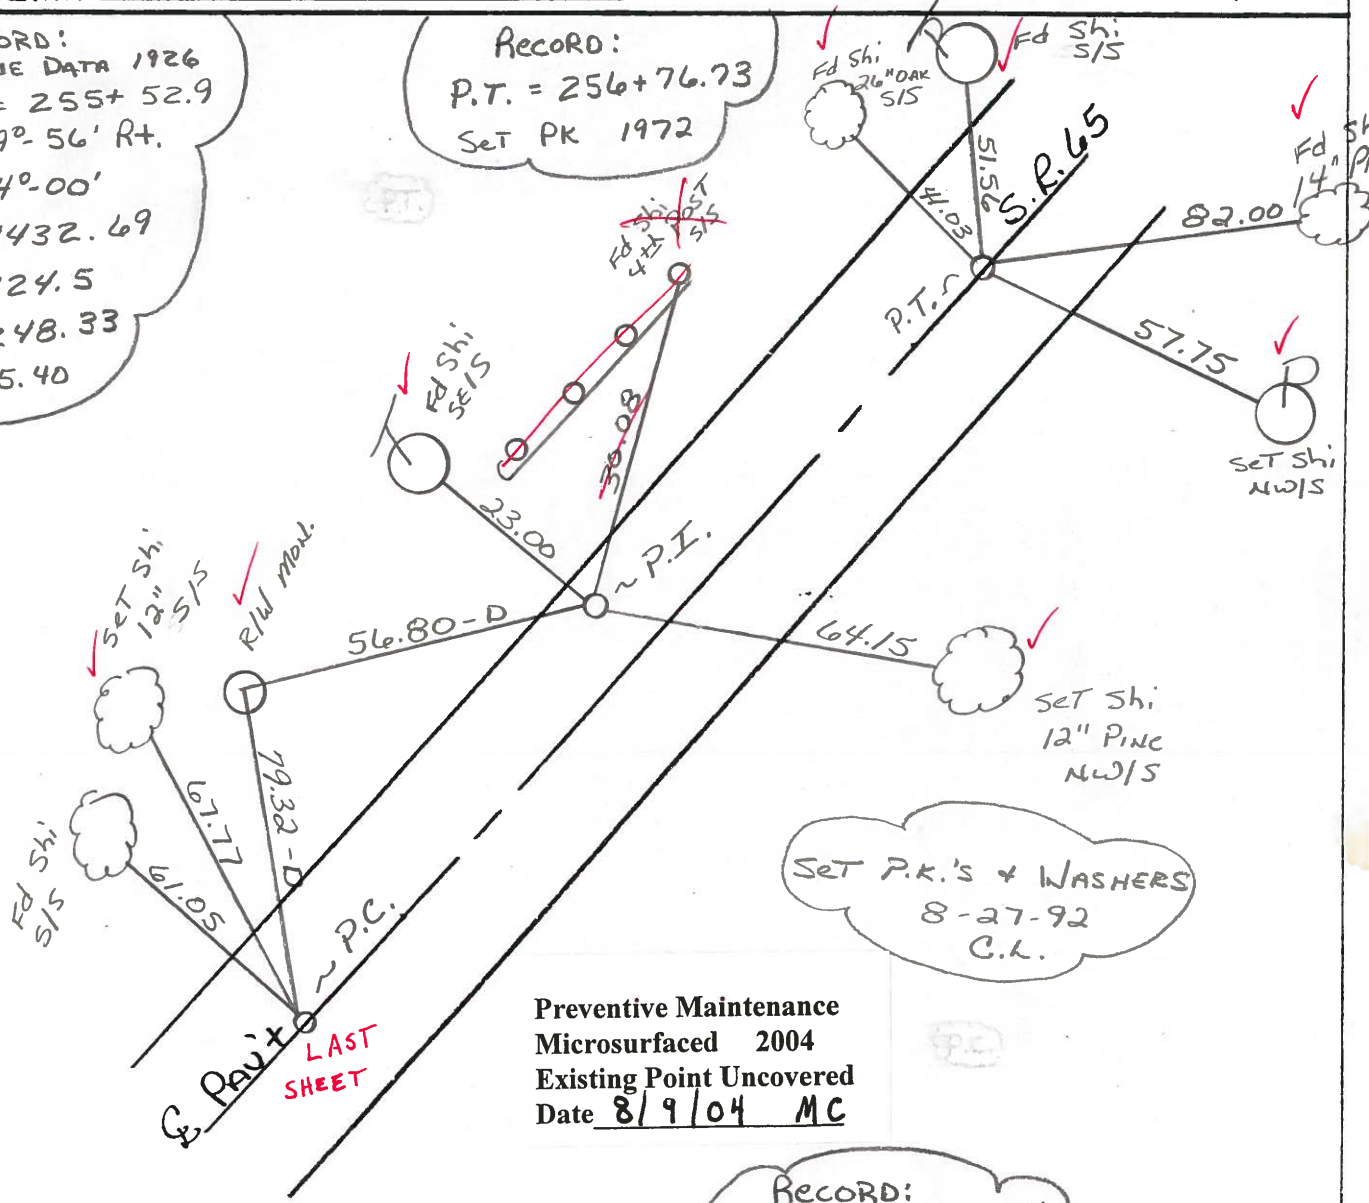

SET P.K.'s + WASHERS
 8-27-92
 C.L.

Preventive Maintenance
 Microsurfaced 2004
 Existing Point Uncovered
 Date 8/9/04 MC

RECORD:
 P.C. = 254+28.4
 SET PK 1972

LAST SHEET

County WOOD S.R. 65

Date 4-9-84

Township WASHINGTON

Weather CLEAR

Section 25

Temp. 45°

T6N, R9E

Personnel HOFFMAN

14-DE


LOEHRKE

14-DF

HOUSEHOLDER H.C.

14-DD

BARNHISEL R.C.

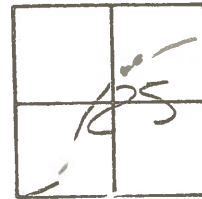

CURVE DATA 1926

P.I. = 255+52.9

Δ = 9°-56' RT.

D = 4°-00'

R = 1432.69

T = 124.5'

L = 248.33

E = 5.40

SET PK./WASHER

10-4-84
S.W.H.

Record!
P.T. 256+76.73
Set P.K. 1972

Fd P.K. ON SURFACE
0.9' LT. of & PAUT
8.4' TO LT. EP.
10.0' TO RT. EP
S.M. = 355+94

Set shi 26" OAK

Set shi

41.01


31.75

82.09

17.11

Set shi 14"

Set shi MAIL BOX POST 19496 Riv

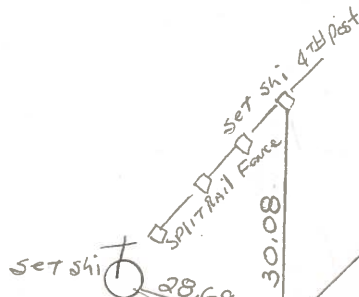

DID NOT RESET

Fd small R.R. SET @ surface. OR IN UNDERGROUND

P.I. Fd R.R. SPK 2 1/2' Below surface
6.5' LT. of & PAUT
1.5' TO LT. EP.
S.M. = 354+70

Record!
P.C. STA 254+28.4
Set P.K. 1972

Fd P.K. @ SURFACE
0.8' LT. of & PAUT
8.5' TO LT. EP.
11.2' TO RT. EP
S.M. = 353+46

SET PK./WASHER
10-4-84
S.W.H.

