

O.D.O.T. DISTRICT 2 SURVEY OFFICE (USE ONLY)

PERSONNEL

REFERENCE NO. 14 DF

SHEET 18 OF 63

NOTES RHOADES

DATE 4/20/15

ROUTE SR 65

H.C. WESTFALL

WEATHER WINDY

COUNTY WOOD

R.C. O'DONNELL

TEMP. 55°

TOWNSHIP WASHINGTON

LEU

SECTION 25

T 6 N R 9 E

TYPE MONUMENT P.K./WASHER


ON SURFACE - ~~BELOW~~ ON

LEFT - PAV'T - ~~RIGHT~~ 1.8'

7.8' TO ~~LT~~ EDGE PAVEMENT


S.L.M. 357+03.50

Grid: Northing: 653188.357 Easting: 1618629.286

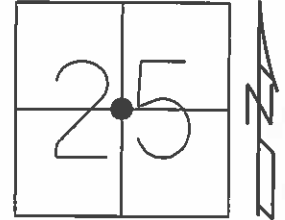

RECORD: P.T.  
 STA. 256+76.73  
 SET P.K. NAIL, 1972.  
 SET P.K./WASHER  
 8/27/92, CL

FD P.K./WASHER  
 7/15/92  
 SET P.K./WASHER  
 5/14/04, MB  
 FD P.K./WASHER  
 GPS, REFDF14  
 8/6/13, SDC  
 SET MAG/WASHER  
 GPS, NEWREFDF14  
 9/8/15, JFO

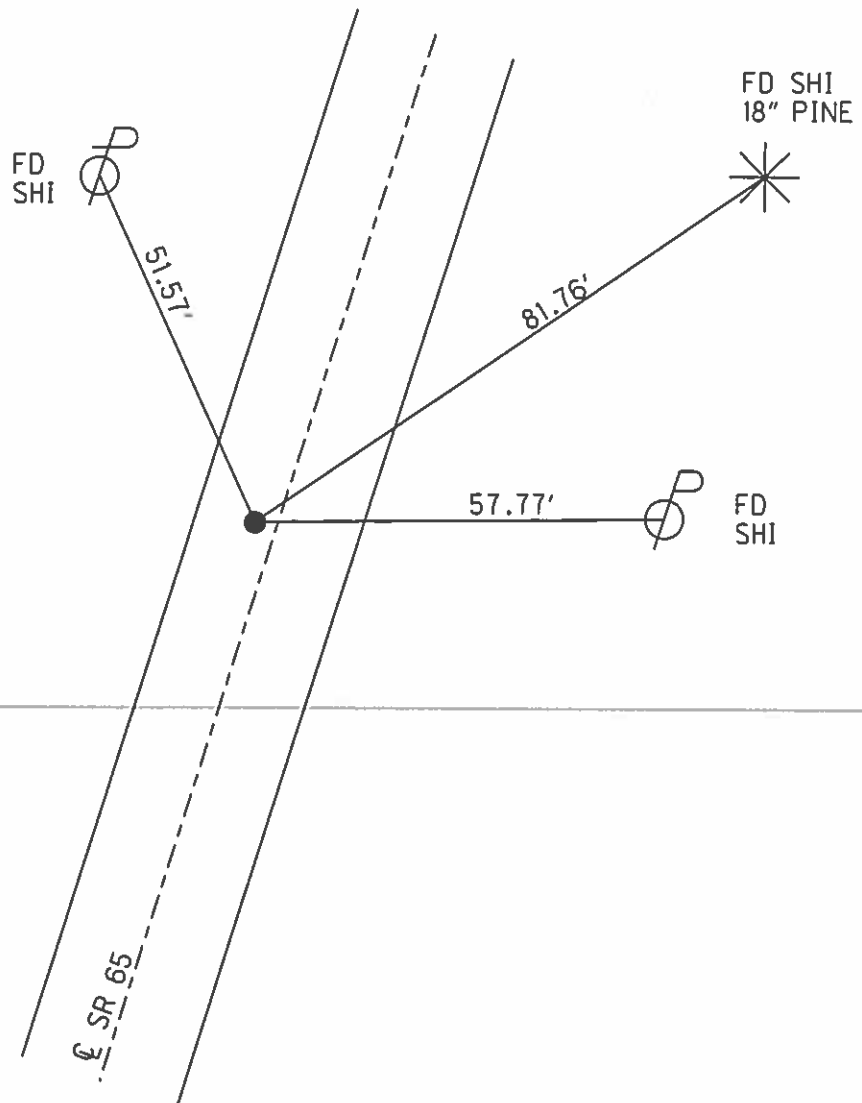

# O.D.O.T. DISTRICT 2 SURVEY OFFICE

PERSONNEL

REFERENCE NO. P.I. = 14-D SHEET 9 OF 34


NOTES BARNHISEL  
 H.C. CURTIS  
 R.C. RomeTo  
Loehrke

DATE 5/14/04  
7-15-92  
 WEATHER RAIN  
 TEMP. +70°

ROUTE 65  
 COUNTY WOOD  
 TOWNSHIP WASHINGTON  
 SECTION 25


P.C. P.I. P.T. Fd. P.K.'s / WASHERS T 6 N R 9 E

TYPE MONUMENT PK'S + WASHER'S  
 ON SURFACE - BELOW yes yes yes  
 LEFT- & PAV'T. - RIGHT 1.8 8.5 1.8  
 - TO LT EDGE PAVEMENT 8.0 1.0 7.8  
 S.L.M. 353+46 354+70 355+94

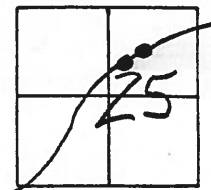

RECORD:  
 CURVE DATA 1926  
 PI = 255+52.9  
 A = 9°-56' Rt.  
 D = 4°-00'  
 R = 1432.69  
 T = 124.5  
 L = 248.33  
 E = 5.40

RECORD:  
 P.T. = 256+76.73  
 SET PK 1972

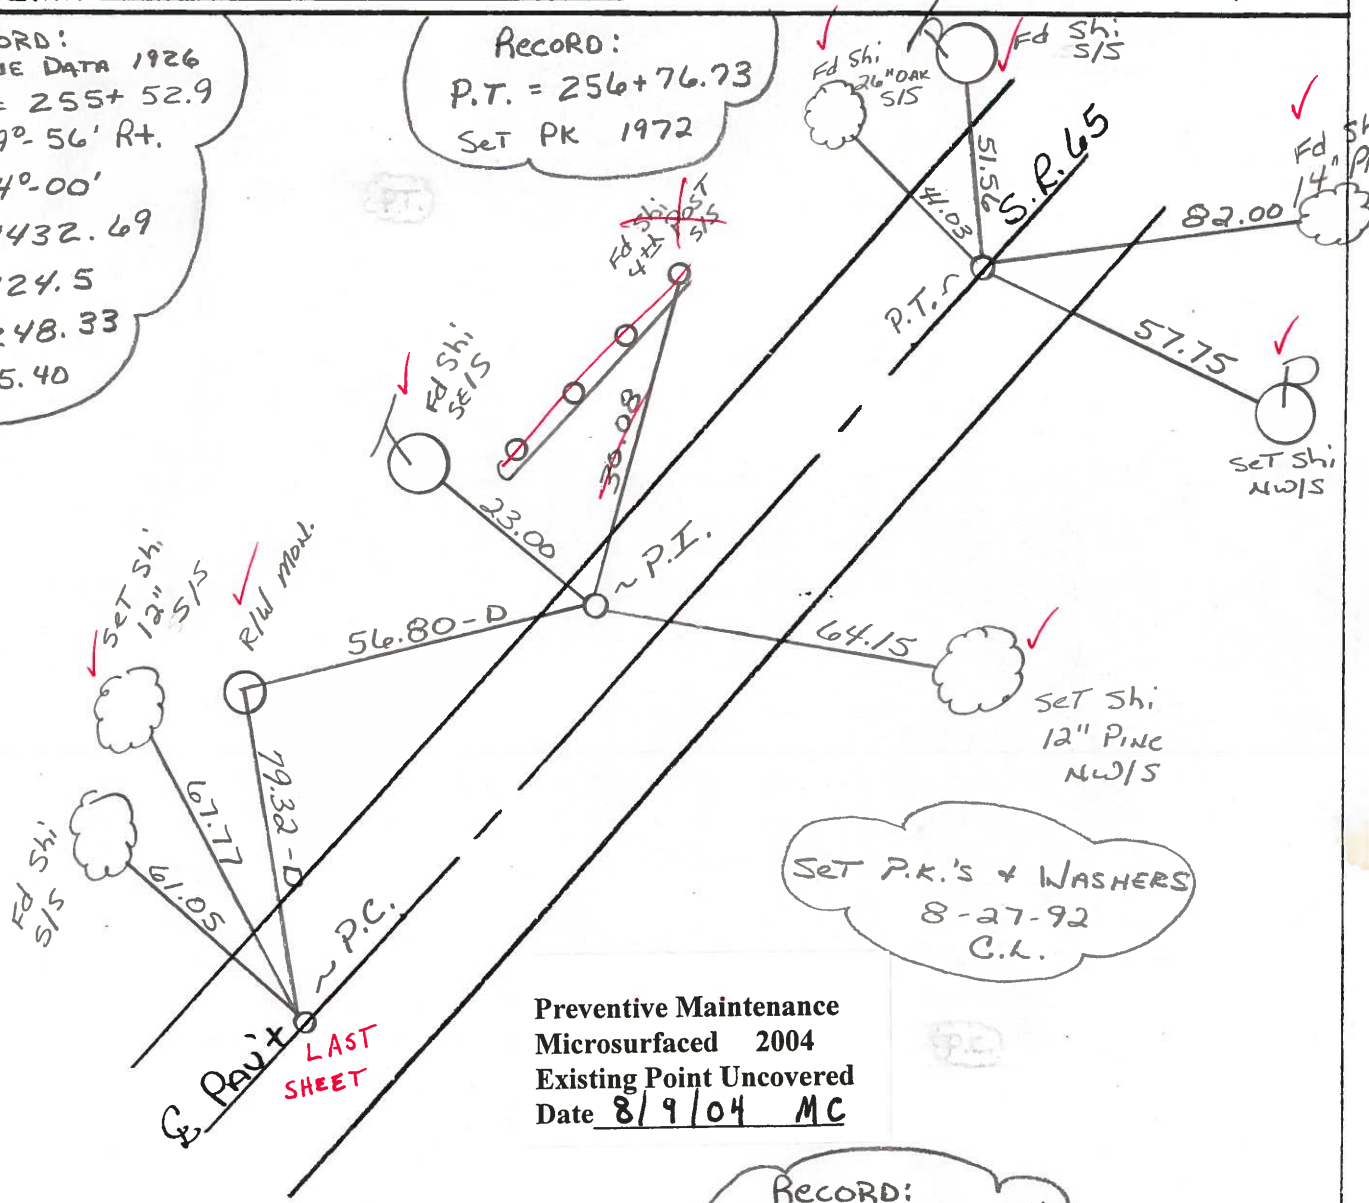

SET P.K.'S + WASHERS  
 8-27-92  
 C.L.

Preventive Maintenance  
 Microsurfaced 2004  
 Existing Point Uncovered  
 Date 8/9/04 MC

RECORD:  
 P.C. = 254+28.4  
 SET PK 1972

LAST SHEET

County WOOD S.R. 65

Date 4-9-84

Township WASHINGTON

Weather CLEAR

Section 25

Temp. 45°

T6N, R9E

Personnel HOFFMAN

14-DE


LOEHRKE

14-DF

HOUSEHOLDER H.C.

14-DD

BARNHISEL R.C.

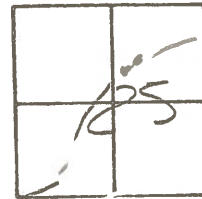

CURVE DATA 1926

P.I. = 255+52.9

Δ = 9°-56' RT.

D = 4°-00'

R = 1432.69

T = 124.5'

L = 248.33

E = 5.40

SET PK./WASHER

10-4-84  
S.W.H.

Record!  
P.T. 256+76.73  
Set P.K. 1972

Fd P.K. ON SURFACE  
0.9' LT. of & PAUT  
8.4' TO LT. EP.  
10.0' TO RT. EP  
S.M. = 355+94

Set shi 26" OAK

Set shi

41.01


31.75

82.09

17.11

Set shi 14"

Set shi MAIL BOX POST 19496 Riv

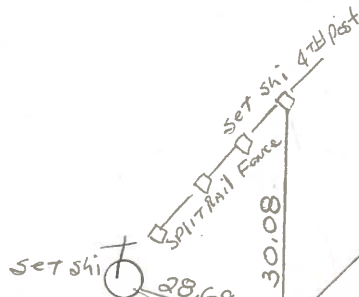

DID NOT RESET




Fd small R.R. SET @ surface. OR IN UNDERGROUND

P.I. Fd R.R. SPK 2 1/2' Below surface  
6.5' LT. of & PAUT  
1.5' TO LT. EP.  
S.M. = 354+70

Record!  
P.C. STA 254+28.4  
Set P.K. 1972

Fd P.K. @ SURFACE  
0.8' LT of & PAUT  
8.5' TO LT. EP.  
11.2' TO RT. EP  
S.M. = 353+46

SET PK./WASHER  
10-4-84  
S.W.H.

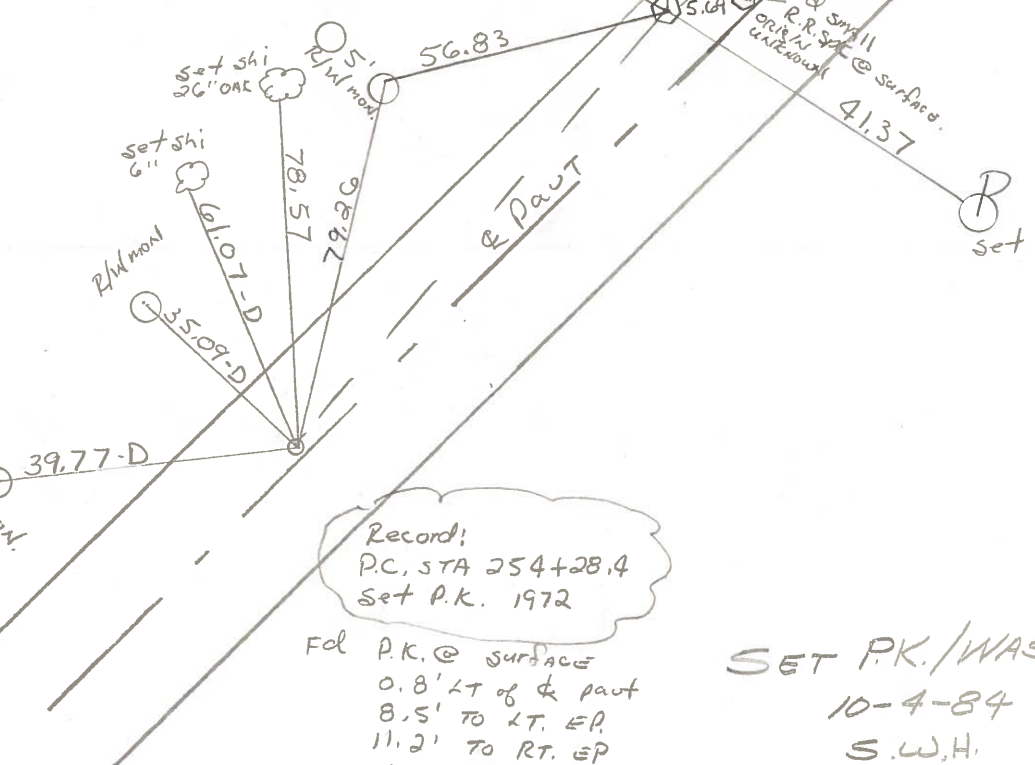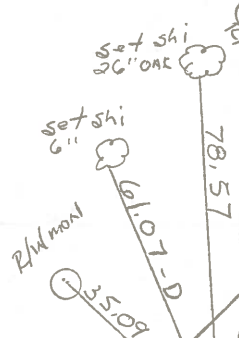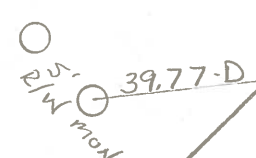


PERSONNEL TITLE PERSONNEL TITLE  
BURNSIDE \_\_\_\_\_  
SMITH \_\_\_\_\_

COUNTY WOOD DATE 10-27-72

S. R. 65 WEATHER CLEAR

SEC. WASHINGTON TWP TEMP. +42°

DESCRIPTION ESTABLISH & REF. CONTROL POINTS JOB NO. \_\_\_\_\_

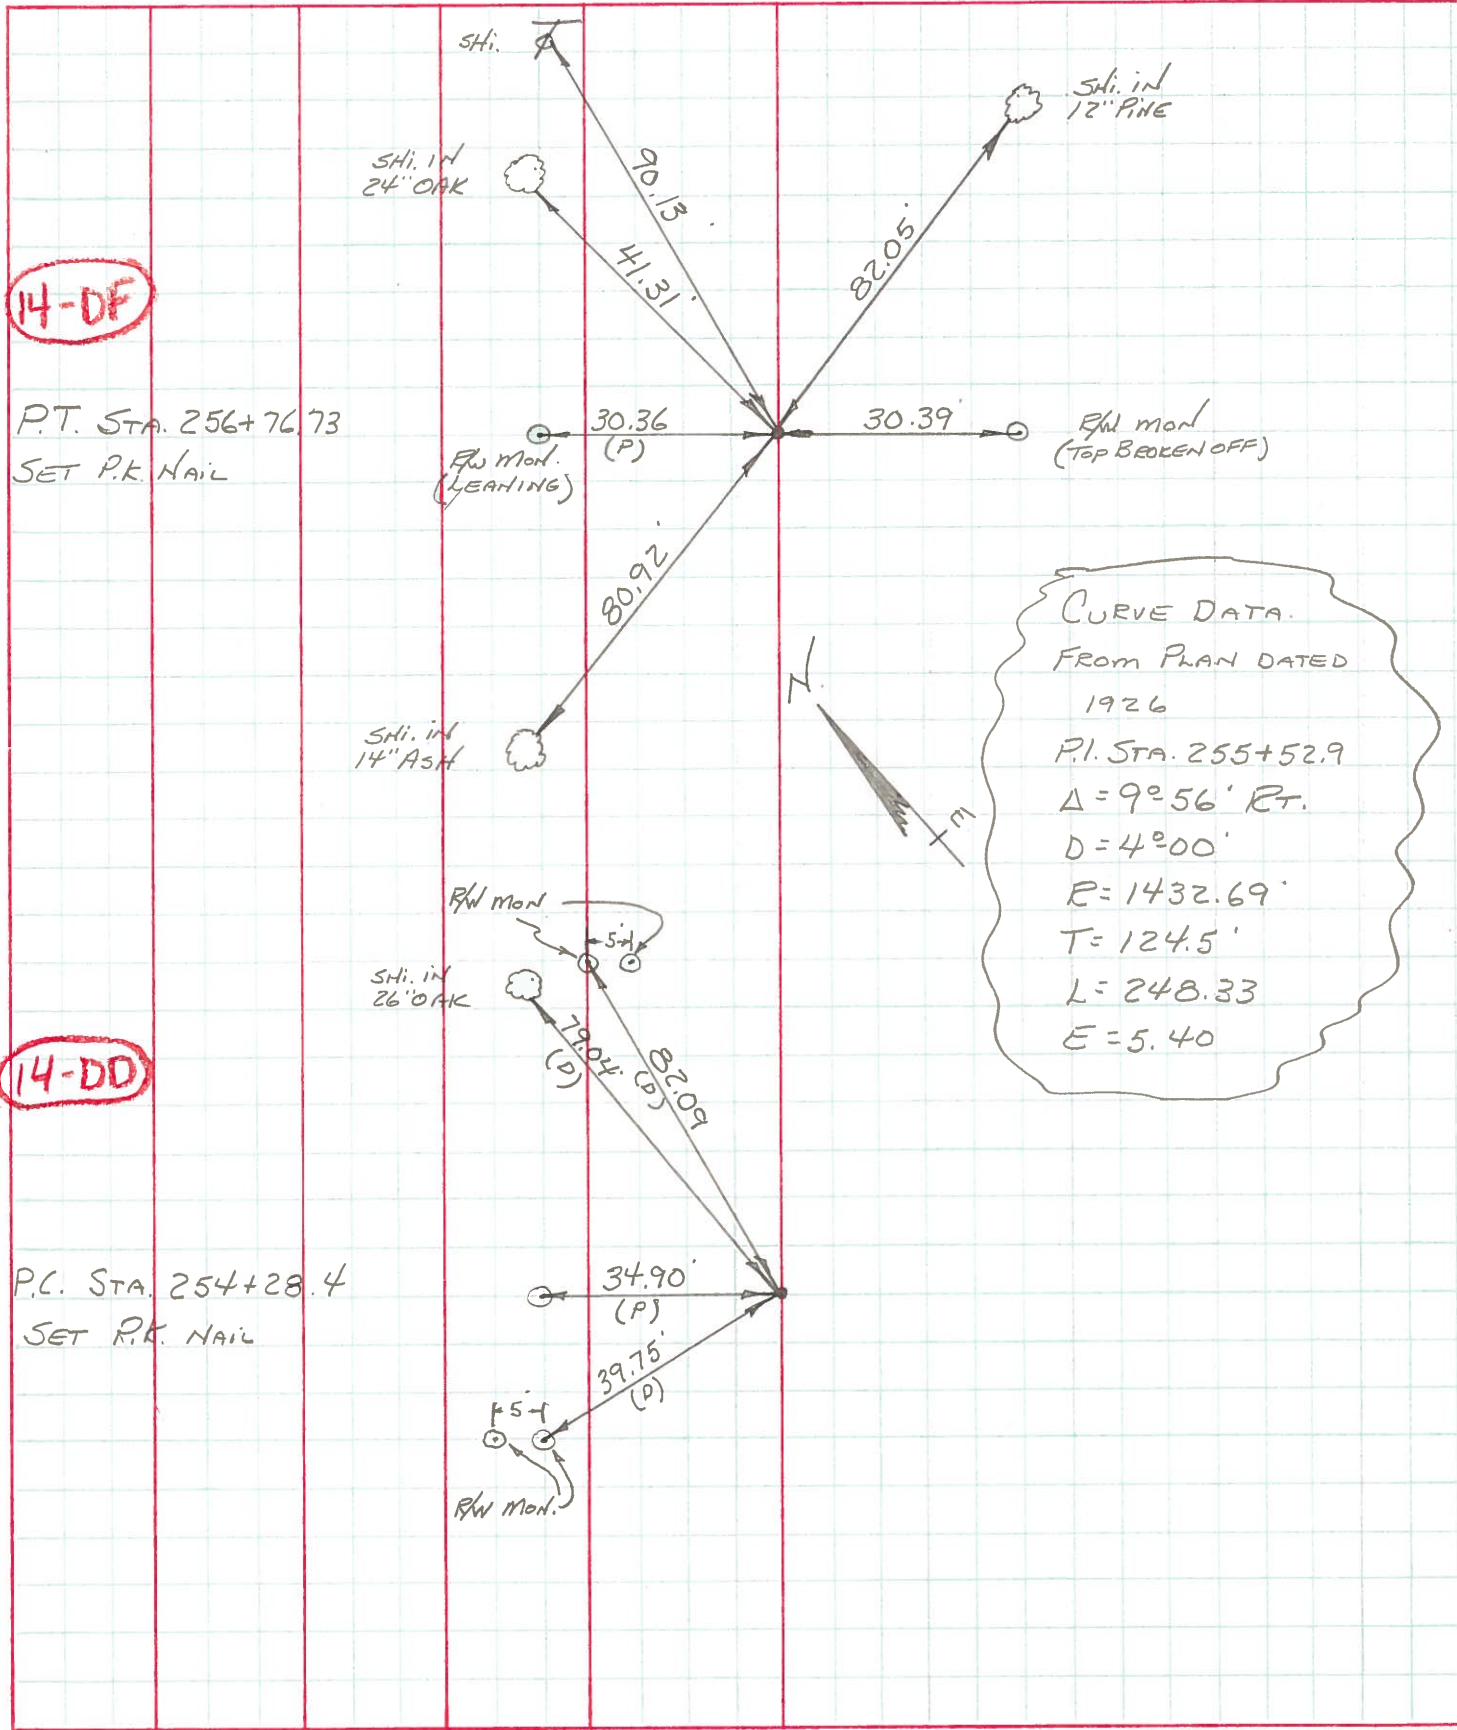

**14-DF**

P.T. STA. 256+76.73  
 SET P.K. NAIL

**14-DD**

P.C. STA. 254+28.4  
 SET P.K. NAIL

CURVE DATA.  
 FROM PLAN DATED  
 1926  
 P.I. STA. 255+52.9  
 $\Delta = 9^{\circ}56'$  RT.  
 $D = 4^{\circ}00'$   
 $E = 1432.69'$   
 $T = 124.5'$   
 $L = 248.33$   
 $E = 5.40$