


O.D.O.T. DISTRICT 2 SURVEY OFFICE (USE ONLY)


PERSONNEL	REFERENCE NO. <u>14 E</u>	SHEET <u>19</u> OF <u>63</u>
NOTES	RHOADES	DATE <u>4/20/15</u>
H.C.	WESTFALL	WEATHER <u>WINDY</u>
R.C.	O'DONNELL	TEMP. <u>55°</u>
	LEU	
		ROUTE <u>SR 65</u>
		COUNTY <u>WOOD</u>
		TOWNSHIP <u>WASHINGTON</u>
		SECTION <u>25</u>
		T <u>6</u> N R <u>9</u> E

TYPE MONUMENT SM.R.R.SPIKE  
~~ON SURFACE~~ - BELOW 0.3'  
 LEFT - PAV'T - ~~RIGHT~~ 0.8'  
 - TOLT EDGE PAVEMENT  
 S.L.M. 361+55.29

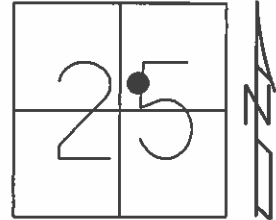

Grid: Northing: 653075.553 Easting: 1618576.342

RECORD: P.I.  
 CURVE DATA 1926  
 STA. 262+50.0  
 $\Delta = 7^\circ 13' RT$   
 $D = 3^\circ 00'$   
 $R = 1910.08$   
 $T = 120.74$   
 $L = 240.55$

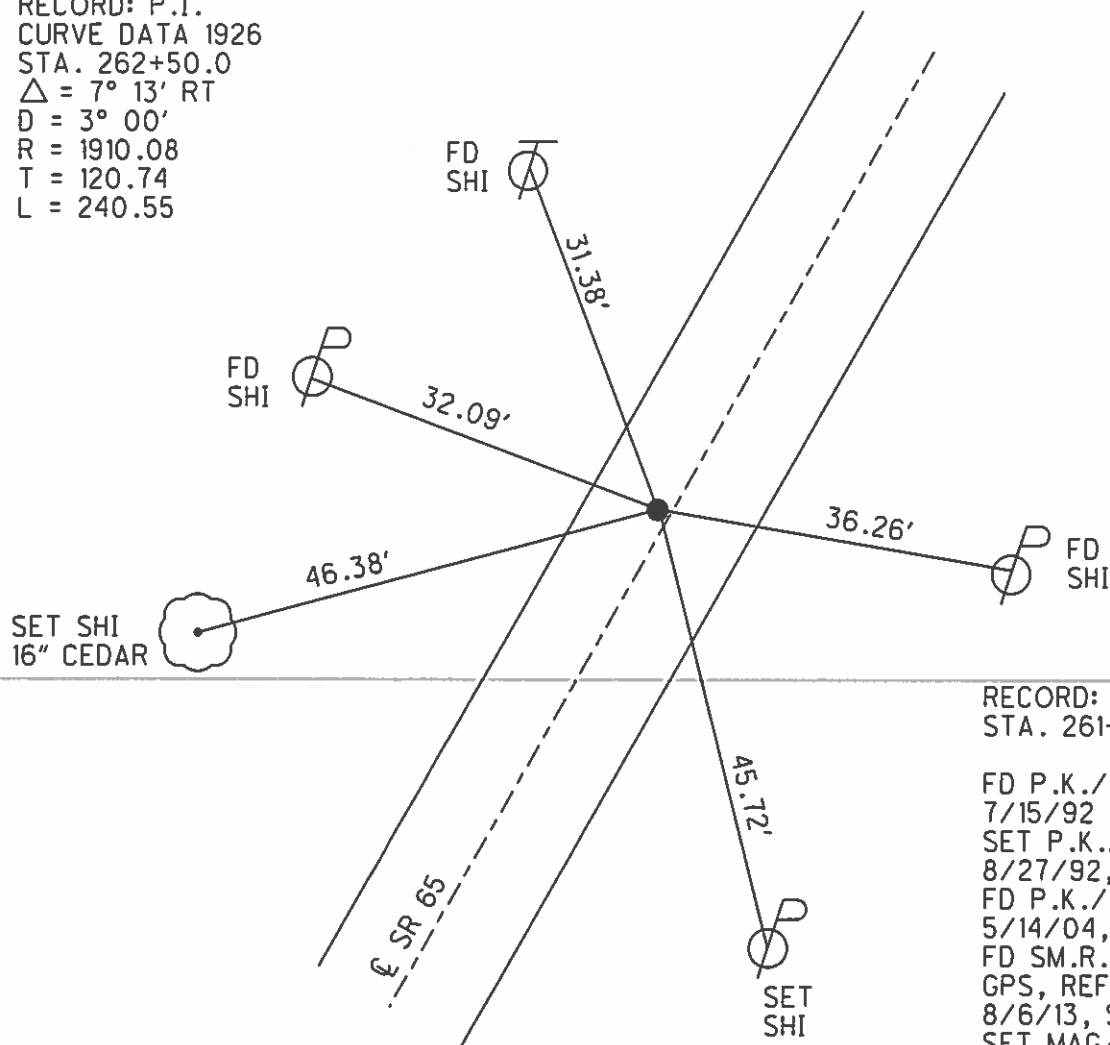

RECORD: P.C.  
 STA. 261+29.26  
 FD P.K./WASHER  
 7/15/92  
 SET P.K./WASHER  
 8/27/92, MB  
 FD P.K./WASHER  
 5/14/04, MC  
 FD SM.R.R.SPIKE  
 GPS, REFE14  
 8/6/13, SDC  
 SET MAG/WASHER  
 GPS, NEWREFE14  
 9/8/15, JFO

# O.D.O.T. DISTRICT 2 SURVEY OFFICE

PERSONNEL

NOTES BARNHISEL  
 H.C. CURTIS  
 R.C. ROMETO  
Loehrke


REFERENCE NO. P.I. = 14-E SHEET 10 OF 34

DATE 5/14/04  
~~7-15-92~~  
 WEATHER RAIN  
 TEMP. +70°

ROUTE 65  
 COUNTY WOOD  
 TOWNSHIP WASHINGTON  
 SECTION 25  
 T. 6 N. R. 9 E.


Fd. P.K.'S/WASHERS @ SURFACE

	PC.	P.T.
TYPE MONUMENT	Sm RR Spk	Sm RR Spk
ON SURFACE - <del>BELOW</del>	YES	YES
LEFT- & PAV'T. - <del>RIGHT</del>	0.8	1.7
- TO LT EDGE PAVEMENT	9.0	8.3
S.L.M.	360+44	362+86

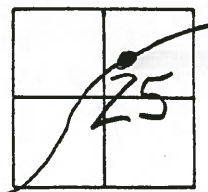

Record:  
 CURVE DATA 1926 Plan  
 PI = 262+50.0  
 A = 7°-13' RT  
 D = 3°-00'  
 R = 1910.08  
 T = 120.74  
 L = 240.55

Record:  
 P.T. = 263+69.81  
 Set PK 1972

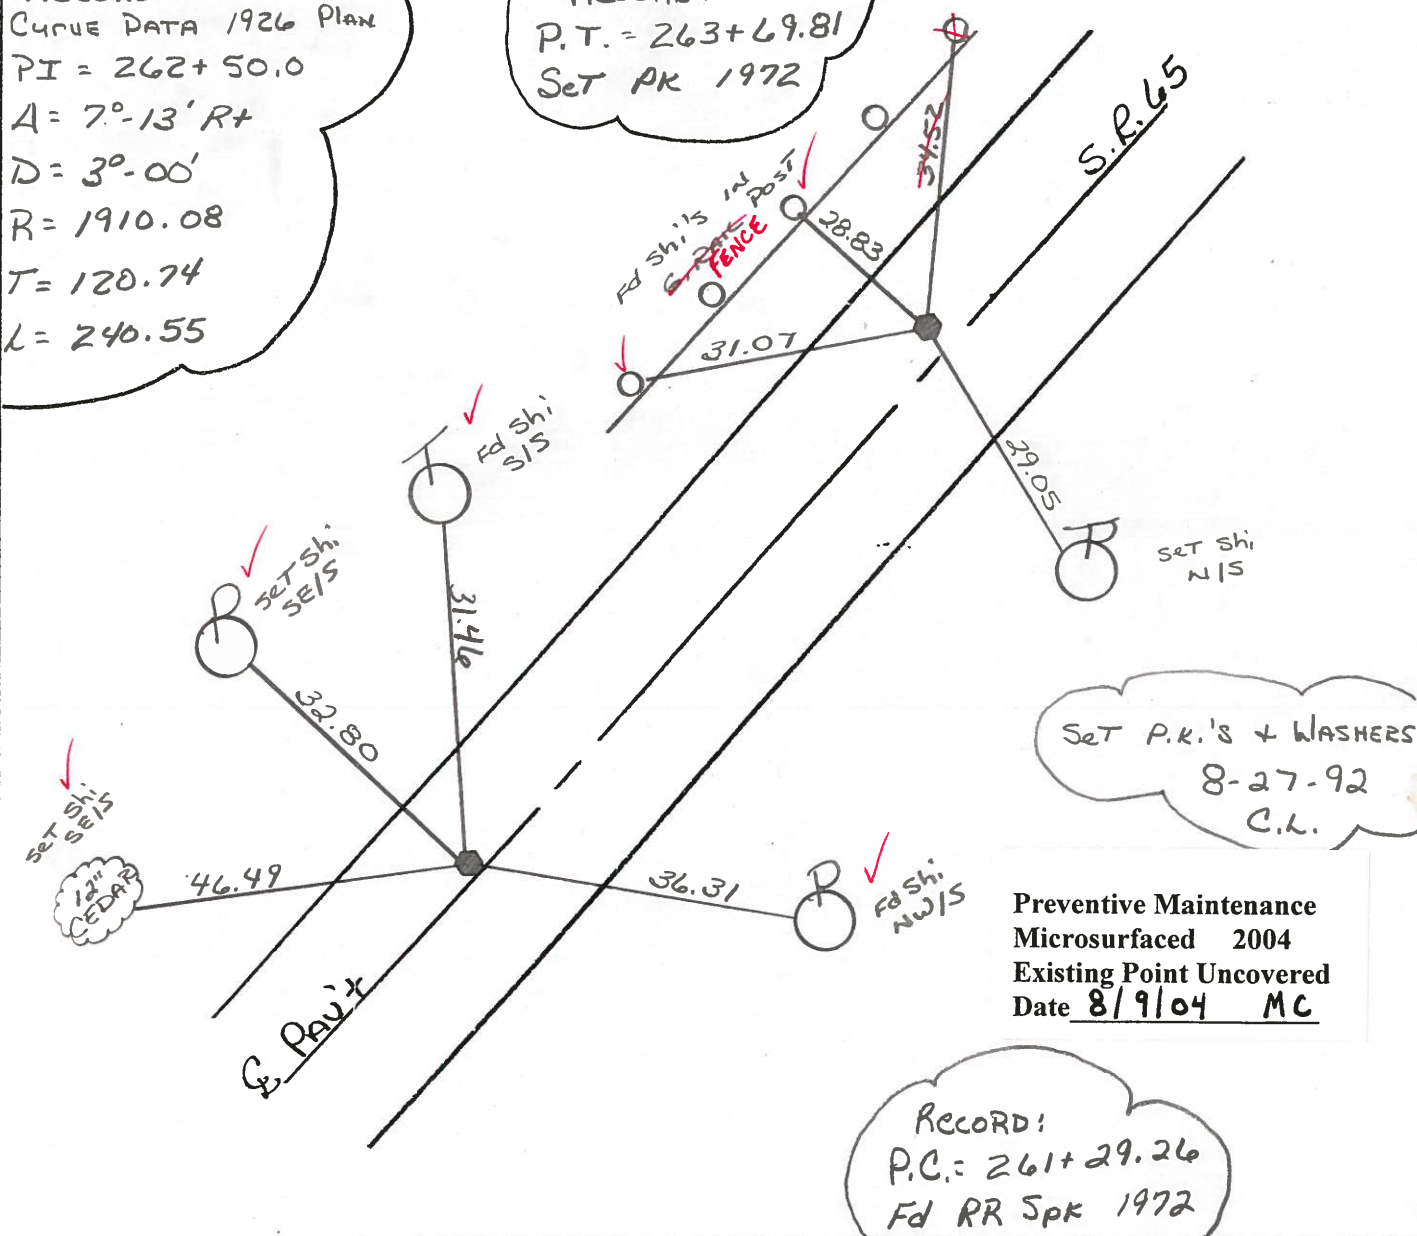

Set P.K.'S + WASHERS  
 8-27-92  
 C.L.

Preventive Maintenance  
 Microsurfaced 2004  
 Existing Point Uncovered  
 Date 8/9/04 MC

Record:  
 P.C. = 261+29.26  
 Fd RR Spk 1972

S.M.T. 1

O.D.O.T. DISTRICT 2 SURVEY OFFICE

SHEET 10 OF 91

County WOOD S.R. 65

Date 4-9-84

Township WASHINGTON


Weather Clear

Section 25

Temp. +45°

T6N, R9E

Personnel HOFFMAN

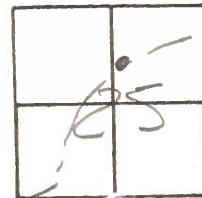

14-E

LOEHRKE

14-EF

HOUSEHOLDER H.C.



BARNHISEL R.C.

Record:  
P.C. 261+29.26  
Fcl R.R. spike 1972

Record:  
P.T. 263+69.81  
Set R.R. 1972

Fcl small spk 2" below Sur  
oil & paint  
9.2' to Lt. EP.  
10.5' to Rt. EP  
S.L.M. 362+86

Fcl R.R. spk 3" below surface  
oil & paint  
9.2' to Lt. EP.  
9.5' to Rt. EP.  
S.L.M. = 360+46

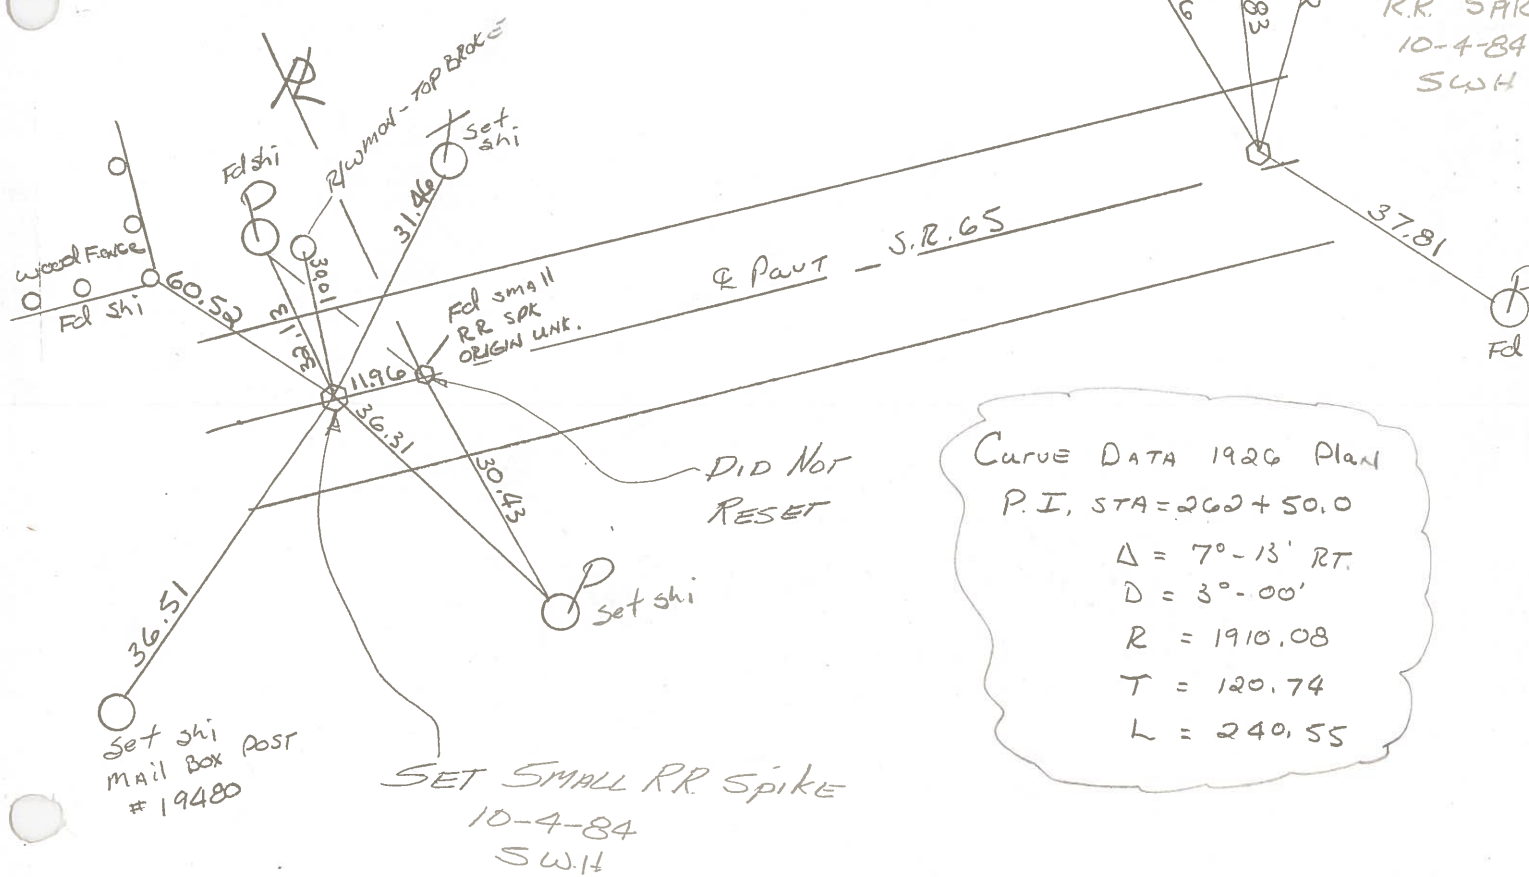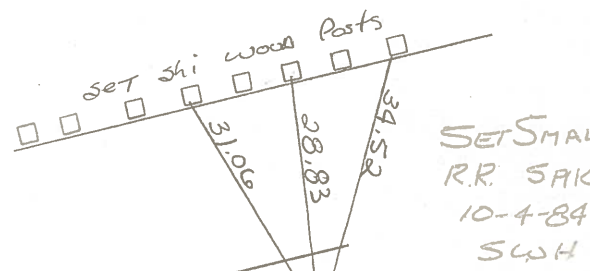

CURVE DATA 1926 PLAN  
P.I, STA=262+50.0  
 $\Delta = 7^{\circ}-13'$  RT.  
D = 3°-00'  
R = 1910.08  
T = 120.74  
L = 240.55

PERSONNEL TITLE PERSONNEL TITLE  
 BURNSIDE \_\_\_\_\_  
 SMITH \_\_\_\_\_

COUNTY Wood DATE 10-27-72

S. R. 65 WEATHER CLEAR

SEC. WASHINGTON TWP TEMP. +42°

DESCRIPTION ESTABLISH & REF. & CONTROL POINTS JOB NO.

