

O.D.O.T. DISTRICT 2 SURVEY OFFICE (USE ONLY)

PERSONNEL

REFERENCE NO 14 EF

SHEET 20 OF 63

NOTES RHOADES

DATE 4/20/15

ROUTE SR 65

H.C. WESTFALL

WEATHER WINDY

COUNTY WOOD

R.C. O'DONNELL

TEMP. 55°

TOWNSHIP WASHINGTON

LEU

SECTION 25

T 6 N R 9 E

TYPE MONUMENT P.K.SHANK


ON SURFACE - ~~BELOW~~ ON

LEFT - PAV'T - ~~RIGHT~~ 1.7'


- TOLT EDGE PAVEMENT

S.L.M. 363+95.14

Grid: Northing: 653807.405 Easting: 1618936.757

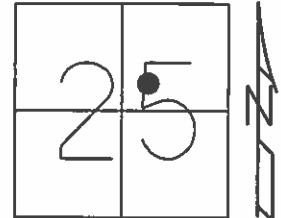

RECORD: P.I.
 CURVE DATA 1926
 STA. 262+50.0
 $\Delta = 7^\circ 13' RT$
 $D = 3^\circ 00'$
 $R = 1910.08$
 $T = 120.74$
 $L = 240.55$

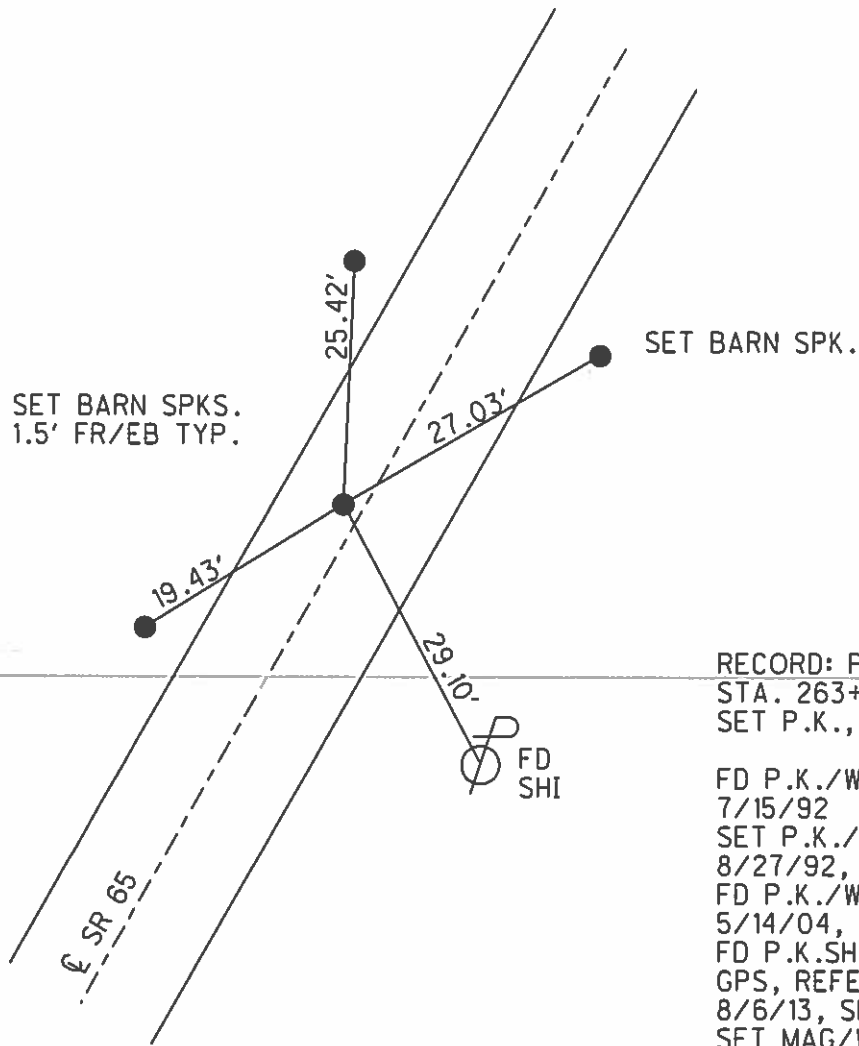

RECORD: P.T.
 STA. 263+69.81
 SET P.K., 1972

FD P.K./WASHER
 7/15/92
 SET P.K./WASHER
 8/27/92, MB
 FD P.K./WASHER
 5/14/04, MC
 FD P.K.SHANK
 GPS, REFEF14
 8/6/13, SDC
 SET MAG/WASHER
 GPS, NEWREFEF14
 9/8/15, JFO

O.D.O.T. DISTRICT 2 SURVEY OFFICE

PERSONNEL

NOTES BARNHISEL
 H.C. CURTIS
 R.C. ROMETO
LOEHRKE


REFERENCE NO. P.I.=14-E SHEET 10 OF 36

DATE 5/14/04
~~7-15-92~~
 WEATHER RAIN
 TEMP. +70°

ROUTE 65
 COUNTY WOOD
 TOWNSHIP WASHINGTON
 SECTION 25
 T. 6 N. R. 9 E.

Fd. P.K.'S/WASHERS @ SURFACE

	P.C.	P.T.
TYPE MONUMENT	<u>Sm RR Spk</u>	<u>Sm RR Spk</u>
ON SURFACE - BELOW	<u>YES</u>	<u>YES</u>
LEFT- & PAV'T. - RIGHT	<u>0.8</u>	<u>1.7</u>
- TO LT EDGE PAVEMENT	<u>9.0</u>	<u>8.3</u>
S.L.M.	<u>360+44</u>	<u>362+86</u>

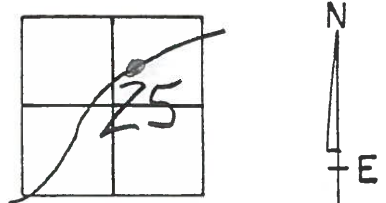


RECORD:
 CURVE DATA 1926 PLAN
 PI = 262+50.0
 A = 7°-13' R+
 D = 3°-00'
 R = 1910.08
 T = 120.74
 L = 240.55

RECORD:
 P.T. = 263+69.81
 SET PK 1972

SET P.K.'S + WASHERS
 8-27-92
 C.L.

Preventive Maintenance
 Microsurfaced 2004
 Existing Point Uncovered
 Date 8/9/04 MC

RECORD:
 P.C. = 261+29.26
 Fd RR Spk 1972

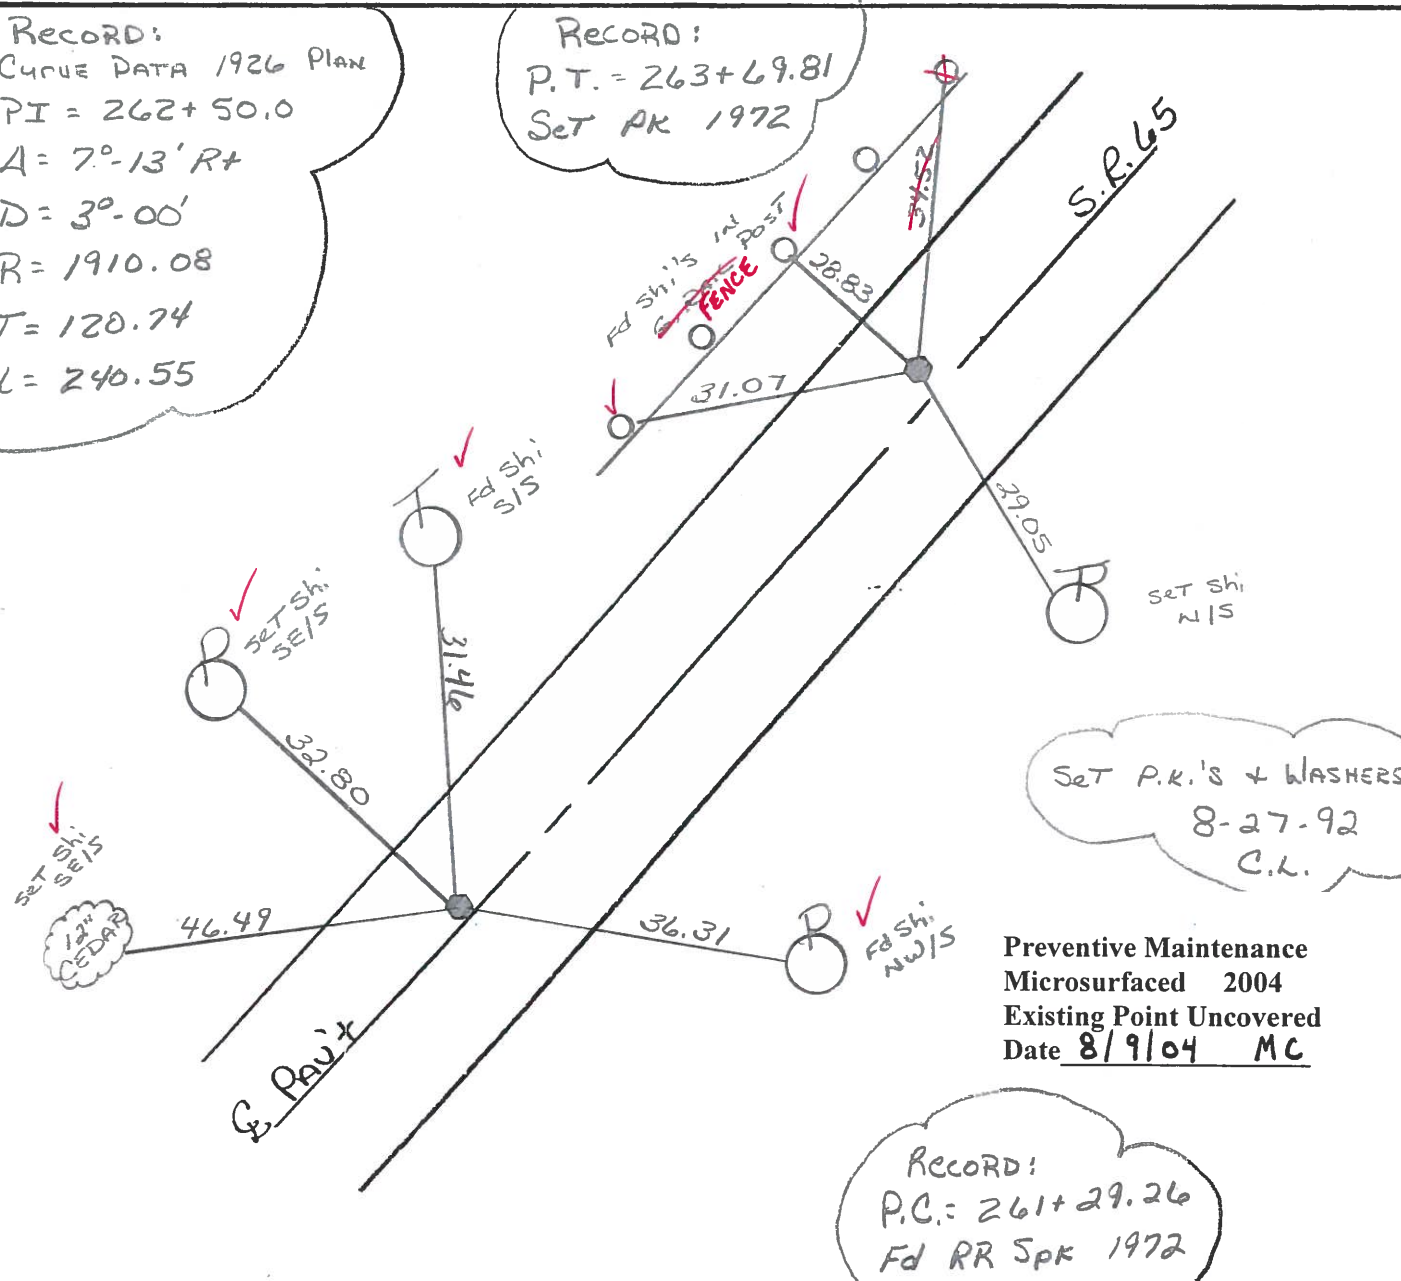

S.M.T. 1

O.D.O.T. DISTRICT 2 SURVEY OFFICE

SHEET 10 OF 91

County Wood S.R. 65

Date 4-9-84

Township WASHINGTON

Weather Clear

Section 25

Temp. +45°

T6N, R9E

Personnel HOFFMAN


14-E

LOENHKE

HOUSEHOLDER H.C.

14-EF

BARNHISEL R.C.

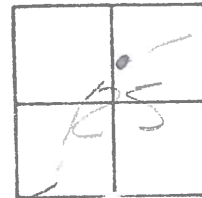


Record:
P.C. 261+29.26
Fol RR spike 1973

Fol R.R. spike 3" below surface
oil & paint
9.2' to Lt. EP
9.5' to Rt. EP
S.L.M. = 360+46

Record:
P.T. 263+69.81
Set RR 1972

Fol small spike 2" below surface
oil & paint
9.2' to Lt. EP
10.5' to Rt. EP
S.L.M. = 362+86

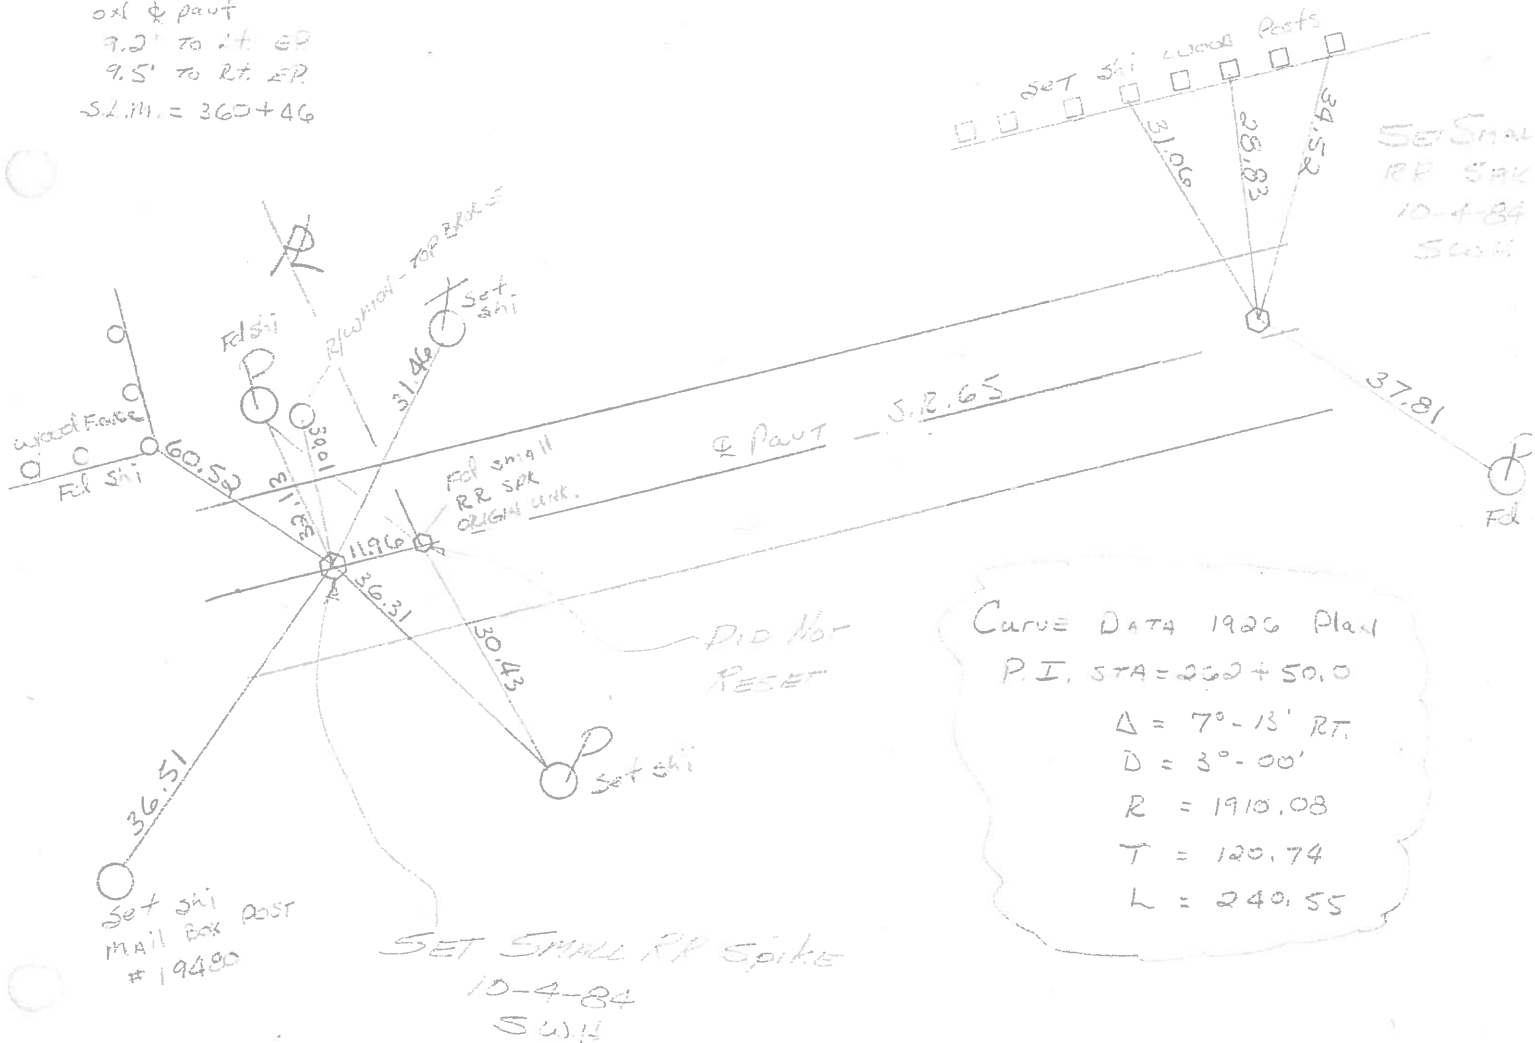


PERSONNEL TITLE PERSONNEL TITLE
BUENSHIDE
SMITH

COUNTY Wood DATE 10-27-72

S. R. 65 WEATHER CLEAR

SEC. WASHINGTON TWP TEMP. +42°

DESCRIPTION ESTABLISH & REF. & CONTROL POINTS JOB NO.

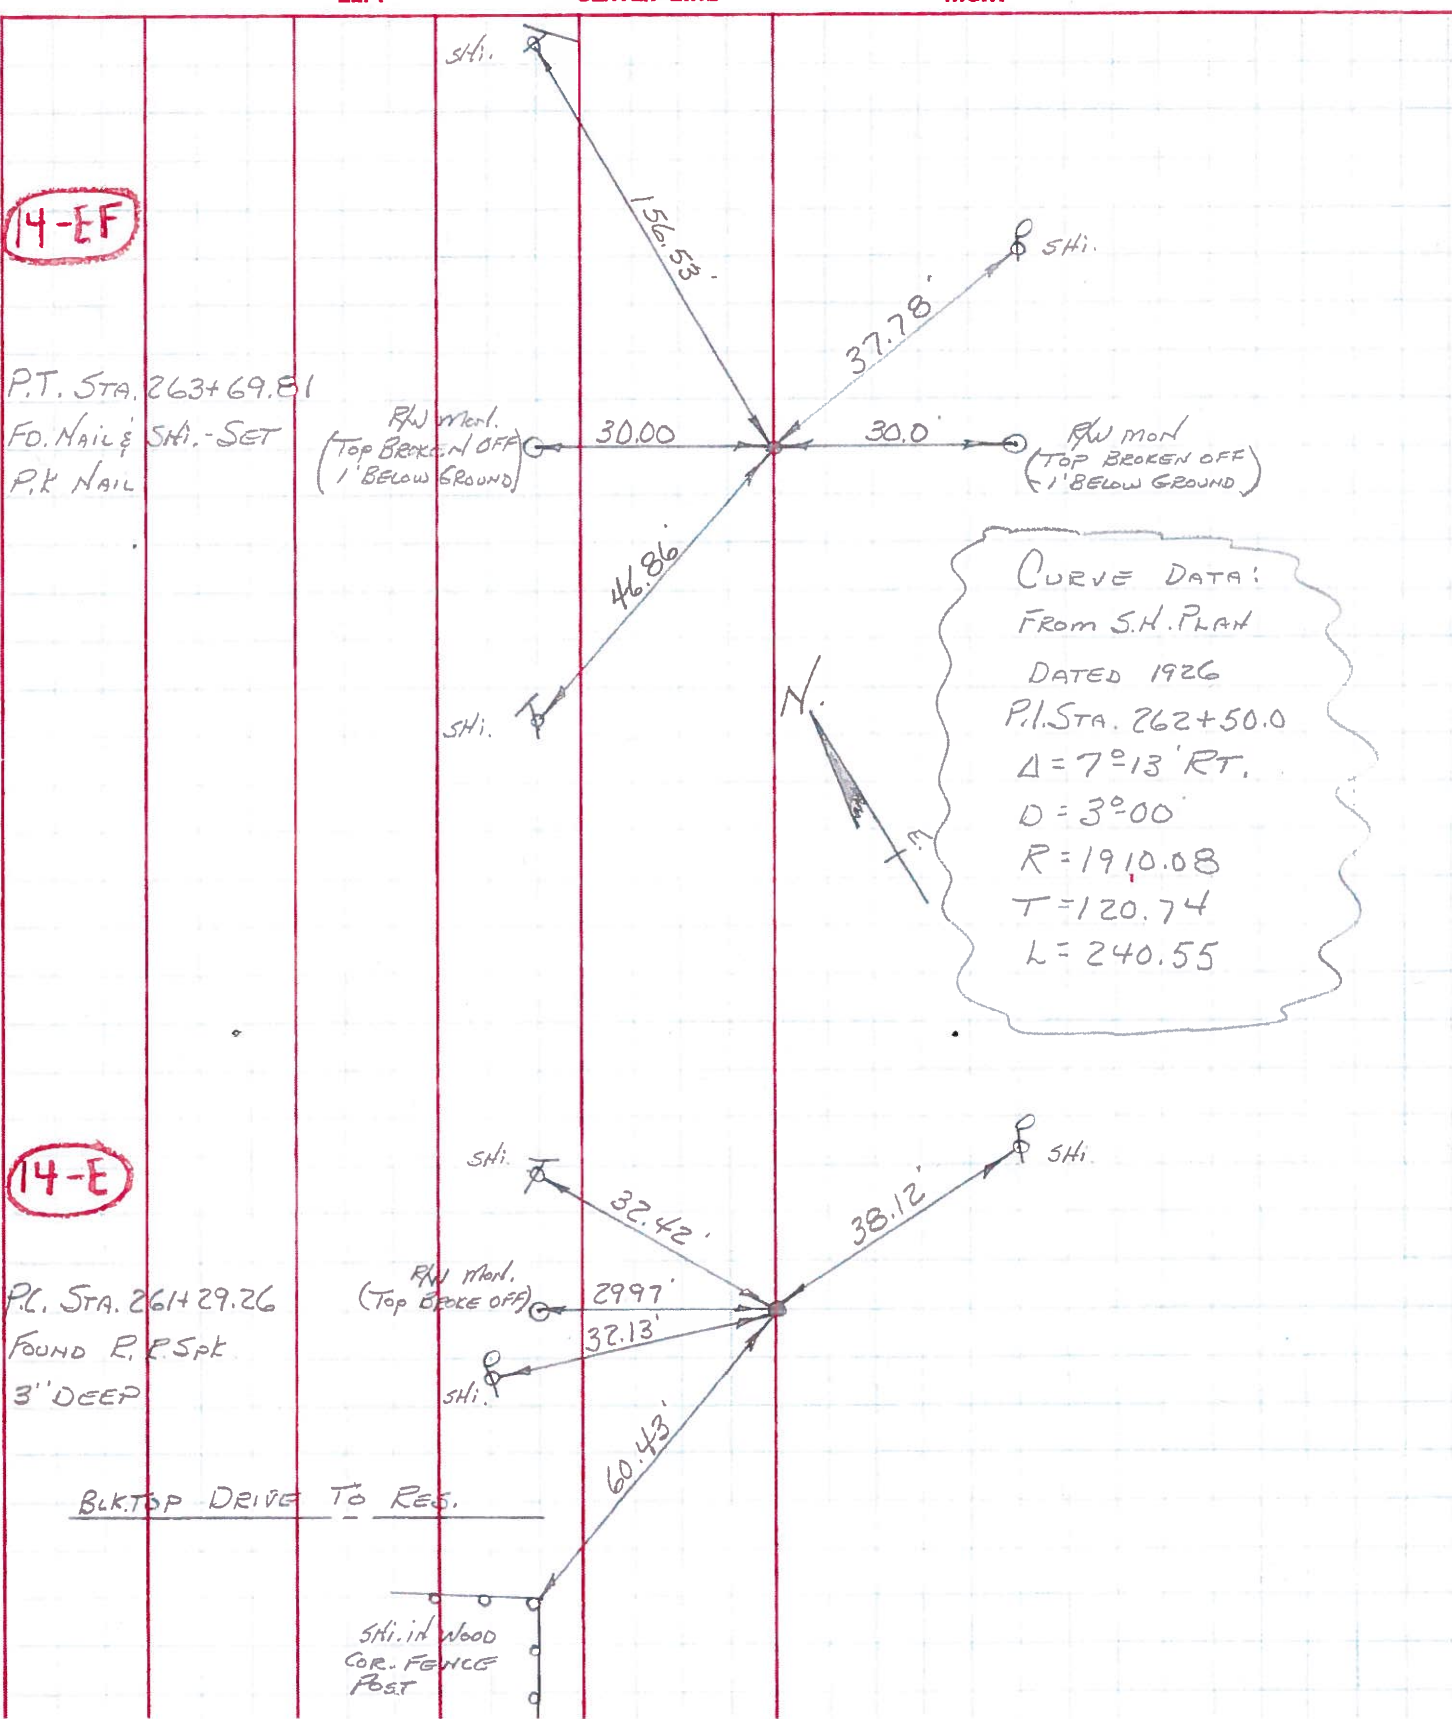

PERSONNEL TITLE PERSONNEL TITLE

COUNTY Wood

DATE 6-24-59
ok 2-2-66

S. R. #65

WEATHER

SEC.

TEMP.

DESCRIPTION Wit. Ties

JOB NO.

LEFT CENTER LINE RIGHT

