


O.D.O.T. DISTRICT 2 SURVEY OFFICE (USE ONLY)

PERSONNEL	REFERENCE NO. <u>14 F</u>	SHEET <u>21</u> OF <u>63</u>
NOTES <u>LEU</u>	DATE <u>4/21/15</u>	ROUTE <u>SR 65</u>
H.C. <u>O'DONNELL</u>	WEATHER <u>WINDY</u>	COUNTY <u>WOOD</u>
R.C. <u>WESTFALL</u>	TEMP. <u>43°</u>	TOWNSHIP <u>WASHINGTON</u>
<u>RHOADES</u>		SECTION <u>25</u>
		T <u>6</u> N R <u>9</u> E


TYPE MONUMENT P.K./WASHER
 ON SURFACE - ~~BELOW~~ ON
 LEFT - PAV'T - ~~RIGHT~~ 1.6'
 - TORT EDGE PAVEMENT
 S.L.M. 370+41.35

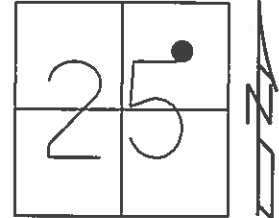

Grid: Northing: 654353.659 Easting: 1619282.017

RECORD: P.I.
 CURVE DATA 1926
 STA. 272+49.8
 $\Delta = 36^\circ 22' RT$
 $D = 8^\circ 00'$
 $R = 716.78$
 $T = 235.43$
 $L = 454.58$

DIST. 14F-14G = ± 219.15

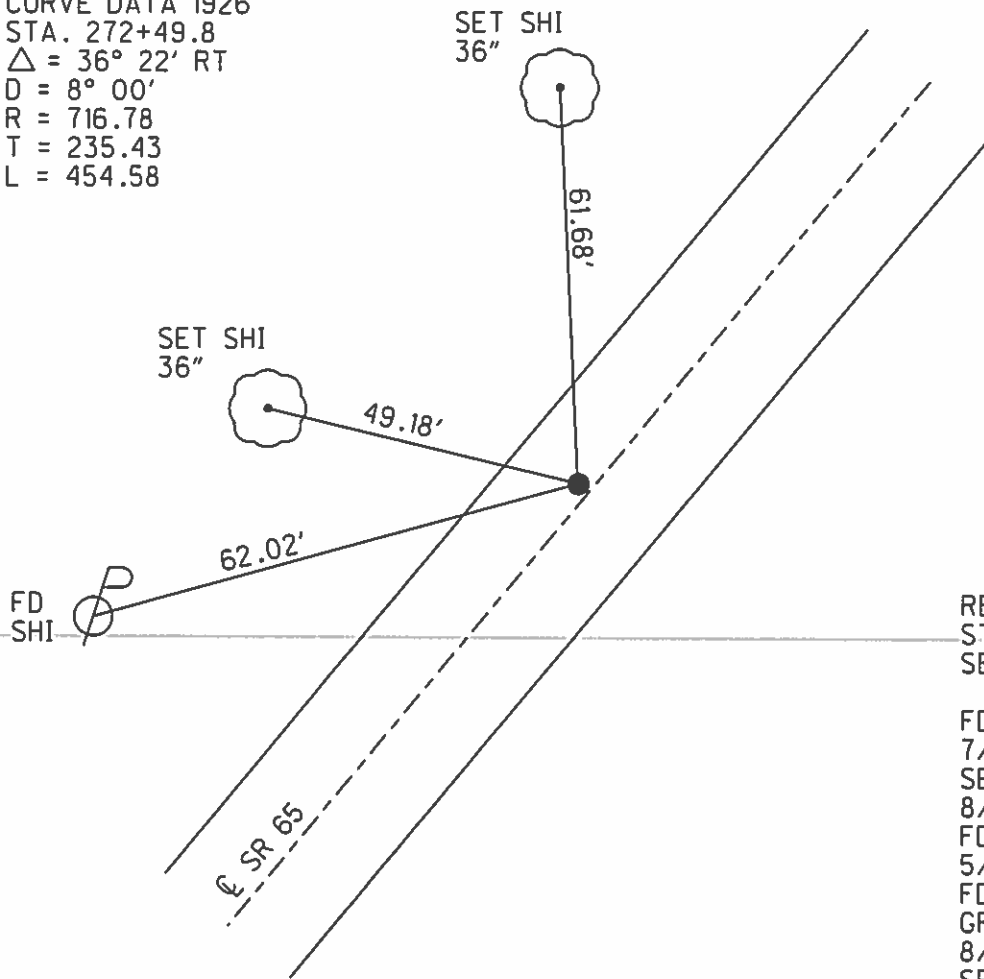

RECORD: P.C.
 STA. 270+14.37
 SET P.K., 1972

FD SM.R.R.SPIKE
 7/15/92
 SET P.K./WASHER
 8/27/92, MB
 FD P.K./WASHER
 5/14/04, MC
 FD P.K./WASHER
 GPS, REFF14
 8/26/13, SDC
 SET MAG/WASHER
 GPS, NEWREFF14
 9/8/15, JFO

O.D.O.T. DISTRICT 2 SURVEY OFFICE

PERSONNEL

REFERENCE NO. P.I. = 14-F SHEET 11 OF 34

NOTES BARNHISEL

5/14/04

H.C. CURTIS

DATE 7-15-92

ROUTE 65

R.C. ROMETO

WEATHER RAIN

COUNTY WOOD

LOCHRKE

TEMP. +70°


TOWNSHIP WASHINGTON

SECTION 25

14-G


T 6 N R 9 E

	P.C.	P.T.
TYPE MONUMENT	Sm RR Spk	Sm RR Spk - 2" DOWN
ON SURFACE - BELOW	YES	YES
LEFT- & PAV'T. - RIGHT	1.9	1.8
- TO RT EDGE PAVEMENT	12.0	11.3
S.L.M.	369+30	373+86

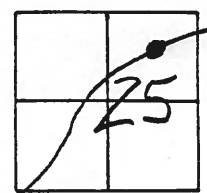

RECORD:
 CURVE DATA 1926
 P.I. = 272+49.80
 A = 36°-22' Rt.
 D = 8°-00'
 R = 716.78
 T = 235.43
 L = 454.58

RECORD:
 P.T. = 274+68.95
 SET PK 1972

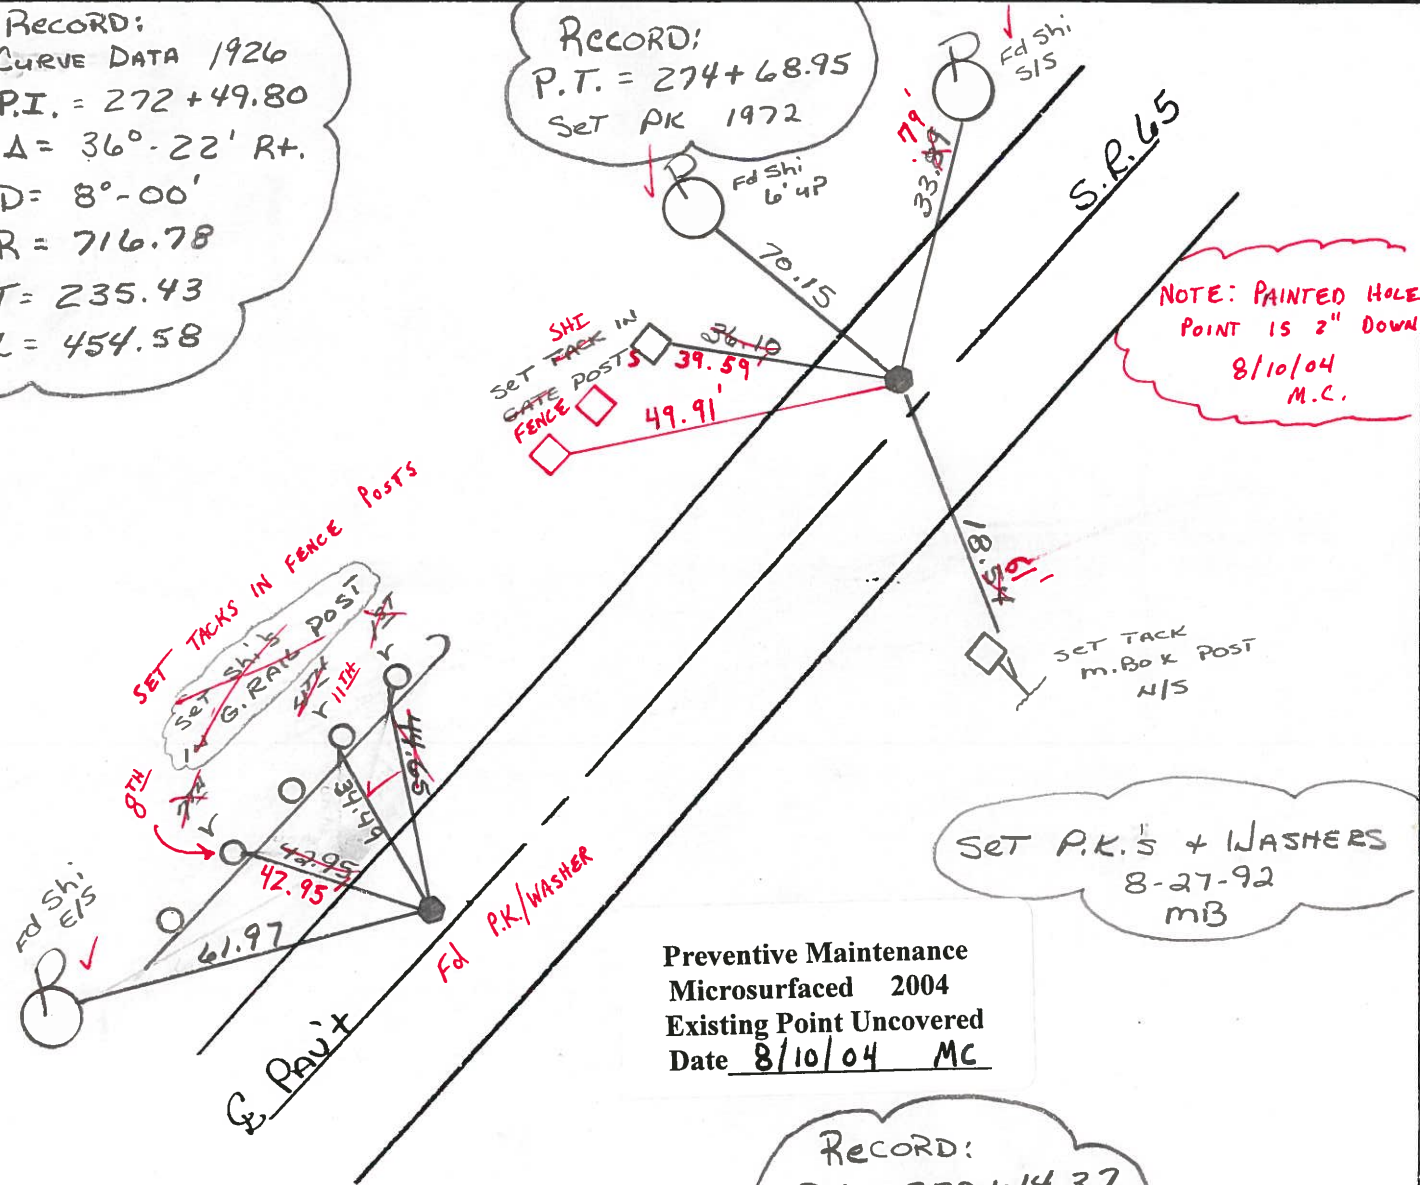

Preventive Maintenance
 Microsurfaced 2004
 Existing Point Uncovered
 Date 8/10/04 MC

RECORD:
 P.C. = 270+14.37
 SET PK 1972

S.M.T. 1

ODOT. DISTRICT 2 SURVEY OFFICE

SHEET 11 OF 91

County WOOD S.R. 65

Township WASHINGTON

Section 25

T6N, R9E

Personnel HOFFMAN

Date 4-9-84

Weather clear

Temp. 45°

14-F

LOENRKE

HOUSEHOLDER H.C.

BARWISER R.C.

14-G



SET SMALL R.R. SPIKE

© BOTH POINTS

10-9-84

S.W.H.

Record:

P.T. 274+68.95

set P.K. 1972

Fd R.R. SPIK 3" Below SURFACE

1.8' Lt. of & Pavt

11.8' TO Lt EP

11.3' TO RT EP

SLM = 373+86

Record:

P.C. 270+14.37

Set P.K. 1972


Fd R.R. SPIK 3" Below SURFACE

1.9' Lt. of & Pavt.

8.2' TO Lt. EP

12.0' TO RT. EP

SLM 369+32

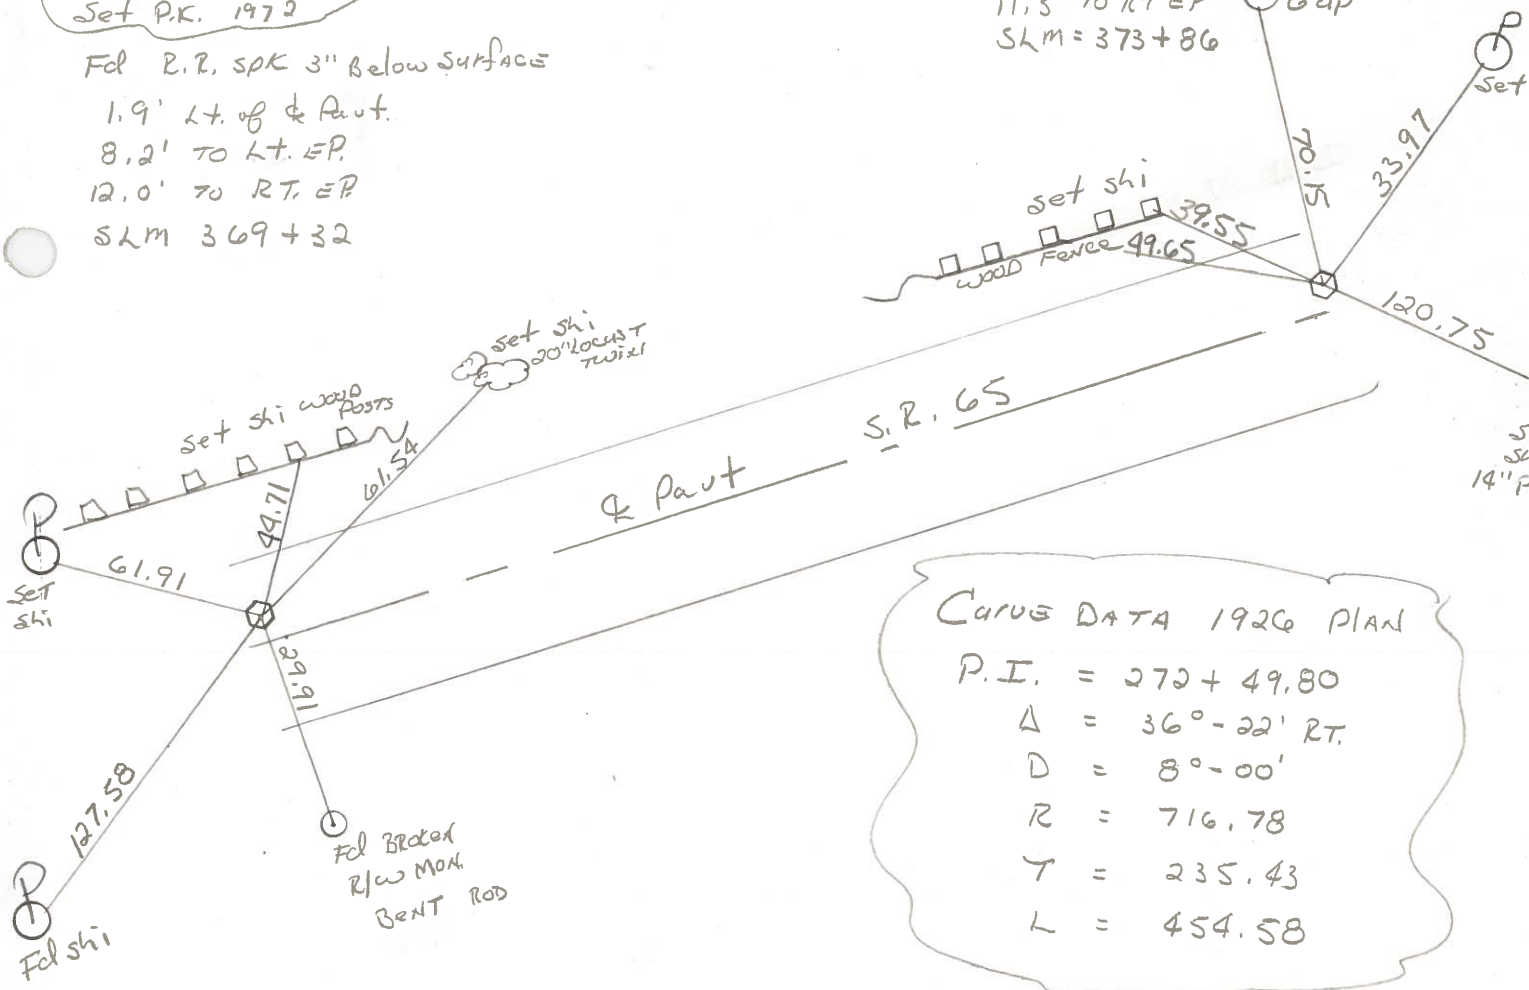

CURVE DATA 1926 PLAN

P.I. = 270+49.80

A = 36°-22' RT.

D = 8°-00'

R = 716.78

T = 235.43

L = 454.58

PERSONNEL BURHSIDE TITLE _____
 PERSONNEL SMITH TITLE _____

COUNTY Wood DATE 10-27-72

S. R. 65 WEATHER CLEAR

SEC. WASHINGTON TWP TEMP. +55°

DESCRIPTION ESTABLISH & REF. & CONTROL POINTS JOB NO. _____

