

O.D.O.T. DISTRICT 2 SURVEY OFFICE (USE ONLY)

PERSONNEL

REFERENCE NO. 14 H

SHEET 23 OF 63

NOTES LEU

DATE 4/21/15

ROUTE SR 65

H.C. O'DONNELL

WEATHER WINDY

COUNTY WOOD

R.C. WESTFALL

TEMP. 43°

TOWNSHIP WASHINGTON

RHOADES

SECTION 25

T 6 N R 9 E

TYPE MONUMENT SM.R.R.SPIKE


~~ON SURFACE~~ - BELOW 0.2'

LEFT - PAV'T - RIGHT ON

- TO - EDGE PAVEMENT


S.L.M. 391+34.59

Grid: Northing: 655234.274 Easting: 1621153.029

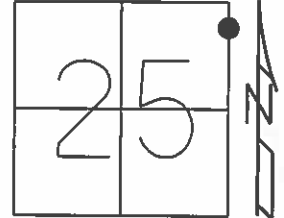

RECORD:
ORIGIN UNKNOWN

FD SM.R.R.SPIKE
7/15/92
SET P.K./WASHER
8/27/92, MB
FD SM.R.R.SPIKE
2" DOWN
8/5/13, SDC
GPS, REFH14
SET MAG/WASHER
GPS, NEWREFH14
9/8/15, JFO

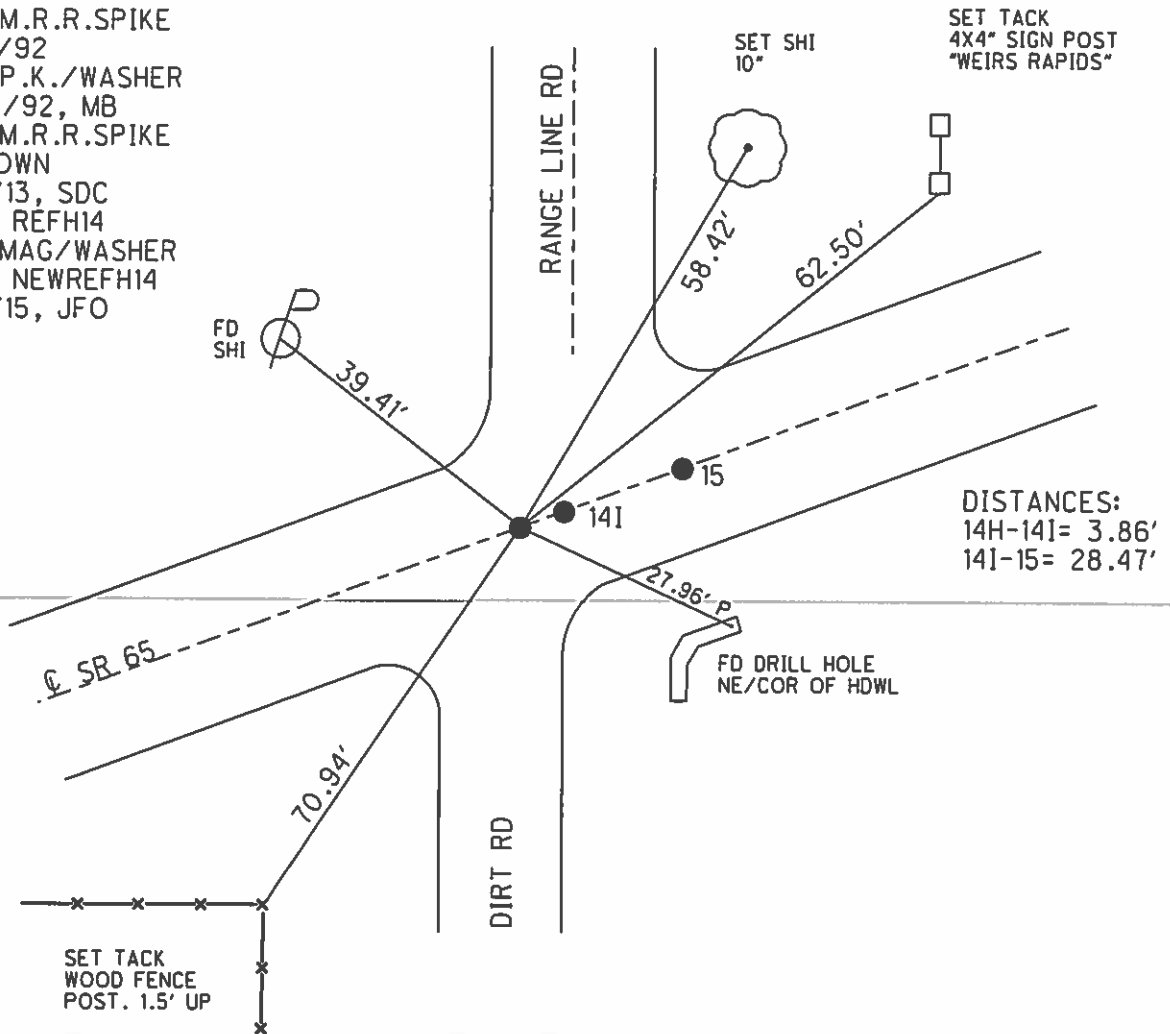

DISTANCES:
14H-141= 3.86'
141-15= 28.47'

O.D.O.T. DISTRICT 2 SURVEY OFFICE

PERSONNEL

REFERENCE NO. 75 ^{P.I. =}

SHEET 12 OF 34

NOTES BARNHISEL

5/14/04

H.C. CURTIS

DATE 7-15-92

ROUTE 65

R.C. ROMETO

WEATHER RAIN

COUNTY WOOD

LOCHRKE

TEMP. +70°

TOWNSHIP WASHINGTON

SECTION 25

(A) ^{Fd. P.K.} (B) ^{Fd. P.K.} (C) ^{ORIGIN UNKNOWN Fd. P.K./WASHER}

TGNR 9 E

TYPE MONUMENT Sm RR Spk's (all 3 pts)


ON SURFACE - ~~BELOW~~ yes yes yes

~~LEFT~~ - PAV'T. - RIGHT yes yes yes


- TO - EDGE PAVEMENT

S.L.M. PT. "A" 390+28

14-H
14-I

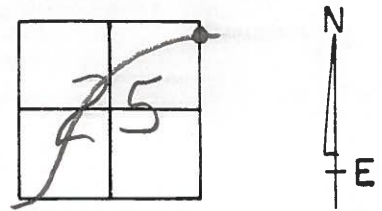

Set P.K.'s & WASHERS
8-27-92
MB

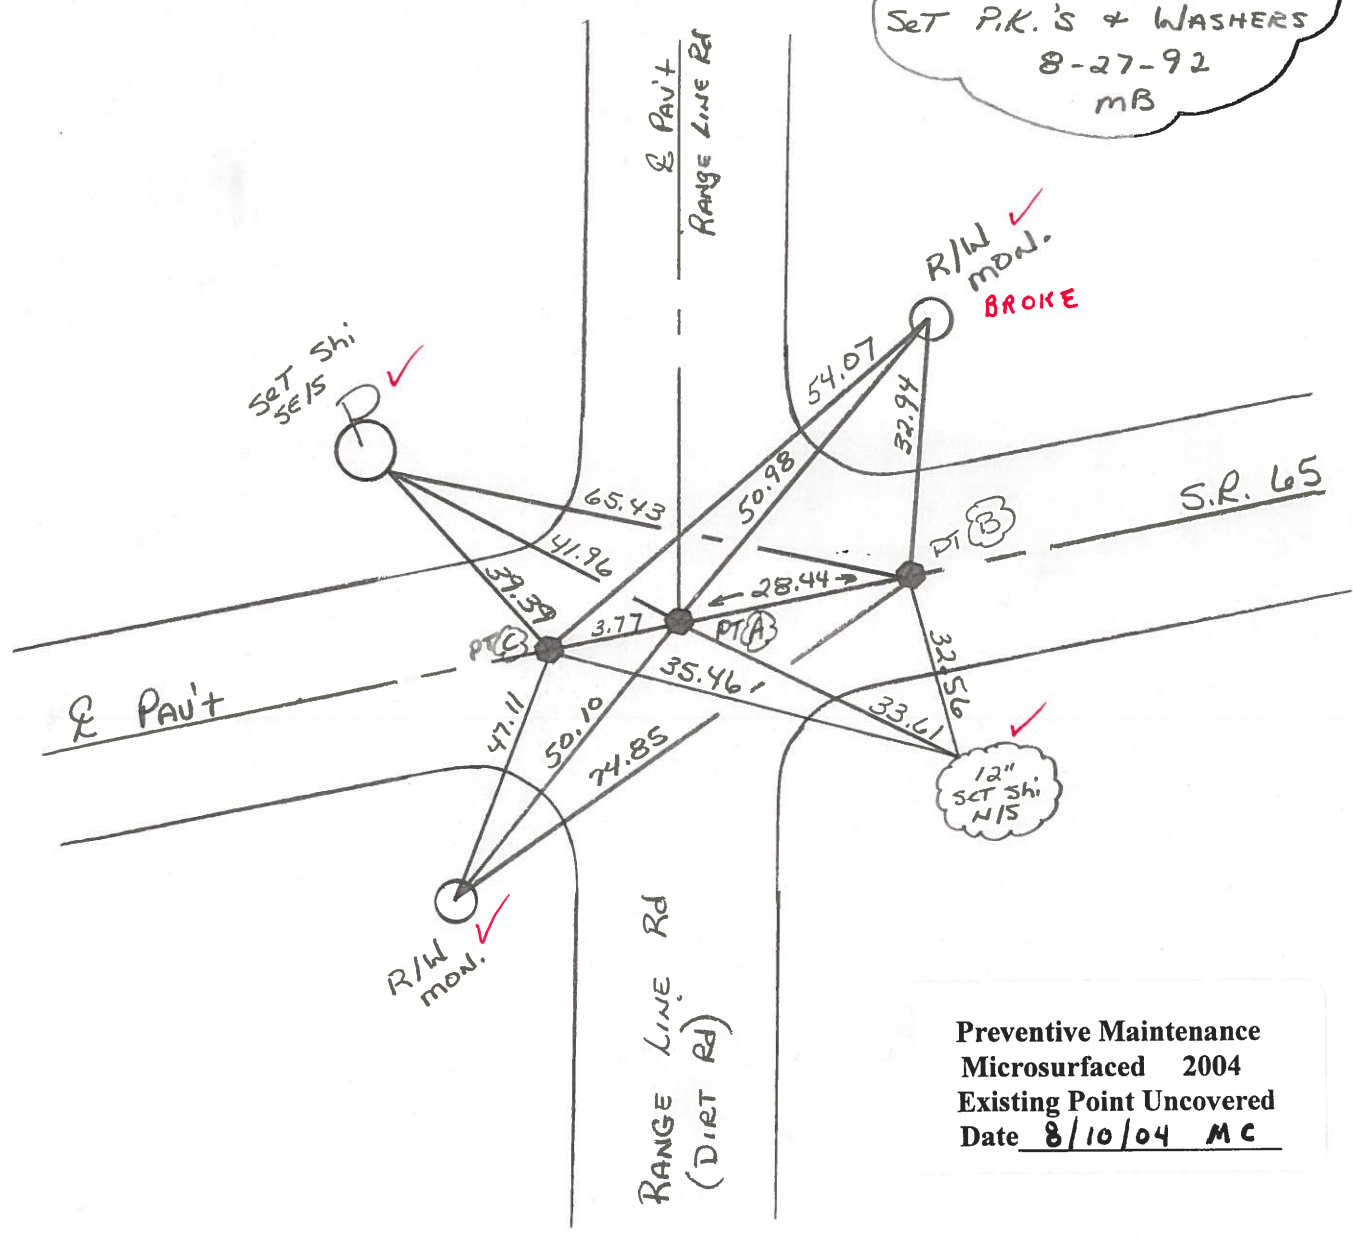

Preventive Maintenance
Microsurfaced 2004
Existing Point Uncovered
Date 8/10/04 MC

SMT-1

O.D.O.T. DISTRICT 2 SURVEY OFFICE

SHEET 12 OF 91

County WOOD S.R. 65

Township WASHINGTON

Section 25

T6N, R9E

Personnel HOFFMAN

14-H LOHRKE

HOUSEHOLDER H.C.


14-I BARNHISEL R.C.

#15

Date 4-9-84

Weather clear

Temp. 45°

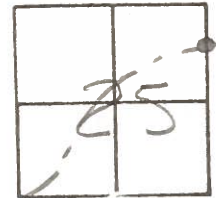

"A" = Fd R.R. SPIK 2" Below Surface SLM = 390 + 28

"B" = Fd R.R. SPIK 1" Below Surface

"C" = Fd R.R. SPIK 2" Below Surface
ORIGIN UNKNOWN

All pts. oxi & paint SRCS

SET SMALL RR SPIKE

@ ALL 3 POINTS

10-9-84

S.W.H.

