


O.D.O.T. DISTRICT 2 SURVEY OFFICE (USE ONLY)

PERSONNEL	REFERENCE NO. <u>16</u>	SHEET <u>29</u> OF <u>63</u>
NOTES <u>WESTFALL</u>	DATE <u>4/21/15</u>	ROUTE <u>SR 65</u>
H.C. <u>O'DONNELL</u>	WEATHER <u>WINDY</u>	COUNTY <u>WOOD</u>
R.C. <u>LEU</u>	TEMP. <u>50°</u>	TOWNSHIP <u>WASHINGTON</u>
<u>RHOADES</u>		SECTION <u>19</u>
		T <u>6</u> N R <u>10</u> E


TYPE MONUMENT P.K.SHANK
 ON SURFACE - ~~BELOW~~ ON
~~LEFT~~ - PAV'T - RIGHT 1.4'
10.4' TO LT EDGE PAVEMENT
 S.L.M. 419+88.66

Grid: Northing: 656004.756 Easting: 1623886.520

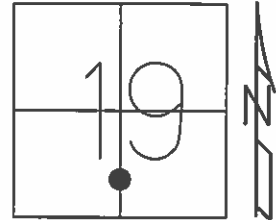

RECORD: P.I.
 STA. 319+64.35
 $\Delta = 2^{\circ}30'$ LT (PLAN)
 SET P.K., 1972

FD P.K./WASHER
 7/15/92, 5/17/04
 SET P.K./WASHER
 8/31/92, MB
 FD P.K./WASHER
 GPS, REF16
 8/27/13, SDC
 SET MAG/WASHER
 GPS, NEWREF16
 9/9/15, JFO

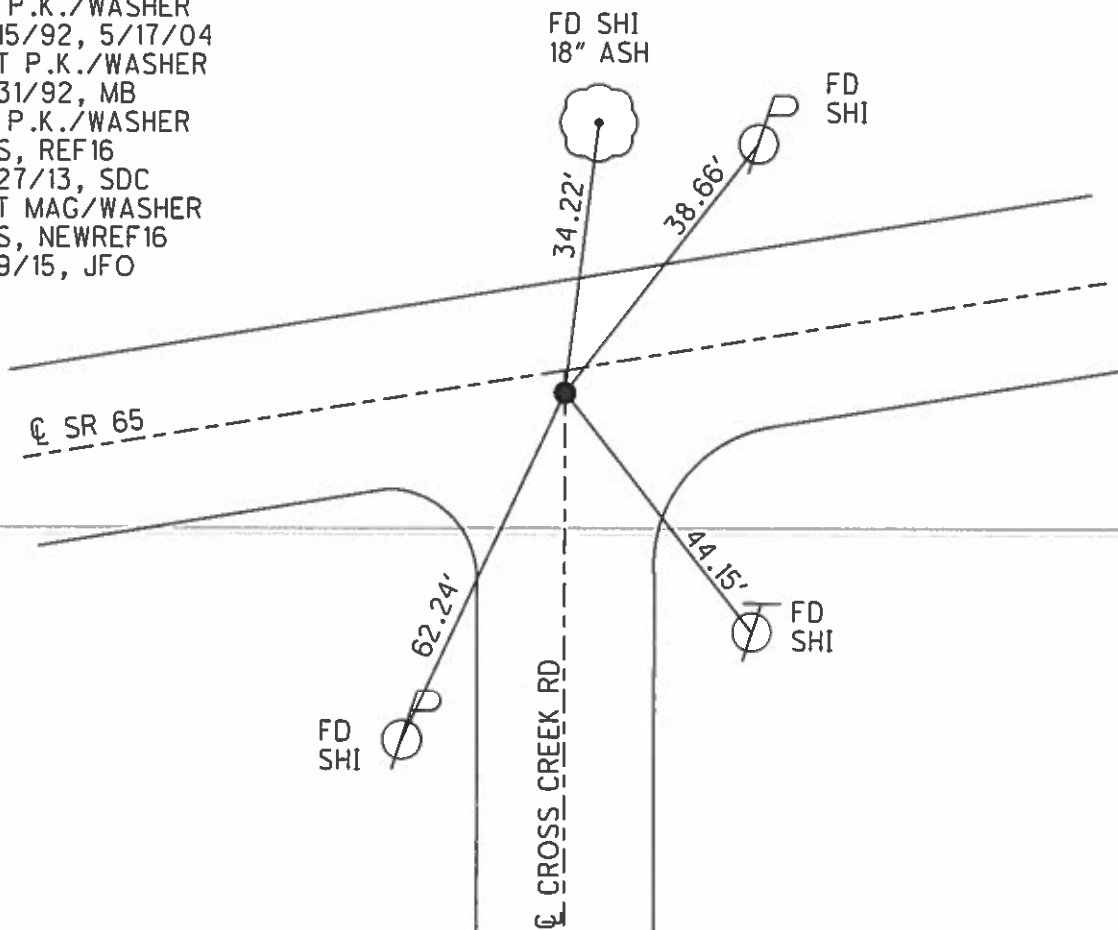

O.D.O.T. DISTRICT 2 SURVEY OFFICE

PERSONNEL

REFERENCE NO. 16

SHEET 15 OF 34

NOTES BARNHISEL

H.C. VAN DUSEN

R.C. KUSZ

BURNETT

DATE 5-17-04
~~7-15-92~~

WEATHER RAIN

TEMP. +70°

ROUTE 65

COUNTY WOOD

TOWNSHIP WASHINGTON

SECTION 19

T 6 N R 10 E


TYPE MONUMENT PK + WASHER ✓

ON SURFACE - ~~BELOW~~ YES


~~LEFT~~ - PAV'T. - RIGHT 1.4

10.4 TO LT EDGE PAVEMENT

S.L.M. 418+75

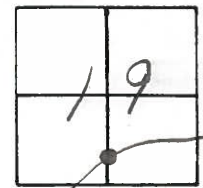

Record:
P.I. = 319+64.35
Set PK 1972
 $\Delta = 2^{\circ}30' \text{ LT. (PLAN)}$

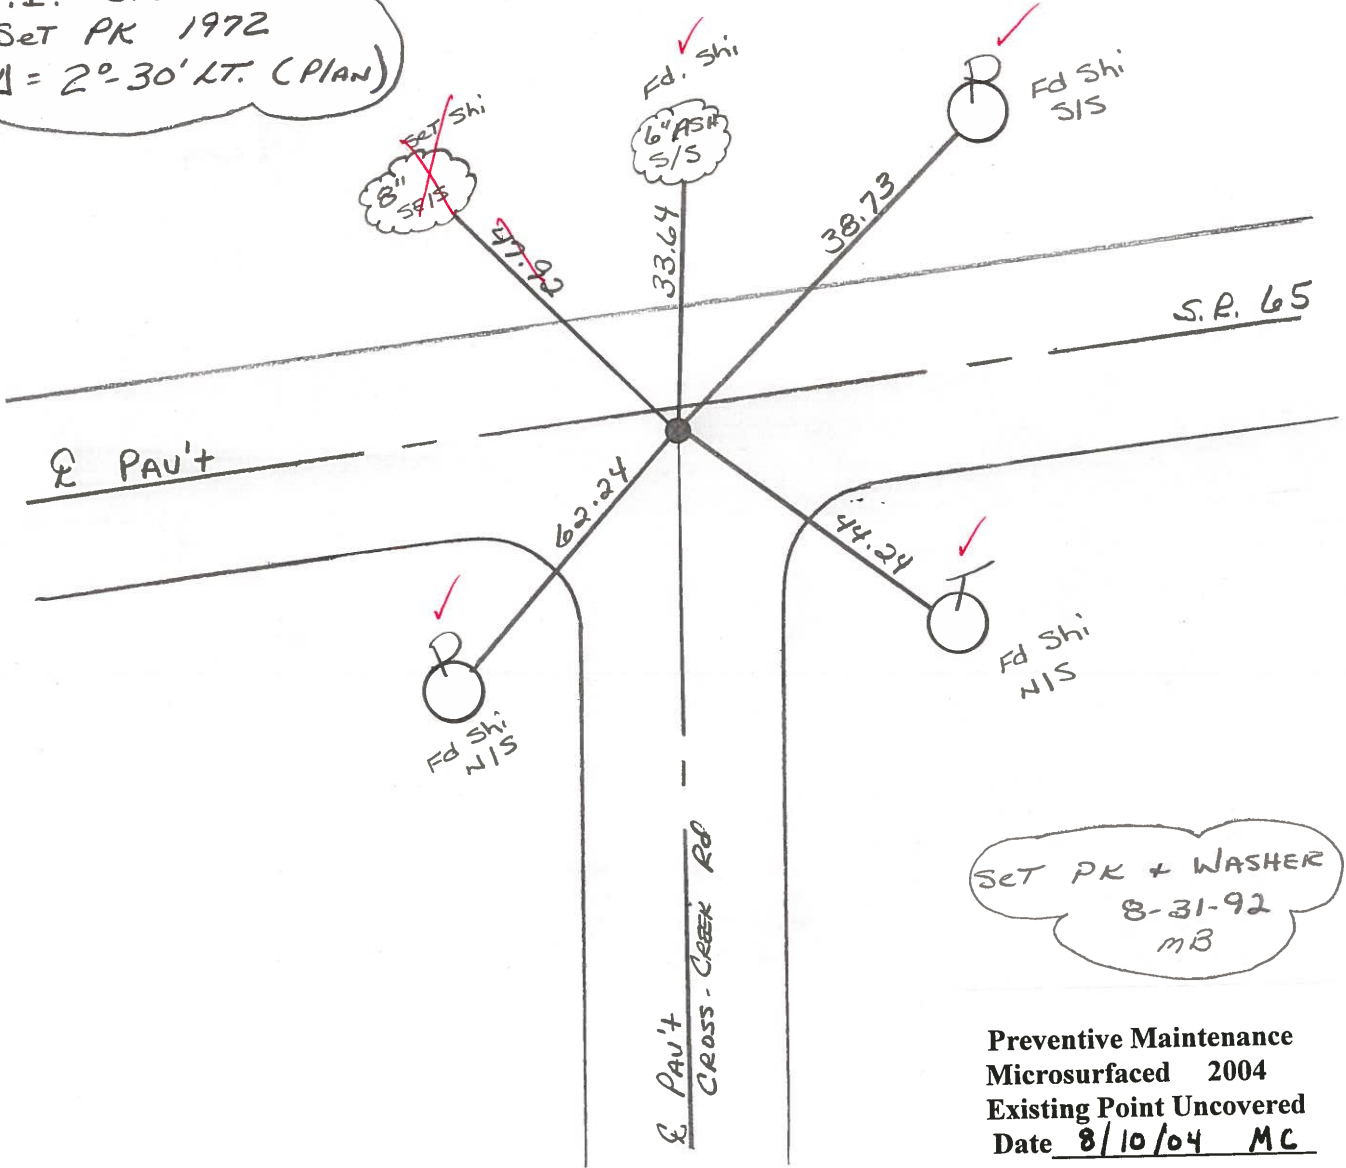

Set PK + WASHER
8-31-92
MB

Preventive Maintenance
Microsurfaced 2004
Existing Point Uncovered
Date 8/10/04 MC

SMT-1

Q.D.O.T. DISTRICT 2 SURVEY OFFICE

SHEET 15 OF 91

County Wood S.R. 65

Date 4-10-84

Township WASHINGTON


Weather Clear

Section 19

Temp. 40°

T6N, R10E

Personnel HOFFMAN
LOEHLKE
HOUSEHOLDER H.C.
BARNHISEL R.C.

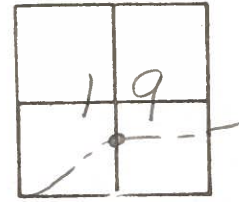


#16

Fd P.K. @ surface
 1.4' RT. of & PAUT SRGS
 10.4' TO LT. EP.

SLM 418+75

SET PK/WASHER
 10-9-84
 S.W.H.

Record:
 P.I. 319+64.35
 SET P.K.
 $\Delta = 2^{\circ}-30' \text{ LT. (CRASH)}$
 1972

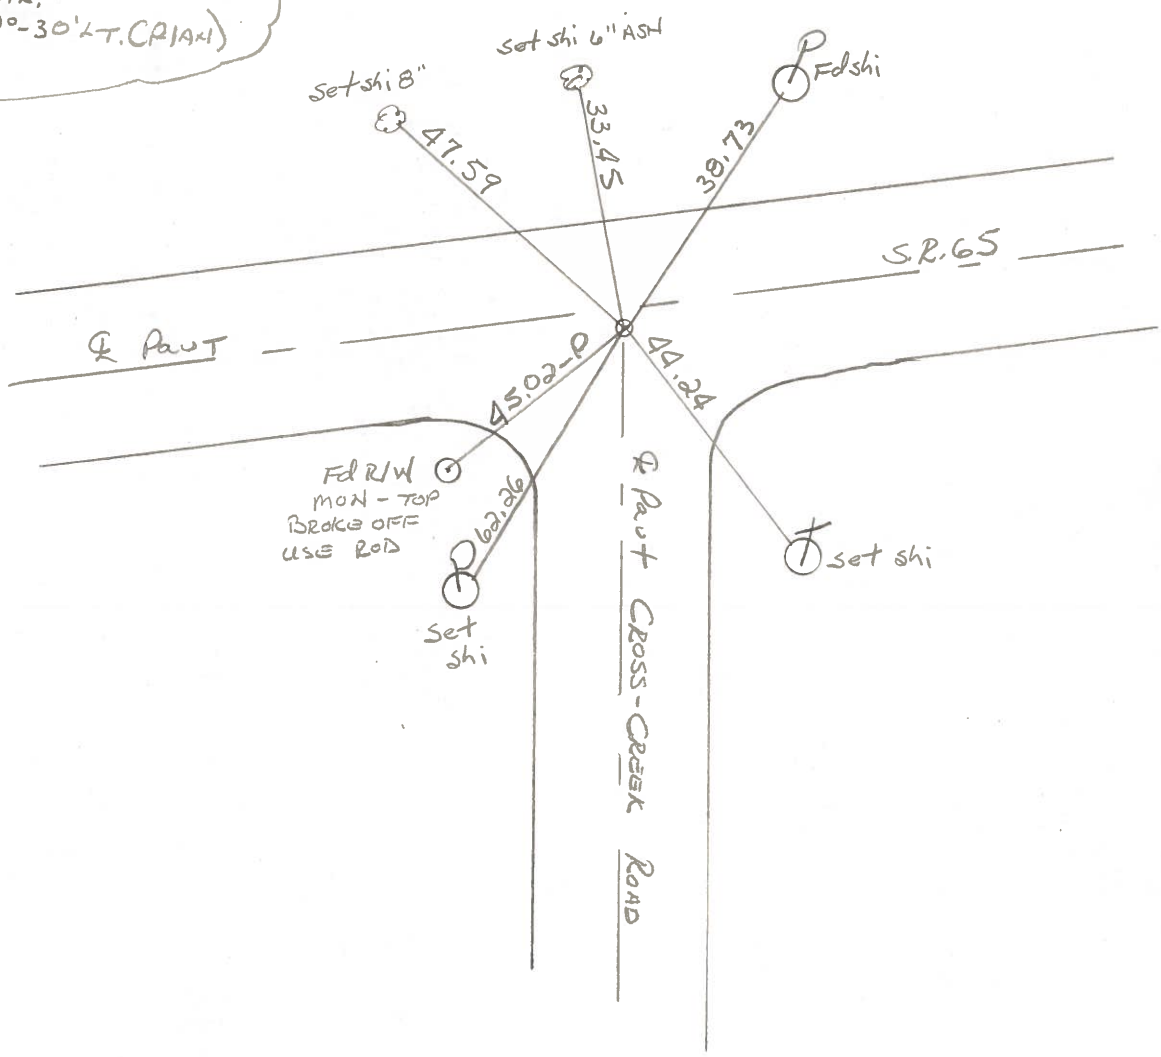

Fd RW
 MON - TOP
 BRACK OFF
 USE ROD

PAUT CROSS-CREEK ROAD

SR. 65

PERSONNEL	TITLE	PERSONNEL	TITLE
BURNSIDE			
SMITH			
BOWERS			

COUNTY WOOD DATE 10-30-72

S. R. 65 WEATHER Cloudy

SEC. WASHINGTON TWP TEMP. +40°

DESCRIPTION ESTABLISH & REF. & CONTROL POINTS JOB NO. _____

