


O.D.O.T. DISTRICT 2 SURVEY OFFICE (USE ONLY)

PERSONNEL	REFERENCE NO. <u>16 A</u>	SHEET <u>30</u> OF <u>63</u>
NOTES	WESTFALL	DATE <u>4/21/15</u>
H.C.	O'DONNELL	WEATHER <u>WINDY</u>
R.C.	LEU	TEMP. <u>50°</u>
	RHOADES	TOWNSHIP <u>WASHINGTON</u>
		SECTION <u>19</u>
		T <u>6</u> N R <u>10</u> E


TYPE MONUMENT P.K./WASHER  
 ON SURFACE - ~~BELOW~~ ON  
~~LEFT~~ - PAV'T - RIGHT 1.4'  
9.0' ~~TORT~~ EDGE PAVEMENT  
 S.L.M. 422+59.35

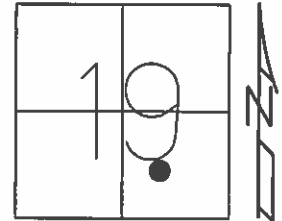

Grid: Northing: 656055.084 Easting: 1624152.469

RECORD: P.C.  
 STA. 322+34.61  
 SET P.K., 1972

FD P.K./WASHER  
 7/15/92, 5/17/04  
 SET P.K./WASHER  
 9/3//92, MB  
 FD P.K./WASHER  
 GPS, REFFA16  
 8/28/13, SDC  
 SET MAG/WASHER  
 GPS, NEWREFA16  
 9/10/15, JFO

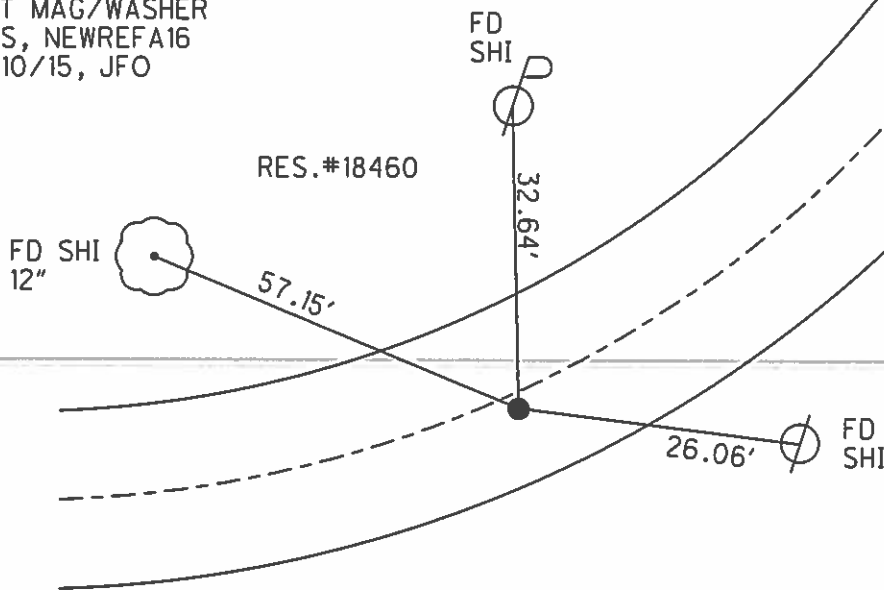

RECORD: P.I.  
 CURVE DATA 1926  
 STA. 324+32.95  
 $\Delta = 19^\circ 39' \text{ LT}$   
 $D = 5^\circ 00'$   
 $R = 1146.28$   
 $T = 198.34$   
 $L = 393.00$

# O.D.O.T. DISTRICT 2 SURVEY OFFICE

PERSONNEL

REFERENCE NO. \_\_\_\_\_

SHEET 16 OF 34

NOTES BARNHISEL

H.C. VAN DUSEN

R.C. KUSZ

BURNETT

DATE 5/17/04

WEATHER cloudy

TEMP. 75°

ROUTE 65

COUNTY WOOD

TOWNSHIP WASHINGTON

SECTION 19

T 6 N R 10 E

TYPE MONUMENT P.K. + WASHER P.C. P.K./WASHER P.T. Fd. P.K.


ON SURFACE - BELOW yes yes

~~LEFT~~ - PAV'T. - RIGHT 1.4 2.0

- TO RT EDGE PAVEMENT 9.0 8.0

S.L.M. 421+49 425+38


16-A  
16-B

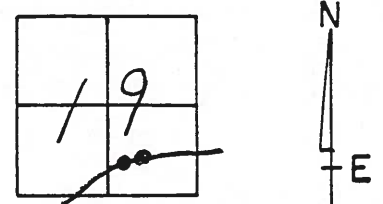

Record:  
Curve Data 1926  
P.I. = 324+32.95  
A = 19° - 39' LT.  
D = 50'-00'  
T = 198.34  
R = 1146.28  
L = 393.00

Reset PK's + Washers  
9-3-92  
mib

Record:  
P.T. = 326+27.61  
Set PK 1972

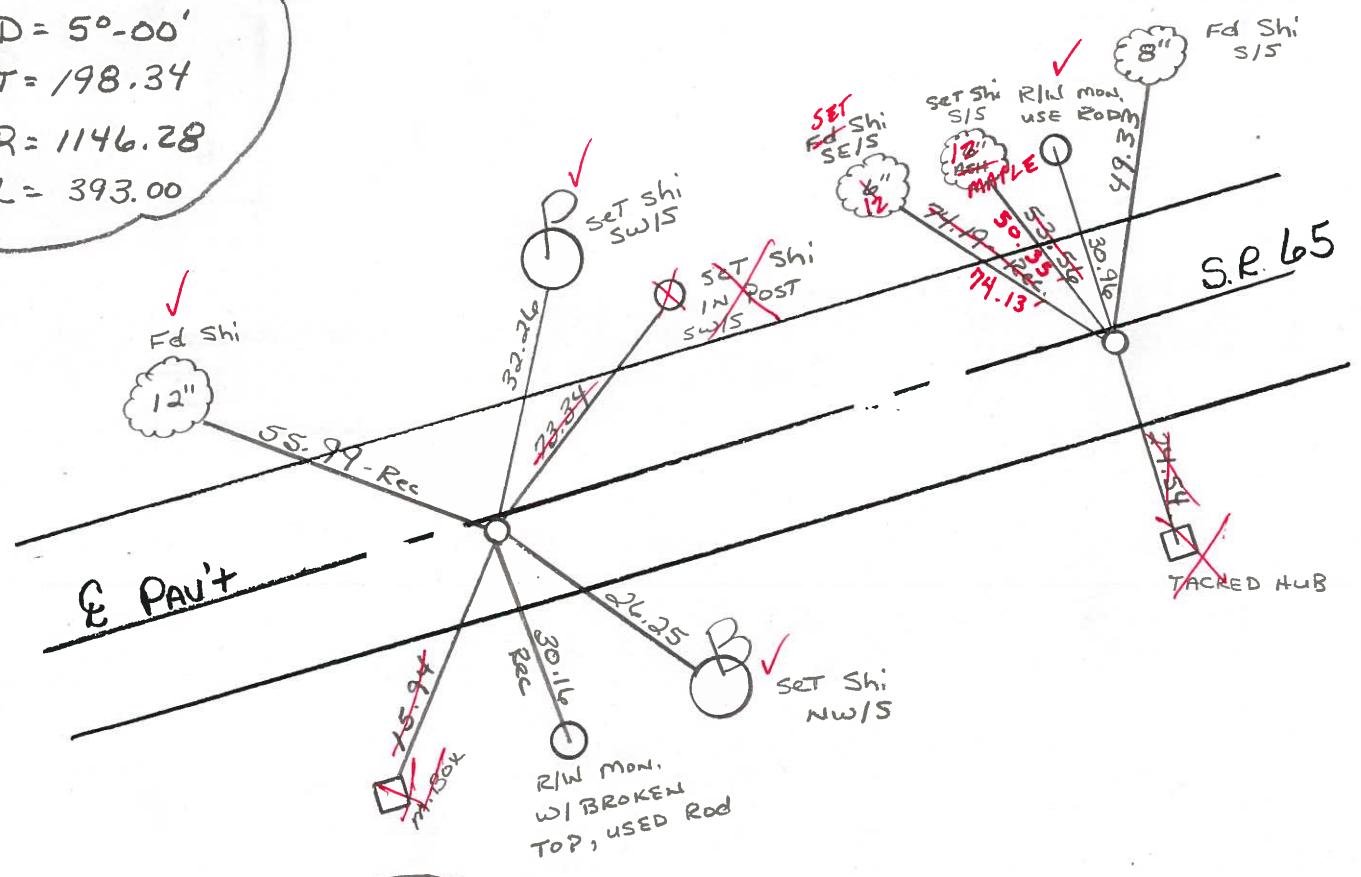

Record:  
P.C. 322+34.61  
Set PK 1972

Preventive Maintenance  
Microsurfaced 2004  
Existing Point Uncovered  
Date 8/10/04 M.C.

County Wood S.R. 64

Date 4-10-84

Township WASHINGTON

Weather clear

Section 19

Temp. 40°

T6N, R10E

Personnel HOFFMAN


16-A

LOEHRKE

HOUSEHOLDER H.C.

16-B

BARHISEL R.C.

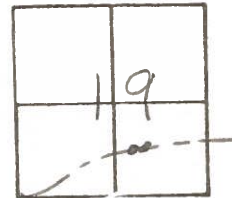

SLM = 421+49

SET PK/WASHER

10-9-84

SLW H

SLM = 425+38

Record:

P.T. 326+27.61

SET P.K. 1972

Fd. P.K. @ surface

1.0' RT. of & PAUT

8.7' TO RT. EP

10.7' TO LT. EP

Record:

P.C. 322+34.61



SET P.K. 1972

Fd. P.K. @ surface

1.0' RT. of & PAUT

8.0' TO RT. EP

10.9' TO LT. EP

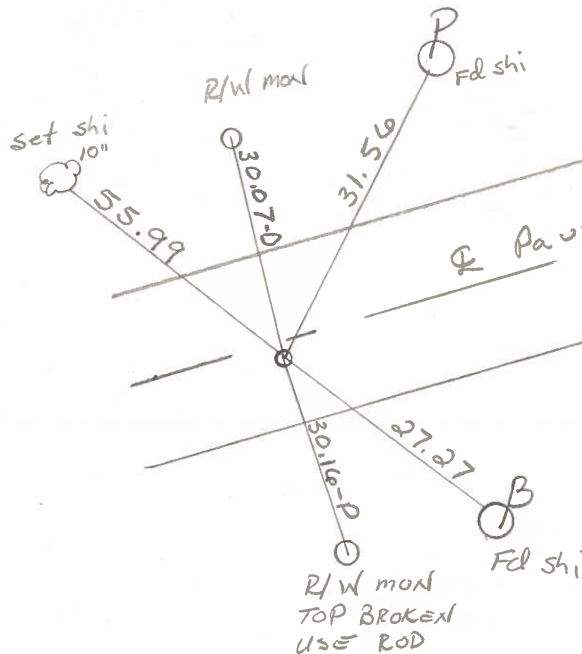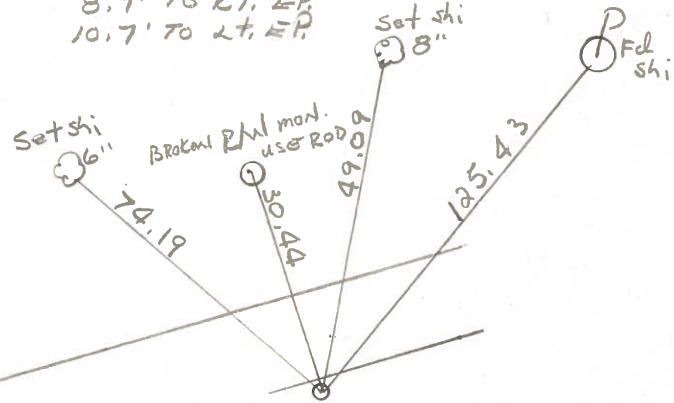

CURVE DATA 1926

P.I. STA = 324+32.95

$\Delta = 19^{\circ}-39' LT.$

D = 5'-0'

T = 198.34

R = 1146.28

L = 393.00

PERSONNEL TITLE PERSONNEL TITLE  
 BURNSIDE \_\_\_\_\_  
 SMITH \_\_\_\_\_  
 BOWERS \_\_\_\_\_

COUNTY Wood DATE 10-30-72  
 S. R. 65 WEATHER Cloudy  
 SEC. WASHINGTON TWP TEMP. +40°

DESCRIPTION ESTABLISH & REF. & CONTROL POINTS JOB NO. \_\_\_\_\_

