


O.D.O.T. DISTRICT 2 SURVEY OFFICE (USE ONLY)

PERSONNEL	REFERENCE NO. <u>16 B</u>	SHEET <u>31</u> OF <u>63</u>
NOTES <u>WESTFALL</u>	DATE <u>4/21/15</u>	ROUTE <u>SR 65</u>
H.C. <u>O'DONNELL</u>	WEATHER <u>WINDY</u>	COUNTY <u>WOOD</u>
R.C. <u>LEU</u>	TEMP. <u>50°</u>	TOWNSHIP <u>WASHINGTON</u>
<u>RHOADES</u>		SECTION <u>19</u>
		T <u>6</u> N R <u>10</u> E

TYPE MONUMENT P.K. NAIL  
 ON SURFACE - ~~BELOW~~ ON  
~~LEFT~~ - PAV'T - RIGHT 2.0'  
8.0' TORT EDGE PAVEMENT  
 S.L.M. 426+48.49

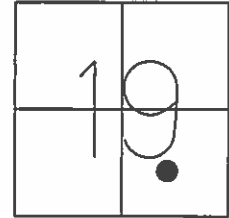


Grid: Northing: 656190.733 Easting: 1624515.226

RECORD: P.T.  
 STA. 326+27.61  
 SET P.K., 1972

FD P.K./WASHER  
 7/15/92, 5/17/04  
 SET P.K./WASHER  
 9/3//92, MB  
 FD P.K.NAIL  
 GPS, REFFB16  
 8/6/13, SDC  
 SET MAG/WASHER  
 GPS, NEWREFB16  
 9/10/15, JFO

RECORD: P.I.  
 CURVE DATA 1926  
 STA. 324+32.95  
 $\Delta = 19^\circ 39' \text{ LT}$   
 $D = 5^\circ 00'$   
 $R = 1146.28$   
 $T = 198.34$   
 $L = 393.00$

RES.#18460

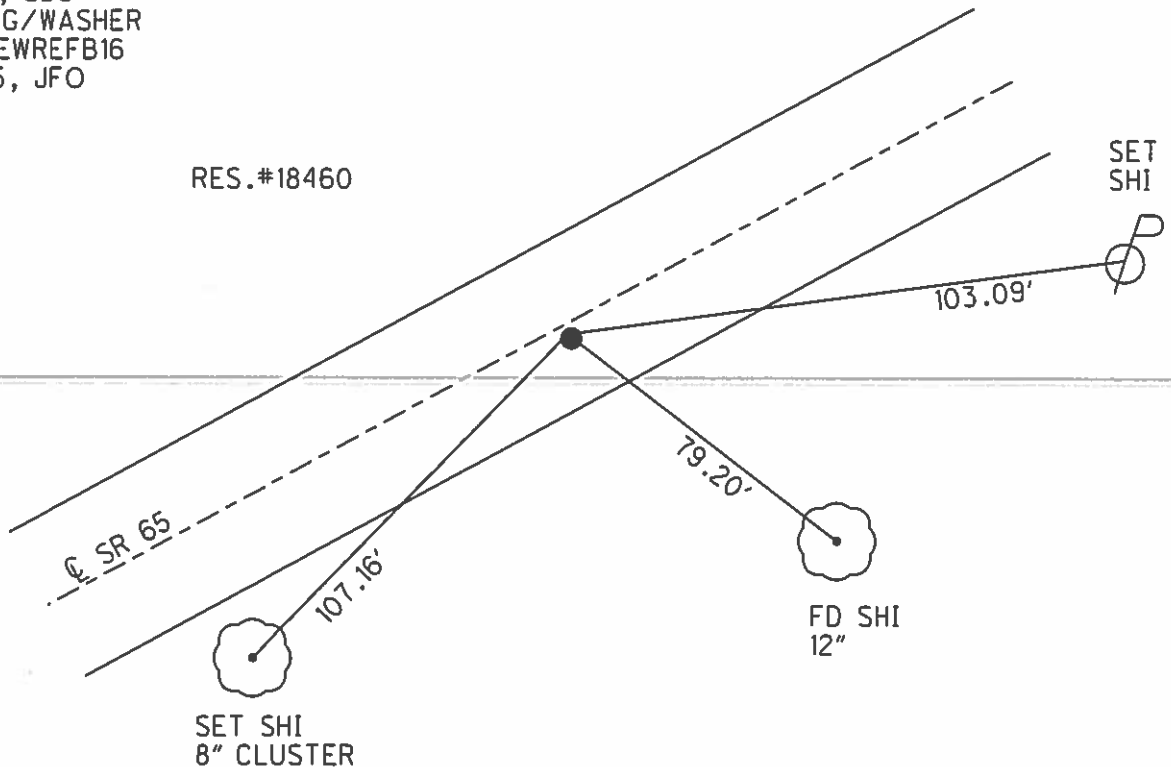

# O.D.O.T. DISTRICT 2 SURVEY OFFICE

PERSONNEL \_\_\_\_\_

REFERENCE NO. \_\_\_\_\_

SHEET 16 OF 34

NOTES BARNHISEL

5/17/04

H.C. VAN DUSEN

DATE 7/16/92

ROUTE 65

R.C. KUSZ

WEATHER cloudy

COUNTY WOOD

BURNETT

TEMP. 75°

TOWNSHIP WASHINGTON

SECTION 19

T 6 N R 10 E

TYPE MONUMENT P.K. + WASHER P.K. + WASHER

16-A

ON SURFACE - BELOW yes yes


16-B

LEFT - & PAV'T. - RIGHT 1.4 2.0

- TO RT EDGE PAVEMENT 9.0 8.0

S.L.M. 421+49


425+38

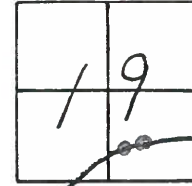

Record:  
 Curve Data 1926  
 P.I. = 324+32.95  
 A = 19°-39' LT.  
 D = 5°-00'  
 T = 198.34  
 R = 1146.28  
 L = 393.00

Reset PK's + WASHERS  
 9-3-92  
 m3

Record:  
 P.T. = 326+27.61  
 Set PK 1972

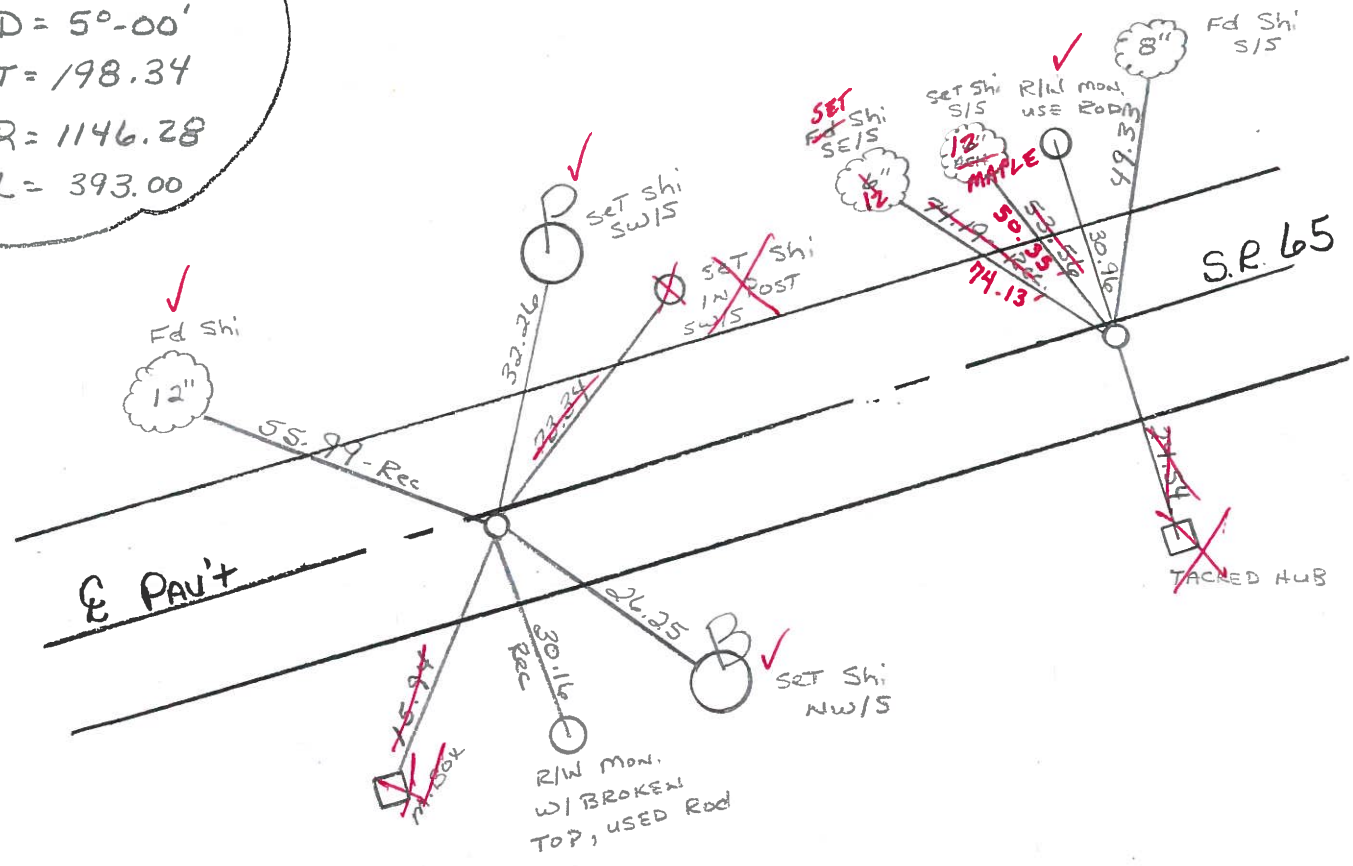

Record:  
 P.C. 322+34.61  
 Set PK 1972

Preventive Maintenance  
 Microsurfaced 2004  
 Existing Point Uncovered  
 Date 8/10/04 MC

SMT-1

ODOT. DISTRICT 2 SURVEY OFFICE

SHEET 16 OF 91

County Wood S.R. 64

Date 4-10-84

Township WASHINGTON

Weather clear

Section 19

Temp. 40°

T6N, R10E

Personnel HOFFMAN


116-A

LOENRKE

HOUSEHOLDER H.C.

116-B

BARHISEL R.S.

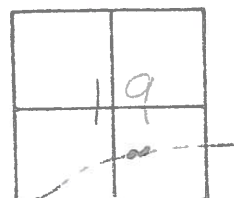

SLM = 425+38

SLM = 421+49

Record:

P.C. 322+34.61  
Set P.K. 1972

Fd. P.K. @ surface  
1.0' RT. of  $\phi$  PAUT  
3.0' TO RT. EP  
13.9' TO Lt. EP

Set PK/WASHER


10-9-84

SUSH

Record:

P.T. 326+27.61  
Set P.K. 1972

Fd. P.K. @ surface  
1.0' RT. of  $\phi$  PAUT  
8.7' TO RT. EP  
10.7' TO Lt. EP

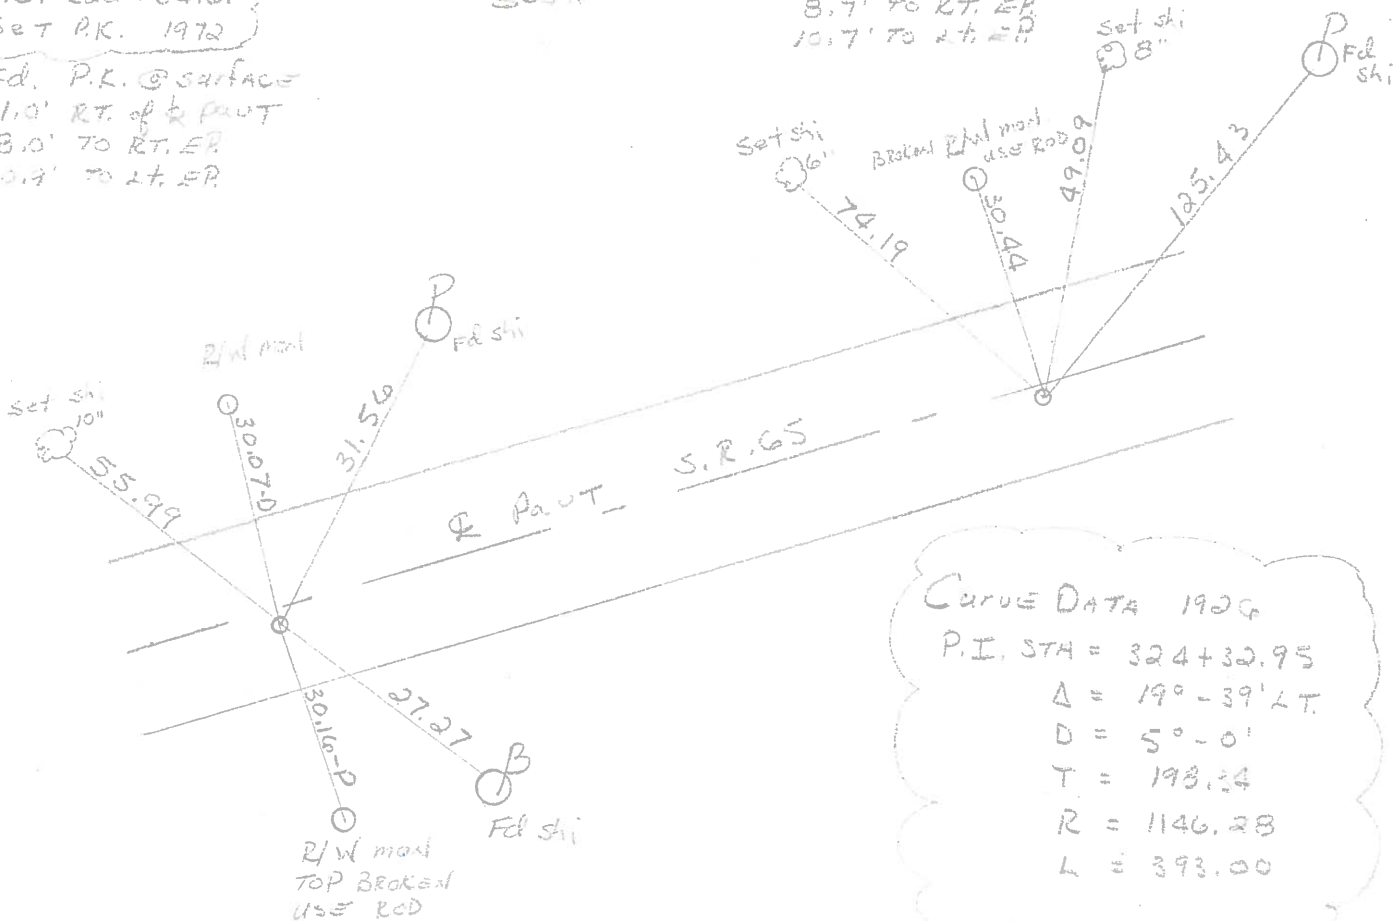

CURVE DATA 1920

P.I. STA = 324+32.95  
 $\Delta = 19^{\circ}-39' LT.$   
D = 5'-0"  
T = 193.24  
R = 1146.28  
L = 393.00


PERSONNEL TITLE PERSONNEL TITLE  
BURNSIDE \_\_\_\_\_  
SMITH \_\_\_\_\_  
BOWERS \_\_\_\_\_

COUNTY Wood DATE 10-30-72

S. R. 65 WEATHER Cloudy

SEC. WASHINGTON TWP TEMP. +40°

DESCRIPTION ESTABLISH & REF. & CONTROL POINTS JOB NO. \_\_\_\_\_

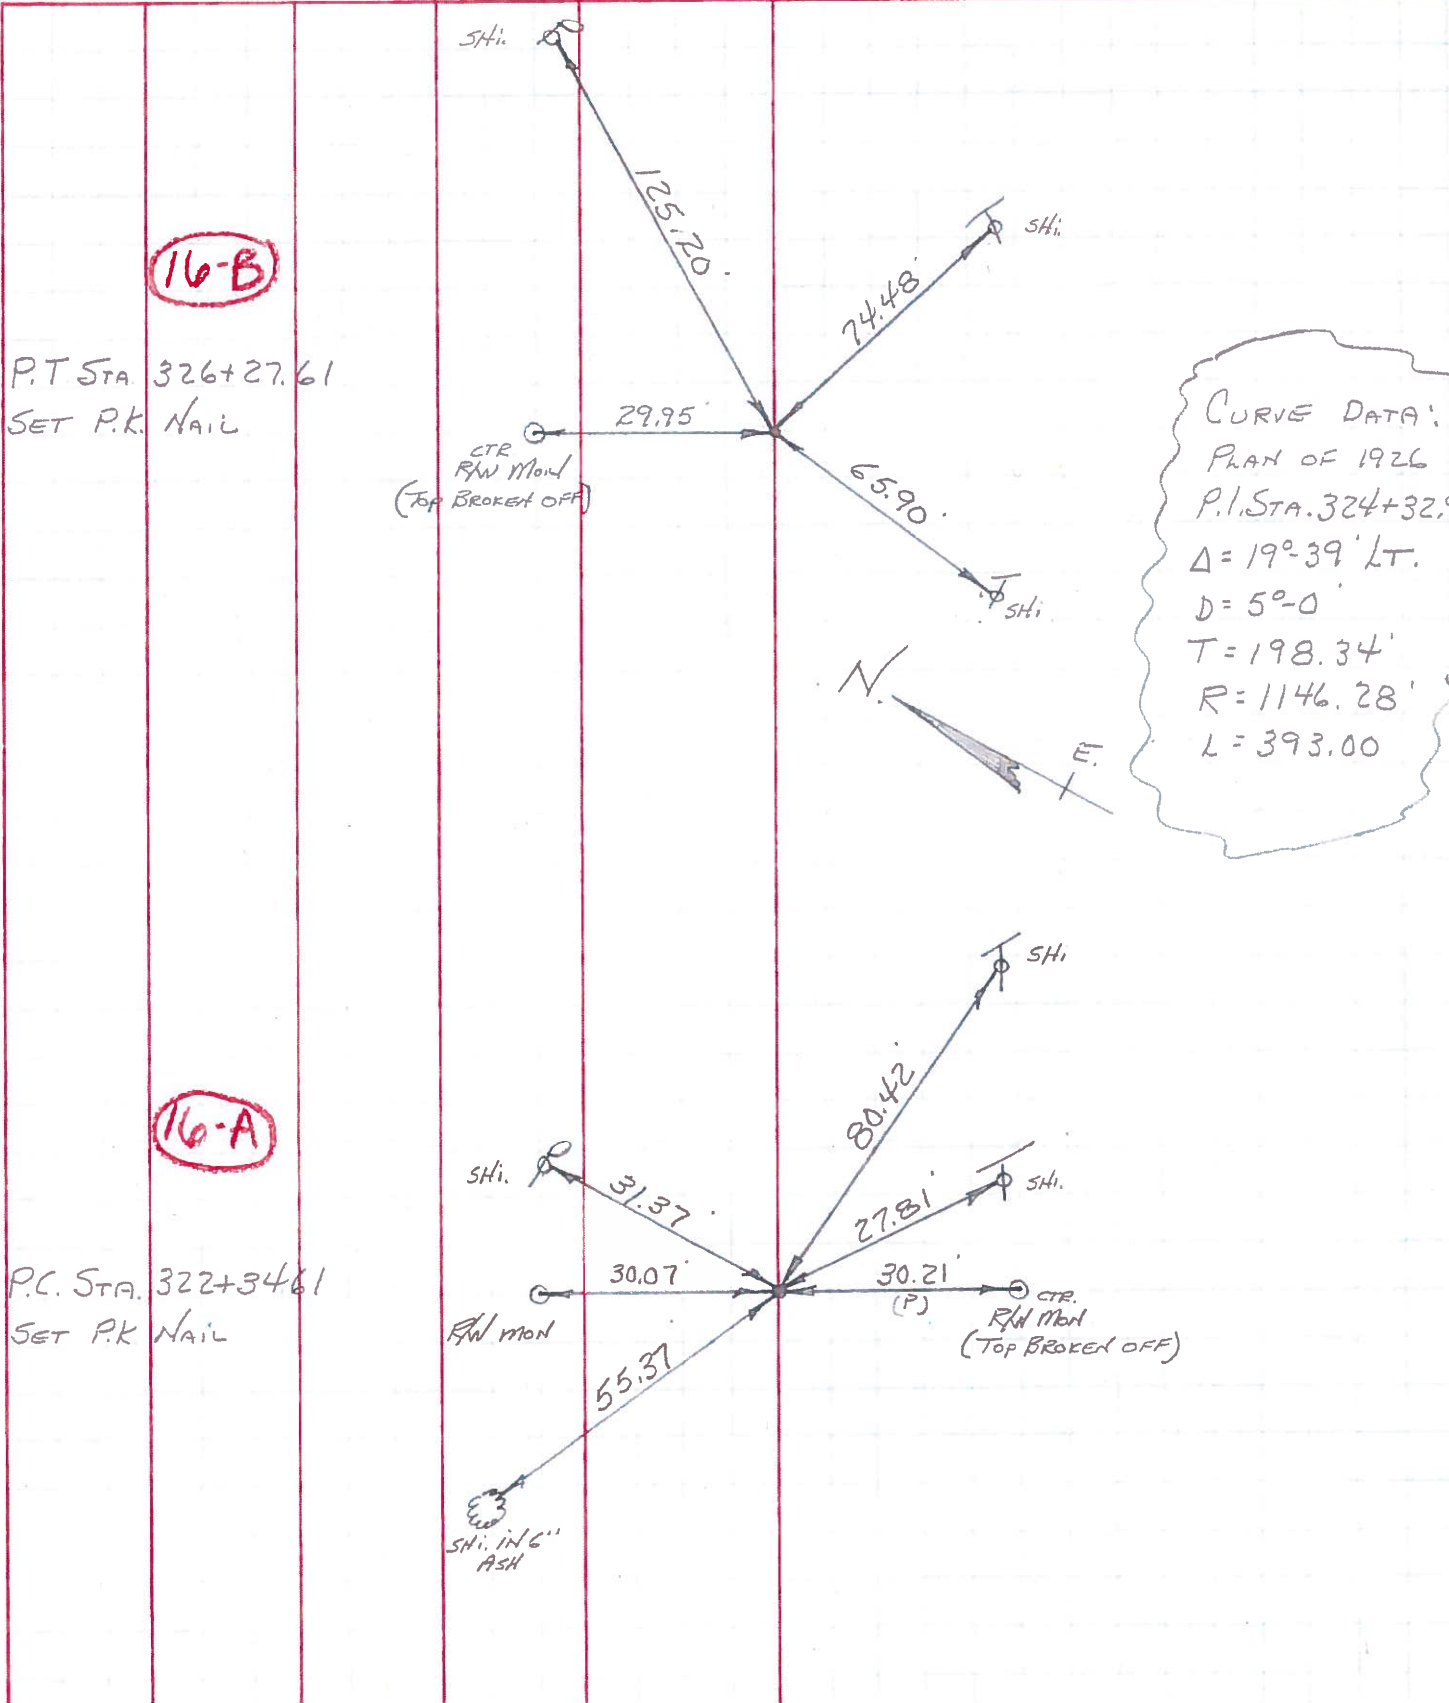

CURVE DATA:  
 PLAN OF 1926  
 P.I. STA. 324+32.5  
 $\Delta = 19^{\circ} 39' LT.$   
 $D = 5^{\circ} - 0'$   
 $T = 198.34'$   
 $R = 1146.28'$   
 $L = 393.00'$