


O.D.O.T. DISTRICT 2 SURVEY OFFICE (USE ONLY)

PERSONNEL	REFERENCE NO. <u>16 C</u>	SHEET <u>32</u> OF <u>63</u>
NOTES	WESTFALL	DATE <u>4/22/15</u>
H.C.	LEU	WEATHER <u>CLOUDY</u>
R.C.	O'DONNELL	TEMP. <u>40°</u>
	RHOADES	
		ROUTE <u>SR 65</u>
		COUNTY <u>WOOD</u>
		TOWNSHIP <u>WASHINGTON</u>
		SECTION <u>19</u>
		T <u>6</u> N R <u>10</u> E


TYPE MONUMENT P.K./WASHER
 ON SURFACE - ~~BELOW~~ ON
 LEFT - PAV'T - ~~RIGHT~~ 1.2'
11.0' TORT EDGE PAVEMENT
 S.L.M. 429+91.85

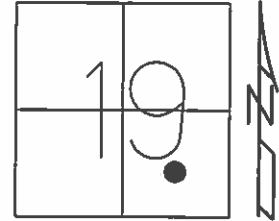

Grid: Northing: 656364.187 Easting: 1624811.628

RECORD: P.C.
 STA. 329+70.26
 SET P.K.NAIL, 1972

FD P.K./WASHER
 7/15/92
 SET P.K./WASHER
 9/3/92, MB
 FD P.K./WASHER
 GPS, REFFC16
 8/6/13, SDC
 SET MAG/WASHER
 GPS, NEWREFFC16
 9/10/15, JFO

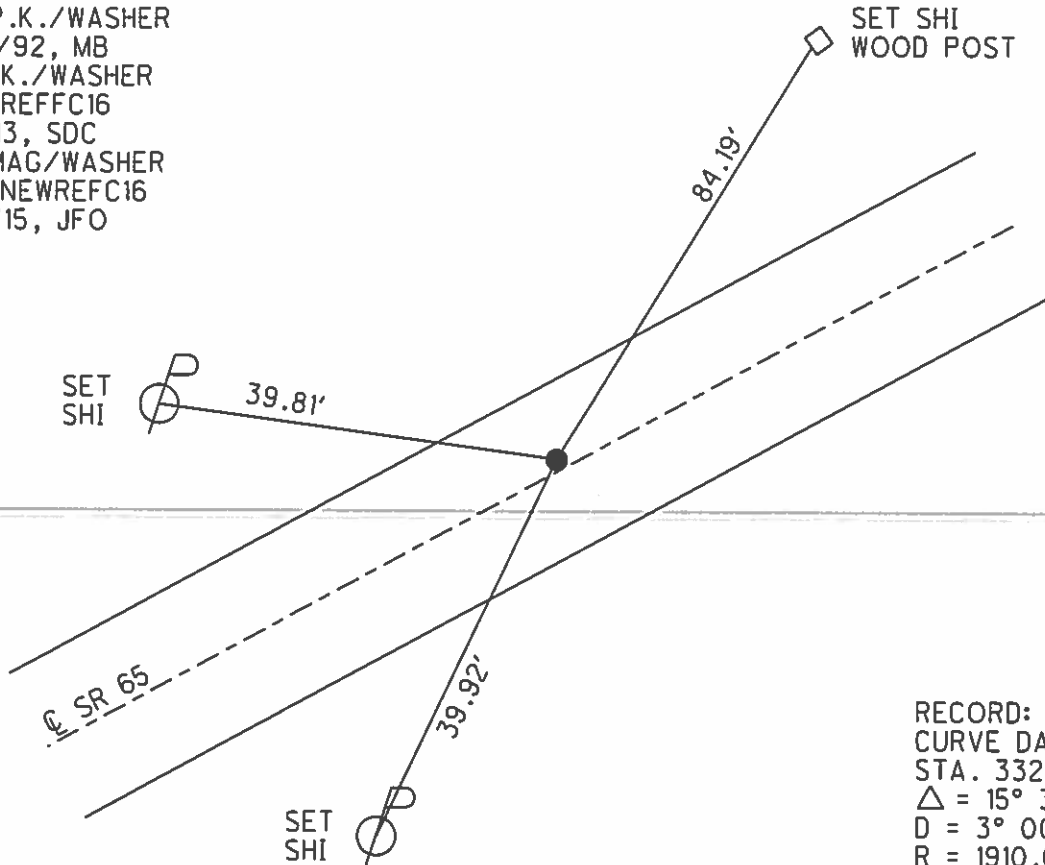

RECORD: P.I.
 CURVE DATA 1926
 STA. 332+31.23
 $\Delta = 15^\circ 33' RT$
 D = $3^\circ 00'$
 R = 1910.08'
 T = 260.77'
 L = 518.33'

O.D.O.T. DISTRICT 2 SURVEY OFFICE

PERSONNEL:

REFERENCE NO. _____

SHEET 17 OF 34

NOTES BARNHISEL

H.C. VAN DUSEN

R.C. KUSZ

BURNETT

DATE 5/17/04

DATE ~~7-16-92~~

WEATHER cloudy

TEMP. +75°

ROUTE 65

COUNTY WOOD

TOWNSHIP WASHINGTON

SECTION 19

T 6 N R 10 E.

TYPE MONUMENT P.C. ✓ P.T.
P.K. + WASHER P.K. + WASHER

ON SURFACE - BELOW yes yes


LEFT- & PAV'T. - RIGHT 1.2 1.0

— TO RT EDGE PAVEMENT 11.0 10.9

S.L.M. 428+81 434+02

(16-C)


(16-D)

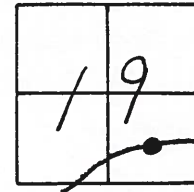

RECORD:
 CURVE DATA 1926
 P.I. = 332+31.23
 Δ = 15°-33' RT.
 D = 3°-00'
 T = 260.77
 R = 1910.08
 L = 518.33

RESET PK'S + WASHERS
 9-3-92
 MB

RECORD:
 P.T. = 334+88.79
 SET PK 1972

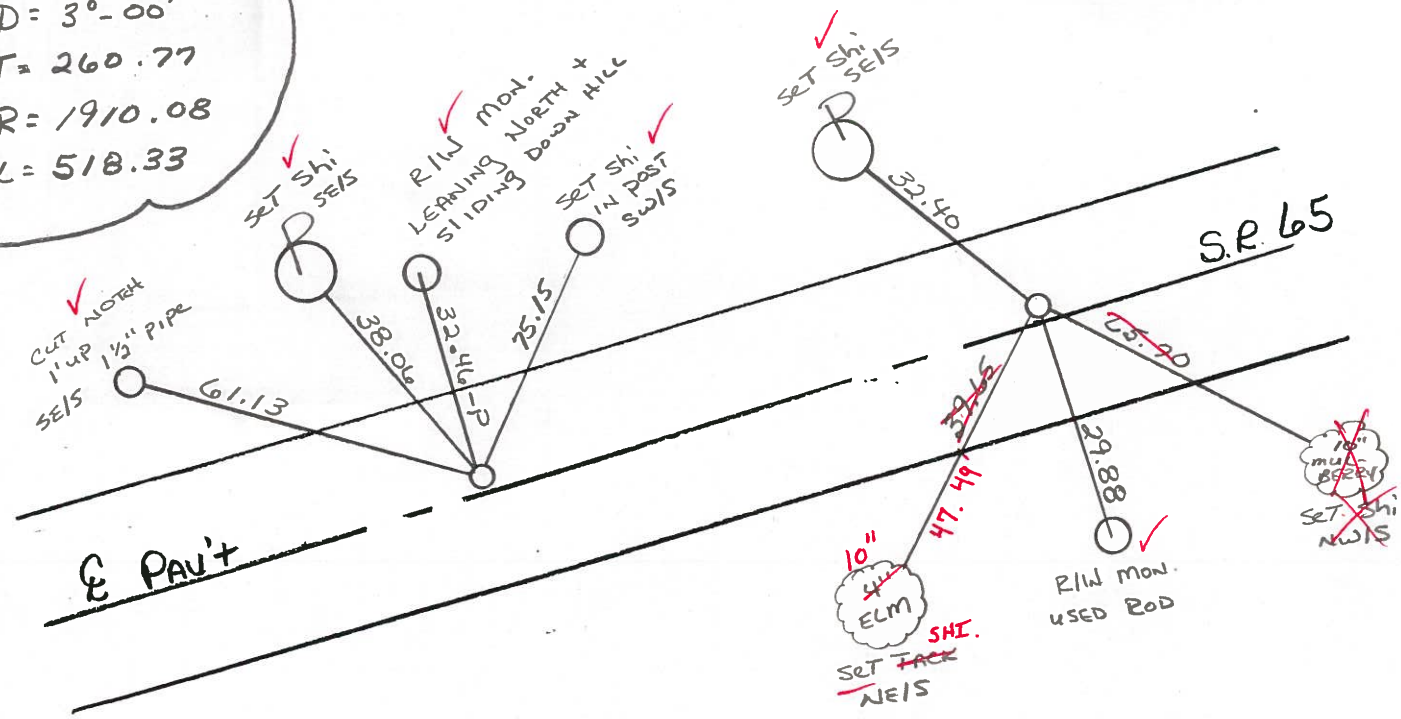

RECORD:
 P.C. = 329+70.46
 SET PK 1972

Preventive Maintenance
 Microsurfaced 2004
 Existing Point Uncovered
 Date 8/10/04 MC

County WOOD S.R. 65

Date 4-10-84

Township WASHINGTON


Weather CLEAR

Section 19

Temp. 45°

T6N, R10E

Personnel HOFFMAN

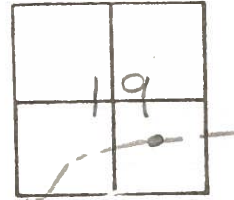

16-C

LOSHZKE

16-D

HOUSEHOLDER H.C.

BARNHISEL R.C.

S.M. = 428 + 82

S.M. = 434 + 02


Record:
P.C. STA = 329 + 70.46
Set P.K. 1972

SET PK/WASHER
10-9-84
SWH.

Record:
P.T. STA. 334 + 88.7
Set P.K. 1972

Fd PK @ surface
ON & PAWT
8.5' TO LT. EP.
9.8' TO RT. EP.

Fd P.K. @ surf.
0.8' LT. of & PAWT
8.9' TO LT. EP.
10.6' TO RT. EP.

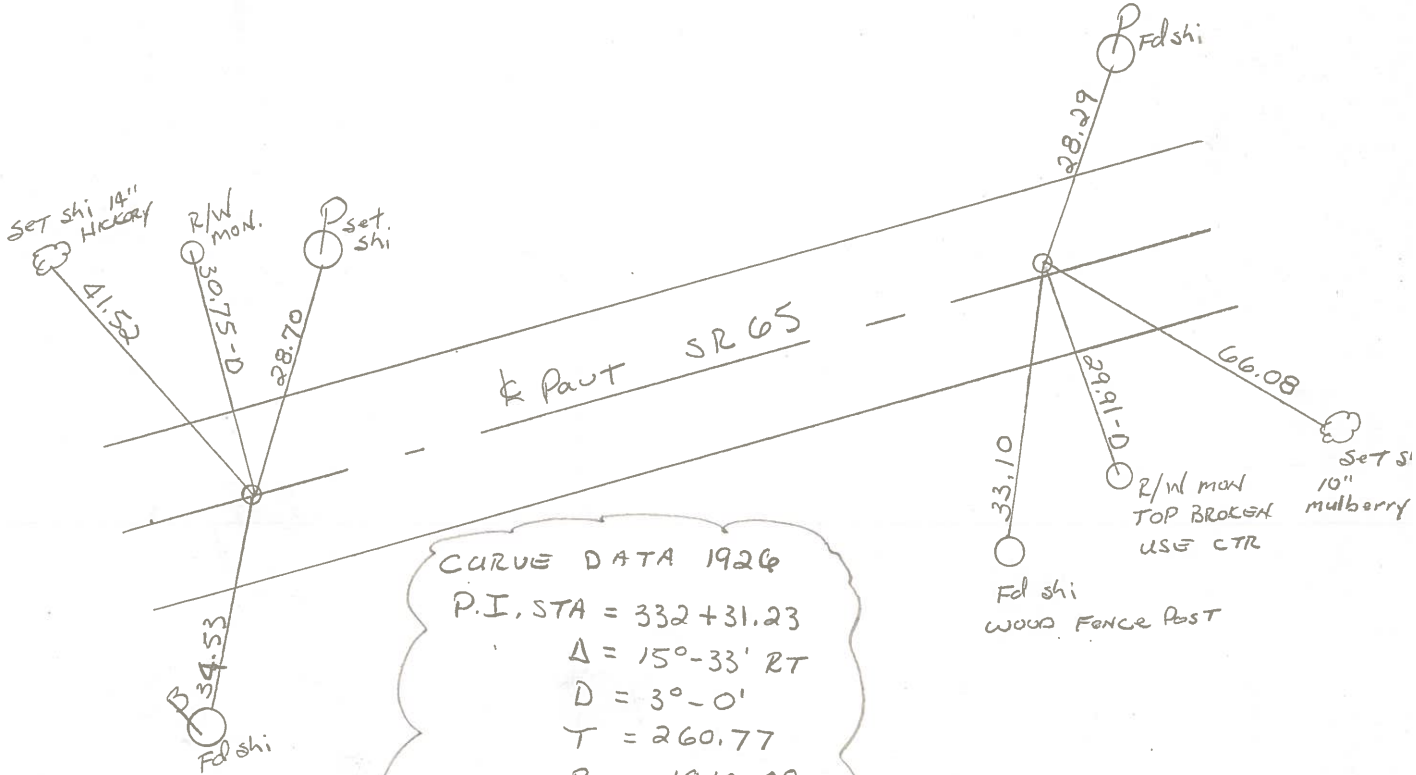

CURVE DATA 1926
P.I. STA = 332 + 31.23
 $\Delta = 15^{\circ}-33'$ RT
D = 3°-0'
T = 260.77
R = 1910.08
L = 518.33

PERSONNEL TITLE PERSONNEL TITLE
 BURNSIDE _____
 SMITH _____
 BOWERS _____

COUNTY Wood DATE 10-31-77

S. R. 65 WEATHER Cloudy

SEC. WASHINGTON TWP TEMP. +42°

DESCRIPTION ESTABLISH & REF. & CONTROL POINTS JOB NO. _____

