

O.D.O.T. DISTRICT 2 SURVEY OFFICE (USE ONLY)

PERSONNEL

REFERENCE NO. 16 D

SHEET 33 OF 63

NOTES WESTFALL

DATE 4/22/15

ROUTE SR 65

H.C. LEU

WEATHER CLOUDY

COUNTY WOOD

R.C. O'DONNELL

TEMP. 40°

TOWNSHIP WASHINGTON

RHOADES

SECTION 19

T 6 N R 10 E

TYPE MONUMENT P.K./WASHER


ON SURFACE - ~~BELOW~~ ON

LEFT - PAV'T - ~~RIGHT~~ 1.0'

10.9' TORT EDGE PAVEMENT


S.L.M. 435+12.57

Grid: Northing: 656563.367 Easting: 1625290.895

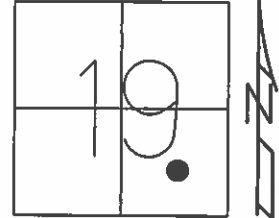

RECORD: P.T.
STA. 334+88.79
SET P.K.NAIL, 1972

FD P.K./WASHER
7/15/92
SET P.K./WASHER
9/3/92, MB
FD P.K./WASHER
GPS, REFFD16
8/6/13, SDC
SET MAG/WASHER
GPS, NEWREFD16
9/10/15, JFO

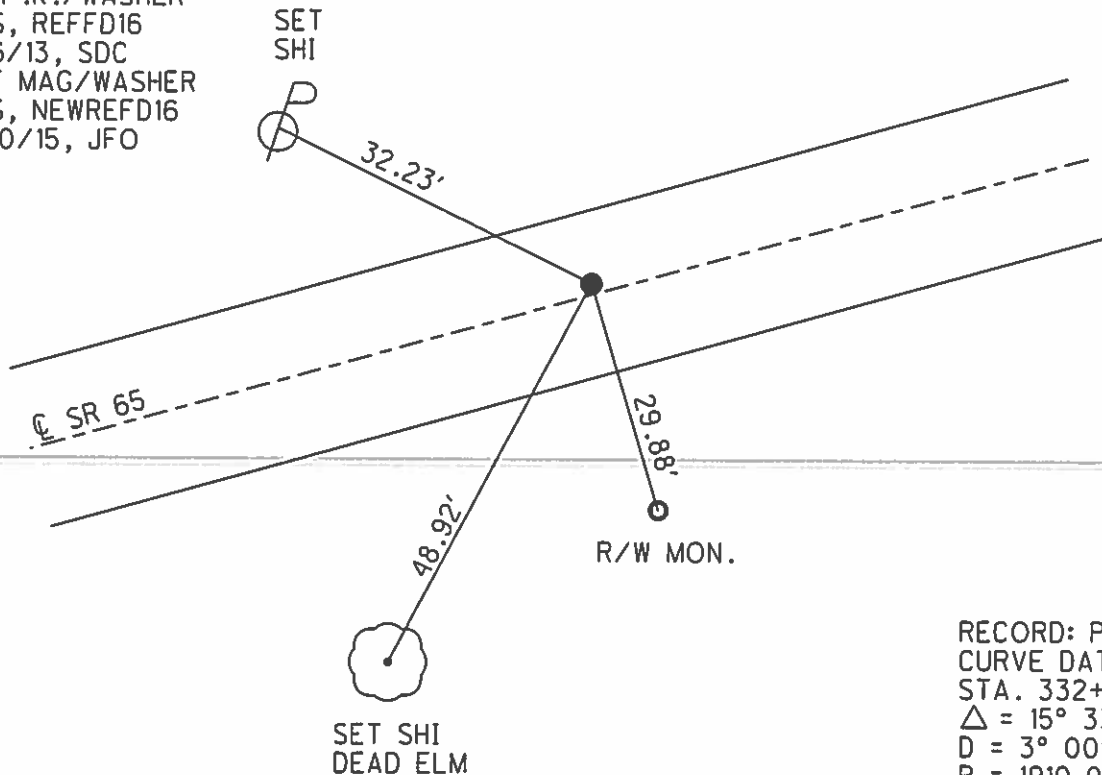

RECORD: P.I.
CURVE DATA 1926
STA. 332+31.23
 $\Delta = 15^\circ 33' RT$
D = $3^\circ 00'$
R = 1910.08'
T = 260.77'
L = 518.33'

O.D.O.T. DISTRICT 2 SURVEY OFFICE

PERSONNEL _____

REFERENCE NO. _____

SHEET 17 OF 36

NOTES BARNHISEL

5/17/04

H.C. VAN DUSEN

DATE 7-16-92

ROUTE 65

R.C. KUSZ

WEATHER cloudy

COUNTY WOOD

BURNETT

TEMP. +75°

TOWNSHIP WASHINGTON


SECTION 19

T 6 N R 10 E.

	P.C.	✓	P.T.
TYPE MONUMENT	<u>P.K. + WASHER</u>		<u>P.K. + WASHER</u>
ON SURFACE - BELOW	<u>yes</u>		<u>yes</u>
LEFT - & PAV'T. - RIGHT	<u>1.2</u>		<u>1.0</u>
— TO RT EDGE PAVEMENT	<u>11.0</u>		<u>10.9</u>
S.L.M.	<u>428+81</u>		<u>434+02</u>

16-C


16-D

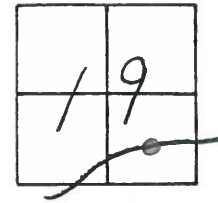

RECORD:
 CURVE DATA 1926
 P.I. = 332+31.23
 Δ = 15° 33' RT.
 D = 3° 00'
 T = 260.77
 R = 1910.08
 L = 518.33

RESET PK'S + WASHERS
 9-3-92
 MB

RECORD:
 P.T. = 334+88.79
 SET PK 1972

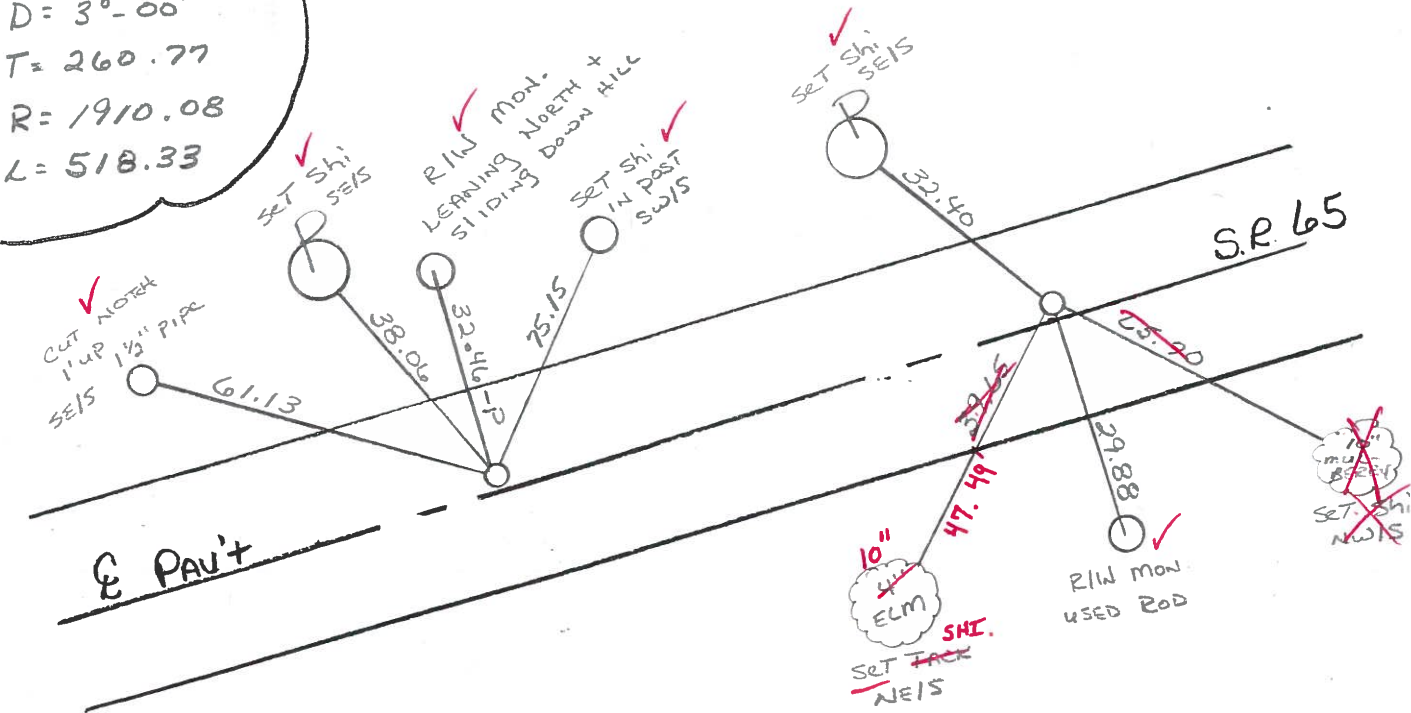

RECORD:
 P.C. = 329+70.46
 SET PK 1972

Preventive Maintenance
 Microsurfaced 2004
 Existing Point Uncovered
 Date 8/10/04 MC

S.M.T. 1.

O.D.O.T. DISTRICT 2 SURVEY OFFICE

SHEET 17 OF 91

County WOOD S.R. 65

Date 4-10-84

Township WASHINGTON

Weather CLEAR

Section 19

Temp. 45°

T6N, R10E

Personnel HOFFMAN


16-C

LOHRE

16-D

HOUSINGER H.C.

BARNHISEL R.C.

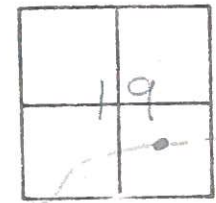

S.M. = 428 + 82

Record:
P.C. STA = 329 + 70.46
Set P.K. 1972


Fd P.K. @ surface
on & paint
8.5' to Lt. EP
9.3' to Rt. EP

SET P.K. WASHBURN
10-9-84
S.M.H.

S.M. = 434 + 02

Record:
P.T. STA. 334 + 86.7
Set P.K. 1972

Fd P.K. @ surf.
0.8' Lt. of & paint
8.9' to Lt. EP
10.6' to Rt. EP

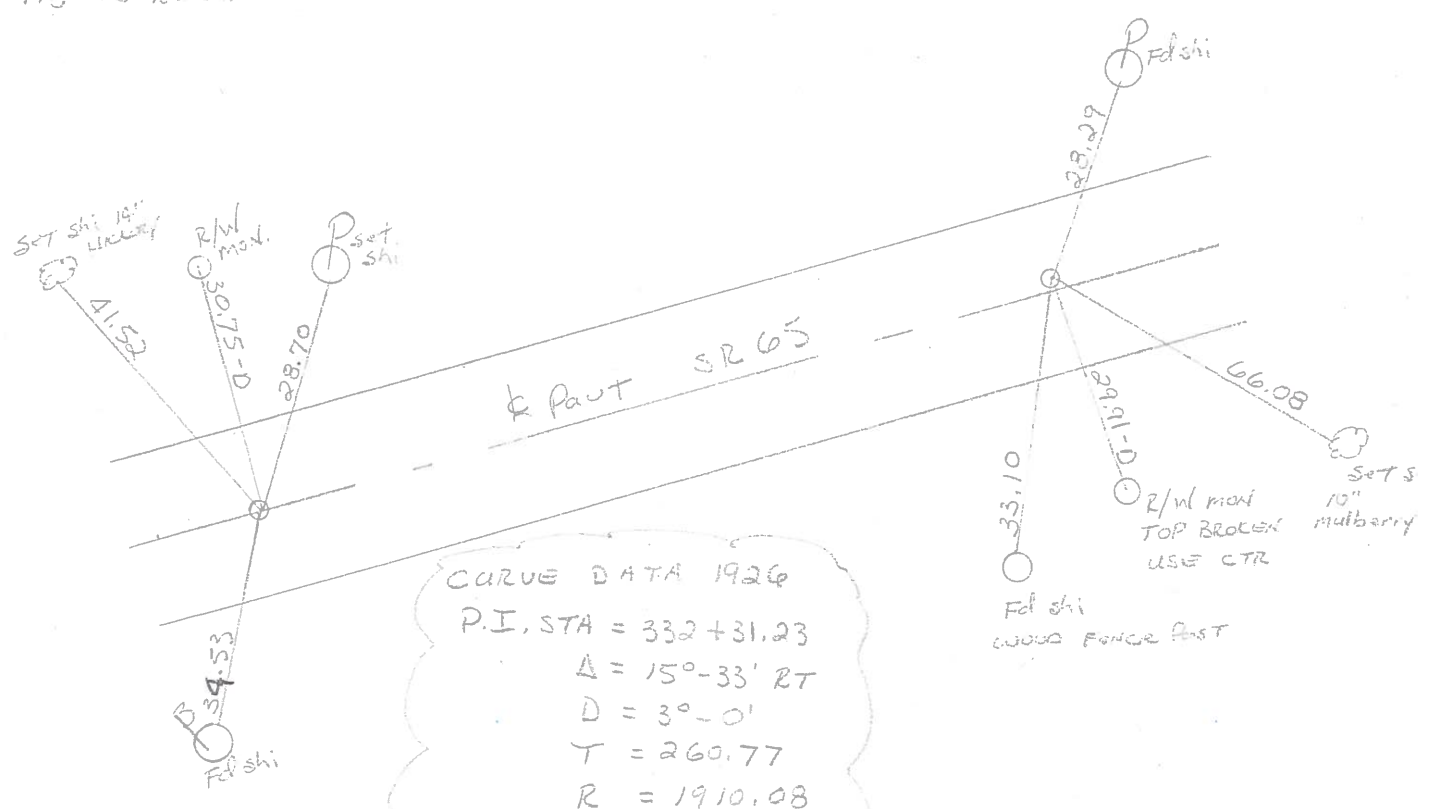

CURVE DATA 1926
P.I. STA = 332 + 31.23
Δ = 15°-33' RT
D = 3°-0'
T = 260.77
R = 1910.08
L = 518.33

PERSONNEL TITLE PERSONNEL TITLE COUNTY WOOD DATE 10-31-72
BURNSIDE _____
SMITH _____ S. R. 65 WEATHER CLOUDY
BOWERS _____ SEC. WASHINGTON TWP TEMP. +42°

DESCRIPTION ESTABLISH & REF. & CONTROL POINTS JOB NO. _____
 LEFT CENTER LINE RIGHT

