
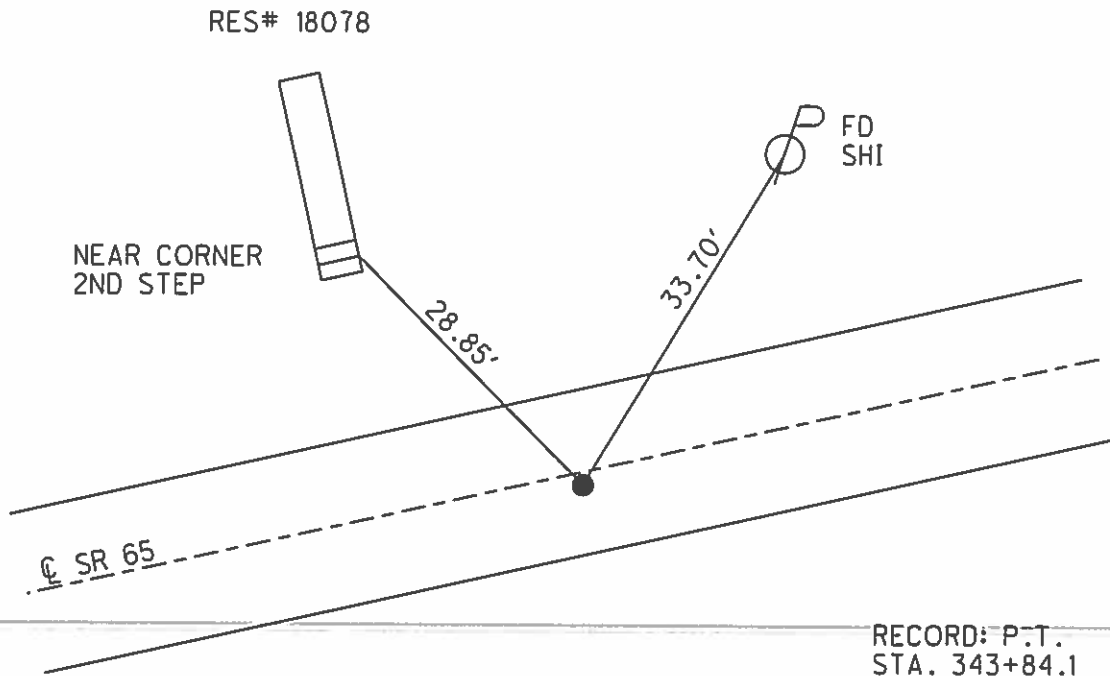


O.D.O.T. DISTRICT 2 SURVEY OFFICE (USE ONLY)

PERSONNEL	REFERENCE NO. <u>16 E</u>	SHEET <u>34</u> OF <u>63</u>
NOTES <u>WESTFALL</u>	DATE <u>4/22/15</u>	ROUTE <u>SR 65</u>
H.C. <u>LEU</u>	WEATHER <u>CLOUDY</u>	COUNTY <u>WOOD</u>
R.C. <u>O'DONNELL</u>	TEMP. <u>40°</u>	TOWNSHIP <u>WASHINGTON</u>
<u>RHOADES</u>		SECTION <u>19</u>
		T <u>6</u> N R <u>10</u> E

TYPE MONUMENT P.K./WASHER
 ON SURFACE - ~~BELOW~~ ON
~~LEFT~~ - PAV'T - RIGHT 1.2'
8.9' TORT EDGE PAVEMENT
 S.L.M. 444+07.72

Grid: Northing: 656563.364 Easting: 1625290.895

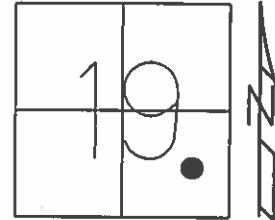

RECORD: P.I.
 CURVE DATA 1926
 STA. 349+80.39
 $\Delta = 15^\circ 48' \text{ LT}$
 $D = 10^\circ 20'$
 $R = 4297.28$
 $T = 596.26$
 $L = 1185.00$

RECORD: P.T.
 STA. 343+84.1
 SET P.K.NAIL, 1972

FD P.K./WASHER
 7/16/92
 SET P.K./WASHER
 9/3//92, MB
 FD P.K./WASHER
 GPS, REFFE16
 8/28/13, SDC
 SET MAG/WASHER
 GPS, NEWREFE16
 9/10/15, JFO

O.D.O.T. DISTRICT 2 SURVEY OFFICE

PERSONNEL _____

REFERENCE NO. _____

SHEET 18 OF 34

NOTES BARNHISEL

H.C. VAN DUSEN

R.C. KUSZ

BURNETT

DATE 5/17/04

DATE ~~9-16-92~~

WEATHER cloudy

TEMP. +75°

ROUTE 65

COUNTY WOOD

TOWNSHIP WASHINGTON

SECTION 19

T. 6 N. R. 10 E

TYPE MONUMENT P.C. PK + WASHER


ON SURFACE - ~~BELOW~~ YES

~~LEFT~~ - PAV'T. - RIGHT 1.2

8.9 TO RT EDGE PAVEMENT


S.L.M. 442+97

16-E

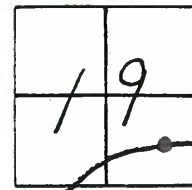

RECORD:
 CURVE DATA 1926
 P.I. = 349+80.39
 Δ = 15°-48' LT.
 D = 10°-20'
 T = 596.26
 R = 4297.28
 L = 1185.00

RECORD:
 P.C. = 343+84.1
 SET PK 1972

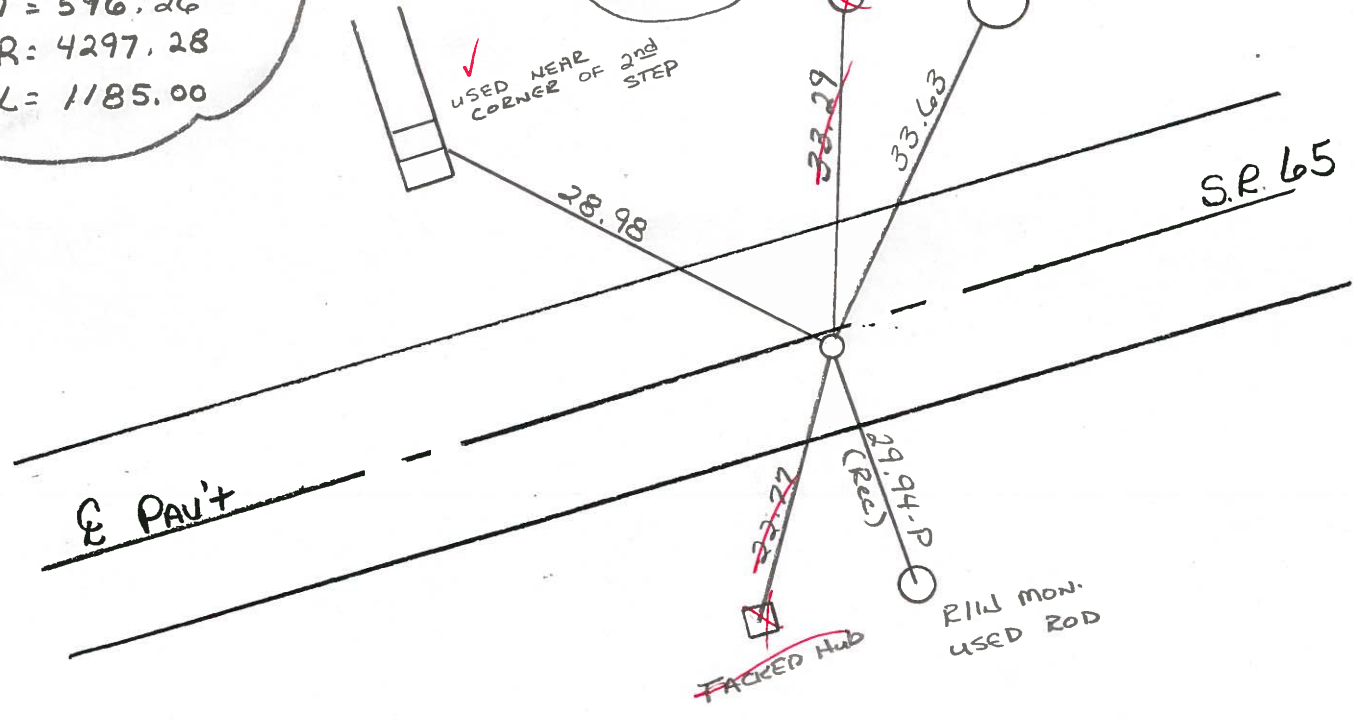

Reset PK + WASHER
 9-3-92
 m13

Preventive Maintenance
 Microsurfaced 2004
 Existing Point Uncovered
 Date 8/10/04 MC

County Wood S.R. 65

Date 4-10-84

Township WASHINGTON

Weather Clear

Section 19

Temp. 45°

T6N, R10E


Personnel HOFFMAN

16-E

LOEHRKE

HOUSEHOLDER H.C.

BARHISEL R.C.

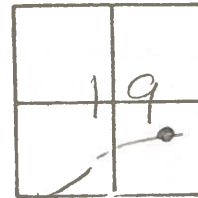

Fd P.K. Nail @ surface

SLM = 442+94

1.1' RT. of & Paut

SET PK/WASHER

8.6' TO RT. EP

10-9-84


10.5' TO LT EP

S.W.H.

Record:

P.C. STA = 343+84.1

Set P.K. 1972

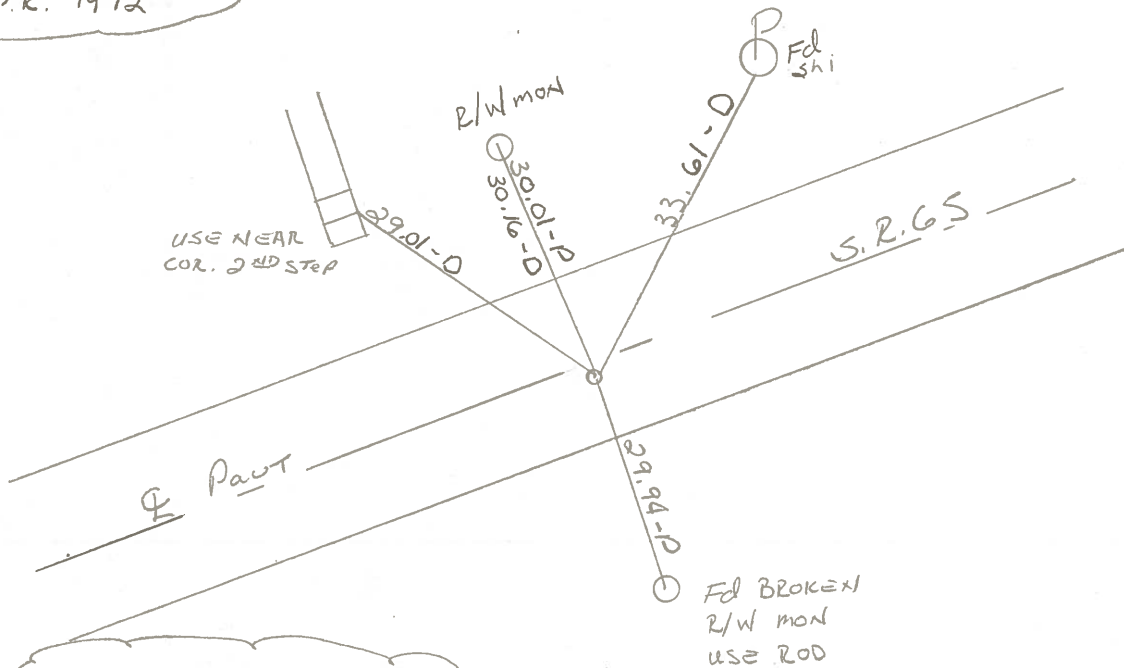

CURVE DATA 1926

P.I. STA = 349+80.39

Δ = 15°-48' LT.

D = 10-20'

T = 596.29'

R = 4297.28

L = 1185.00

PERSONNEL TITLE PERSONNEL TITLE

BURNSIDE
SMITH
BOWERS

COUNTY Wood

DATE 11-6-72

S. R. 65

WEATHER CLEAR


SEC. MIDDLETON TWP

TEMP. 57°

DESCRIPTION ESTABLISH & REF. & CONTROL POINTS

JOB NO.

LEFT CENTER LINE RIGHT

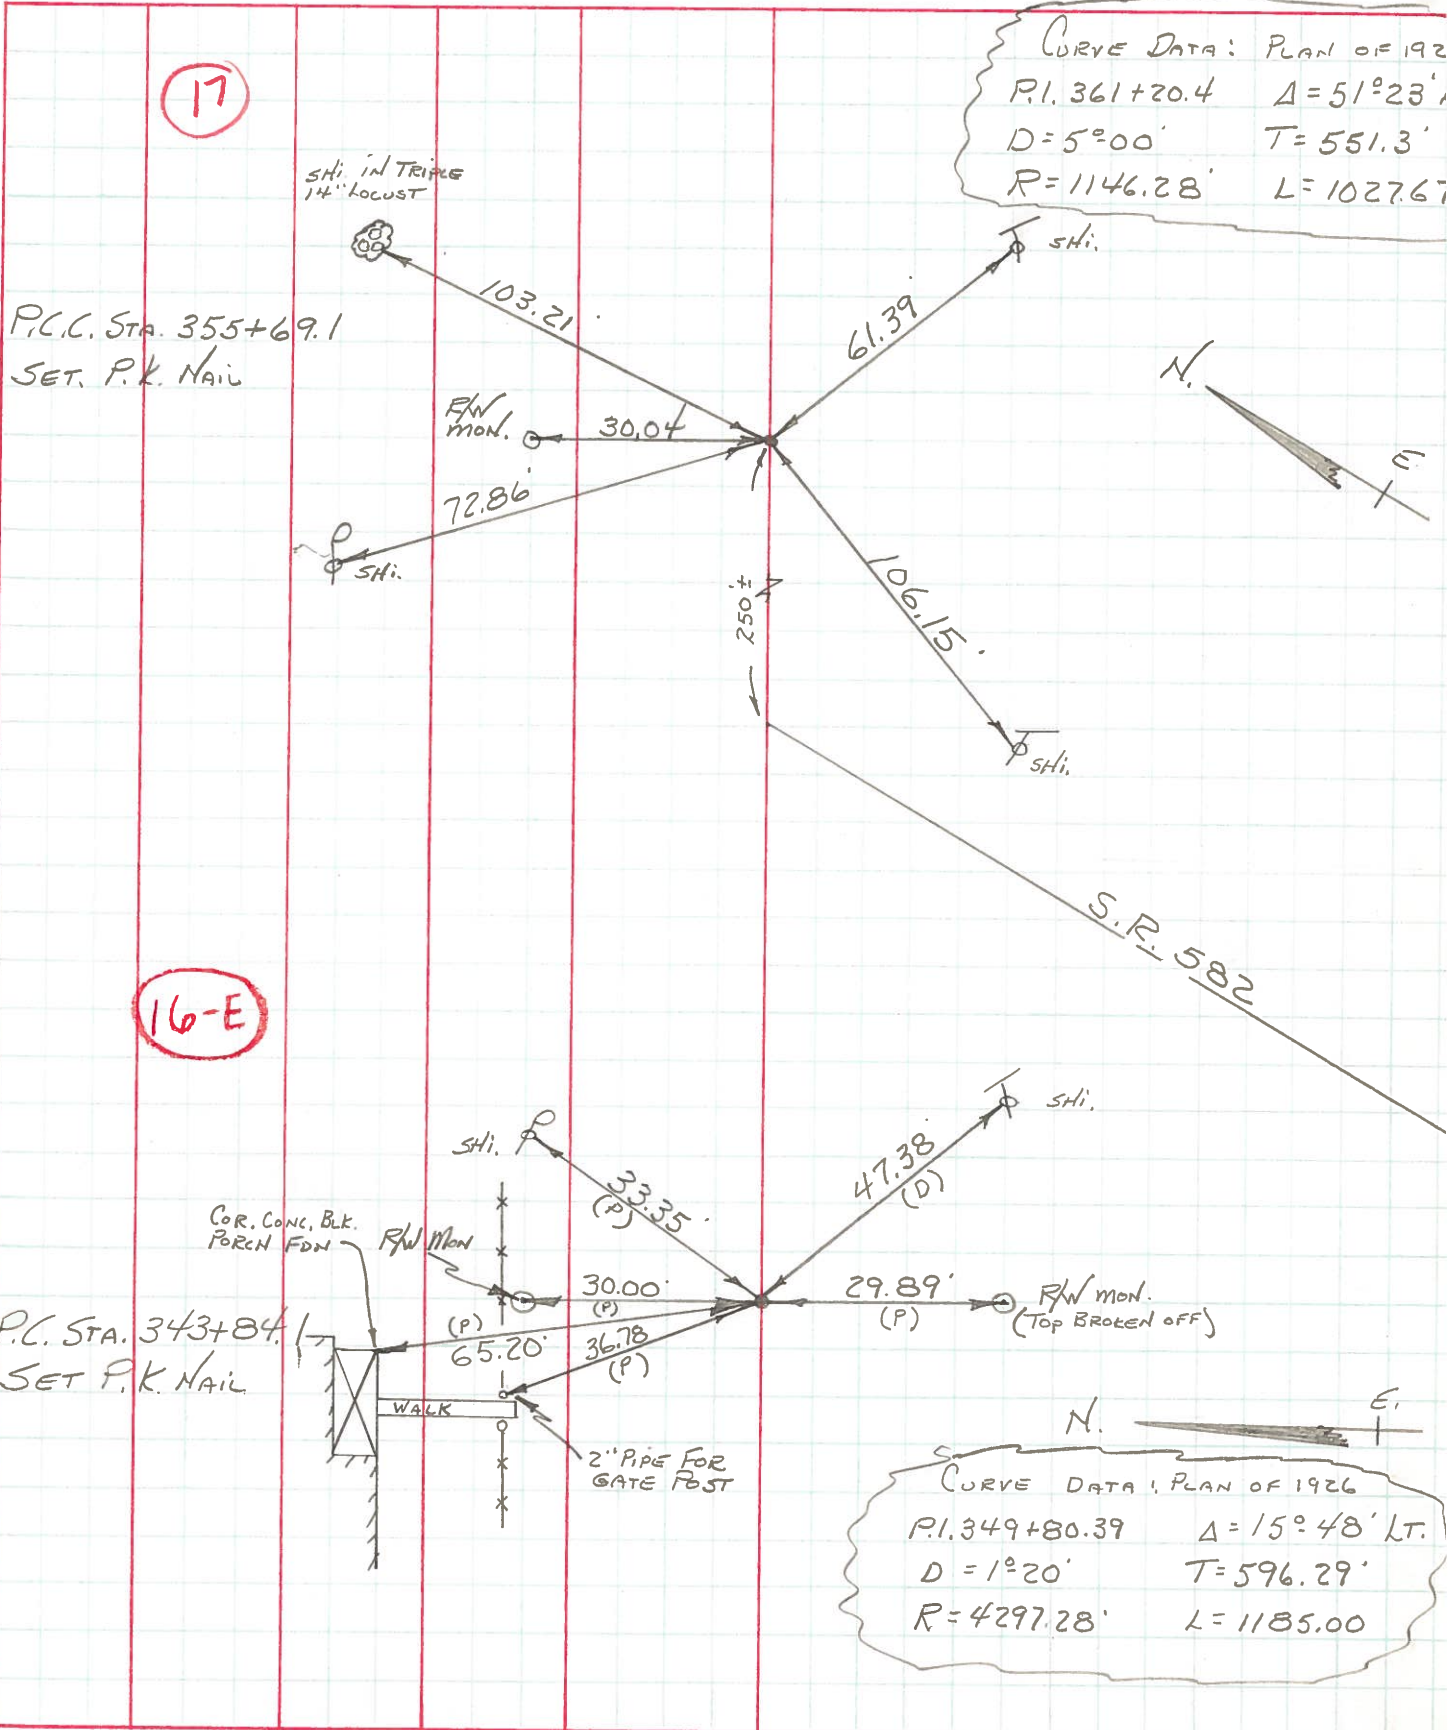

17

P.C.C. STA. 355+69.1
SET P.K. NAIL

CURVE DATA: PLAN OF 1926
 P.I. 361+20.4 Δ=51°23'
 D=5°00' T=551.3'
 R=1146.28' L=1027.6'

16-E

P.C. STA. 343+84.1
SET P.K. NAIL

CURVE DATA, PLAN OF 1926
 P.I. 349+80.39 Δ=15°48' LT.
 D=1°20' T=596.29'
 R=4297.28' L=1185.00