


O.D.O.T. DISTRICT 2 SURVEY OFFICE (USE ONLY)


PERSONNEL	REFERENCE NO. <u>17</u>	SHEET <u>36</u> OF <u>63</u>
NOTES	WESTFALL	DATE <u>4/21/15</u>
H.C.	O'DONNELL	WEATHER <u>CLOUDY</u>
R.C.	LEU	TEMP. <u>40°</u>
	RHOADES	
		ROUTE <u>SR 65</u>
		COUNTY <u>WOOD</u>
		TOWNSHIP <u>MIDDLETON</u>
		SECTION <u>20</u>
		T <u>6</u> N R <u>10</u> E

TYPE MONUMENT P.K./WASHER
 ON SURFACE - ~~BELOW~~ ON
~~LEFT~~ - PAV'T - RIGHT 2.5'
7.6' TORT EDGE PAVEMENT
 S.L.M. 455+90.21

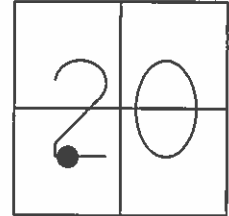

Grid: Northing: 657247.092 Easting: 1627243.735

RECORD: P.I.
 CURVE DATA 1926
 STA. 361+20.4
 $\Delta = 51^\circ 23' \text{ LT}$
 $D = 5^\circ 00'$
 $R = 1146.28$
 $T = 551.30$
 $L = 1027.67$

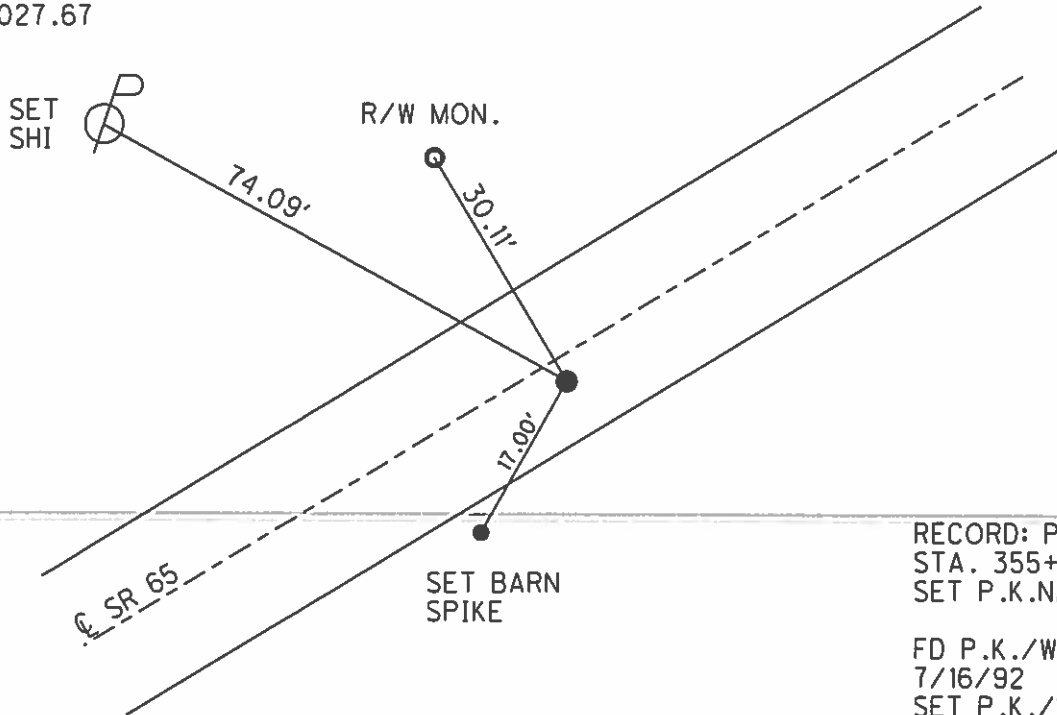

RECORD: P.C.C.
 STA. 355+69.1
 SET P.K.NAIL, 1972

FD P.K./WASHER
 7/16/92
 SET P.K./WASHER
 9/3//92, MB
 FD P.K./WASHER
 GPS, REF17
 8/29/13, SDC
 SET MAG/WASHER
 GPS, NEWREF17
 9/11/15, JFO

O.D.O.T. DISTRICT 2 SURVEY OFFICE


PERSONNEL

NOTES BARNHISEL
 H.C. VAN DUSEN
 R.C. KUSZ
BURNETT

REFERENCE NO. 17
5/25/04
 DATE 7-16-92
 WEATHER CLOUDY
 TEMP. +75°


SHEET 21 OF 34
 ROUTE 65
 COUNTY WOOD
 TOWNSHIP WASHINGTON
 SECTION 20
T 6 N R 10 E

TYPE MONUMENT P.C.C. P.K. + WASHER ✓
 ON SURFACE - BELOW yes
~~PAV'T.~~ - & PAV'T. - RIGHT 2.5
2.6 TO RT EDGE PAVEMENT
 S.L.M. 454 + 82

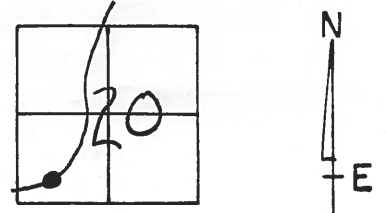

Record:
 CURVE DATA 1926
 P.I. = 361 + 20.4
 A = 51° - 23' LT.
 D = 5° - 00'
 T = 551.30
 R = 1146.28
 L = 1027.67

Record
 P.C.C. = 355 + 69.1
 Set PK 1972

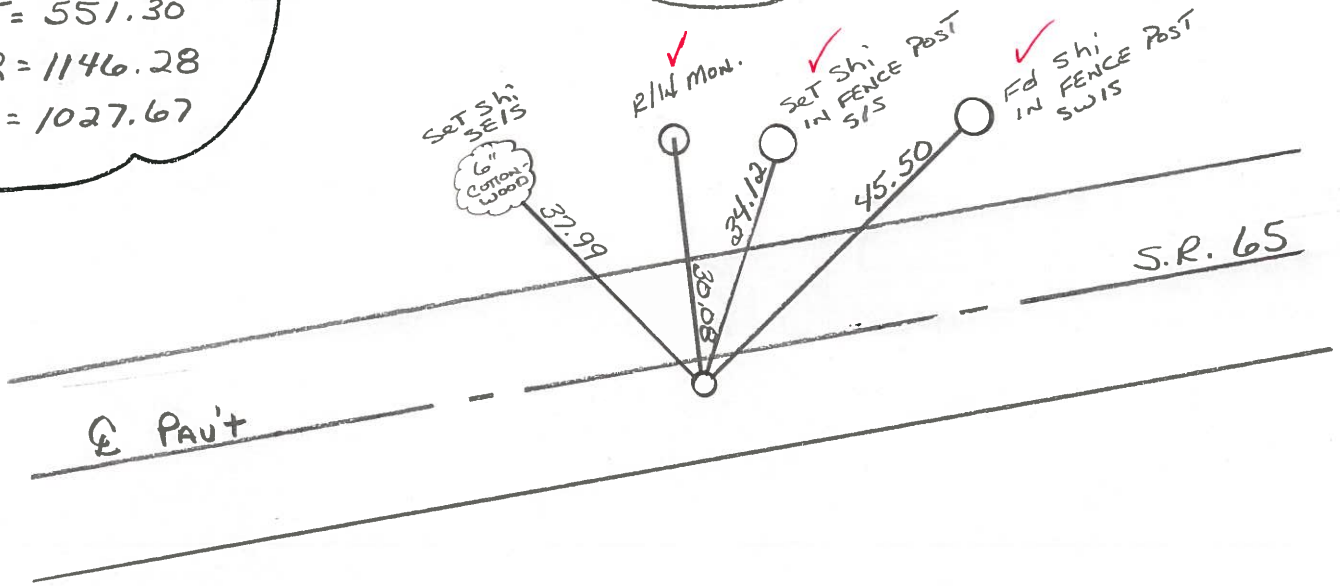

Reset PK + WASHER
 9-3-92
 MB

Preventive Maintenance
 Microsurfaced 2004
 Existing Point Uncovered
 Date 8/9/04 MC

County WOOD S.R. 65

Date 4-10-84

Township MIDDLETON

Weather clear

Section 20

Temp. 45°


T6N, R10E

Personnel HOFFMAN

LOENRKE

HOUSEHOLDER H.C.

BARNHISEL R.C.

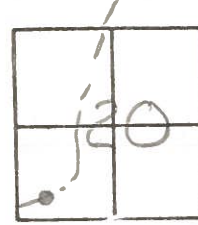

#17

Fd P.K. @ surface

- 1.2' Rt. of & Pavt.
- 7.4' to Rt. EP
- 10.2' to Lt. EP


SLM 454+81

SET PK/WASHER

10-9-84
S.W.H.

RECORD:

P.C.C. STA=355+69.1
Set P.K. 1972

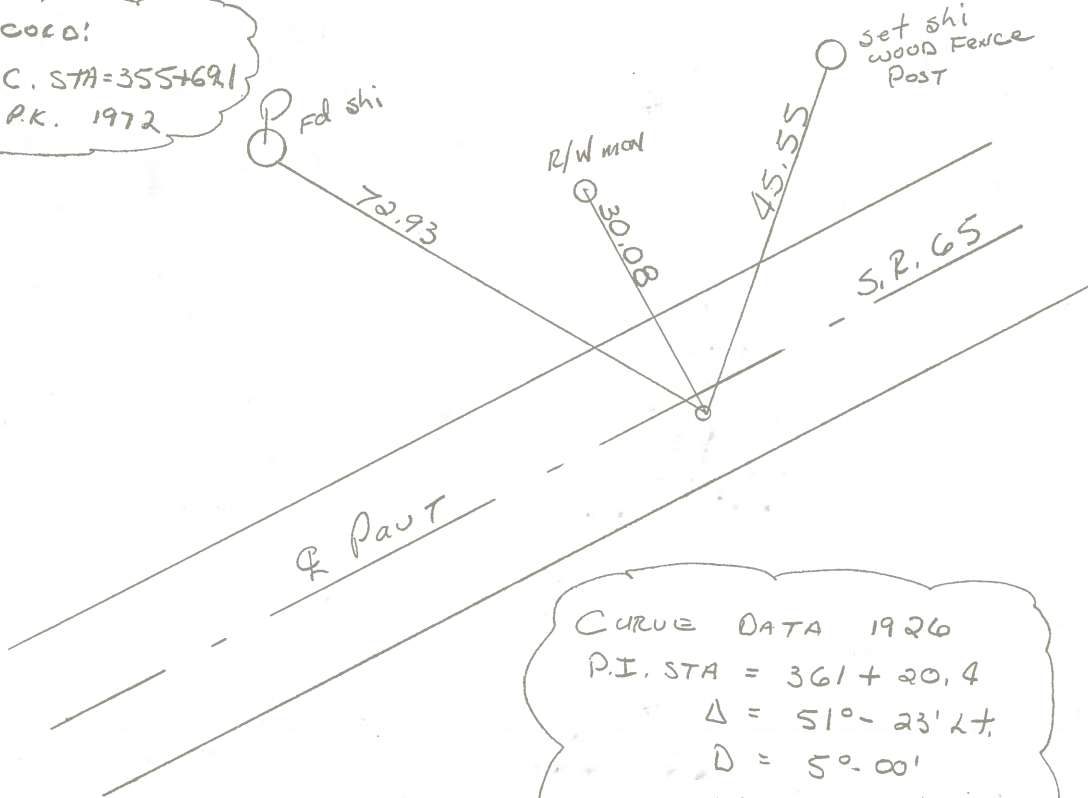

CURVE DATA 1926

P.I. STA = 361+20.4

$\Delta = 51^{\circ} - 23' \text{ Lt.}$

D = 50.00'

T = 551.3'

R = 1146.28

L = 1027.67

PERSONNEL BURNSIDE TITLE _____ PERSONNEL SMITH TITLE _____
 COUNTY WOOD DATE 11-6-72
 S. R. 65 WEATHER CLEAR
 SEC. MIDDLETON TWP TEMP. 57°

DESCRIPTION ESTABLISH & REF. & CONTROL POINTS JOB NO. _____

