

O.D.O.T. DISTRICT 2 SURVEY OFFICE (USE ONLY)

PERSONNEL

REFERENCE NO. 17 C


SHEET 39 OF 63

NOTES WESTFALL  
 H.C. O'DONNELL  
 R.C. LEU  
RHOADES

DATE 4/21/15  
 WEATHER CLOUDY  
 TEMP. 30°

ROUTE SR 65  
 COUNTY WOOD  
 TOWNSHIP MIDDLETON  
 SECTION 20  
 T 6 N R 10 E


TYPE MONUMENT P.K.NAIL  
 ON SURFACE - ~~BELOW~~ ON  
 LEFT - PAV'T - ~~RIGHT~~ 2.4'  
7.1' TOLT EDGE PAVEMENT  
 S.L.M. 471+68.32

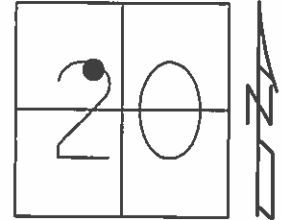

Grid: Northing: 658610.904 Easting: 1627902.376

RECORD: P.T.  
 STA. 371+78.69  
 SET P.K.NAIL, 1972

FD P.K./WASHER  
 7/16/92  
 SET P.K./WASHER  
 9/3//92, MB  
 FD P.K./WASHER  
 GPS, REFC17  
 8/6/13, SDC  
 SET MAG/WASHER  
 GPS, NEWREFC17  
 9/11/15, JFO

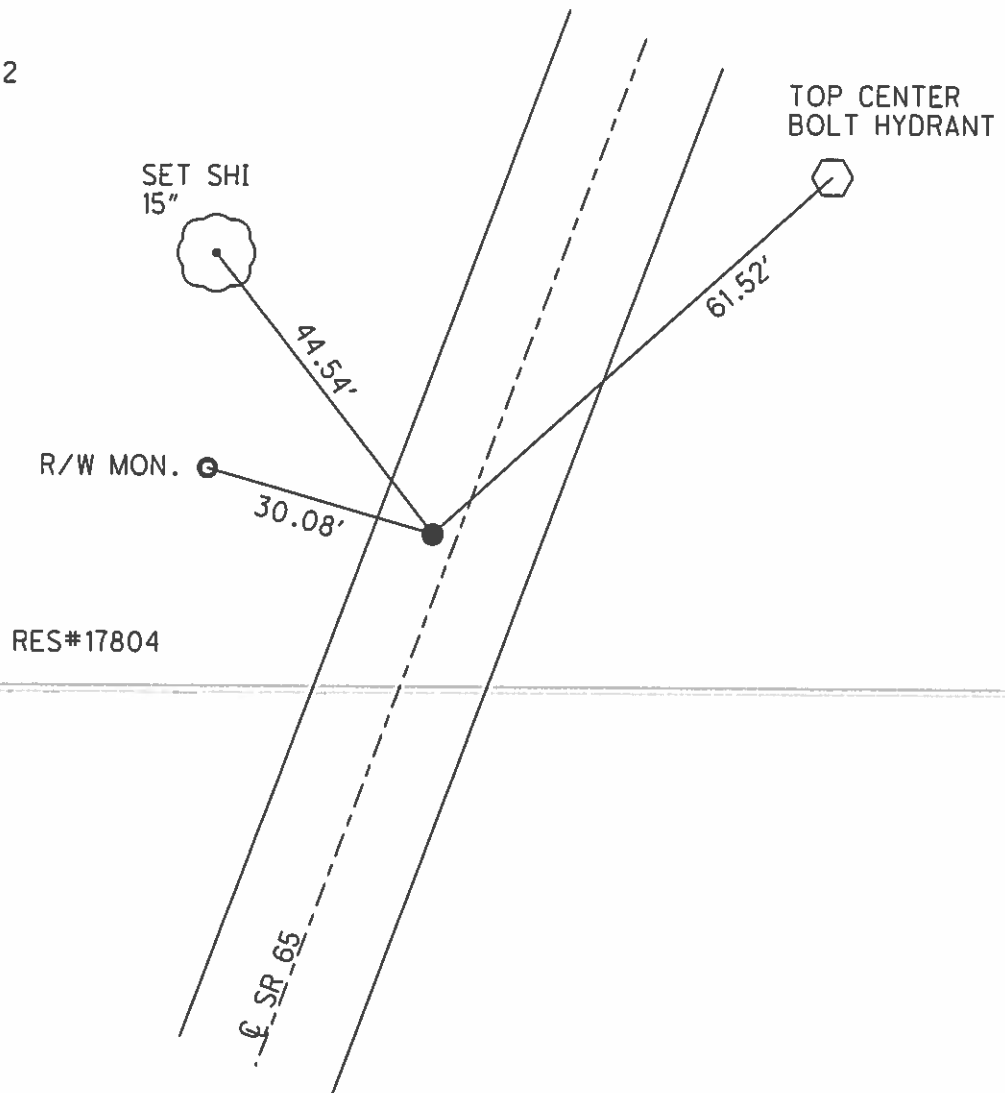

RECORD: P.I.  
 CURVE DATA 1926  
 STA. 370+79.2  
 $\Delta = 18^{\circ}05'$  RT  
 D =  $9^{\circ}00'$   
 R = 637.28  
 T = 101.41  
 L = 200.90

# O.D.O.T. DISTRICT 2 SURVEY OFFICE

PERSONNEL

REFERENCE NO. \_\_\_\_\_

SHEET 23 OF 34

NOTES BARNHISEL

5/25/04

H.C. VAN DUSEN

DATE 7-16-92

ROUTE 65

R.C. KUSZ

WEATHER cloudy

COUNTY WOOD

BURNETT

TEMP. +75°

TOWNSHIP WASHINGTON

SECTION 20

T 6 N R 10 E

TYPE MONUMENT PK + WASHER PK + WASHER

ON SURFACE - BELOW yes yes


LEFT- & PAV'T. - RIGHT 2.3 2.4

- TO LT EDGE PAVEMENT 2.9 2.1

S.L.M. 468+57 470+56

17-B


17-C

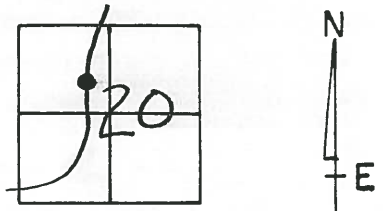

RECORD!  
 CURVE DATA 1926  
 P.I. = 370+79.2  
 $\Delta = 18^{\circ} - 05' RT$   
 $D = 9^{\circ} - 00'$   
 $T = 101.41$   
 $R = 637.28$   
 $L = 200.90$

RECORD!  
 P.T. = 371+78.69  
 SET PK 1972

Preventive Maintenance  
 Microsurfaced 2004  
 Existing Point Uncovered  
 Date 8/9/04 MC

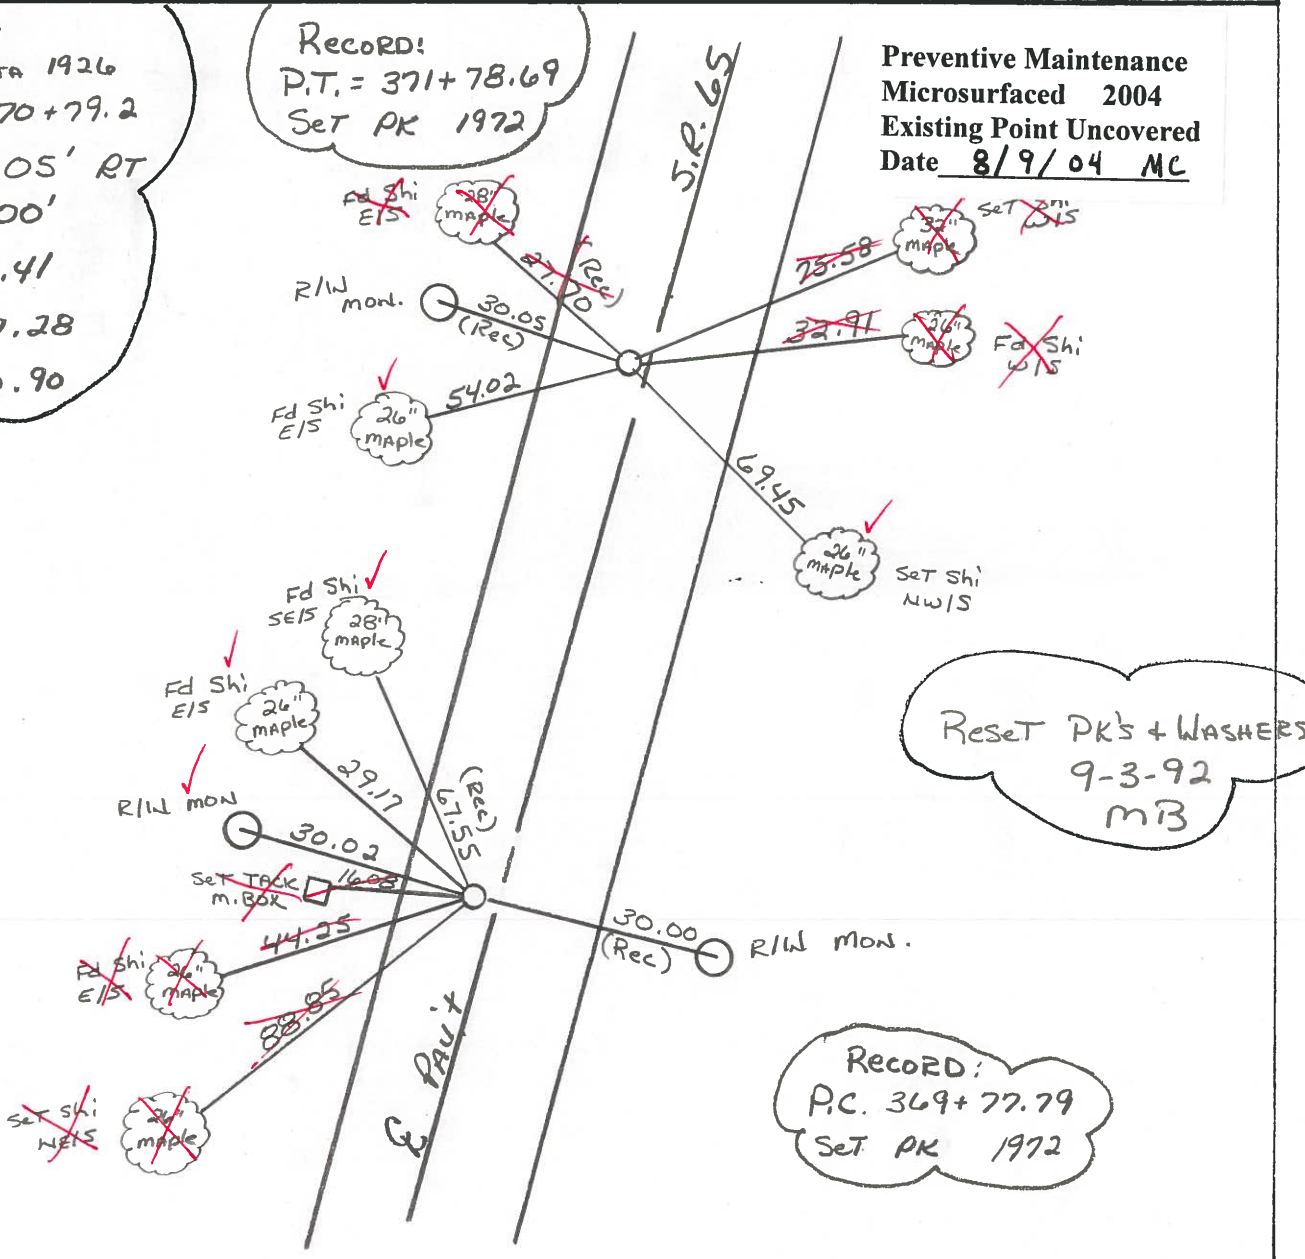

County WOOD S.R. 65

Date 4-10-84

Township MIDDLETON


Weather Clear

Section 20

Temp. 50°

T&N, R10E

Personnel HOFFMAN

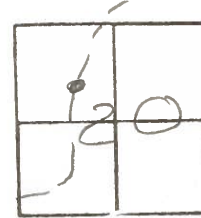

**17-B**

LOSHRKE

**17-C**

HOUSEHOLDER H.C.

BARNHISEL R.C.

SET PK/WASHER  
@ BOTH POINTS


10-10-84  
GWH

SLM = 468+57  
Fd P.K. @ surface  
1.8' Lt. of Paut  
6.8' to Lt. EP  
11.8' to Rt. EP

SLM 470+57  
Fd P.K. @ surface  
2.0' Lt. of Paut  
7.5' to Lt. EP  
11.0' to Rt. EP

Record:  
P.T. STA. 371+78.69  
Set P.K. 1972

Record:  
P.C. STA 369+77.79  
Set P.K. 1972

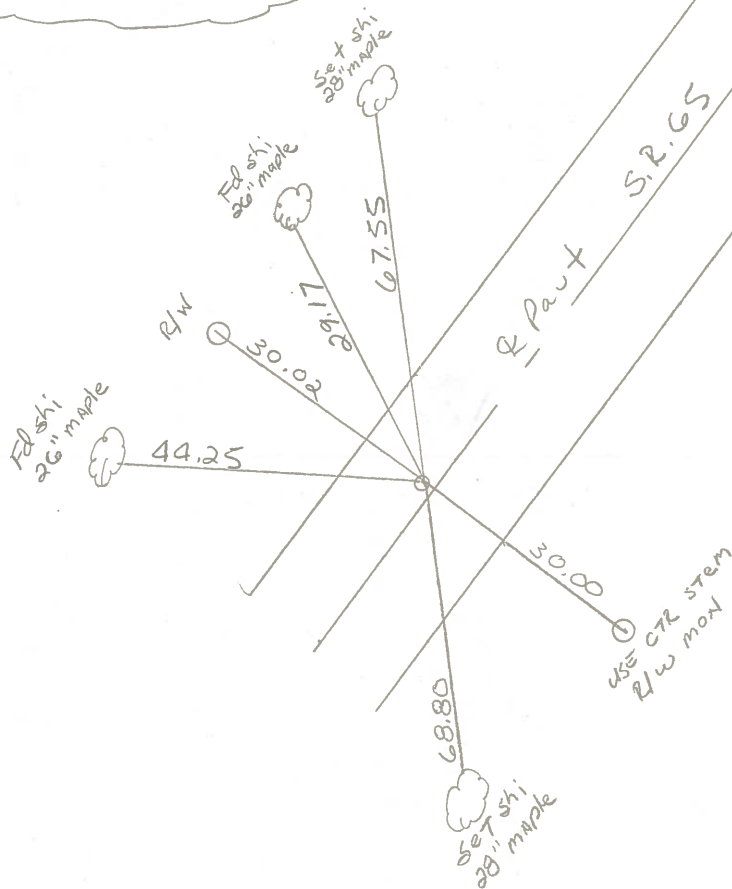

CURVE DATA 1926  
P.I. STA. = 370+79.2  
 $\Delta = 18^\circ - 5' RT.$   
 $D = 90 - 0'$   
 $T = 101.41$   
 $R = 637.28$   
 $L = 200.90$

PERSONNEL TITLE PERSONNEL TITLE  
 BURNSIDE \_\_\_\_\_  
 SMITH \_\_\_\_\_  
 BOWERS \_\_\_\_\_

COUNTY Wood DATE 11-6-72  
 S. R. 65 WEATHER CLEAR  
 SEC. MIDDLETON TWP TEMP. +58°

DESCRIPTION ESTABLISH & REF. & CONTROL POINTS JOB NO.  
 LEFT CENTER LINE RIGHT

