
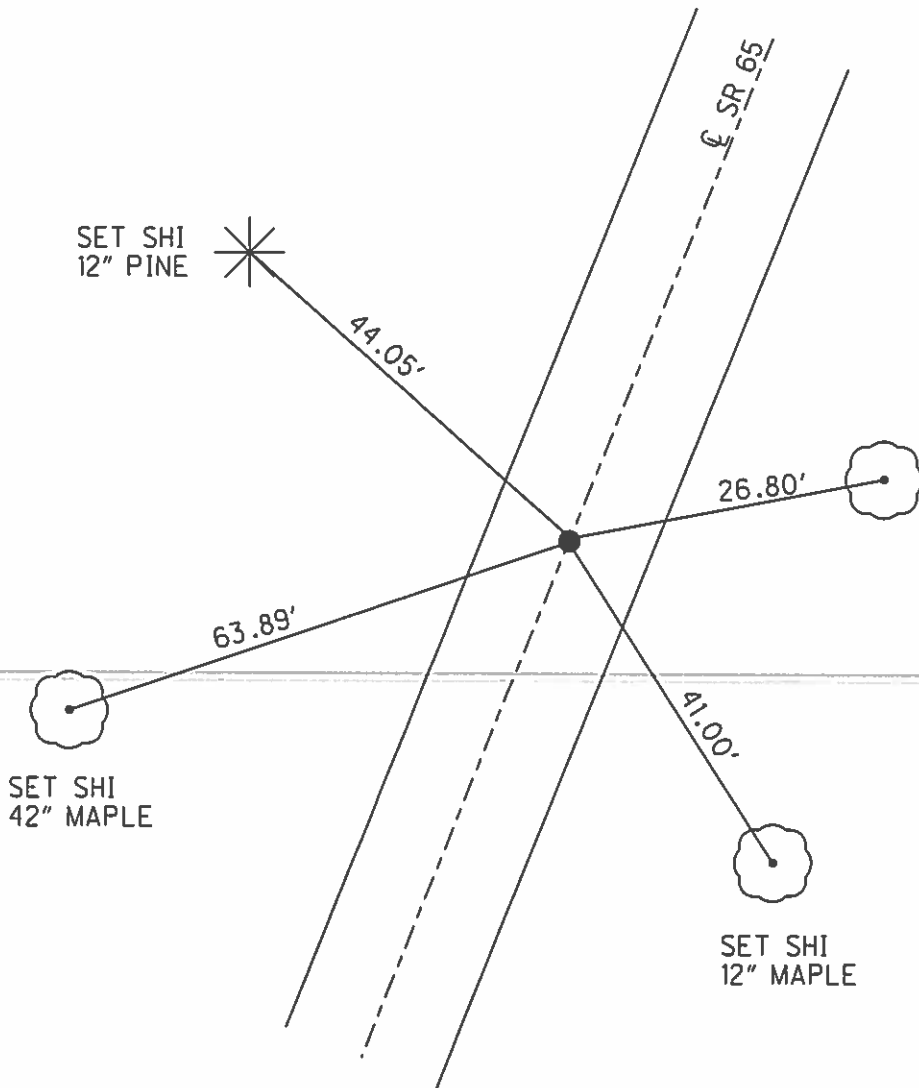


O.D.O.T. DISTRICT 2 SURVEY OFFICE (USE ONLY)

PERSONNEL	REFERENCE NO. <u>17 E</u>	SHEET <u>41</u> OF <u>63</u>
NOTES <u>WESTFALL</u>	DATE <u>4/22/15</u>	ROUTE <u>SR 65</u>
H.C. <u>O'DONNELL</u>	WEATHER <u>CLOUDY</u>	COUNTY <u>WOOD</u>
R.C. <u>LEU</u>	TEMP. <u>40°</u>	TOWNSHIP <u>MIDDLETON</u>
<u>RHOADES</u>		SECTION <u>20</u>
		T <u>6</u> N R <u>10</u> E

TYPE MONUMENT P.K./WASHER
 ON SURFACE - ~~BELOW~~ ON
 LEFT - PAV'T - RIGHT ON
9.4' TOLT EDGE PAVEMENT
 S.L.M. 480+26.11

Grid: Northing: 659386.333 Easting: 1628269.157

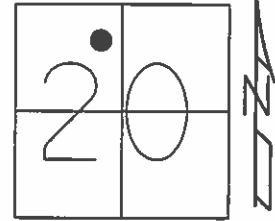

RECORD: P.I.
 CURVE DATA 1926
 STA. 378+61.95
 $\Delta = 3^{\circ}30'$ LT
 D = $1^{\circ}00'$
 R = 5729.65
 T = 175.06
 L = 350.00

RECORD: P.T.
 STA. 380+36.89
 SET P.K.NAIL, 1972

FD P.K./WASHER
 7/16/92
 SET P.K./WASHER
 9/4/92, MB
 FD P.K./WASHER
 5/25/04
 GPS, REFE17
 8/6/13, SDC
 SET MAG/WASHER
 GPS, NEWREFE17
 9/14/15, JFO

O.D.O.T. DISTRICT 2 SURVEY OFFICE

PERSONNEL _____

REFERENCE NO. _____

SHEET 24 OF 36

NOTES BARNHISEL

H.C. VAN DUSEN

R.C. KUSZ

BURNETT

DATE 5/25/04
~~7-16-92~~

WEATHER CLOUDY

TEMP. +75°

ROUTE 65

COUNTY WOOD

TOWNSHIP WASHINGTON

SECTION 20

T 6 N R 10 E

P.C. P.T.

TYPE MONUMENT P.K. WASHER P.K. WASHER

ON SURFACE - ~~BELOW~~ YES YES


~~SET~~ - PAV'T. - RIGHT 0.6 RT ON &

^{9.4}
^{10.1} TO LT EDGE PAVEMENT

S.L.M. 475+63 479+12

(17-D)

(17-E)

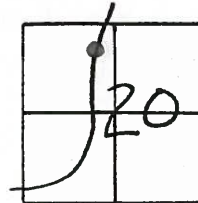


RECORD:
Curve DATA 1926
P.I. = 378+61.95
 $\Delta = 3^\circ - 30' \text{ LT}$
 $D = 1^\circ - 00'$
 $T = 175.06$
 $R = 5729.65$
 $L = 350.00$

RECORD:
P.T. = 380+36.89
SET PK 1972

Reset P.K. + WASHERS
9-4-92
MB

Preventive Maintenance
Microsurfaced 2004
Existing Point Uncovered
Date 8/5/04 MB

RECORD:
P.C. = 376+86.89
SET PK 1972

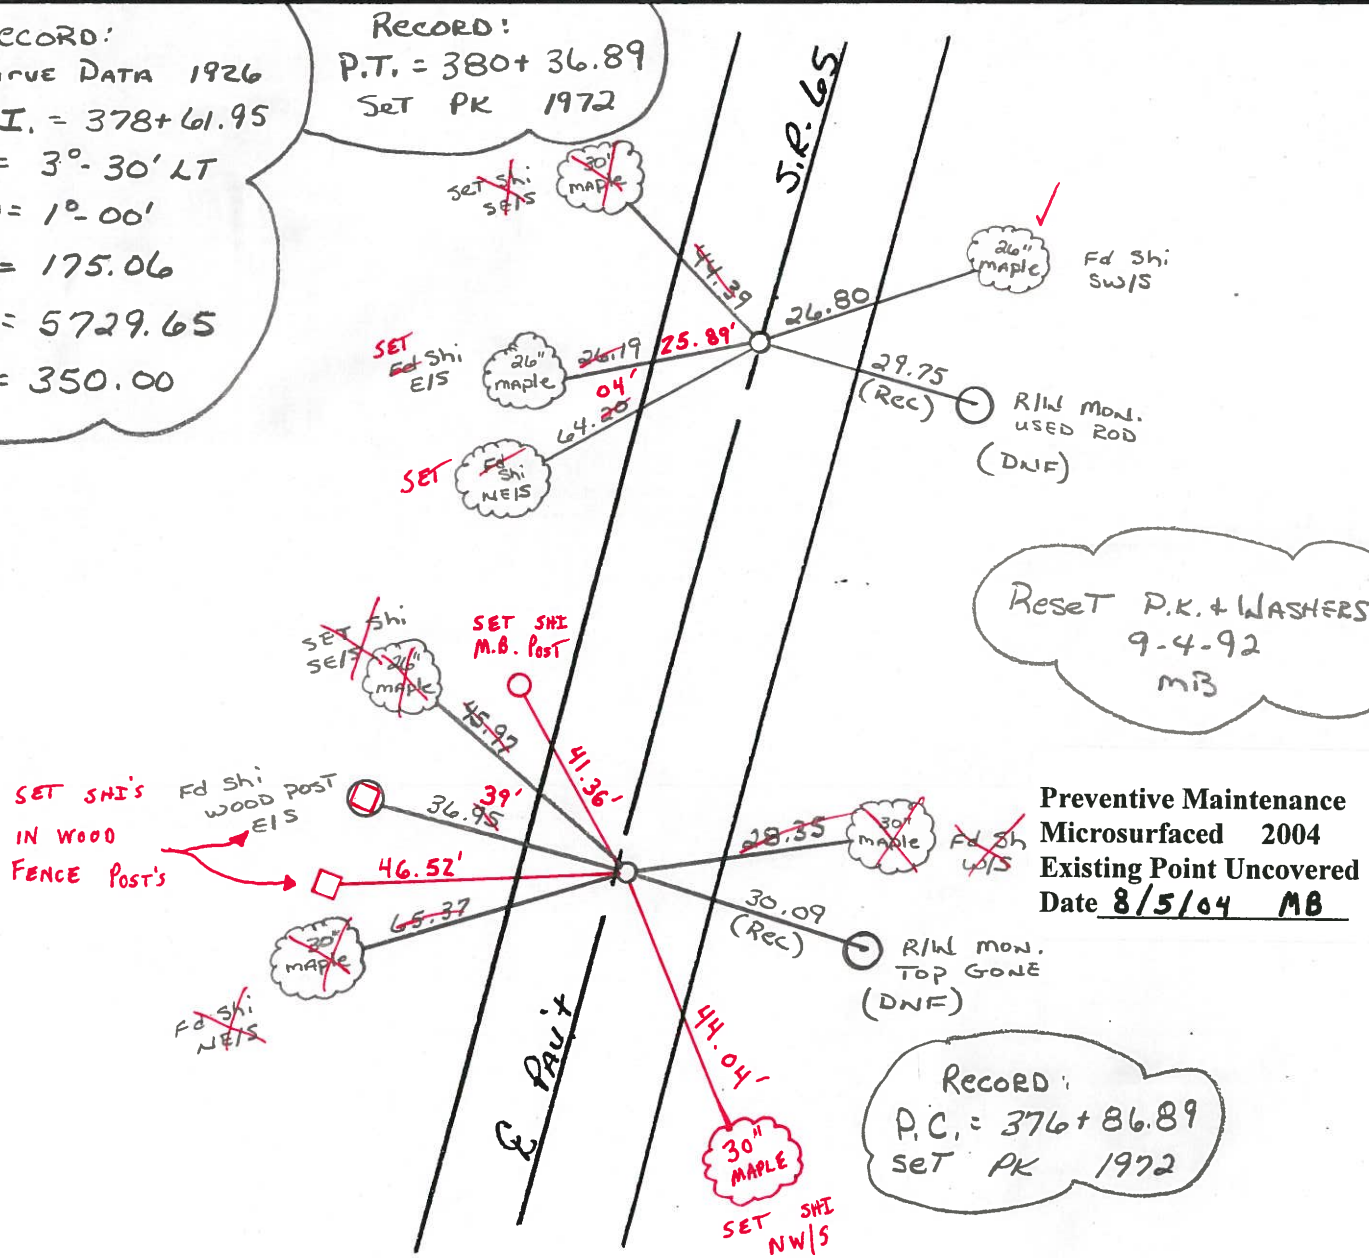

County Wood S.R. 65

Date 4-10-84

Township MIDDLETON


Weather Clear

Section 20

Temp. +50°

T6N, R10E

Personnel HOFFMAN

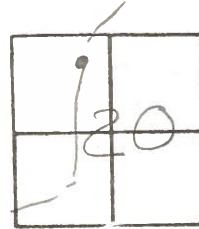

17-D

LOENZLE

HOUSEHOLDER H.C.

17-E

BARNHISEL R.C.


SET P.K./WASHER
@ BOTH PTS
10-10-84
S.W.H.

SLM 479+14
Fd P.K. @ surface
on & part
9.0' TO RT. EP.
9.3' TO LT. EP.

RECORD:
P.T. STA 380+36
SET P.K. 1972

SLM 475+65
Fd. P.K @ surface
on & part
9.0' TO RT. EP.
9.2' TO LT. EP.

RECORD:
P.C. = 376+86.89
Set P.K. 1972

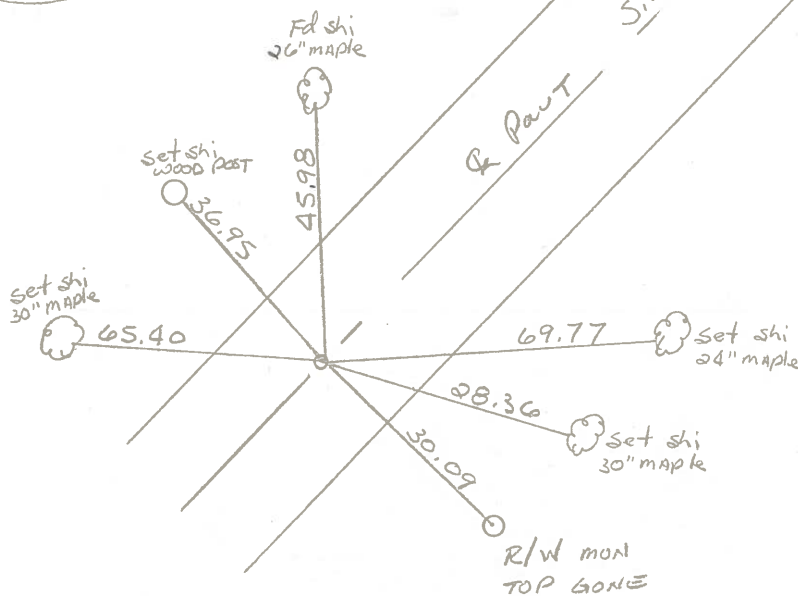

CURVE DATA 1926
P.I. STA = 378+61.95
 $\Delta = 3^{\circ}-30' LT.$
 $D = 10'-0'$
 $T = 175.06$
 $R = 5729.65$
 $L = 350.00$


PERSONNEL TITLE PERSONNEL TITLE
 BURNSIDE _____
 SMITH _____
 BOWERS _____

COUNTY Wood DATE 11-6-72

S. R. 65 WEATHER CLEAR

SEC. MIDDLETON TWP TEMP. +57°

DESCRIPTION ESTABLISH & REF. & CONTROL POINTS JOB NO. _____

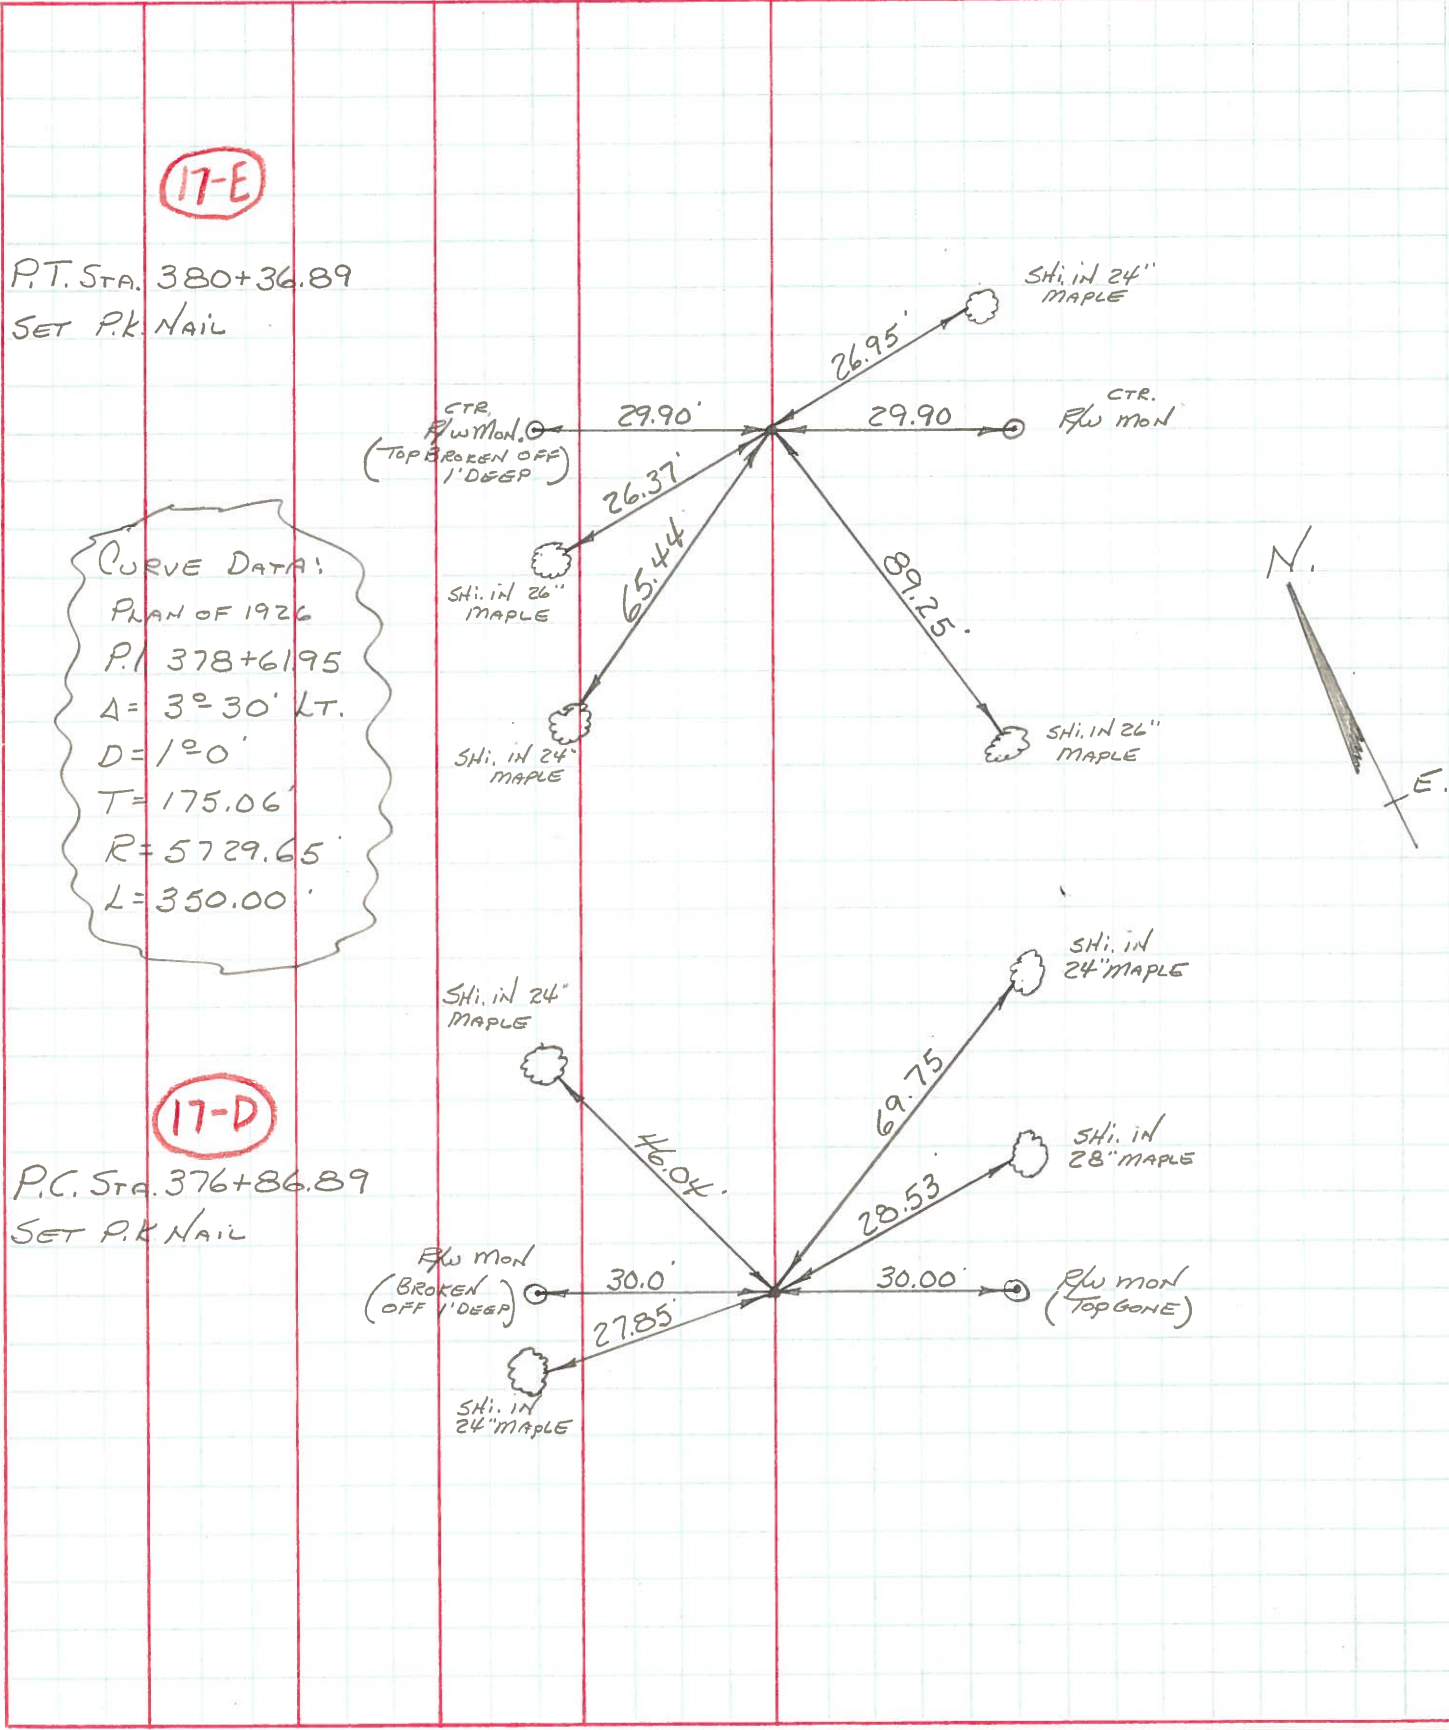

17-E

P.T. STA. 380+36.89
 SET P.K. NAIL

CURVE DATA:
 PLAN OF 1926
 P.I. 378+61.95
 Δ = 3° 30' LT.
 D = 120'
 T = 175.06'
 R = 5729.65'
 L = 350.00'

17-D

P.C. STA. 376+86.89
 SET P.K. NAIL