


O.D.O.T. DISTRICT 2 SURVEY OFFICE (USE ONLY)

PERSONNEL	REFERENCE NO. <u>17 G</u>	SHEET <u>43</u> OF <u>63</u>
NOTES <u>WESTFALL</u>	DATE <u>4/22/15</u>	ROUTE <u>SR 65</u>
H.C. <u>O'DONNELL</u>	WEATHER <u>CLOUDY</u>	COUNTY <u>WOOD</u>
R.C. <u>LEU</u>	TEMP. <u>40°</u>	TOWNSHIP <u>MIDDLETON</u>
<u>RHOADES</u>		SECTION <u>20</u>
		T <u>6</u> N R <u>10</u> E

TYPE MONUMENT P.K./WASHER
 ON SURFACE - ~~BELOW~~ ON
 LEFT - PAV'T - RIGHT ON
11.8' TORT EDGE PAVEMENT
 S.L.M. 493+49.13

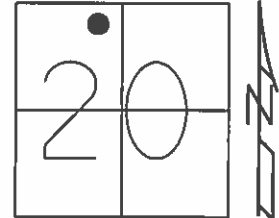


Grid: Northing: 660632.796 Easting: 1628681.175

RECORD: P.T.
 STA. 393+82

FD P.K./WASHER
 7/16/92
 SET P.K./WASHER
 9/4/92, MB
 FD P.K./WASHER
 5/25/04
 GPS, REFG17
 9/3/13, SDC
 SET MAG/WASHER
 GPS, NEWREFGG17
 9/14/15, JFO

RECORD: P.I.
 STA. 391+24.7
 $\Delta = 23^{\circ}37' 30''$ LT
 MEAS. 1972

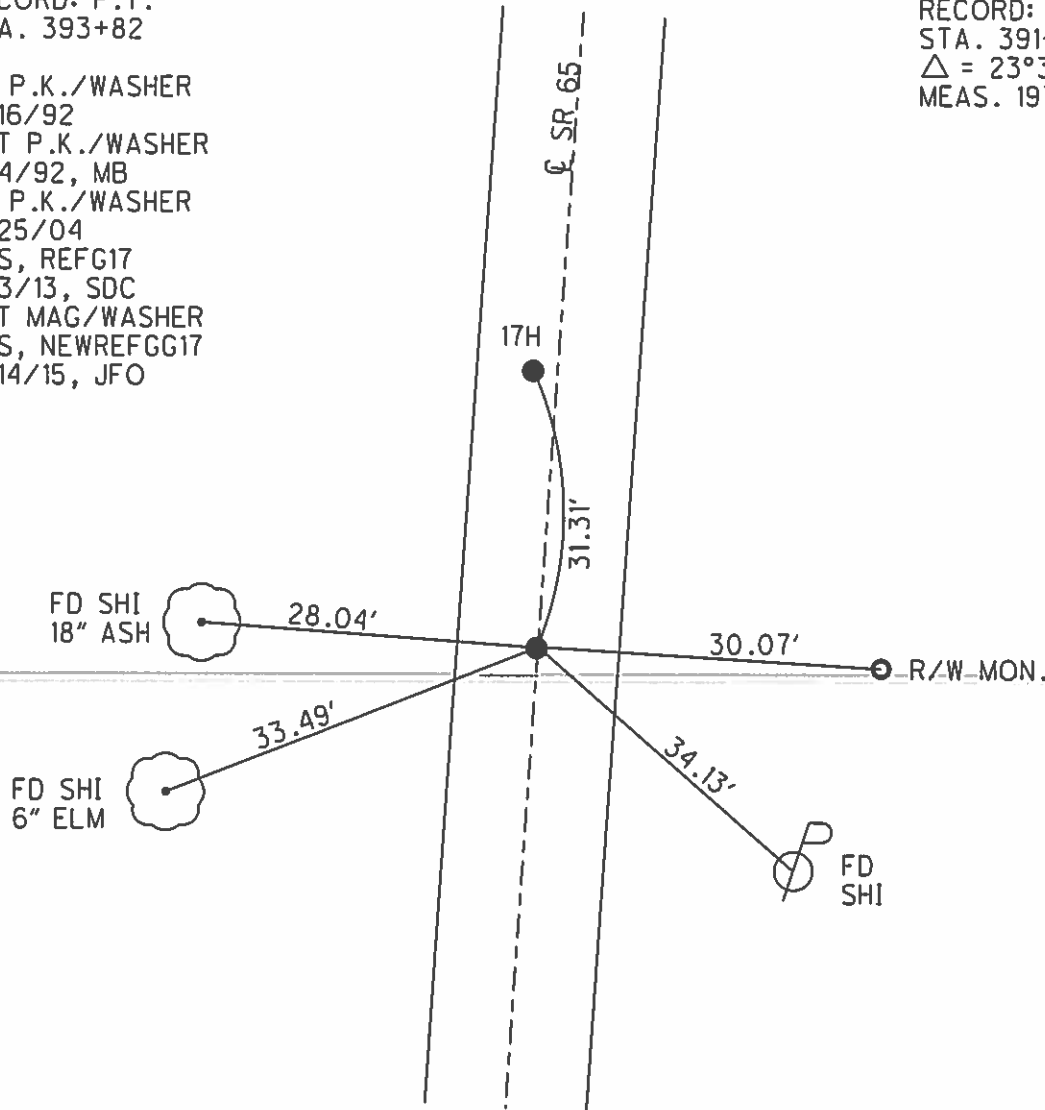

O.D.O.T. DISTRICT 2 SURVEY OFFICE

PERSONNEL

REFERENCE NO. _____

SHEET 25 OF 34

NOTES BARNHISEL

5/25/04

H.C. VAN DUSEN

DATE 7-16-92

ROUTE 65

R.C. KUSZ

WEATHER cloudy

COUNTY WOOD

(17-F)

BURNETT

TEMP. +75°

TOWNSHIP WASHINGTON

(17-G)

SECTION 20

(17-H)

P.C. ✓ P.T. ✓ P.C. ✓

Reset
P.K.'S + WASHERS
9-4-92
miB

T 6 N 10 E


TYPE MONUMENT ALL PK'S + WASHERS

ON SURFACE - BELOW yes yes yes

LEFT - PAV'T. - RIGHT ON E ON E 1.8 LT

TO RT EDGE PAVEMENT 10.1 11.8 11.2

S.L.M. 487+62 492+38 492+69

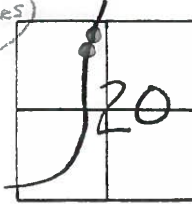


RECORD:
P.I. = 391+24.7
 $\Delta = 23^\circ 37' 30''$ LT
MEAS 1972

RECORD:
P.C. = 393+82

RECORD:
P.T. = 393+58.8

RECORD:
P.C. = 388+83.5

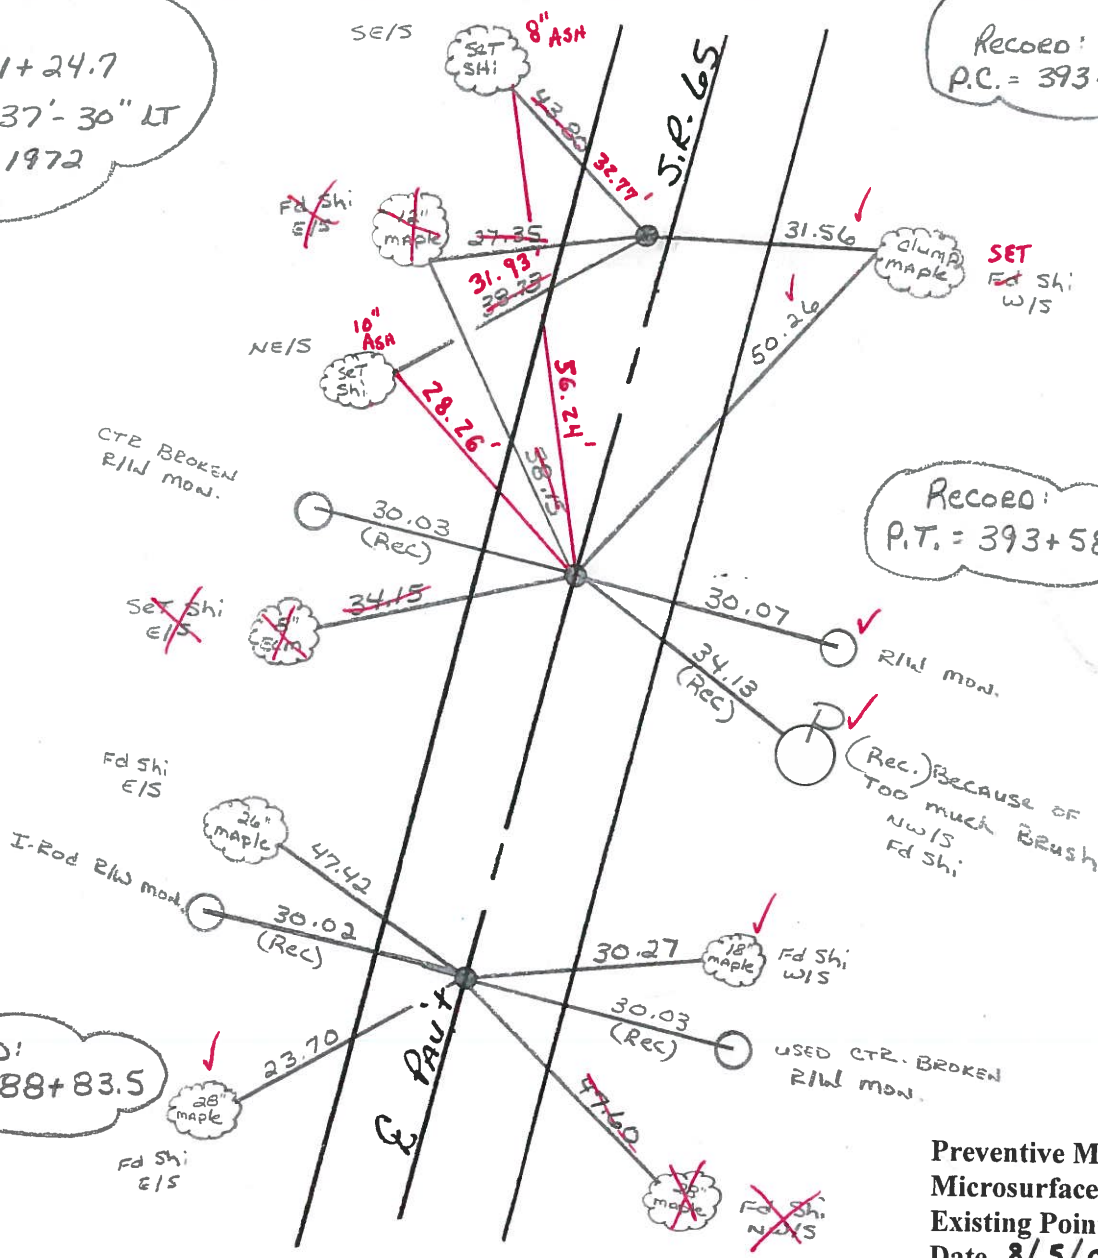

Preventive Maintenance
Microsurfaced 2004
Existing Point Uncovered
Date 8/5/04 MC

SMT-1

O.D.O.T. DISTRICT 2 SURVEY OFFICE

SHEET 25 OF 91

County Wood S.R. 65

Date 4-10-84

Township MIDDLETON

Weather Clear

Section 20

Temp. 45°

T6N, R10E

Personnel HOFFMAN

17-F


LOERKE

17-H

HOUSEHOLDER H.C.

17-G


GARNISSEL R.C.

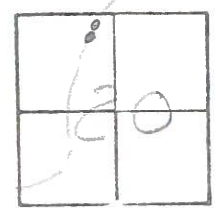

SET PK / WASHOR
ALL 3 POINTS
10-10-84
SWH

SLM 492+69
Fol P.K. @ surface
1.2' Lt. of & paint
11.4' TO Lt. EP.
10.8' TO RT. EP.
Record:
P.C. 393+82

P.I. 391+24.7
 $\Delta = 23^\circ - 37' - 30''$ Lt.
mens 1972

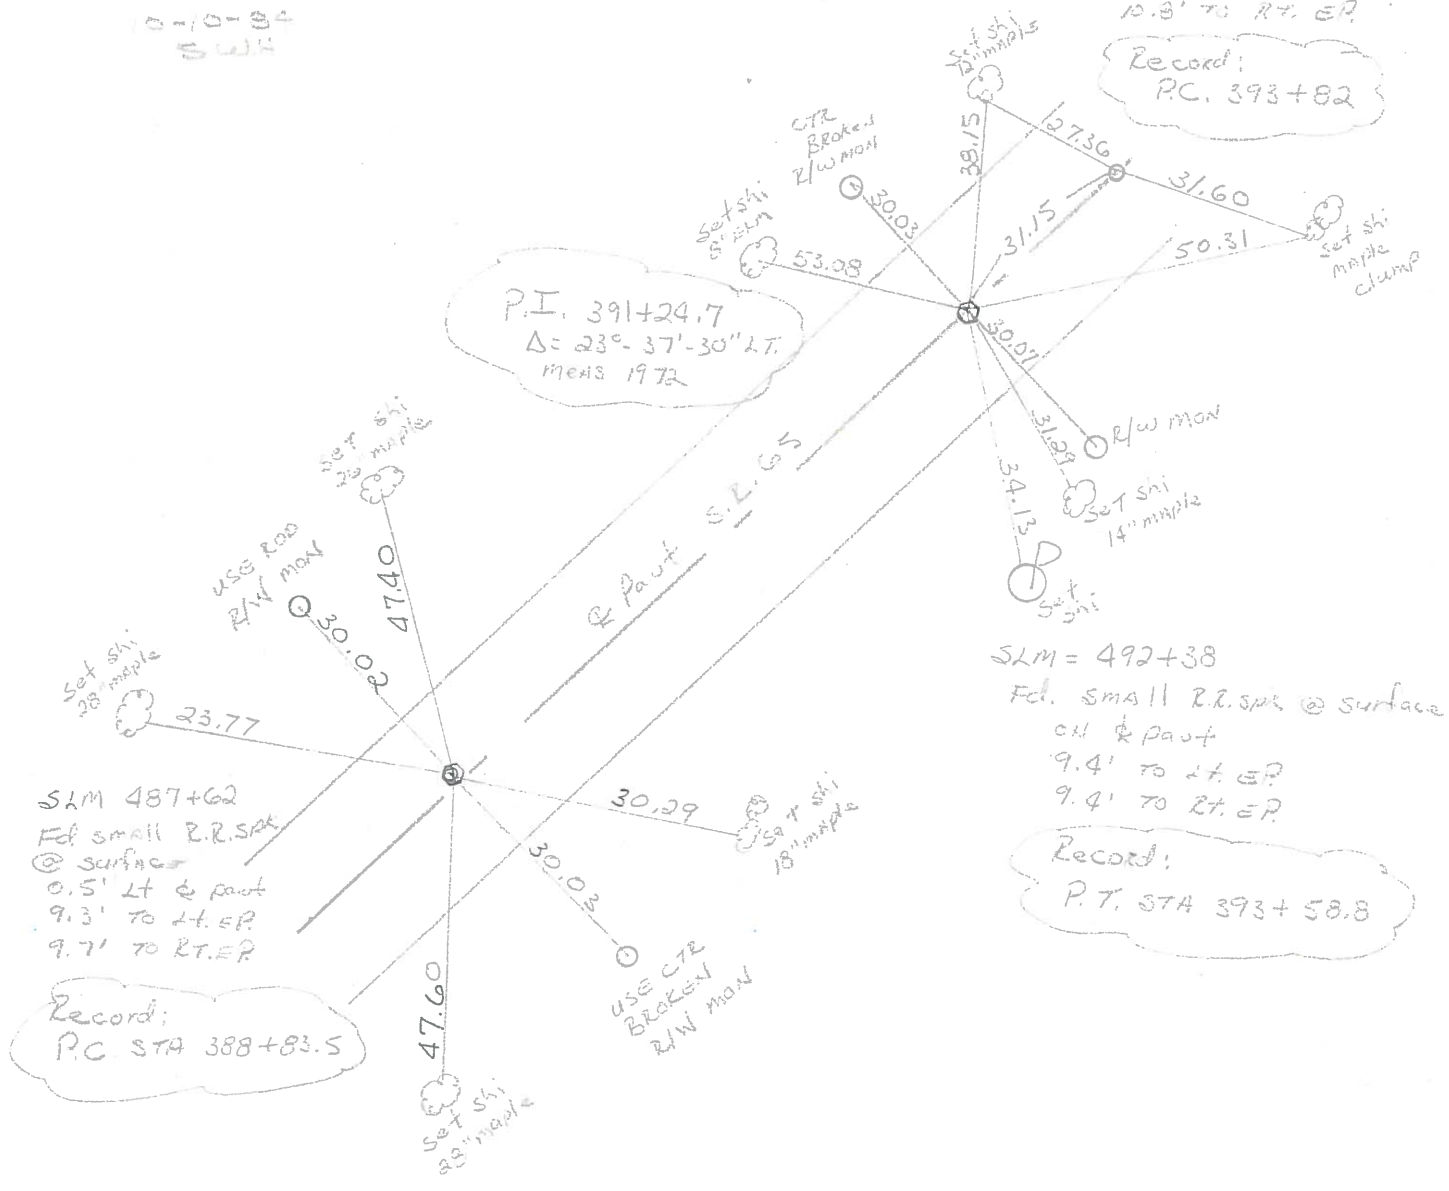

SLM = 492+38
Fol. small R.R. spike @ surface
oil & paint
9.4' TO Lt. EP.
9.4' TO RT. EP.

Record:
P.T. STA 393+58.8

SLM 487+62
Fol small R.R. spike
@ surface
0.5' Lt & paint
9.3' TO Lt. EP.
9.7' TO RT. EP.
Record:
P.C. STA 388+83.5

PERSONNEL TITLE PERSONNEL TITLE
BURNSIDE _____
SMITH _____
BOWERS _____
KIJOWSKI _____

COUNTY WOOD DATE 11-9-72
 S. R. 65 WEATHER CLOUDY
 SEC. MIDDLETON TWP TEMP. +43°

DESCRIPTION ESTABLISH & REF. & CONTROL POINTS JOB NO. _____

