
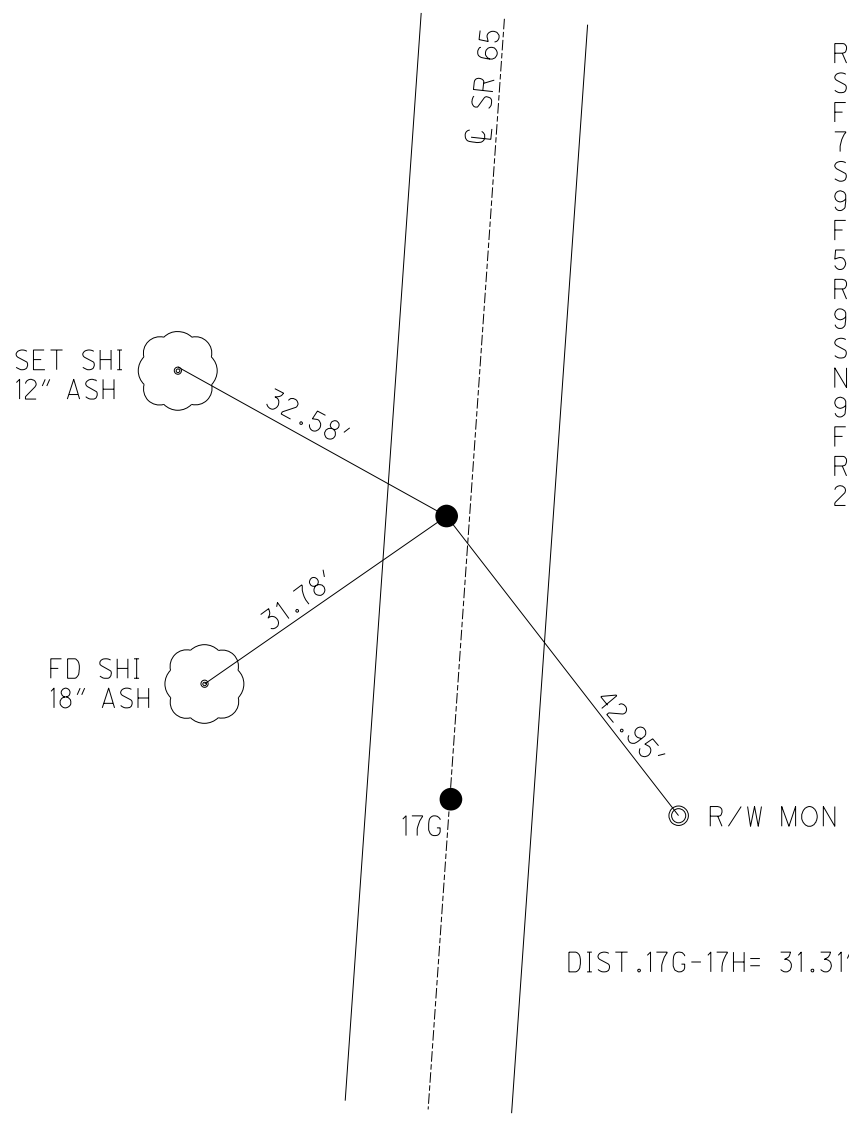


O.D.O.T. DISTRICT 2 SURVEY OFFICE (USE ONLY)

PERSONNEL _____ REFERENCE NO. 17 H SHEET 44 OF 63
 NOTES NIESE DATE 2/16/24 ROUTE SR 65
 H.C. NIESE WEATHER FAIR COUNTY WOOD
 R.C. ASTON TEMP. 32° TOWNSHIP MIDDLETON
 DWG BY RHOADES PID 93680 SECTION 20
 T 6 N R 10 E

TYPE MONUMENT MAG/WASHER
 ON SURFACE - ~~BELOW~~ ON
 OFFSET \odot PAVEMENT 1.8' LT : ~~RT~~
11.2' TO RT EDGE PAVEMENT
 STATION: 493+80.45

HORZ.DATUM: NAD83 2011 GEOID: NAVD88 2018
 GRID: NORTHING: 660663.870 EASTING: 1628680.618

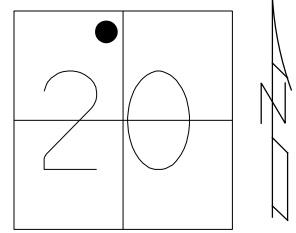


RECORD: P.C.
 STA. 393+82
 FD P.K./WASHER
 7/16/92
 SET P.K./WASHER
 9/4/92, MB
 FD P.K./WASHER
 5/25/04
 REFH17
 9/3/13, SDC
 SET MAG/WASHER
 NEWREFH17
 9/14/15, JFO
 FD MAG/WASHER
 REF17H
 2/16/24, TDN

O.D.O.T. DISTRICT 2 SURVEY OFFICE (USE ONLY)


PERSONNEL	REFERENCE NO. <u>18</u>	SHEET <u>47</u> OF <u>63</u>
NOTES <u>LEU</u>	DATE <u>4/30/15</u>	ROUTE <u>SR 65</u>
H.C. <u>O'DONNELL</u>	WEATHER <u>CLOUDY</u>	COUNTY <u>WOOD</u>
R.C. <u>RHOADES</u>	TEMP. <u>50°</u>	TOWNSHIP <u>MIDDLETON</u>
		SECTION <u>17</u>
		T <u>6</u> N R <u>10</u> E

TYPE MONUMENT P.K./WASHER
 ON SURFACE - ~~BELOW~~ ON
 LEFT - PAV'T - ~~RIGHT~~ 1.3'
8.6' TOLT EDGE PAVEMENT
 S.L.M. 499+76.22

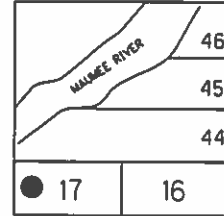

Grid: Northing: 661244.922 Easting: 1628791.917

RECORD: P.C.C.
 STA. 399+82.2
 1926 PLAN
 SET P.K.NAIL 1972
 FD P.K./WASHER
 7/16/92
 SET P.K./WASHER
 7/28/92, MB
 FD P.K./WASHER
 5/25/04, 8/6/13
 GPS, REF18
 9/4/13, SDC
 SET MAG/WASHER
 GPS, NEWREF18
 9/14/15, JFO

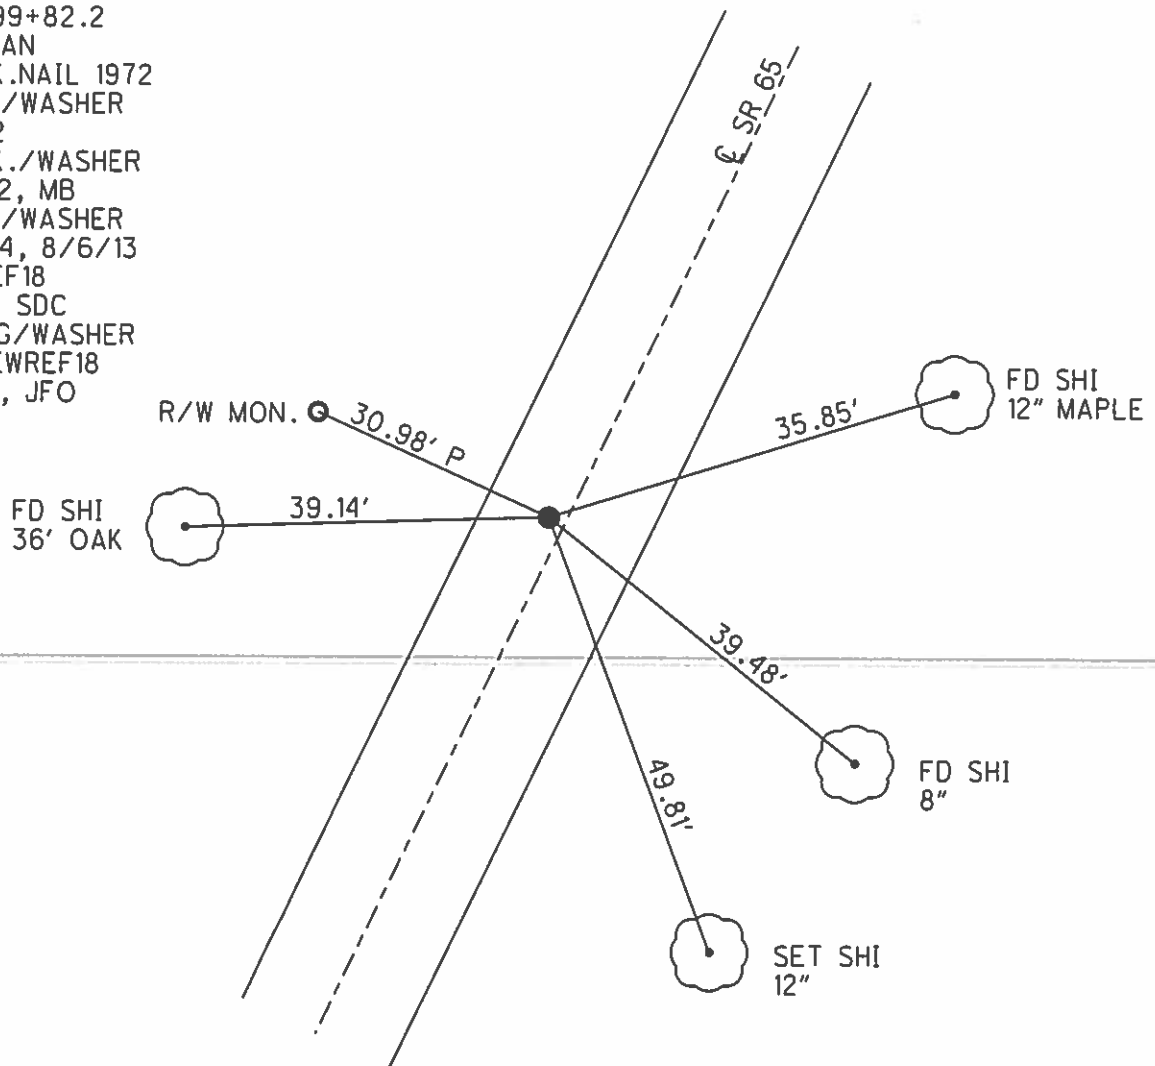

O.D.O.T. DISTRICT 2 SURVEY OFFICE

PERSONNEL _____

REFERENCE NO. 18

SHEET 27 OF 34

NOTES BARNHISEL

5/25/04

H.C. VAN DUSEN

DATE 7-16-92

ROUTE 65

R.C. KUSZ

WEATHER SUNNY

COUNTY WOOD

BURNETT

TEMP. +77°

TOWNSHIP MIDDLETON

SECTION R.T. 17

T 6 N R 10 E


TYPE MONUMENT P.K. & WASHER ✓

ON SURFACE - ~~BELOW~~ YES

LEFT- & PAV'T. - ~~RIGHT~~ 1.3

8.6 TO LT EDGE PAVEMENT


S.L.M. 498+65

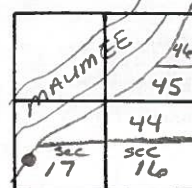

RECORD:

P.C.C. STA: 399+82.2

SET PK 1972

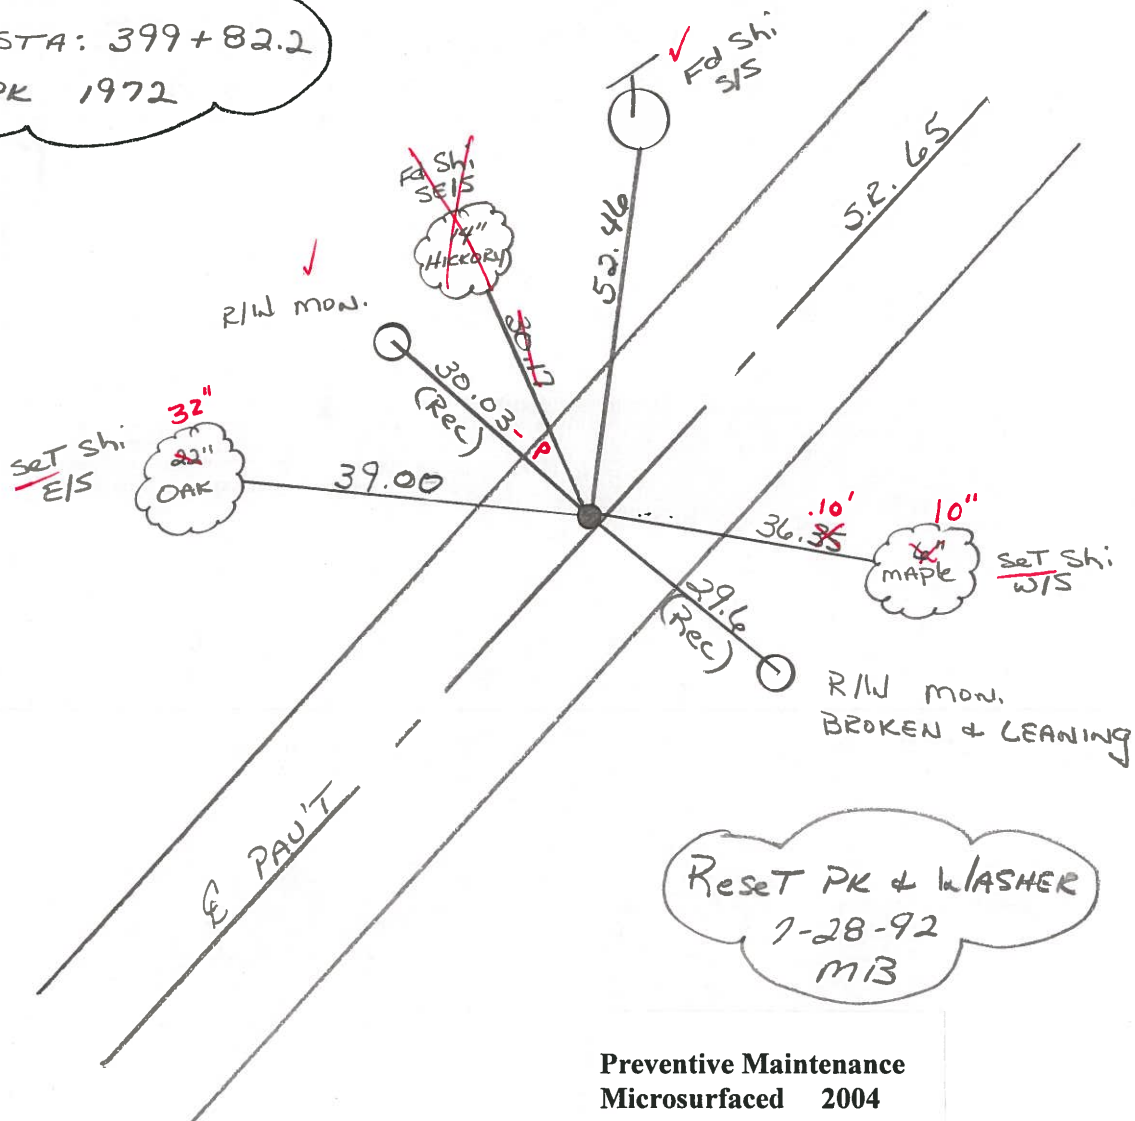

Preventive Maintenance
 Microsurfaced 2004
 Existing Point Uncovered
 Date 8/5/04 MB

County Wood S.R. 65

Date 4-11-84

Township MIDDLETON

Weather Clear

Section FRAC. 17

Temp. + 45°

T&N, R/OE


Personnel HOFFMAN

LOETRKE

HOUSEHOLDER H.C.

BARNHISEL R.C.

18

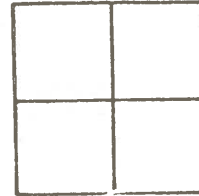

Fd P.K. Nail @ SURFACE

SLM 498+65

ON & PAUT

9.0' TO LT. EP


10.5' TO RT. EP

SET PK/WASHER

10-10-84

SWH

Record:
P.C.C. STA 4399+82.2
Set P.K. 1972

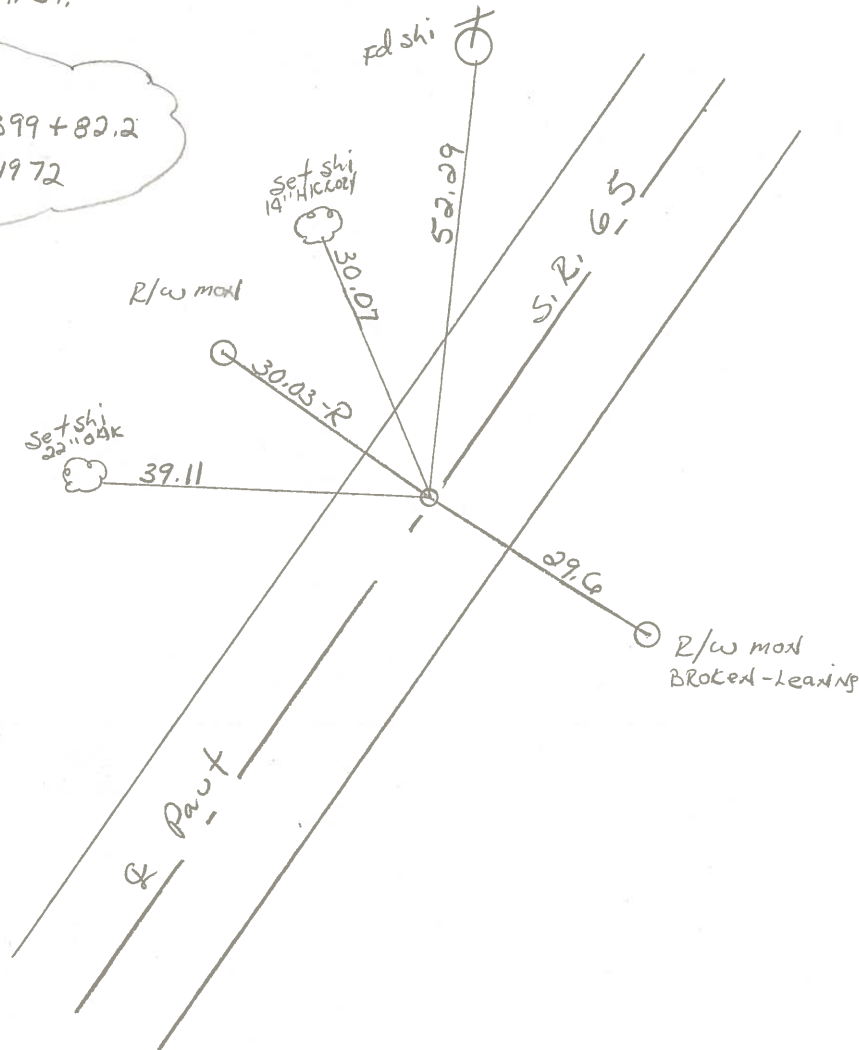

PERSONNEL	TITLE	PERSONNEL	TITLE	COUNTY	<u>WOOD</u>	DATE	<u>11-9-72</u>
<u>BURNSIDE</u>				S. R.	<u>65</u>	WEATHER	<u>CLOUDY</u>
<u>SMITH</u>				SEC.	<u>MIDDLETON TWP</u>	TEMP.	<u>+ 43°</u>
<u>BOWERS</u>							
<u>KIJOWSKI</u>							

DESCRIPTION ESTABLISH & REF. & CONTROL POINTS JOB NO. _____

