


O.D.O.T. DISTRICT 2 SURVEY OFFICE (USE ONLY)


PERSONNEL _____ REFERENCE NO. 18 B SHEET 49 OF 63
 NOTES LEU DATE 4/30/15 ROUTE SR 65
 H.C. O'DONNELL WEATHER CLOUDY COUNTY WOOD
 R.C. RHOADES TEMP. 50° TOWNSHIP MIDDLETON
 SECTION RT 44
 T 1 R 10 E

TYPE MONUMENT P.K./WASHER
 ON SURFACE - ~~BELOW~~ ON _____
 LEFT - PAV'T - ~~RIGHT~~ 3.2'
7.4' TOLT EDGE PAVEMENT
 S.L.M. 516+15.76

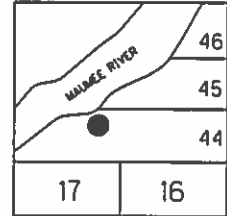

Grid: Northing: 662602.778 Easting: 1629678.582

RECORD: P.C.C.
 STA. 416+18.52
 P.T. FOR 5° 0'
 1926 PLAN
 SET P.K.NAIL 1972
 FD P.K./WASHER
 7/15/92
 SET P.K./WASHER
 7/28/92, MB
 FD P.K./WASHER
 5/25/04, 8/6/13
 GPS, REFB18
 9/4/13, SDC
 SET MAG/WASHER
 GPS, NEWREFB18
 9/14/15, JFO

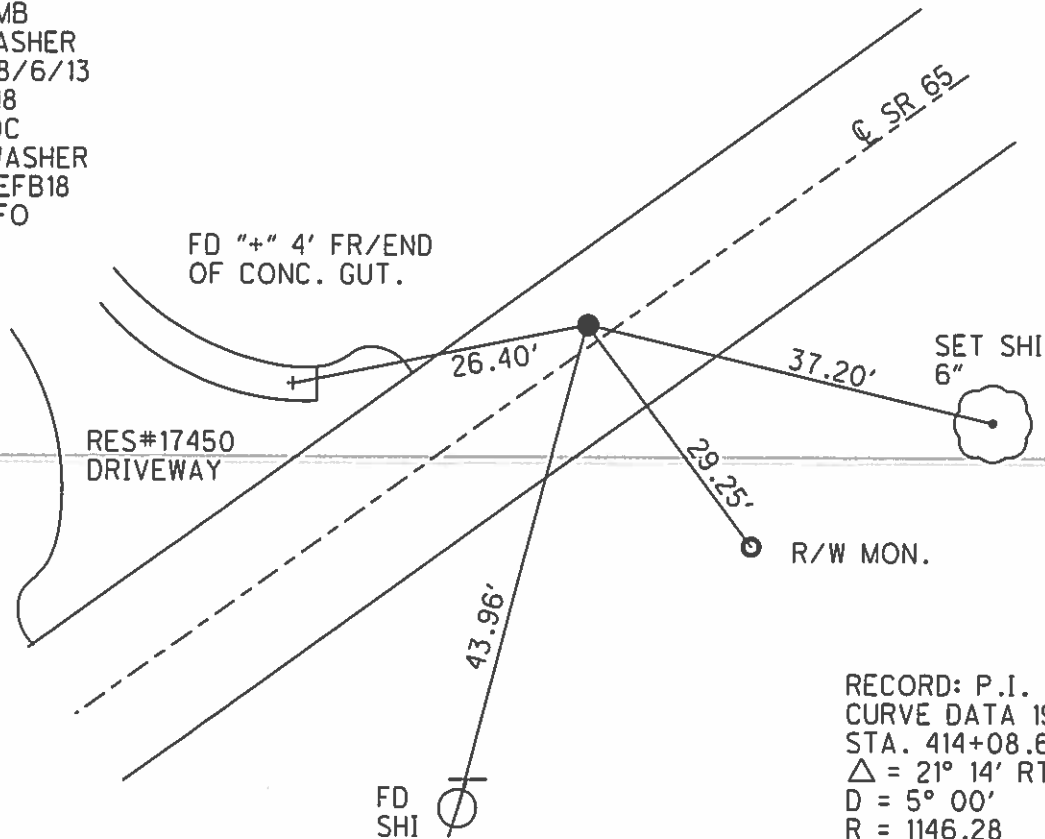

RECORD: P.I.
 CURVE DATA 1926
 STA. 414+08.67
 $\Delta = 21^\circ 14' RT$
 $D = 5^\circ 00'$
 $R = 1146.28$
 $T = 214.81$
 $L = 424.66$

O.D.O.T. DISTRICT 2 SURVEY OFFICE

PERSONNEL _____

REFERENCE NO. _____

SHEET 29 OF 34

NOTES BARNHISEL

H.C. VAN DUSEN

R.C. KUSZ

BURNETT

5/25/04

DATE ~~7/15/92~~

WEATHER RAINY

TEMP. 65°

ROUTE 65

COUNTY WOOD

TOWNSHIP MIDKEXTON

SECTION R.T. 44

T 6 N R 10 E

TYPE MONUMENT P.K. & WASHER ✓


ON SURFACE - ~~BLOW~~ YES

LEFT- & PAV'T. - ~~RIGHT~~ 3.2

6.3 TO LT EDGE PAVEMENT

S.L.M. 515+04

18-B

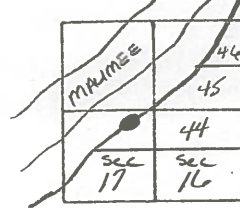

RECORD:

P.C.C. 416+18.52

P.T. FOR 5°-0'

SET P.K. 1972

P.I. = 414+08.67

$\Delta = 21^{\circ}-14' RT$

D = 5°-0'


R = 1146.28

T = 214.81

L = 424.66

Reset P.K. & WASHER

7-28-92
MB

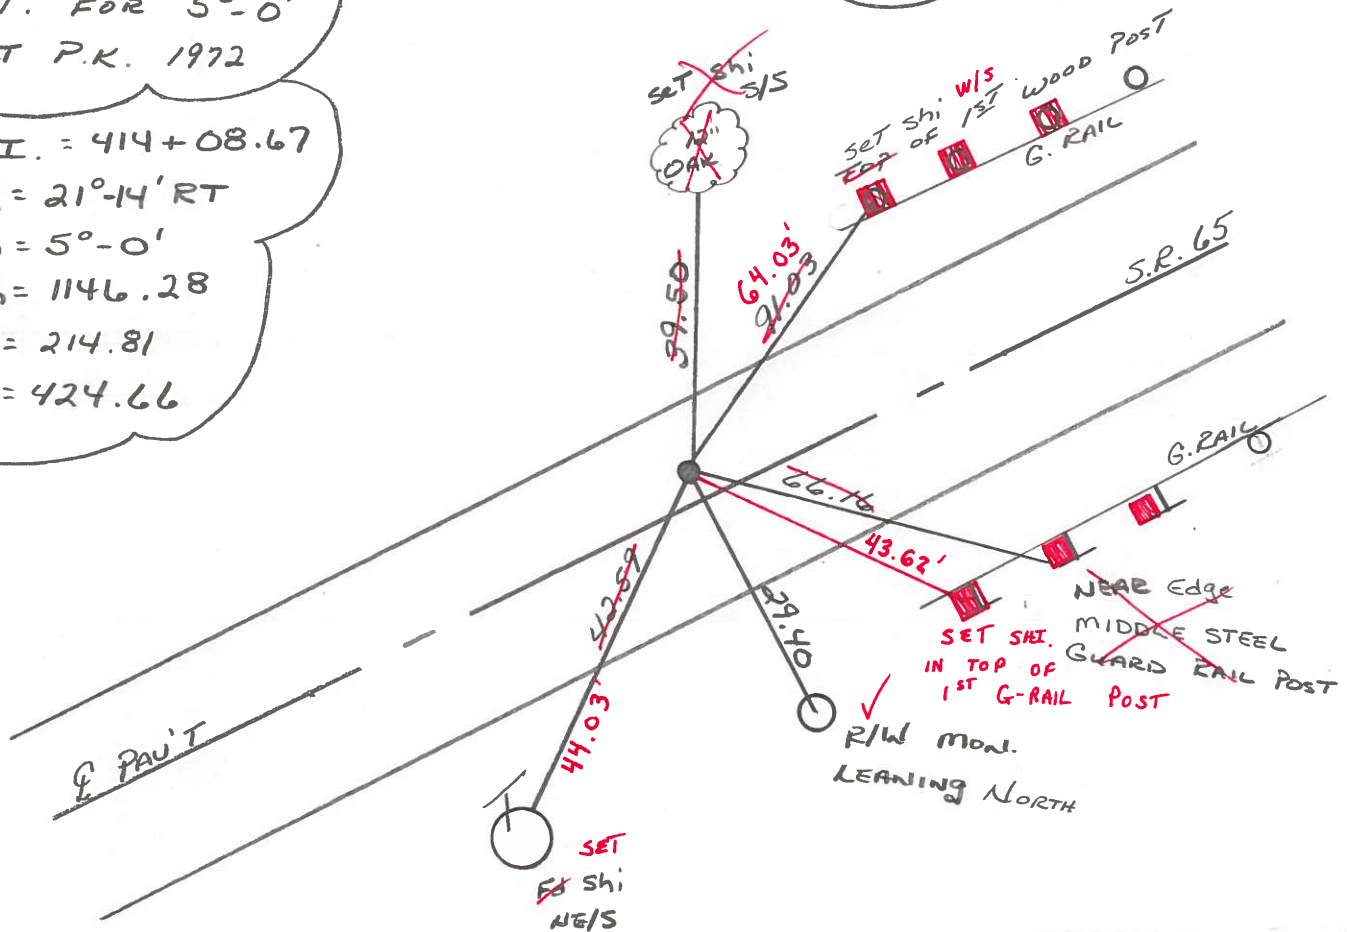

Preventive Maintenance
Microsurfaced 2004
Existing Point Uncovered
Date 8/5/04 MB

County WOOD S.R. 65

Date 4-11-84

Township MIDDLETON

Weather clear

Section R.T. 44

Temp. +45°

T&N, R/OE


Personnel HOFFMAN

LOEHRKE

HOUSEHOLDER H.C.

BARNHISEL R.C.

18-B

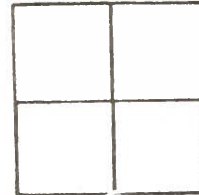

Fd P.K. @ surface

2.4' Lt. of & Post

5.1' to Lt. EP

12.9' to Rt. EP

S.L.M. 515+04

SET PK/WASHER


10-10-84
SWH

Record:

P.C.C. 416+18.52

P.T. FOR 5°-0'

Set P.K. 1972

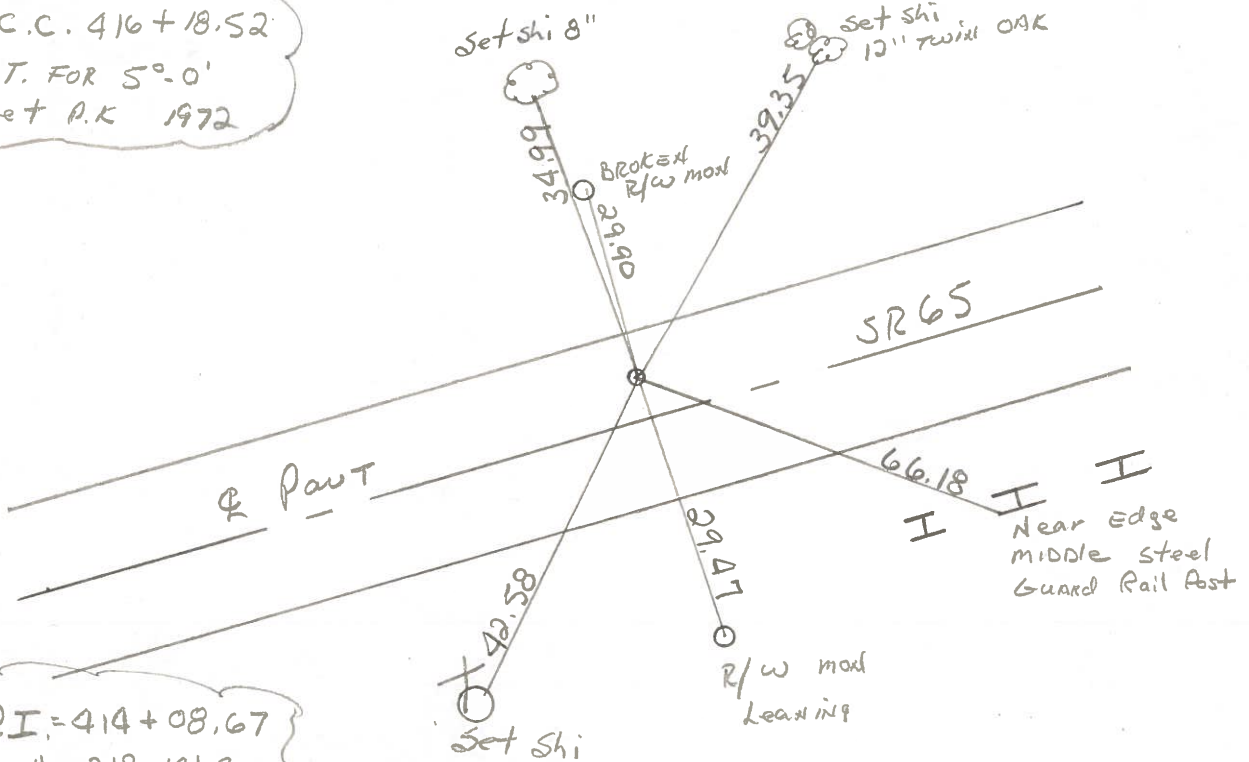

P.I. = 414+08.67

$\Delta = 21^\circ - 14' RT$

D = 5°-0'


R = 1146.28

T = 214.81

L = 424.66

PERSONNEL	TITLE	PERSONNEL	TITLE	COUNTY	<u>WOOD</u>	DATE	<u>11-13-72</u>
<u>BURNSIDE</u>				S. R.	<u>65</u>	WEATHER	<u>CLOUDY</u>
<u>SMITH</u>				SEC.	<u>MIDDLETON TWP</u>	TEMP.	<u>+40°</u>
<u>POWERS</u>							
<u>KISOWSKI</u>							

DESCRIPTION ESTABLISH & REF. & CONTROL POINTS JOB NO. _____

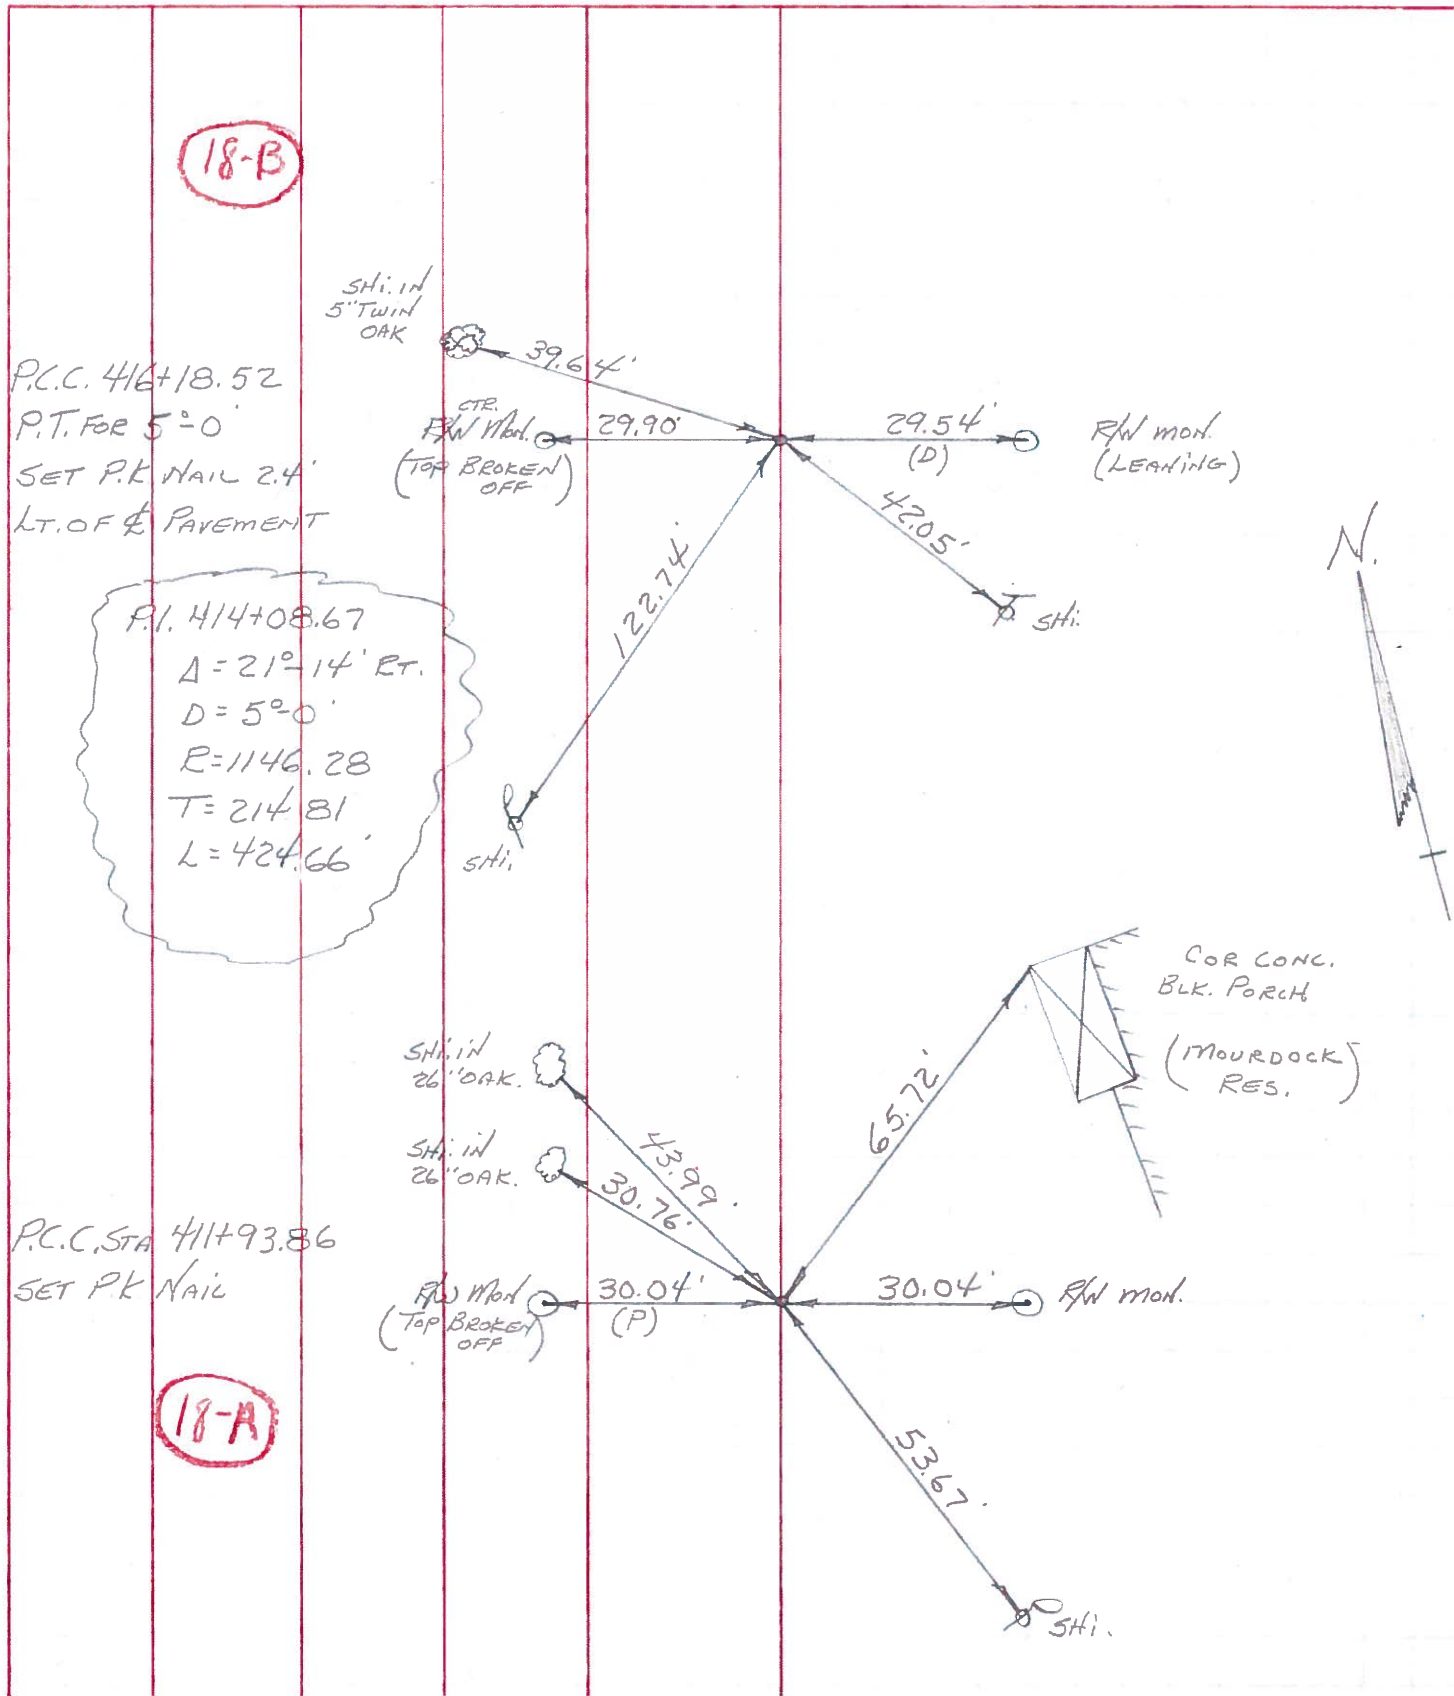

18-B

P.I. 414+08.67
 Δ=21°-14' RT.
 D=5°-0'
 R=1146.28
 T=214.81
 L=424.66'

18-A