


O.D.O.T. DISTRICT 2 SURVEY OFFICE (USE ONLY)


PERSONNEL \_\_\_\_\_ REFERENCE NO. 18 C SHEET 50 OF 63  
 NOTES LEU DATE 4/30/15 ROUTE SR 65  
 H.C. O'DONNELL WEATHER CLOUDY COUNTY WOOD  
 R.C. RHOADES TEMP. 50° TOWNSHIP MIDDLETON  
 \_\_\_\_\_ SECTION RT 44  
 \_\_\_\_\_ T 1 R 10 E

TYPE MONUMENT P.K./WASHER  
 ON SURFACE - ~~BELOW~~ \_\_\_\_\_ ON \_\_\_\_\_  
 LEFT - PAV'T - RIGHT ON \_\_\_\_\_  
9.9' TOLT EDGE PAVEMENT  
 S.L.M. 526+17.45

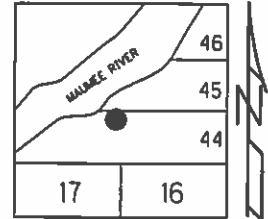

Grid: Northing: 662956.199 Easting: 1630284.248

RECORD:  
 FD P.K./WASHER  
 7/15/92  
 SET P.K./WASHER  
 7/28/92, MB  
 FD P.K./WASHER  
 5/25/04, 8/6/13  
 GPS, REFC18  
 9/4/13, SDC  
 SET MAG/WASHER  
 GPS, NEWREFC18  
 9/14/15, JFO

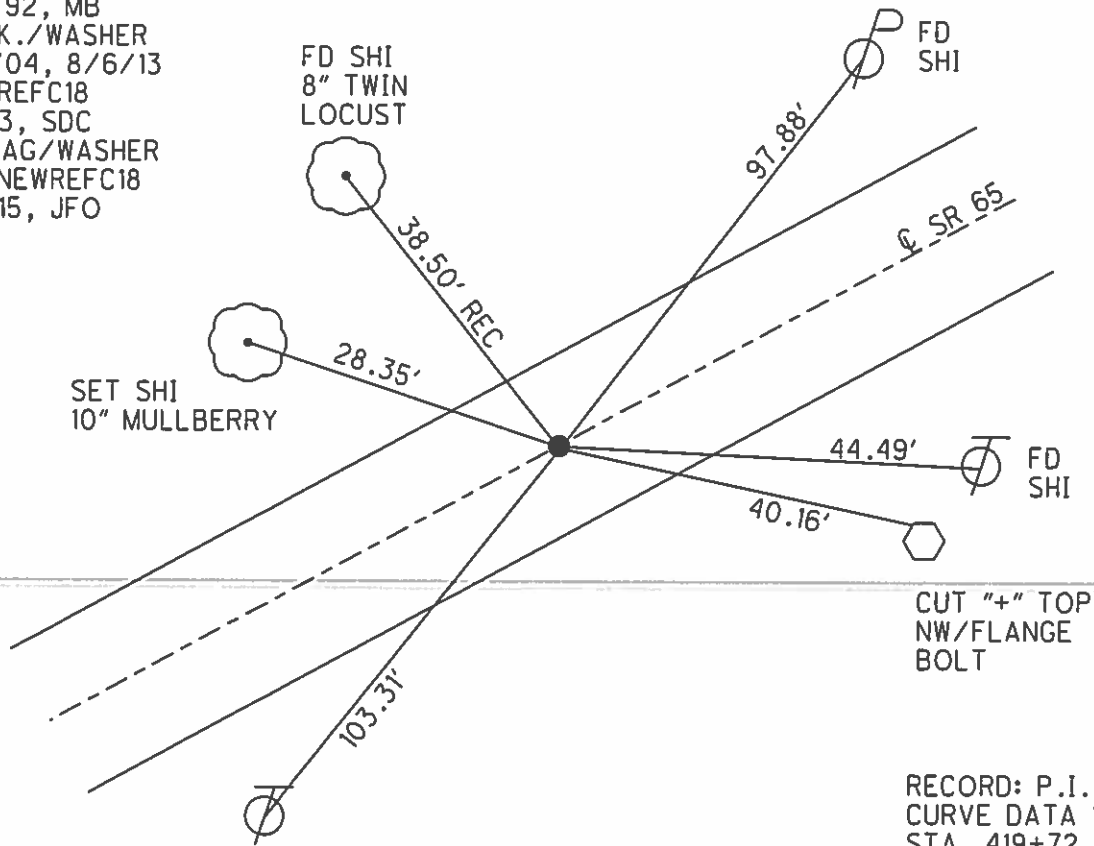

RECORD: P.I.  
 CURVE DATA 1926  
 STA. 419+72.31  
 $\Delta = 7^\circ 04' RT$   
 $D = 1^\circ 00'$   
 $R = 5729.65$   
 $T = 353.79$   
 $L = 706.67$

# O.D.O.T. DISTRICT 2 SURVEY OFFICE

PERSONNEL

REFERENCE NO. \_\_\_\_\_

SHEET 30 OF 34

NOTES BARNHISEL

5/25/04

H.C. VAN DUSEN

DATE 7-15-92

ROUTE 65

R.C. KUSZ

WEATHER RAIN

COUNTY WOOD

BURNETT

TEMP. 65°

TOWNSHIP MIDDLETON

SECTION R.T. 44

T 6 N R 10 E

TYPE MONUMENT P.K. + WASHER ✓


ON SURFACE - ~~BELOW~~ yes

~~LEFT - & PAV'T. - RIGHT~~ yes

9.9 TO LT EDGE PAVEMENT

S.L.M. 522+05

18-C

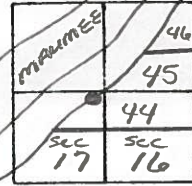

CURVE DATA 1926

P.I. = 419+72.31

$\Delta = 7^{\circ}-04' RT$

D = 1°-0'


L = 706.67

T = 353.79

R = 5729.65

Reset P.K. + WASHER

7-28-92  
MB

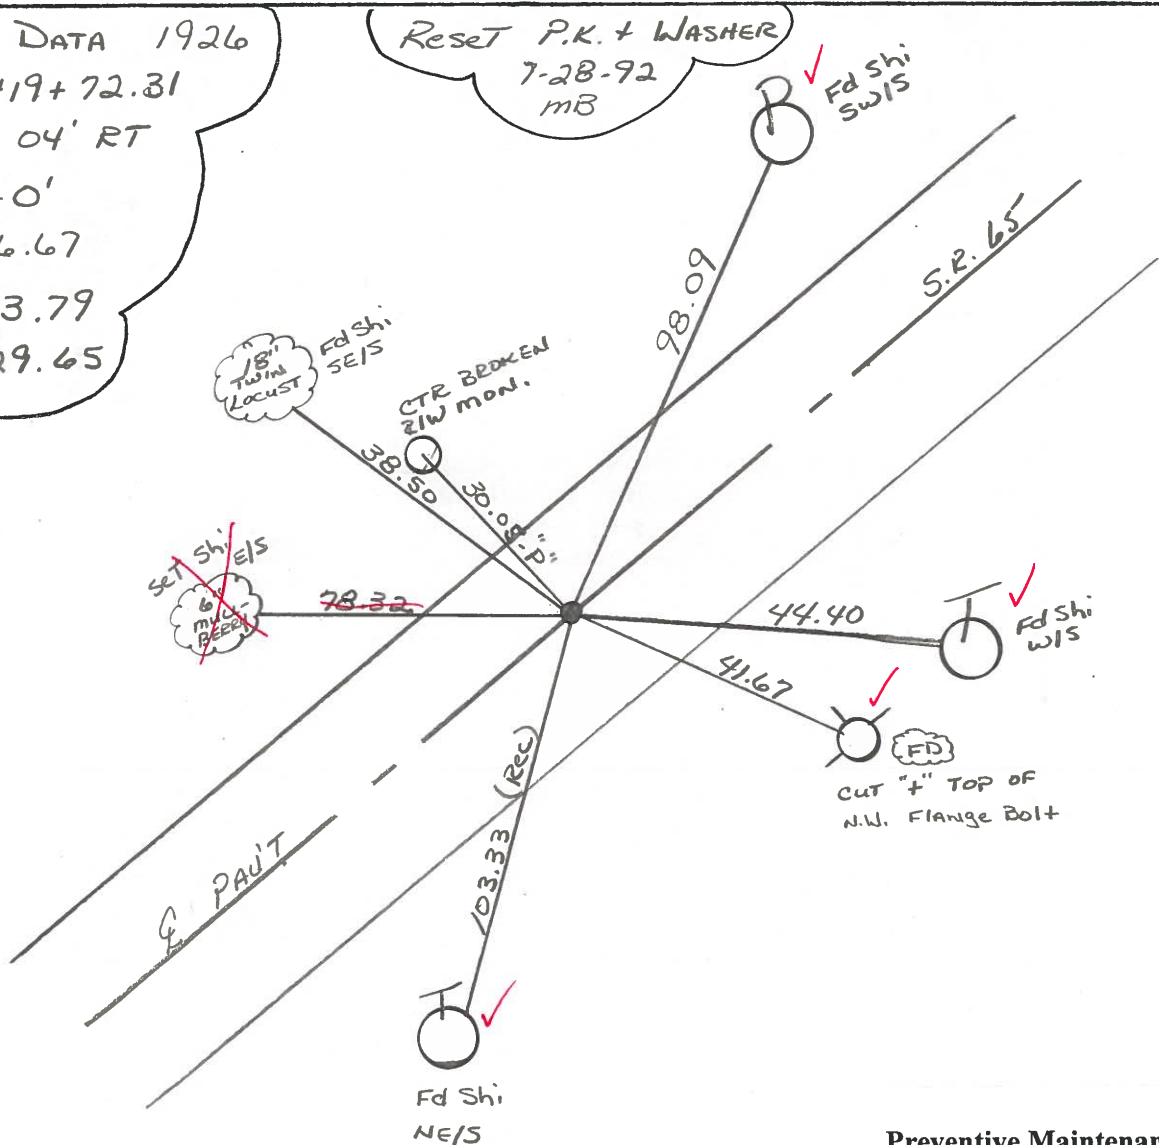

Preventive Maintenance  
Microsurfaced 2004  
Existing Point Uncovered  
Date 8/5/04 MB

SMT-1

O.D.O.T. DISTRICT 2 SURVEY OFFICE

SHEET 30 OF 91

County Wood S.R. 65

Date 4-11-84

Township MIDDLETON

Weather Clear

Section R.T. 44

Temp. 45°

T&N, R10E


Personnel HOFFMAN

LOHRKE

HOUSEHOLDER H.C.

BAGHISEL R.C.

18-C

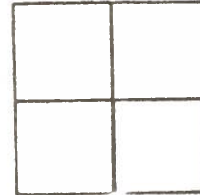


Fd P.K. @ surface

SLM 522+06

oil & paint  
9.2' to Lt. EP.  
9.3' to Rt. EP.

SET P.K./WASHER  
10-10-84  
S.W.H.

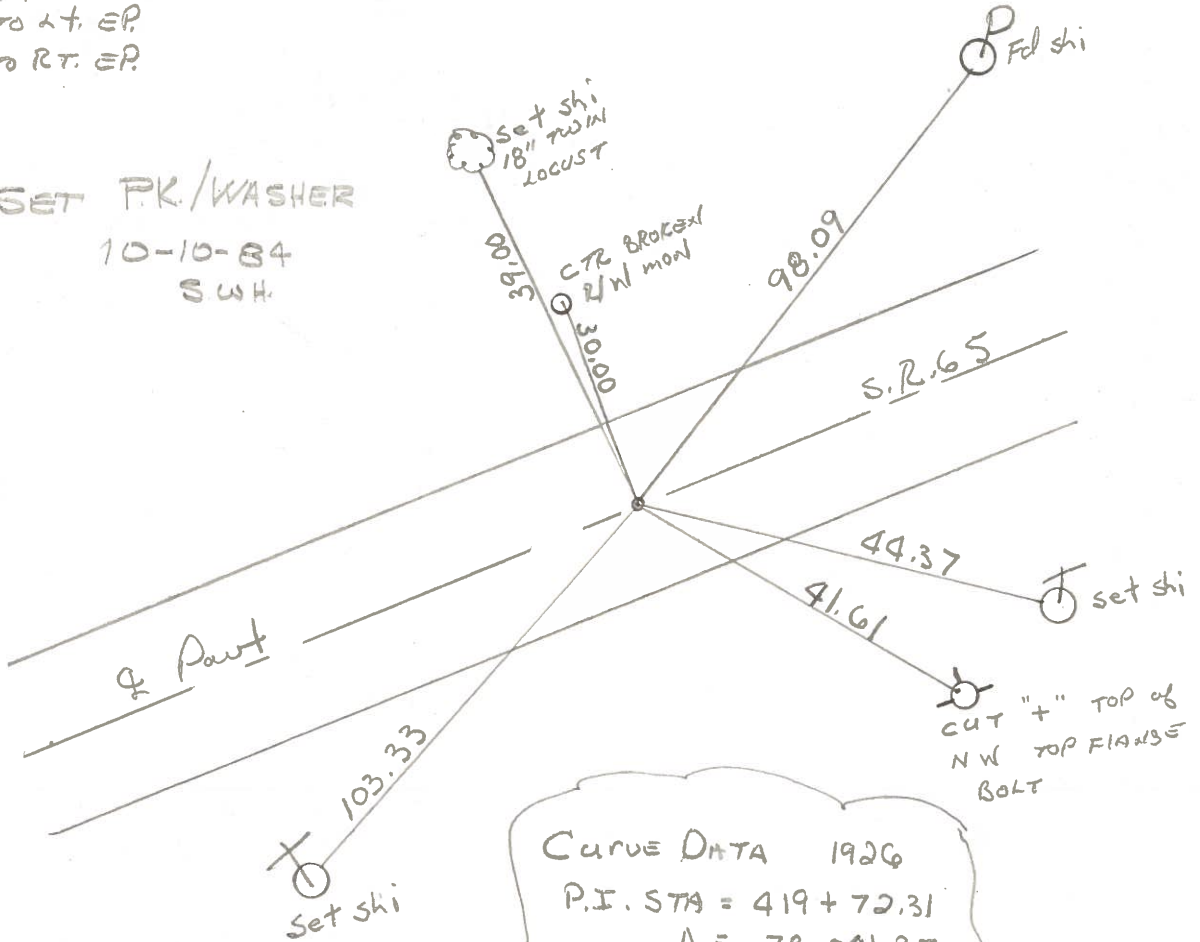

CURVE DATA 1926  
 P.I. STA = 419+72.31  
 $\Delta = 70.04'$  RT  
 $D = 10.0'$   
 $L = 706.67$   
 $T = 353.79$   
 $R = 5729.65$

PERSONNEL	TITLE	PERSONNEL	TITLE
BURNSIDE			
SMITH			
BOWERS			
KIOWSKI			

COUNTY Wood DATE 11-13-72

S. R. 65 WEATHER Cloudy

SEC. MIDDLETON TWP TEMP. +38°

DESCRIPTION ESTABLISH & REF. & CONTROL FBINTS JOB NO. \_\_\_\_\_

