


**O.D.O.T. DISTRICT 2 SURVEY OFFICE (USE ONLY)**


PERSONNEL	REFERENCE NO. <u>19 E</u>	SHEET <u>56</u> OF <u>63</u>
NOTES	LEU	DATE <u>4/30/15</u>
H.C.	O'DONNELL	WEATHER <u>CLOUDY</u>
R.C.	RHOADES	TEMP. <u>50°</u>
		ROUTE <u>SR 65</u>
		COUNTY <u>WOOD</u>
		TOWNSHIP <u>MIDDLETON</u>
		SECTION <u>RT 46</u>
		T <u>1</u> R <u>10 E</u>

TYPE MONUMENT P.K./WASHER  
 ON SURFACE - ~~BELOW~~ ON  
~~LEFT~~ - PAV'T - RIGHT 5.5'  
4.0' TORT EDGE PAVEMENT  
 S.L.M. 570+59.38

Grid: Northing: 664746.940 Easting: 1634659.402

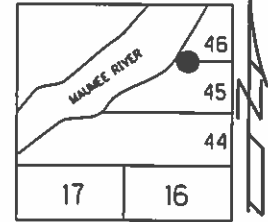

RECORD:  
 ORIGIN UNKNOWN  
 FD P.K./WASHER  
 7/13/92  
 SET P.K./WASHER  
 7/28/92, MB  
 FD P.K./WASHER  
 5/25/04, 8/6/13  
 GPS, REFFE19  
 9/5/13, SDC  
 SET MAG/WASHER  
 GPS, NEWREFE19  
 9/16/15, JFO

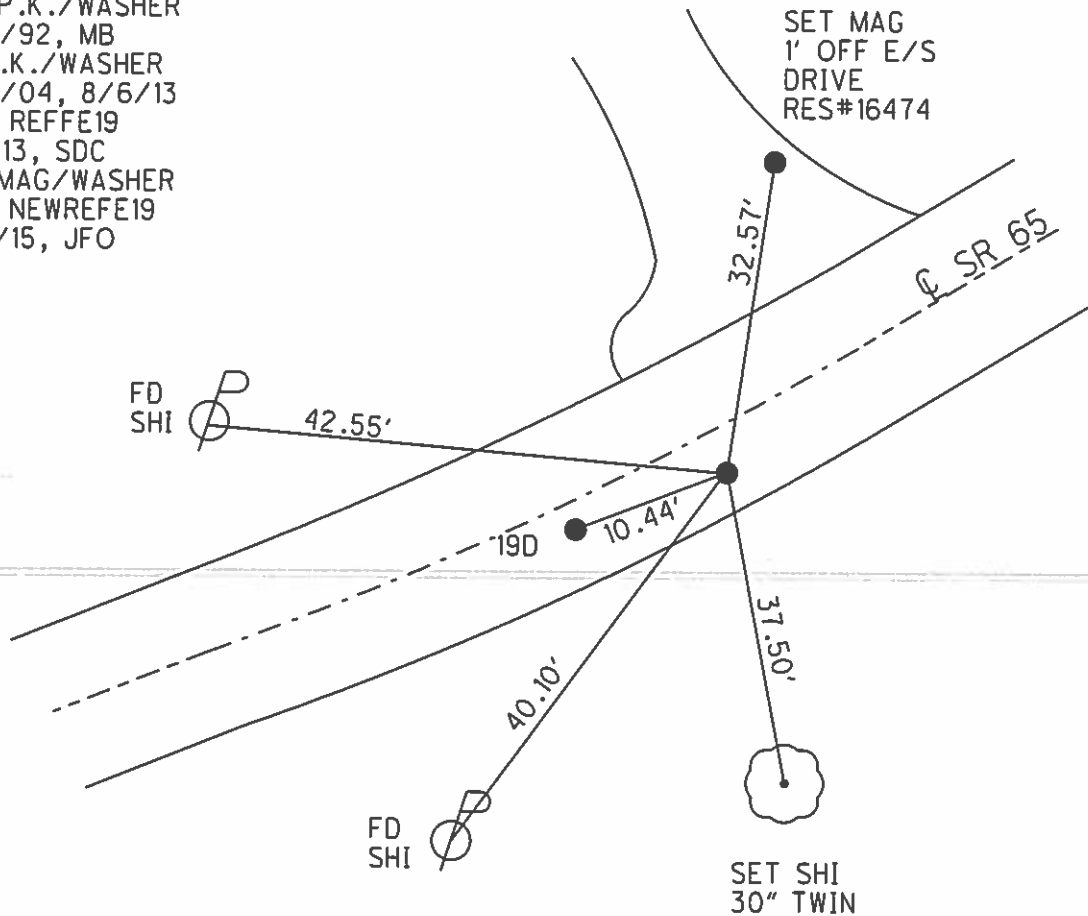



County Wood S.R. 65

Date 4-12-84

Township MIDDLE TOWNSHIP


Weather Clear

Section R. T. 45-46

Temp. 45°

T&N, R/OE

Personnel HOFFMAN

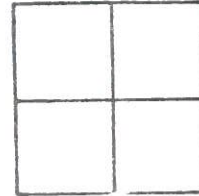

19-D

HOUSEHOLDER H.C.

19-E

19-F

BARNDHISEL R.C.

SET PK/WASHER @ ALL 3 POINTS  
10-10-84  
SLM

SLM 571+71  
FD SHANK @ R.K. NAIL  
@ SURFACE  
2.0' RT of & PAINT  
7.7' TO RT. EP  
12.5' TO LT. EP

RECORD!  
P.T. 473+33.94  
Set P.K. 1972

CURVE DATA 1926

P.I. 472+22.15


$\Delta = 37^\circ - 15' 24''$

$D = 16^\circ - 00'$

$R = 359.27$

$T = 121.02$

$L = 232.81$

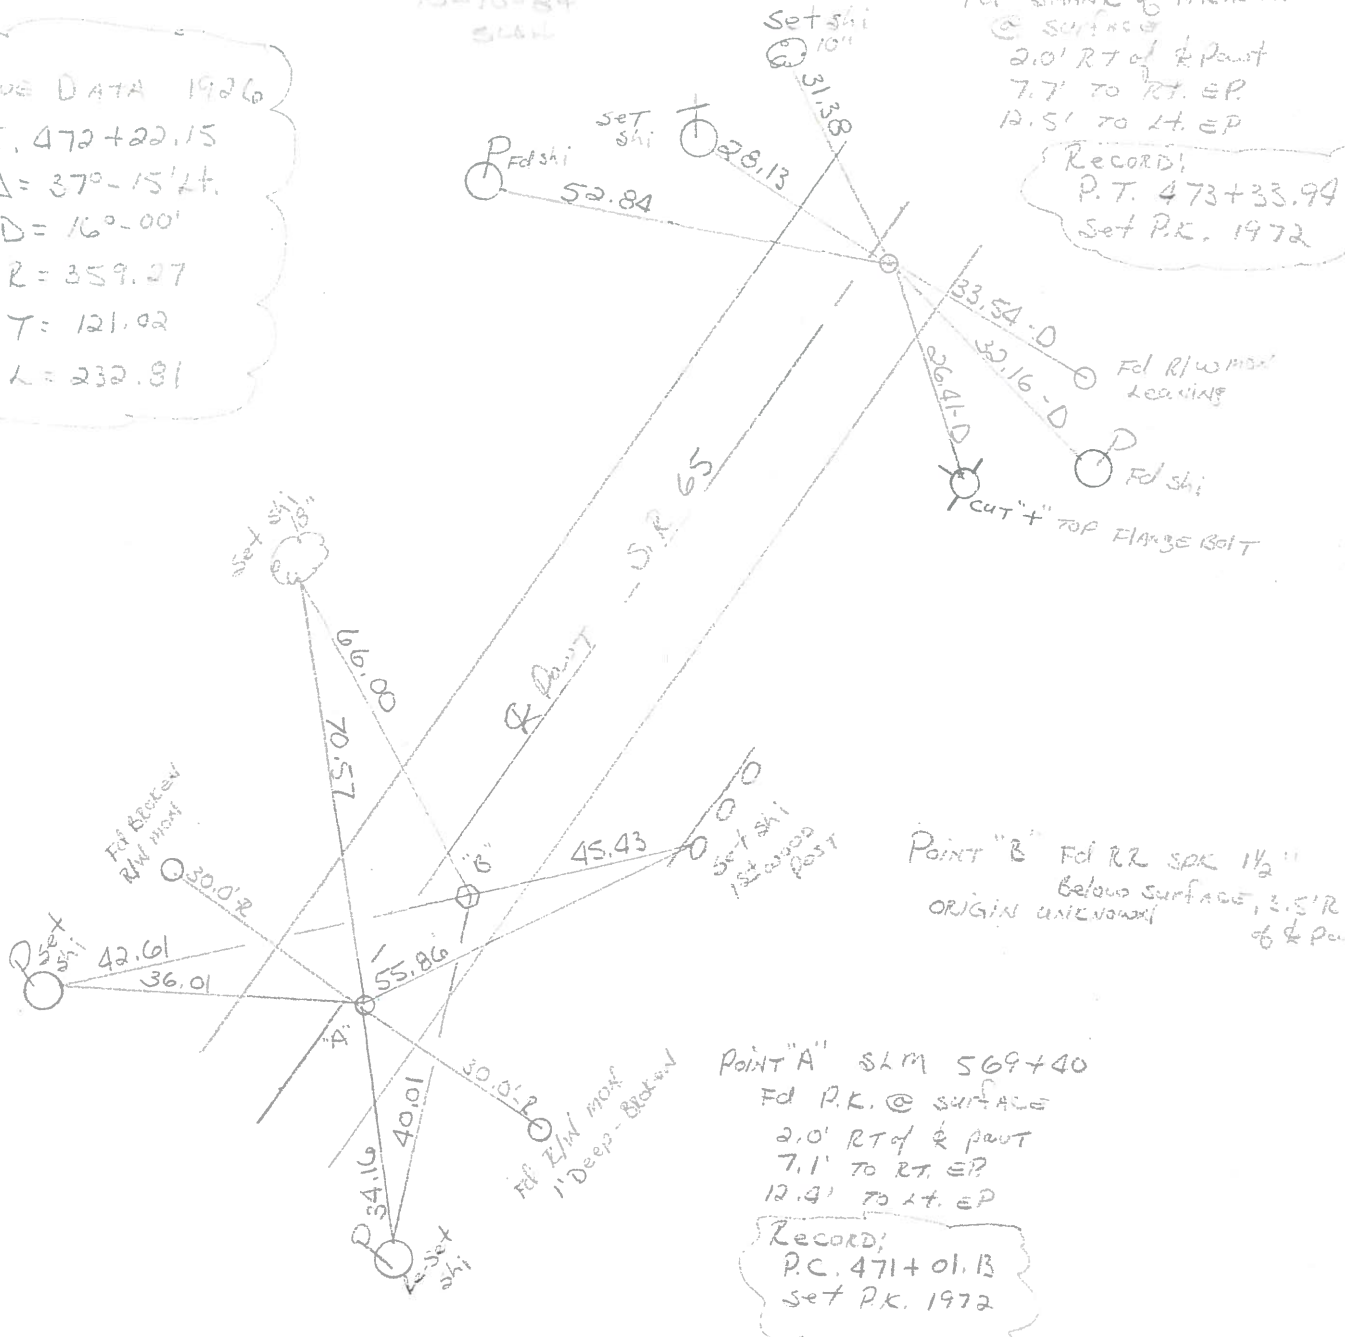

POINT "A" SLM 569+40  
FD R.K. @ SURFACE  
2.0' RT of & PAINT  
7.1' TO RT. EP  
12.4' TO LT. EP  
RECORD!  
P.C. 471+01.13  
Set P.K. 1972

POINT "B" Fd RR SPC 1 1/2"  
Below SURFACE, 3.5' RT  
ORIGIN UNKNOWN  
of & PAINT