

O.D.O.T. DISTRICT 2 SURVEY OFFICE (USE ONLY)

PERSONNEL

REFERENCE NO 20 C

SHEET 61 OF 63


NOTES BARNHEISEL
 H.C. VAN DUSEN
 R.C. KUSZ
BURNETT

DATE 7/13/92
 WEATHER CLOUDY
 TEMP. 72°


ROUTE SR 65
 COUNTY WOOD
 TOWNSHIP MIDDLETON
 SECTION RT 47
 T 1 R 10 E

TYPE MONUMENT P.K./WASHER
 ON SURFACE - ~~BELOW~~ ON
 LEFT - PAV'T - ~~RIGHT~~ 1.0'
8.8' TOLT EDGE PAVEMENT
 S.L.M. 595+42.12

Grid: Northing: 666729.960 Easting: 1636132.215

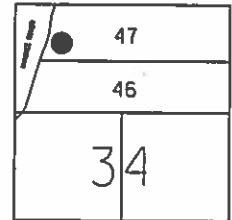

RECORD: P.C.
 STA. 497+36.70
 SET P.K.NAIL 1972
 FD P.K./WASHER
 7/13/92
 SET P.K./WASHER
 9/4/92, MB
 FD P.K./WASHER
 5/25/04
 FD MONBOX
 GPS, REFFC20
 9/10/13, SDC

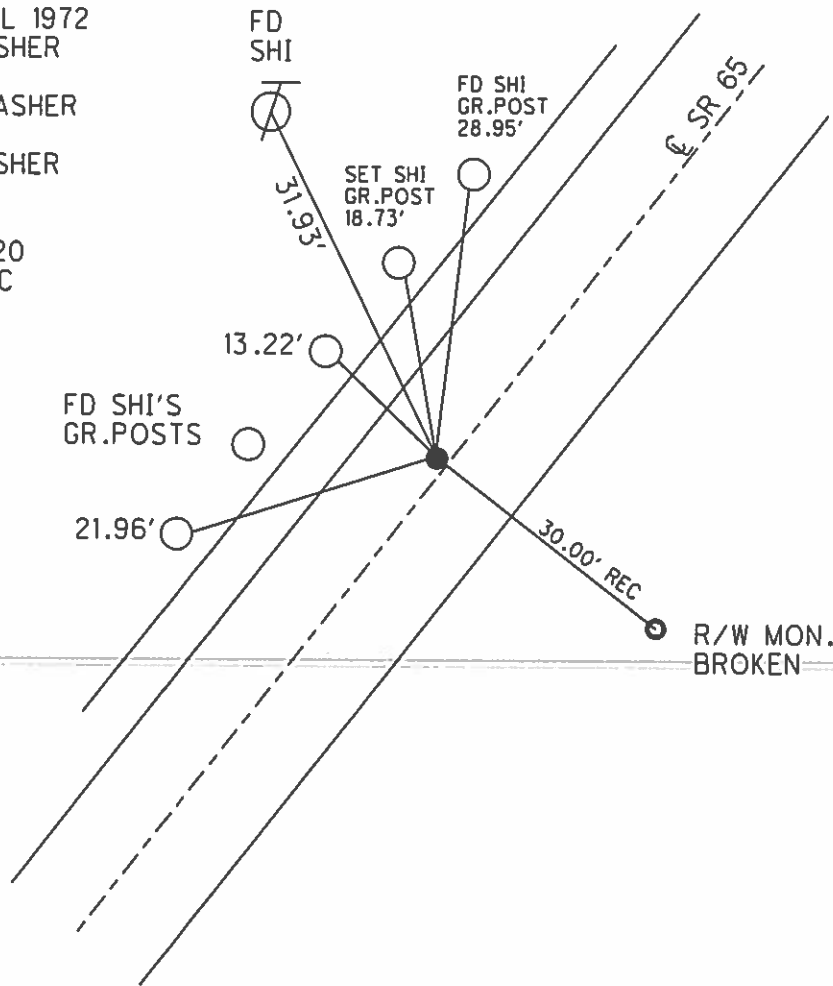

RECORD: P.I.
 CURVE DATA 2011
 STA. 596+61.23
 $\Delta = 08^\circ 25' 15''$ RT
 D = $1^\circ 45' 00''$
 R = 3274.04
 T = 241.03
 L = 481.19

O.D.O.T. DISTRICT 2 SURVEY OFFICE

PERSONNEL _____

REFERENCE NO. _____

SHEET 35 OF 34

NOTES BARNHISEL

H.C. VAN DUSEN

R.C. KUSZ

BURNETT

DATE 5/25/04

DATE ~~7-13-92~~

WEATHER cloudy

TEMP. +72°

ROUTE 65

COUNTY WOOD

TOWNSHIP MIDDLETON

SECTION R.T. 47

T 6 N R 10 E

P.C. fd. P.T.

TYPE MONUMENT P.K.'S + WASHERS

20-C

ON SURFACE - ~~BELW~~ yes yes

LEFT- & PAW'T. - ~~RIGHT~~ 1.0 1.7

20-D

- TO LT EDGE PAVEMENT 8.8 / 8.3

S.L.M. 595+73 ~ 597+79

	47
	46
	34




Reset P.K.'S + WASHERS
9-4-92
MB

Preventive Maintenance
Microsurfaced 2004
Existing Point Uncovered
Date 8/5/04 M.B.

RECORD:
P.T. = 499+42.95
Set P.K. 1972

RECORD
P.C. = 497+36.70
Set P.K. 1972

CURVE DATA 1926
P.I. = 498+40.00
 $\Delta = 8^{\circ}-15' RT$
 $D = 4^{\circ}-0'$
 $R = 1432.69$
 $T = 103.30$
 $L = 206.25$

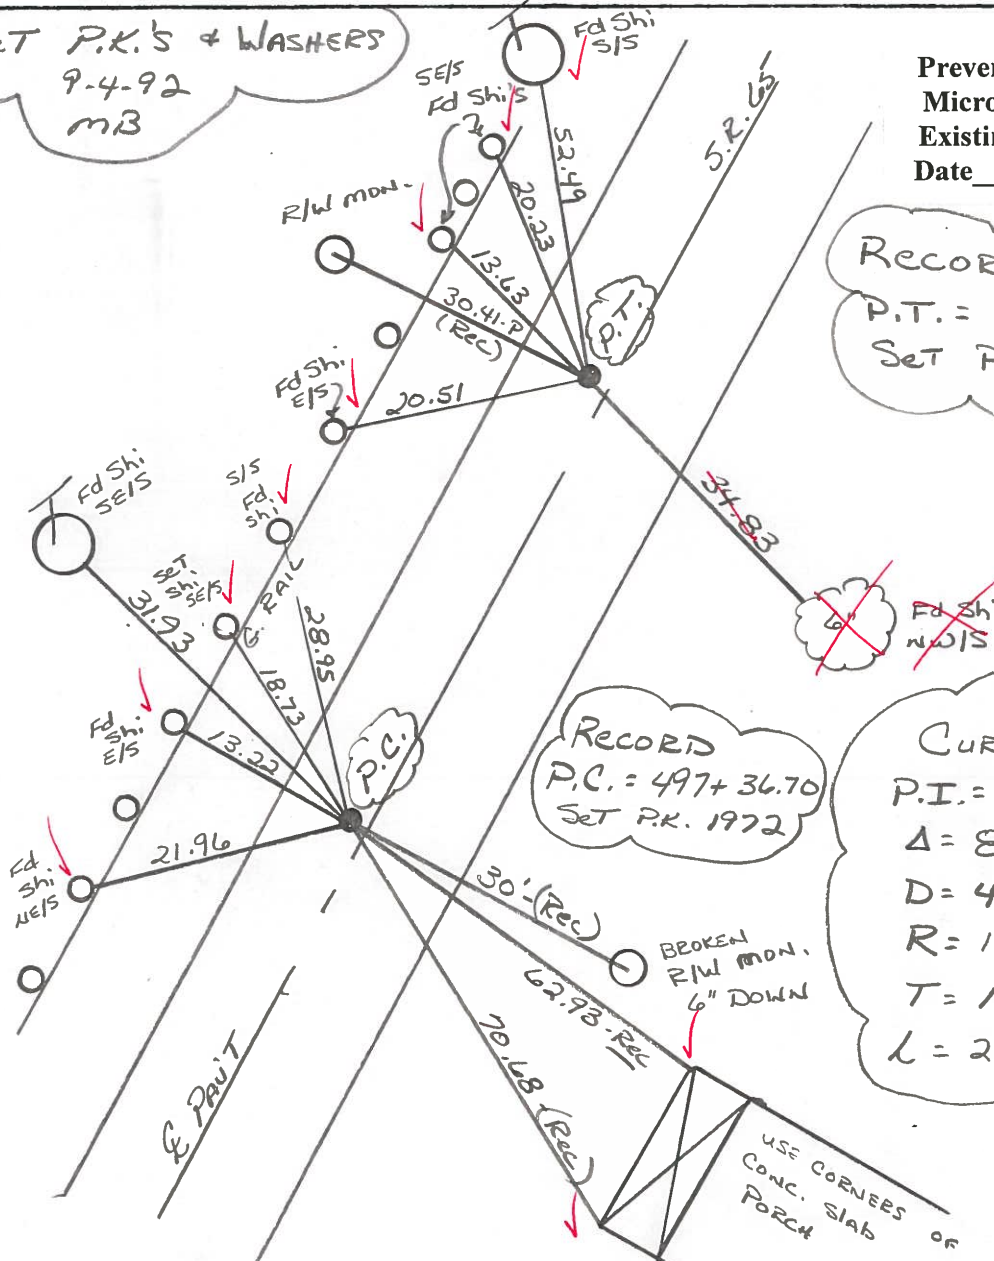

USE CORNERS OF
CONC. SLAB
PORCH

County WOOD S.R. 65

Date 4-12-84

Township MIDDLETON

Weather CLEAR

Section R.T. 47

Temp. 50°

T&N, R10E


Personnel HOFFMAN

HOUSEHOLDER H.C.

BARNHISEL R.C.

20-C

20-D

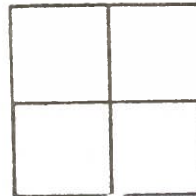

SET PK/WASHER

Ⓢ BOTH POINTS

10-10-84


S.W.H.

S.L.M. 597 + 79
Fd P.K. @ SURFACE
2.4' Lt. of & Paint
7.4' TO Lt. EP
12.5' TO RT. EP

Record:
P.T. STA = 499 + 42.95
Set P.K. 1972

S.L.M. 595 + 73
Fd P.K. @ SURFACE
0.7' Lt. of & Paint
8.6' TO Lt. EP
10.3' TO RT. EP

Record:
P.C. 497 + 36.7
Set P.K. 1972

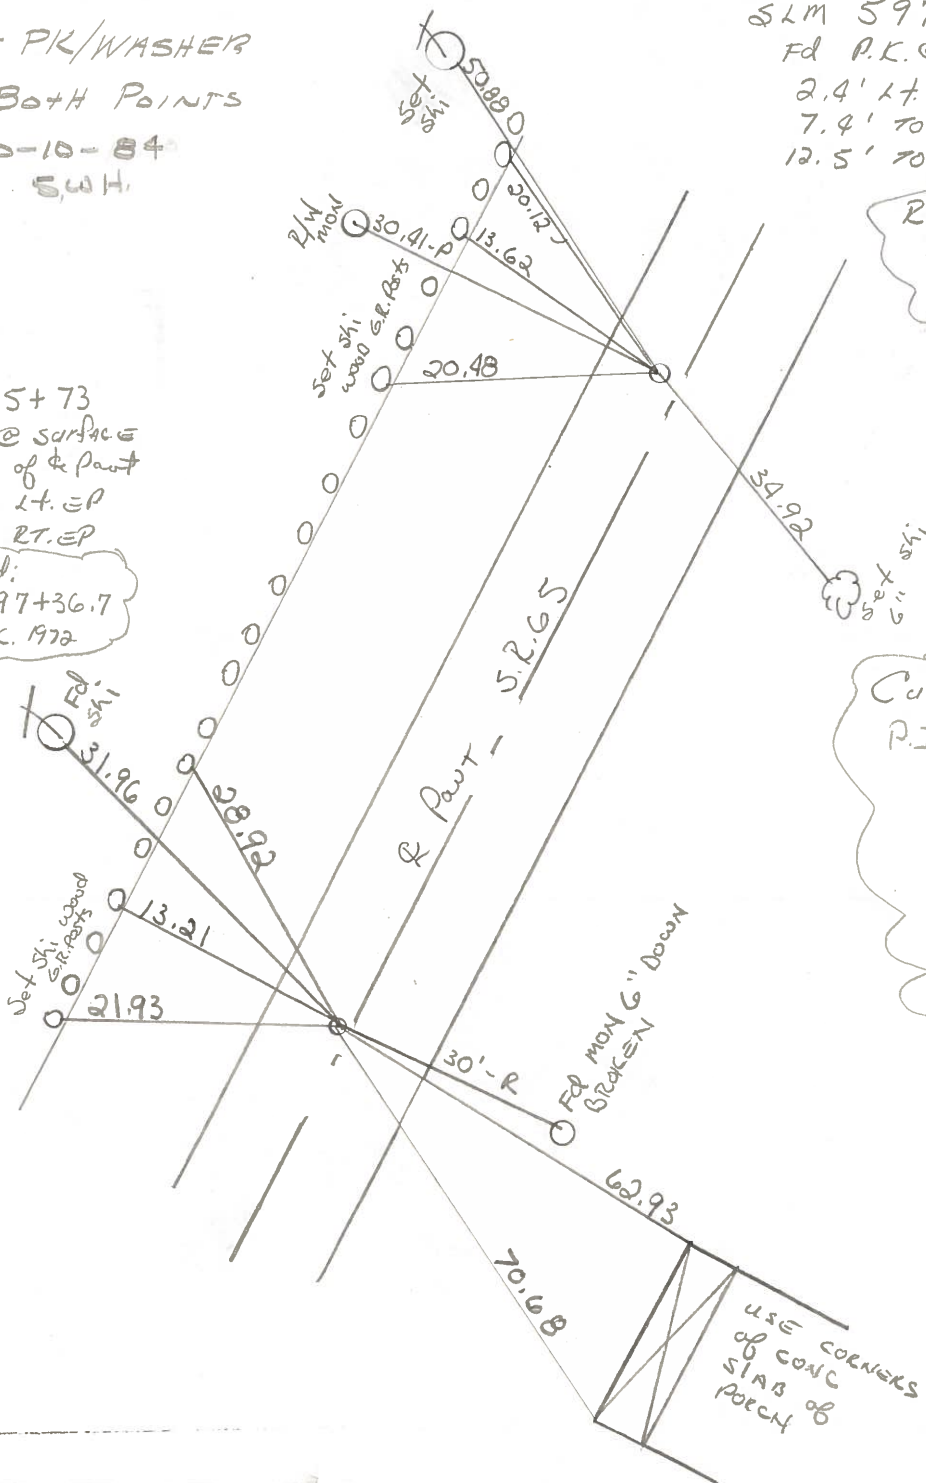

CURVE DATA 1926
P.I. STA = 498 + 40.00
Δ = 8° - 15' RT
D = 4° - 0'
R = 1432.69
T = 103.30
L = 206.25

USE CORNERS
OF CONC
SLAB OF
POUCH

PERSONNEL TITLE PERSONNEL TITLE

COUNTY Wood DATE June 20, 1966

W. Dennis

D. Curtis


J. Teal

J. Brindley

S. R. 65 WEATHER warm

SEC. _____ TEMP. 70°±

DESCRIPTION S. R. 65 - Ref Mon. & Control Points - S. R. 64 JOB NO. 0299401

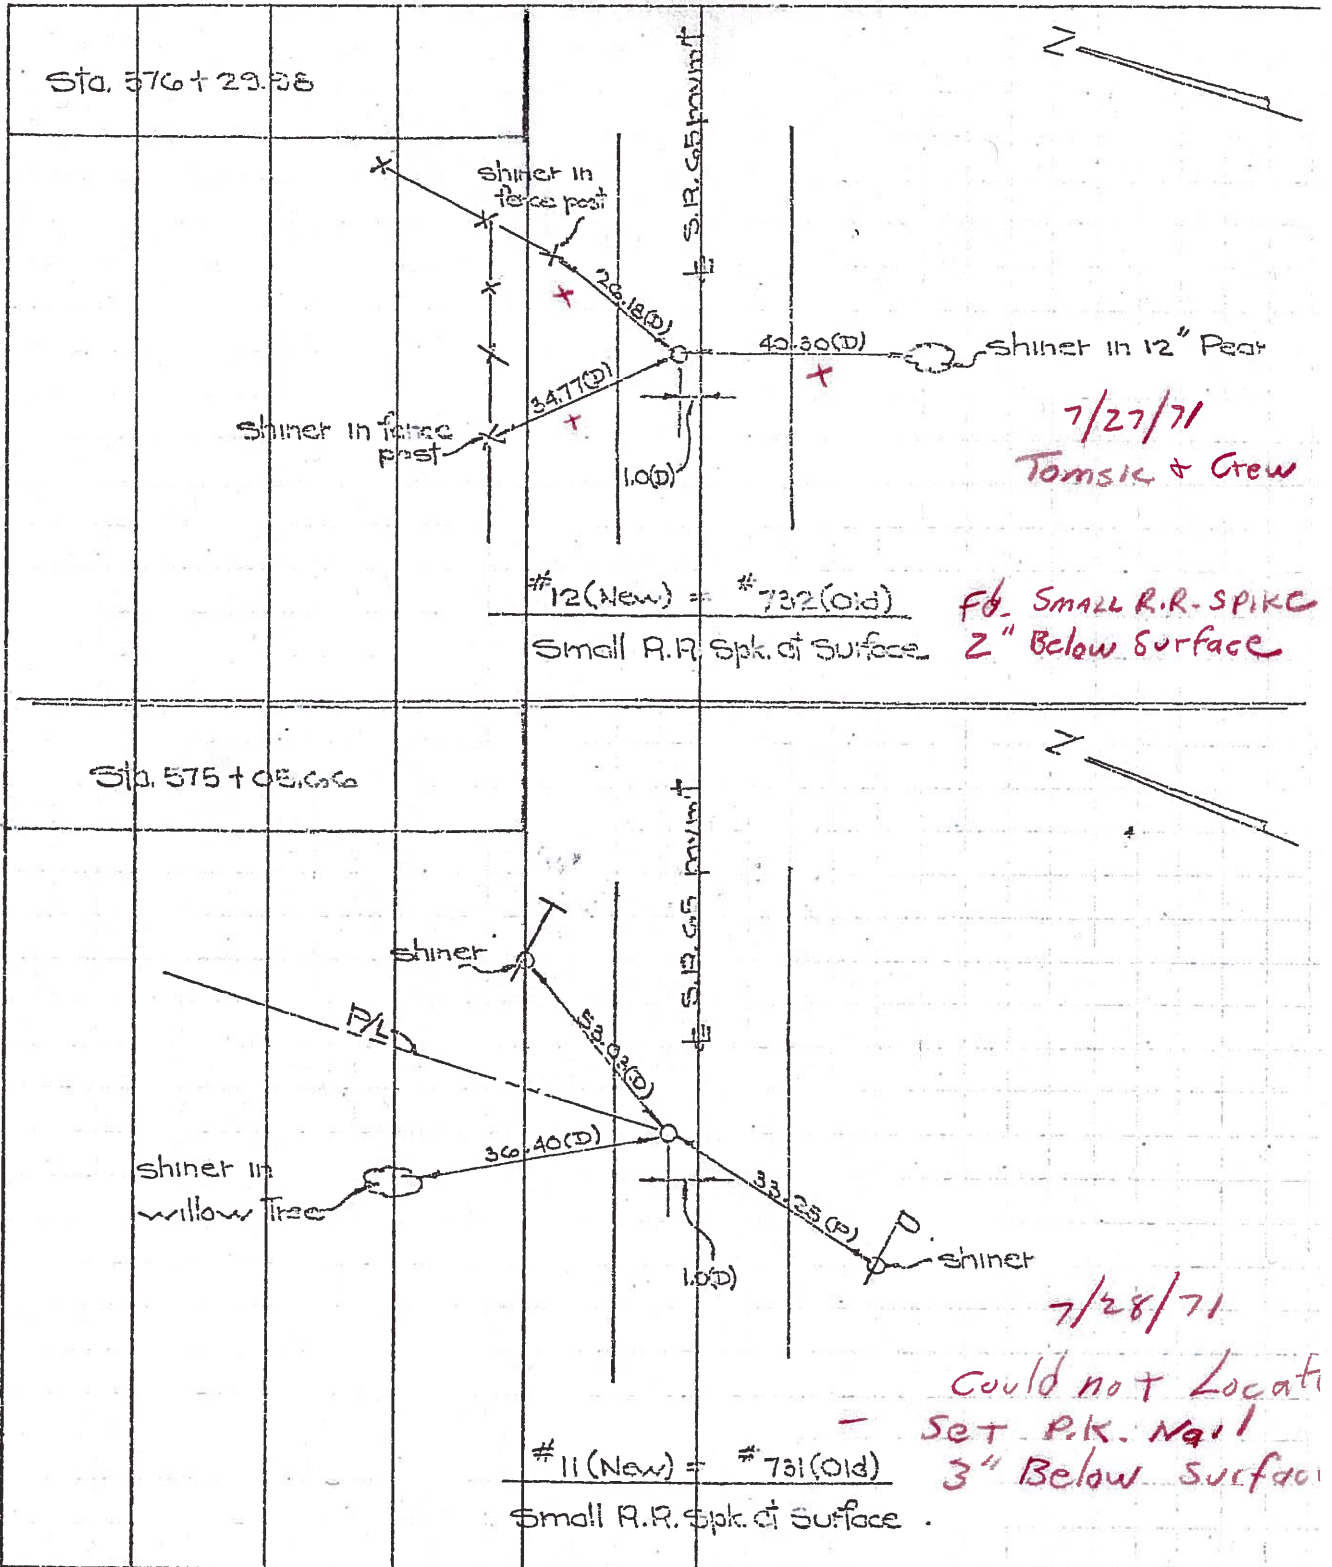

PERSONNEL TITLE PERSONNEL TITLE

JAMESON notes
Williams
Phillips

COUNTY Wood

DATE 6-24-59

S. R. 65


WEATHER Cloudy

SEC.

TEMP 75°

DESCRIPTION Ties & Wit's. to Points

JOB NO.

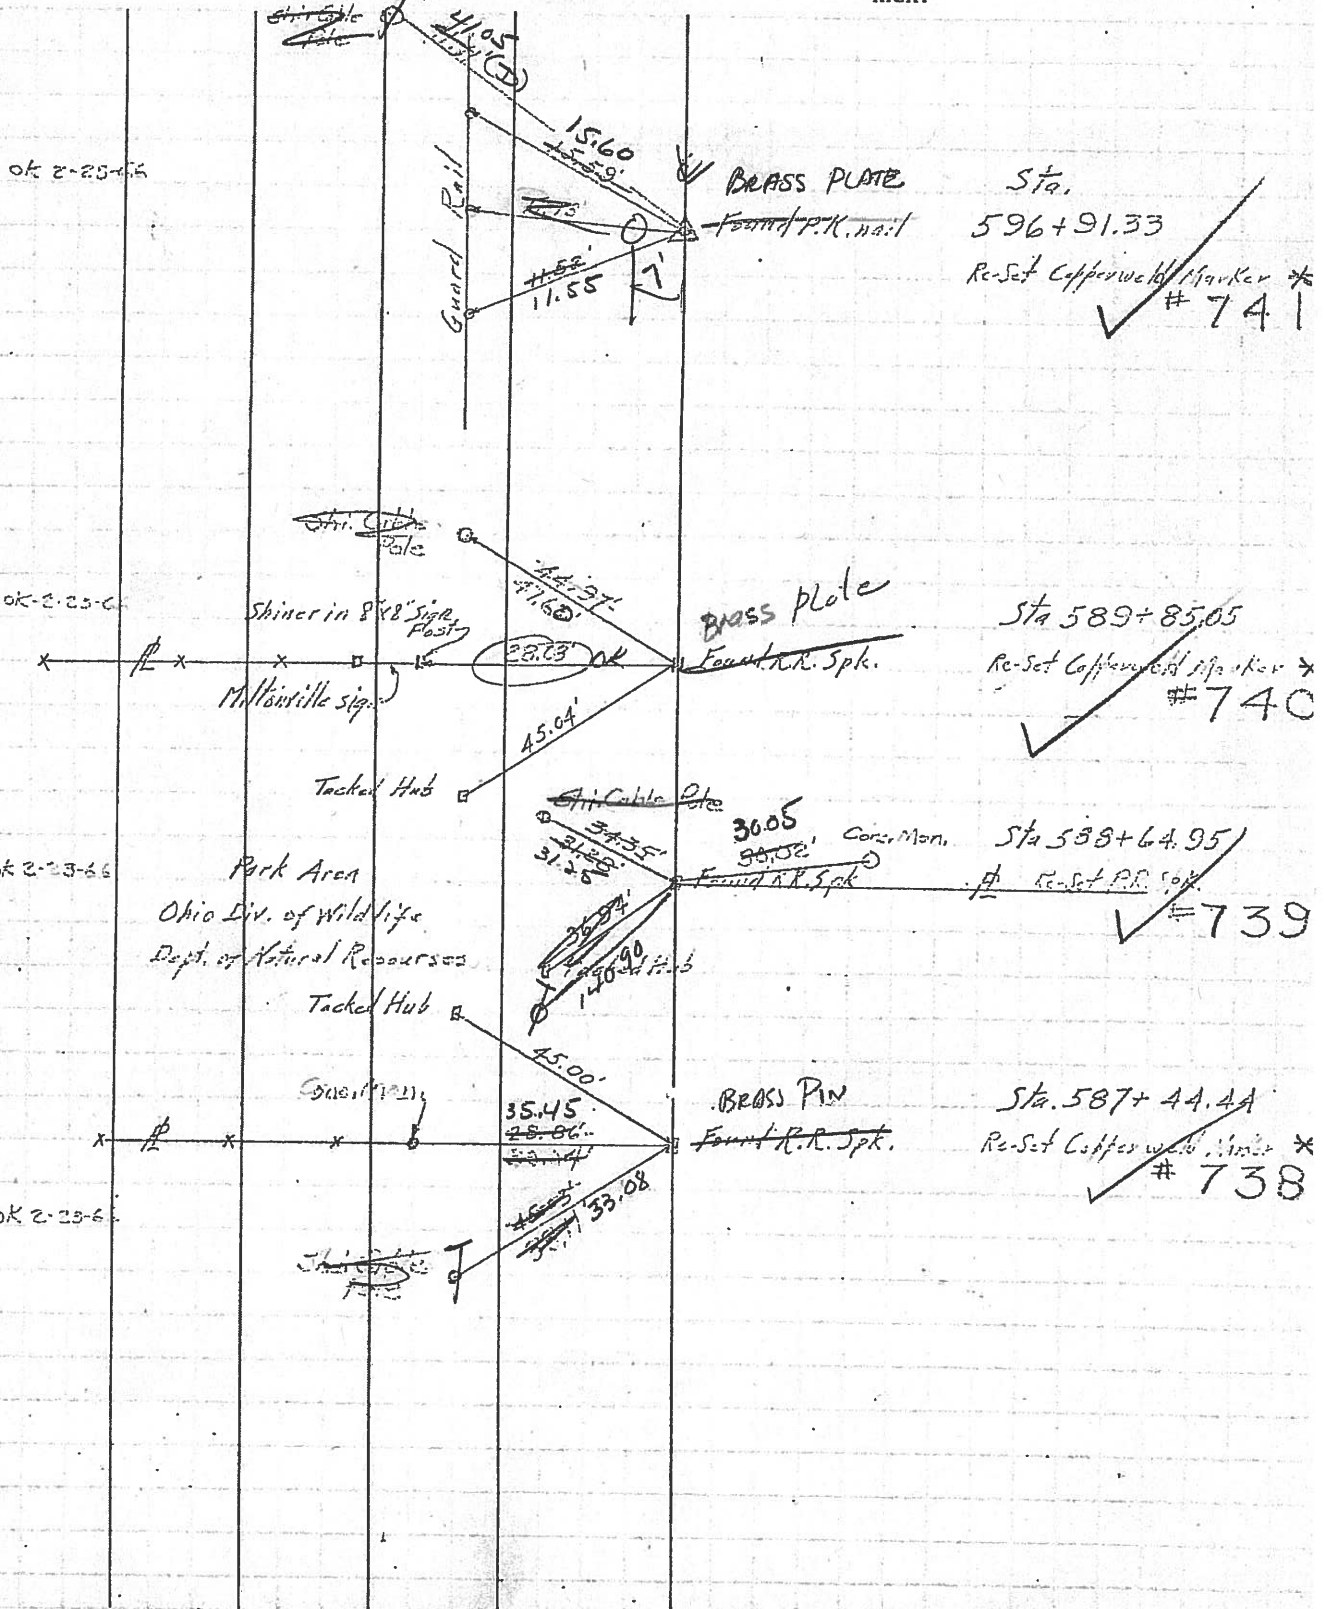

PERSONNEL	TITLE	PERSONNEL	TITLE	COUNTY	<u>Wood</u>	DATE	<u>11-16-72</u>
<u>BURNSIDE</u>				S. R.	<u>65</u>	WEATHER	<u>Cloudy</u>
<u>SMITH</u>				SEC.	<u>MIDDLETON TWP</u>	TEMP.	<u>+36°</u>
<u>BOWERS</u>							
<u>KIJOWSKI</u>							

DESCRIPTION ESTABLISH & REF. & CONTROL POINTS JOB NO. _____

