


O.D.O.T. DISTRICT 2 SURVEY OFFICE (USE ONLY)


PERSONNEL	REFERENCE NO <u>20 D</u>	SHEET <u>62</u> OF <u>63</u>
NOTES <u>BARNHISEL</u>	DATE <u>7/13/92</u>	ROUTE <u>SR 65</u>
H.C. <u>VAN DUSEN</u>	WEATHER <u>CLOUDY</u>	COUNTY <u>WOOD</u>
R.C. <u>KUSZ</u>	TEMP. <u>72°</u>	TOWNSHIP <u>MIDDLETON</u>
<u>BURNETT</u>		SECTION <u>RT 47</u>
		T <u>1</u> R <u>10</u> E

TYPE MONUMENT P.K./WASHER
 ON SURFACE - BELOW ON
 LEFT - PAV'T - RIGHT 1.7'
8.3' TOLT EDGE PAVEMENT
 S.L.M. 600+23.58

Grid: Northing: 667102.431 Easting: 1636436.309

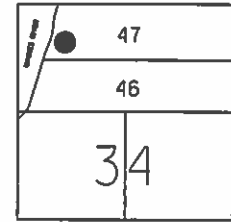

RECORD: P.T.
 STA. 499+42.95
 SET P.K.NAIL 1972
 FD P.K./WASHER
 7/13/92
 SET P.K./WASHER
 9/4/92, MB
 FD P.K./WASHER
 5/25/04
 FD MONBOX
 GPS, REFFD20
 9/10/13, SDC

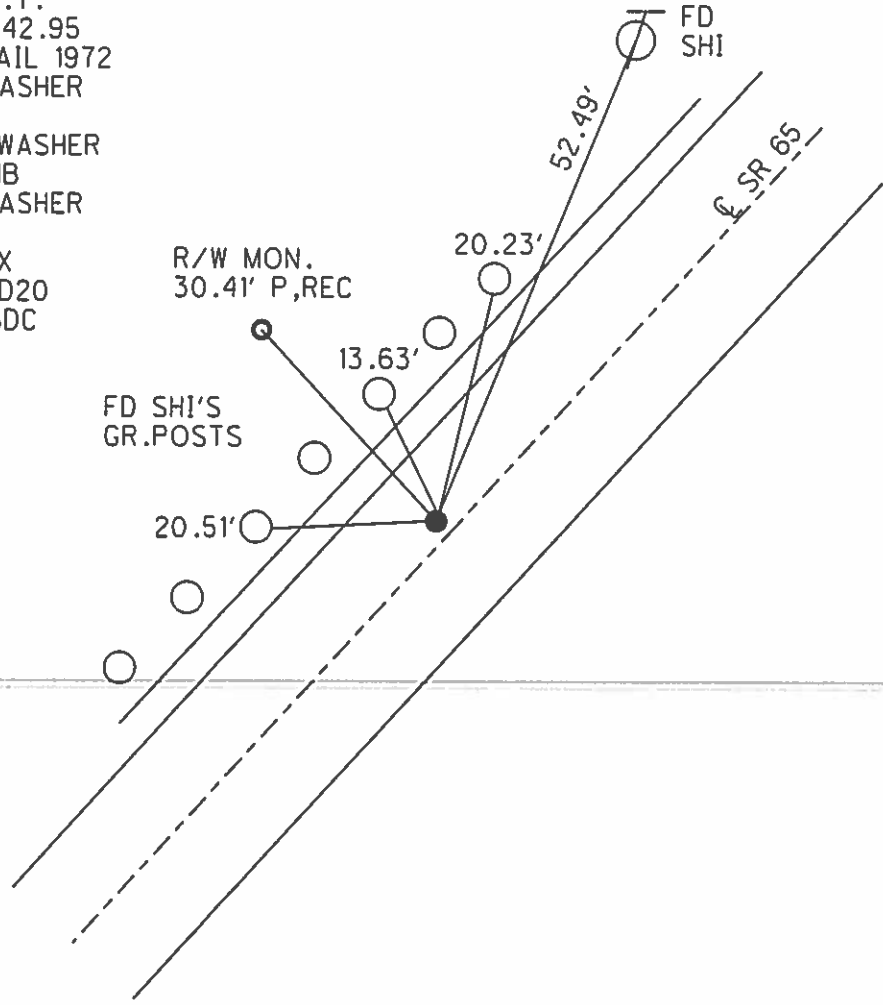

O.D.O.T. DISTRICT 2 SURVEY OFFICE

PERSONNEL

REFERENCE NO. _____

SHEET 35 OF 36

NOTES BARNHISEL

H.C. VAN DUSEN

R.C. KUSZ

BURNETT

DATE 5/25/04

~~7/3/72~~

WEATHER cloudy

TEMP. +72°

ROUTE 65

COUNTY WOOD

TOWNSHIP MIDDLETON

SECTION R.T. 47

T 6 N R 10 E

P.C. 10. P.T. _____
 TYPE MONUMENT P.K.'S + WASHERS

ON SURFACE - ~~BELOW~~ yes yes

LEFT- & PAV'T. - RIGHT 1.0 1.7

- TO LT EDGE PAVEMENT 8.8 / 8.3

S.L.M. 595+73 ~ 597+79

20-C

20-D

47
46
34




Reset P.K.'S + WASHERS
 9-4-92
 MB

Preventive Maintenance
 Microsurfaced 2004
 Existing Point Uncovered
 Date 8/5/04 MB

RECORD:
 P.T. = 499+42.95
 Set P.K. 1972

RECORD
 P.C. = 497+36.70
 Set P.K. 1972

CURVE DATA 1926
 P.I. = 498+40.00
 $\Delta = 8^{\circ}-15' RT$
 $D = 4^{\circ}-0'$
 $R = 1432.69$
 $T = 103.30$
 $L = 206.25$

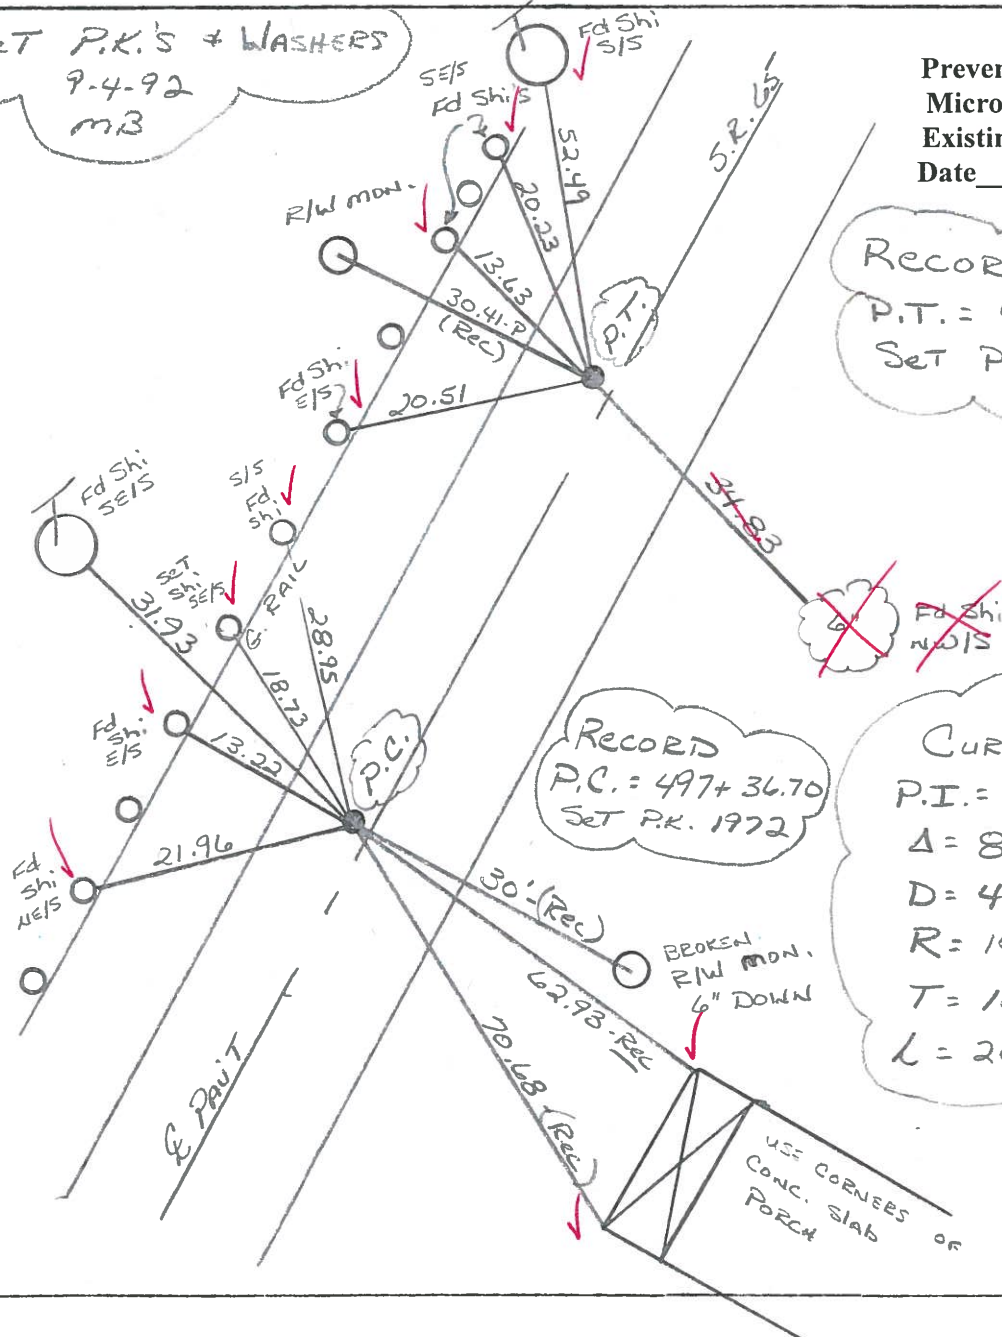

PERSONNEL TITLE PERSONNEL TITLE
BUENSIDE _____
SMITH _____
BOWERS _____
Kijowski _____

COUNTY WOOD DATE 11-16-72
 S. R. 65 WEATHER CLOUDY
 SEC. MIDDLETON TWP TEMP. +36°

DESCRIPTION ESTABLISH & REF. & CONTROL POINTS JOB NO. _____
 LEFT CENTER LINE RIGHT

