


O.D.O.T. DISTRICT 2 SURVEY OFFICE (USE ONLY)

PERSONNEL	REFERENCE NO. <u>20 E</u>	SHEET <u>63</u> OF <u>63</u>
NOTES	<u>BARNHESEL</u> DATE <u>7/13/92</u>	ROUTE <u>SR 65</u>
H.C.	<u>VAN DUSEN</u> WEATHER <u>CLOUDY</u>	COUNTY <u>WOOD</u>
R.C.	<u>KUSZ</u> TEMP. <u>72°</u>	TOWNSHIP <u>MIDDLETON</u>
	<u>BURNETT</u>	SECTION <u>RT 47</u>
		T <u>1</u> R <u>10 E</u>


TYPE MONUMENT P.K./WASHER
 ON SURFACE - ~~BELOW~~ ON
 LEFT - PAV'T - RIGHT -
11.6' TO LT EDGE PAVEMENT
 S.L.M. 602+55.33

Grid: Northing: 667270.590 Easting: 1636593.075

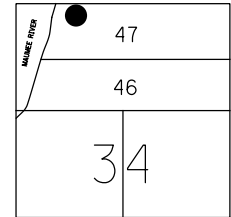

RECORD: P.C.
 STA. 503+35.47
 SET P.K.NAIL 1972
 FD P.K./WASHER
 7/13/92
 SET P.K./WASHER
 9/4/92, MB
 FD P.K./WASHER
 5/25/04
 FD MONBOX
 GPS, REFF21
 9/10/13, SDC

NOTE:
 TIES RECORDED AS RECORD
 WERE PULLED ON 7/13/92.
 UPDATED TIES WERE PULLED
 ON 9/10/13.

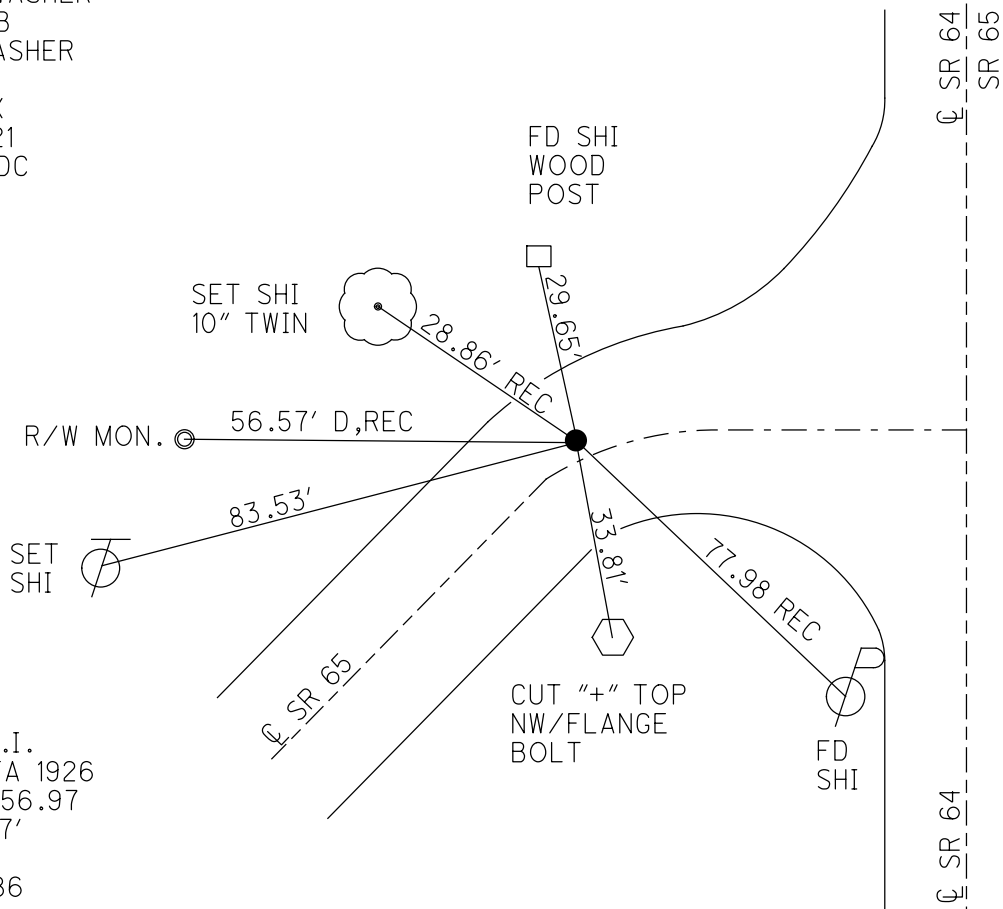


RECORD: P.I.
 CURVE DATA 1926
 STA. 504+56.97
 $\Delta = 23^\circ 57'$
 $D = 10^\circ 0'$
 $R = 573.686$
 $T = 121.50$
 $L = 239.50$

O.D.O.T. DISTRICT 2 SURVEY OFFICE (USE ONLY)


PERSONNEL _____ REFERENCE NO. 21 SHEET 63 OF 63
 NOTES BARNHISEL DATE 7/13/92 ROUTE SR 65
 H.C. VAN DUSEN WEATHER CLOUDY COUNTY WOOD
 R.C. KUSZ TEMP. 72° TOWNSHIP MIDDLETON
BURNETT SECTION RT 47
 T 1 R 10 E

TYPE MONUMENT P.K./WASHER
 ON SURFACE - ~~BELOW~~ ON _____
 LEFT - PAV'T - RIGHT _____
11.6' TOLT EDGE PAVEMENT
 S.L.M. 602+55.33
 Grid: Northing: 667270.590 Easting: 1636593.075

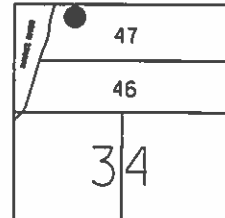

RECORD: P.C.
 STA. 503+35.47
 SET P.K.NAIL 1972
 FD P.K./WASHER
 7/13/92
 SET P.K./WASHER
 9/4/92, MB
 FD P.K./WASHER
 5/25/04
 FD MONBOX
 GPS, REFF21
 9/10/13, SDC

NOTE:
 TIES RECORDED AS RECORD
 WERE PULLED ON 7/13/92.
 UPDATED TIES WERE PULLED
 ON 9/10/13.

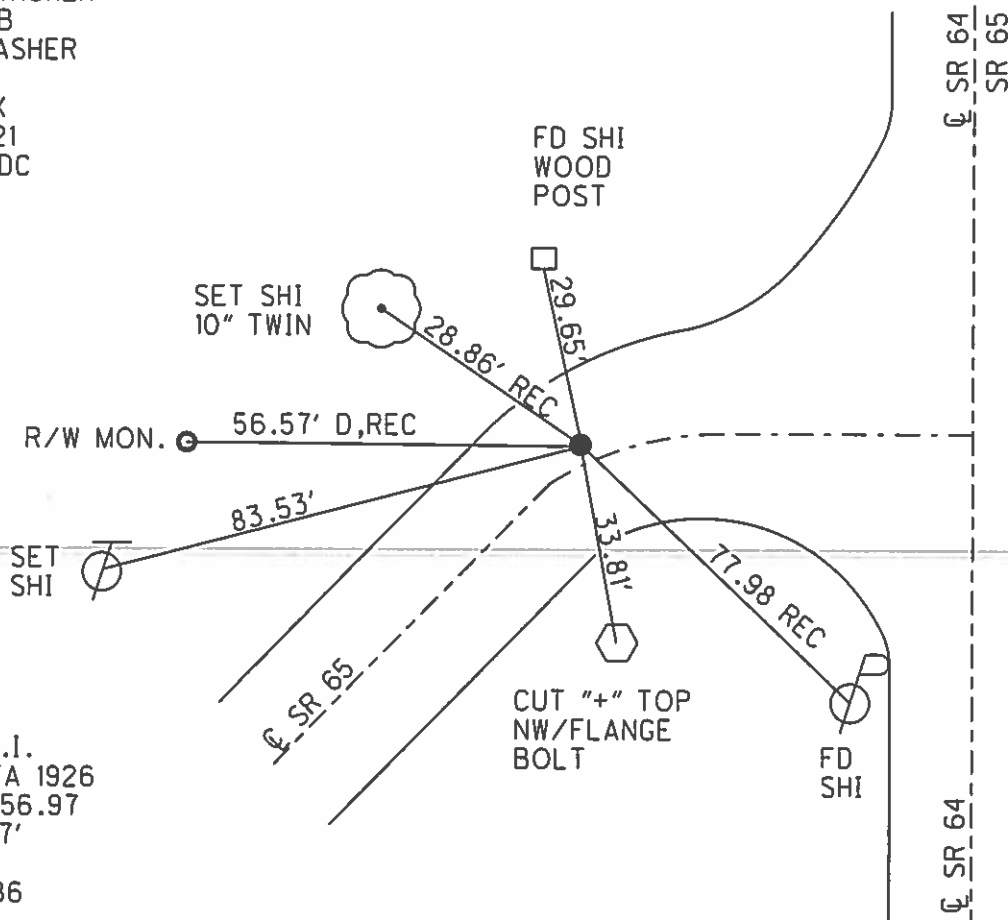

RECORD: P.I.
 CURVE DATA 1926
 STA. 504+56.97
 $\Delta = 23^\circ 57'$
 $D = 10^\circ 0'$
 $R = 573.686$
 $T = 121.50$
 $L = 239.50$

O.D.O.T. DISTRICT 2 SURVEY OFFICE

PERSONNEL _____

REFERENCE NO. _____

SHEET 89 OF 91

NOTES Van Dusen

H.C. Moser

R.C. Huss

DATE 5-18-95

WEATHER Cloudy

TEMP. + 55° F.

ROUTE SR-65

COUNTY Wood

TOWNSHIP Perrysburg

SECTION RT-66

T 7 N R 10 E



TYPE MONUMENT Mon Box

ON SURFACE - BELOW on surface

~~LEFT~~ - C PAV'T. - ~~RIGHT~~ on E

11.1 TO RT EDGE PAVEMENT

S.L.M. 912+11

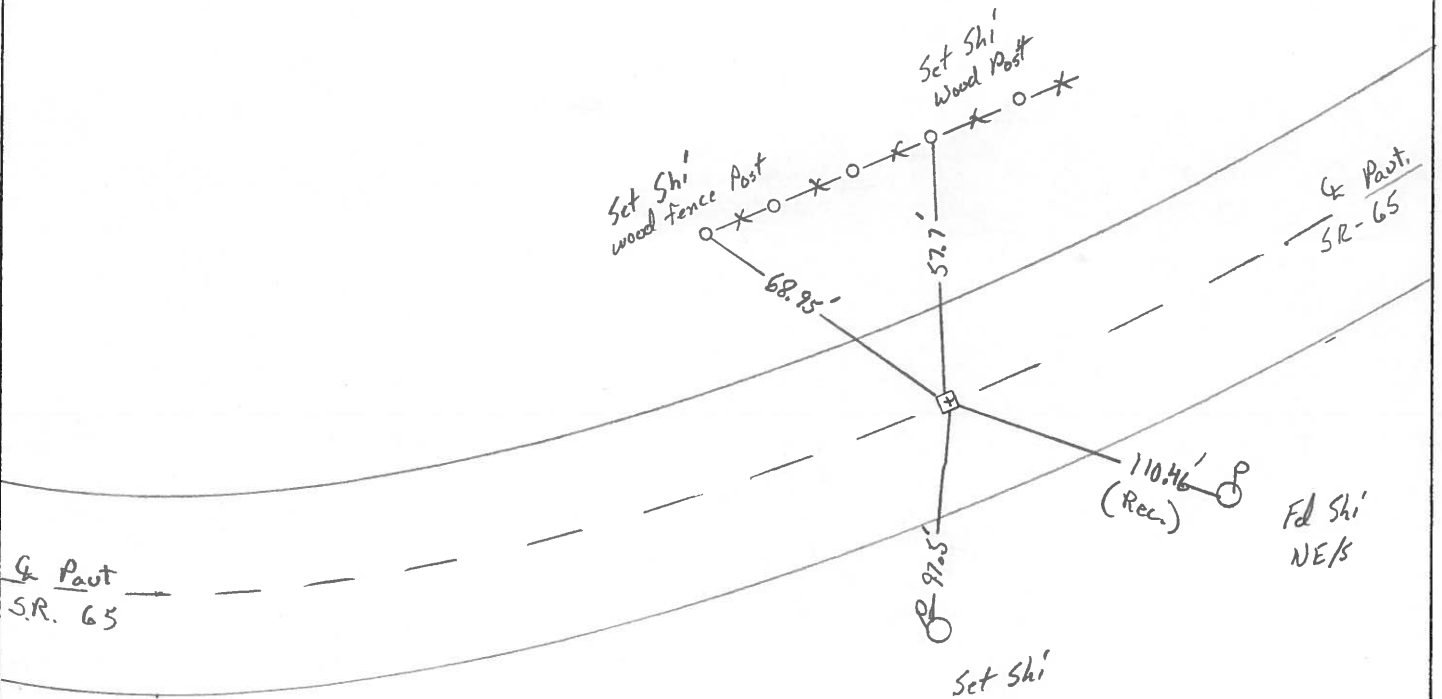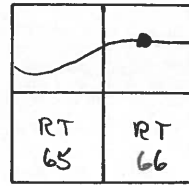

(Record)

Fd Mon Box w/t cut on lid
 Ref to t did not open
 0.5' Lt & 12.9' Rt EOP
 11.8' Lt EOP Set H. 5-11-84

O.D.O.T. DISTRICT 2 SURVEY OFFICE

PERSONNEL _____

REFERENCE NO. _____

SHEET _____ OF _____

NOTES Huss

H.C. CANTERBURY

R.C. WILLIAMS

DATE 5-6-09

WEATHER OVERCAST

TEMP. +64°

ROUTE S.R. #65

COUNTY WOOD

TOWNSHIP MIDDLETON

SECTION 47

T _____ R _____



TYPE MONUMENT BRASS MOBAR

ON SURFACE BELOW ± 5" Down

LEFT - PAV'T. - RIGHT 8.1' LT. of ♀

2.4' TO LT EDGE PAVEMENT

S.L.M. _____

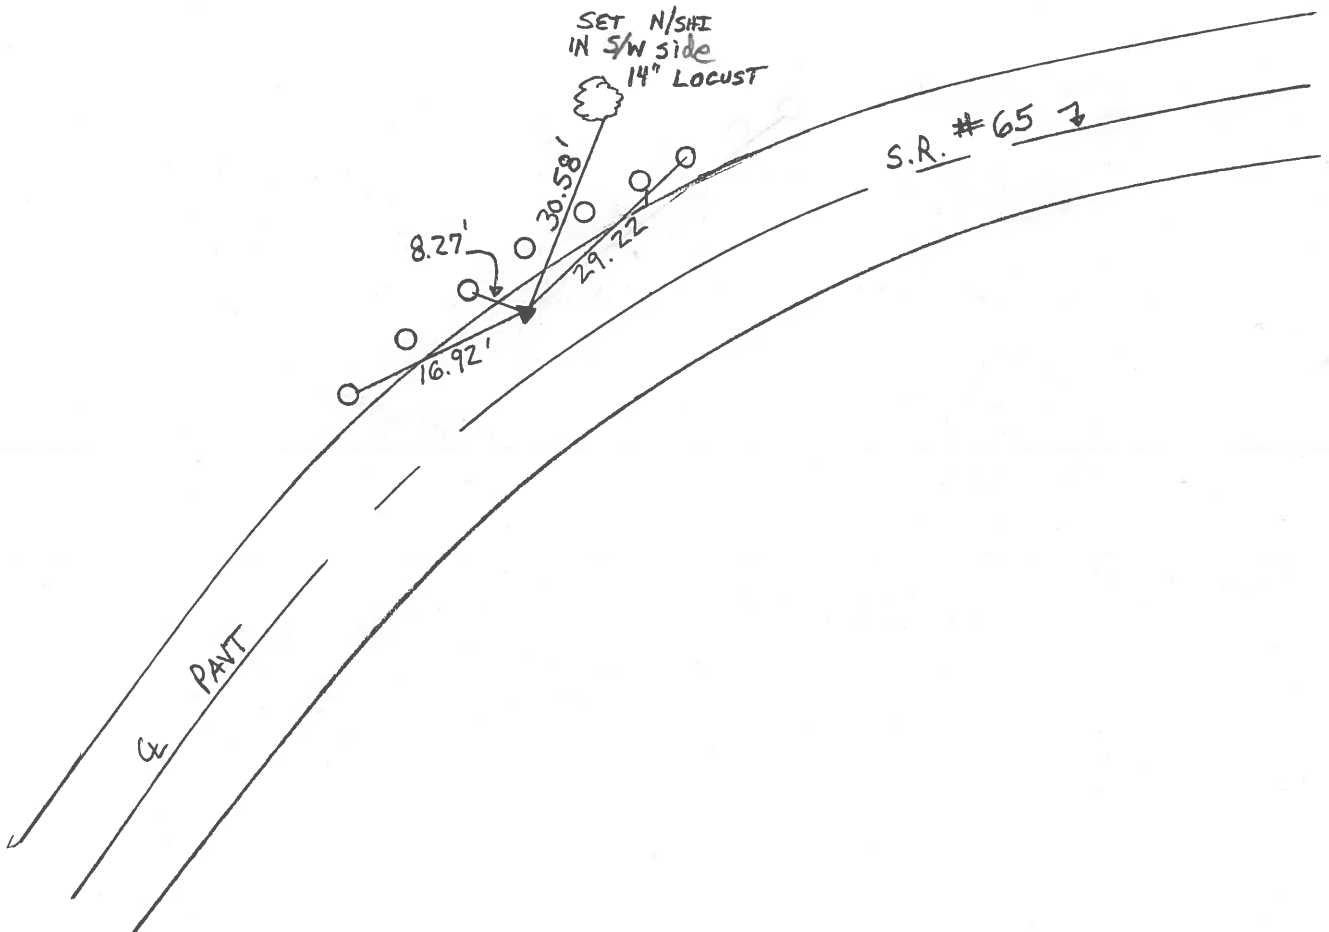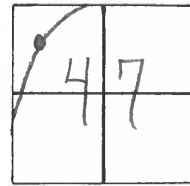

O.D.O.T. DISTRICT 2 SURVEY OFFICE

PERSONNEL

REFERENCE NO. 21

SHEET 36 OF 36

NOTES BARNHISEL

H.C. VAN DUSEN

R.C. KUSZ

BURNETT

DATE 5/25/04
~~7/3/92~~

WEATHER Cloudy

TEMP. +72°

ROUTE 65

COUNTY WOOD

TOWNSHIP MIDDLETON

SECTION R.T. 47

T 6 N R 10 E


TYPE MONUMENT P.K. + WASHER

ON SURFACE - ~~BELOW~~ YES

LEFT- & PAV'T. - RIGHT —

11.6 TO LT EDGE PAVEMENT

S.L.M. 601 + 70

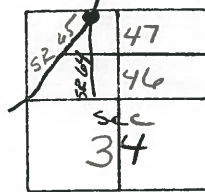

CURVE DATA 1926

P.I. = 504 + 56.97

$\Delta = 23^\circ - 57'$

D = 10° - 0'

R = 573.686


T = 121.50

L = 239.50

Preventive Maintenance
Microsurfaced 2004
Existing Point Uncovered
Date 8/5/04 M.B.

Reset
P.K. + WASHER
9-4-92
MB

RECORD
P.C. = 503 + 35.47
SET P.K. 1972

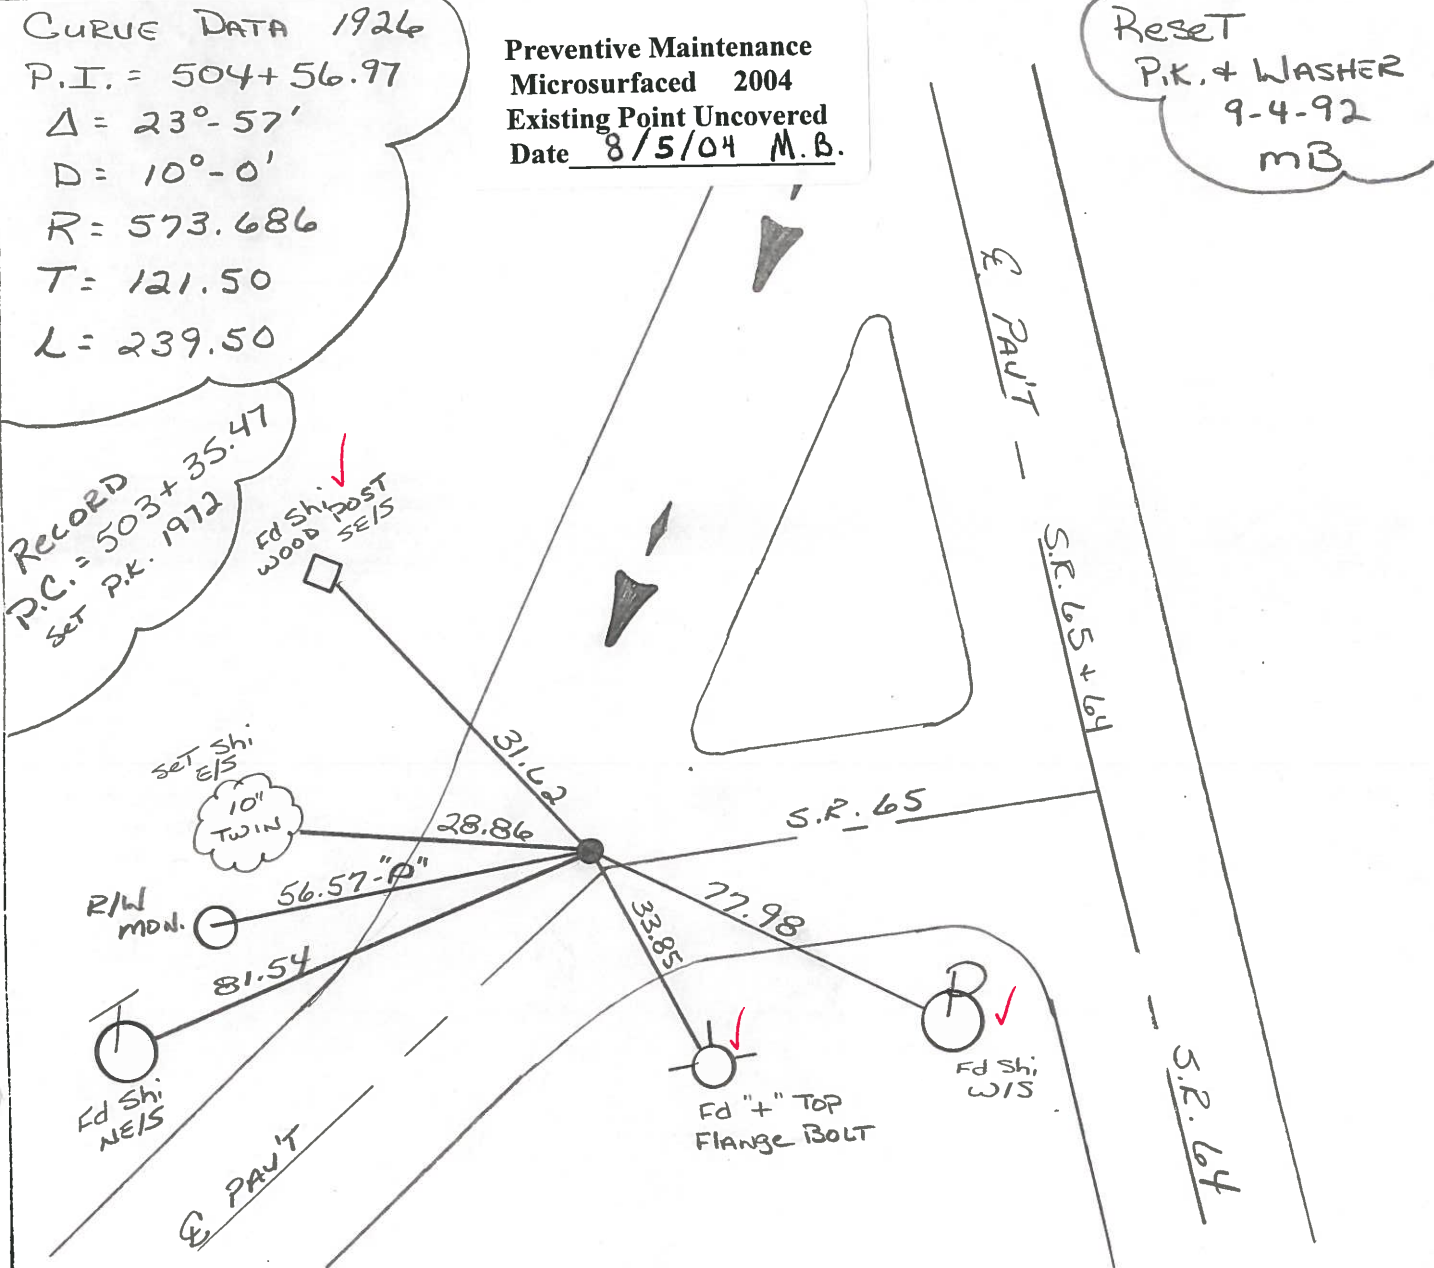

County Wood S.R. 65

Date 4-12-84

Township MIDDLETON

Weather CLEAR

Section R.T.

Temp. 50°


T6N, R10E

Personnel HOFFMAN

HOUSEHOLDER H.C.

BARNHISEL R.C.

#21

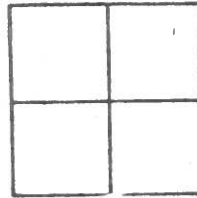


SKM 601+71

Fd P.K. @ surface
11.6' to Lt. EP.

SET PK/WASHER
10-10-84
SWH

Record!
P.C. 503+35.47
Set P.K. 1972

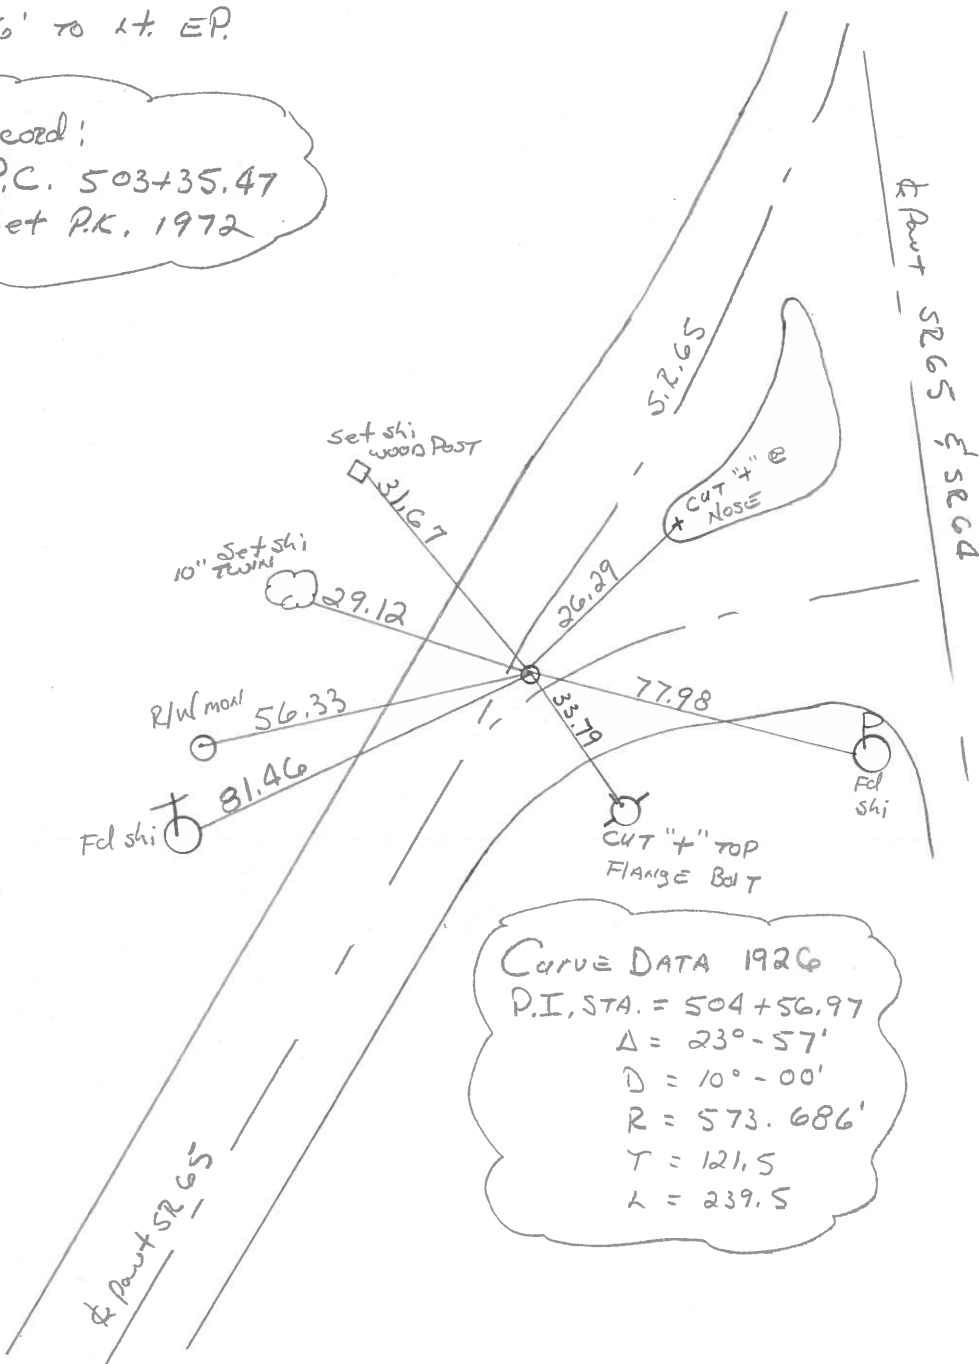

CURVE DATA 1926
P.I. STA. = 504+56.97
 $\Delta = 23^\circ - 57'$
 $D = 10^\circ - 00'$
 $R = 573.686'$
 $T = 121.5$
 $L = 239.5$

SR 65 & Pkwt

SR 64 & Pkwt

CUT "+" TOP
FLANGE Bolt

Fd shi

Set shi wood Post

10" Set shi Point

R/Wl mark

Fd shi

S.R. 65

SR 65 & SR 64

County WOOD S.R. 65

Date 11-17-72

Township MIDDLETON

Weather PT. CLOUDY

Section R.T. 47

Temp. 37°

T6N, R10E

Personnel BURNSIDE

SMITH

BOWERS

KIJOWSKI

RT.	RT.
47	48



#21

CURVE DATA:
 PLAN OF 1926
 P.I. 504+56.97
 A = 23°-57'
 D = 10°-00'
 R = 573.686
 T = 121.5'
 L = 239.5'

P.C. STA. 503+35.47
 SET P.K. NAIL

