

O.D.O.T. DISTRICT 2 SURVEY OFFICE (USE ONLY)

PERSONNEL

REFERENCE NO. 20 G

SHEET 3 OF 7

NOTES BURNSIDE

DATE 7/20/79

ROUTE SR 65

H.C. BOWERS

WEATHER CLEAR

COUNTY WOOD

R.C. KNAPE

TEMP. 78°

TOWNSHIP MIDDLETON

MEAD

DWG BY RHOADES

PID 87671

SECTION RT 48

T 6 N R 10 E

TYPE MONUMENT BOAT SPIKE

ON SURFACE - ~~BELOW~~ ON

OFFSET CL PAVEMENT - LT : RT

3 1/2' TO RT EDGE PAVEMENT



STATION: 608+15.80

HORZ. DATUM: NAD 83 2007

GEOID: _____

GRID: NORTHING: 667882.787

EASTING: 1636882.391

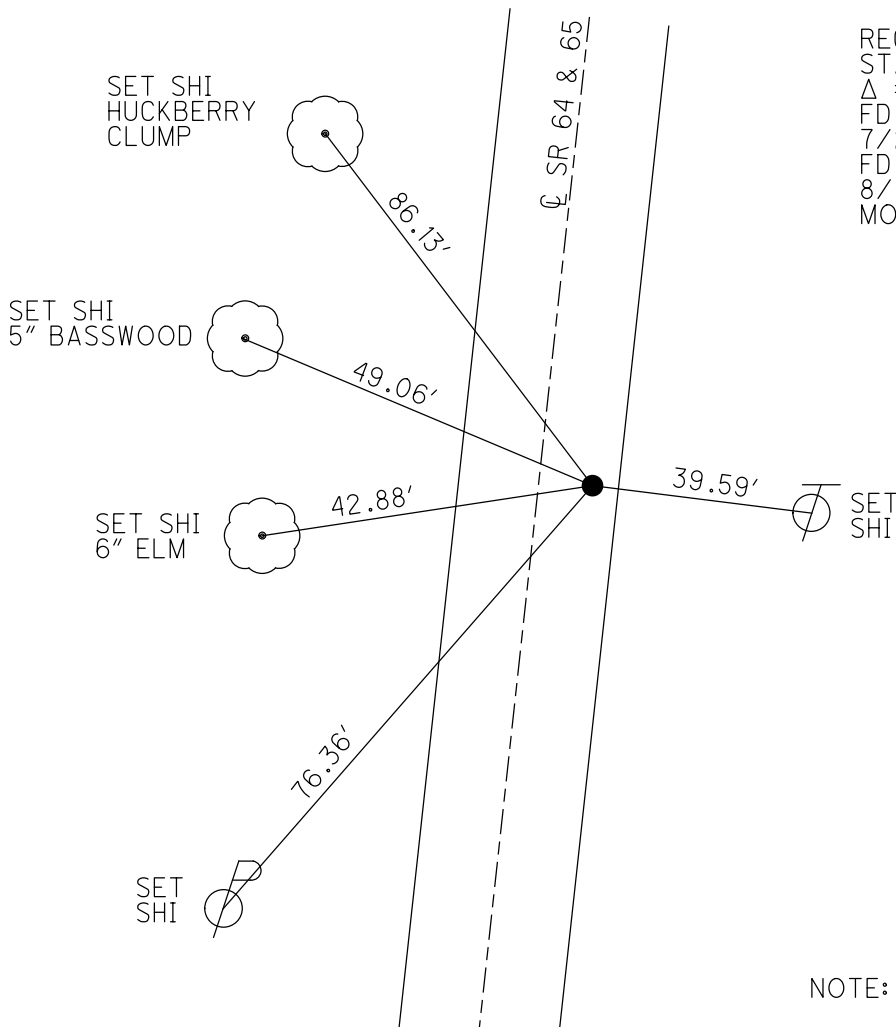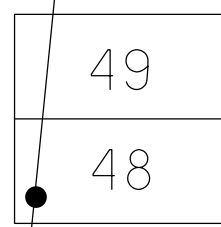

RECORD: P.I.
 STA. 608+15.85
 $\Delta = 13^\circ 33' \text{ LT}$
 FD BOAT SPIKE
 7/20/79, BURNSIDE
 FD NAIL
 8/13/14, RJL
 MONBOX SET

NOTE: SR 64 REF 16A

County Wood S.R. 64 E 65

Date 4-12-84

Township MIDDLETON

Weather Cloudy

Section RIVER TRACT 48


Temp 50°

T6N, R10E

Personnel HOFFMAN

HOUSEHOLDER H.C.

BAKHISEL R.C.

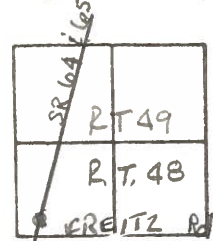

16-A Fd BOAT Spk @ SURFACE

SLM 604+17

8.3' Rt. of & PAWT
3.8' TO RT EP
19.8' TO LT EP

SET PK/WASHER

10-17-84

S.W.H.

Record:

P.I. STA = 608+15.85

$\Delta = 13^{\circ}-33' LT$

