

O.D.O.T. DISTRICT 2 SURVEY OFFICE (USE ONLY)

PERSONNEL _____ REFERENCE NO. 20 H SHEET 4 OF 7
 NOTES BURNSIDE DATE 7/20/79 ROUTE SR 65
 H.C. BOWERS WEATHER CLEAR COUNTY WOOD
 R.C. KNAPE TEMP. 80° TOWNSHIP MIDDLETON
 _____ MEAD SECTION RT 48
 DWG BY RHOADES PID 92088 T 6 N R 10 E

TYPE MONUMENT BOAT SPIKE

ON SURFACE - ~~BELOW~~ ON _____


OFFSET \odot PAVEMENT 4 1/2' LT : ~~RT~~

- TO - EDGE PAVEMENT


STATION: 612+80.46

HORIZ.DATUM: NAD 83 2011 GEOID: 2018

GRID: NORTHING: 668340.737 EASTING: 1636960.726

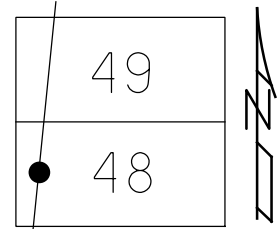

RECORD: P.I.
 STA. 612+80.6
 $\Delta = 0^\circ 55' RT$
 FD BOAT SPIKE
 7/20/79, BURNSIDE
 FD P.K.NAIL
 8/13/14, RJL
 MONBOX SET
 FD MONBOX
 W/1" IPID
 2" ALUM CAP W/MARK
 CL05
 1/24/18, JFO

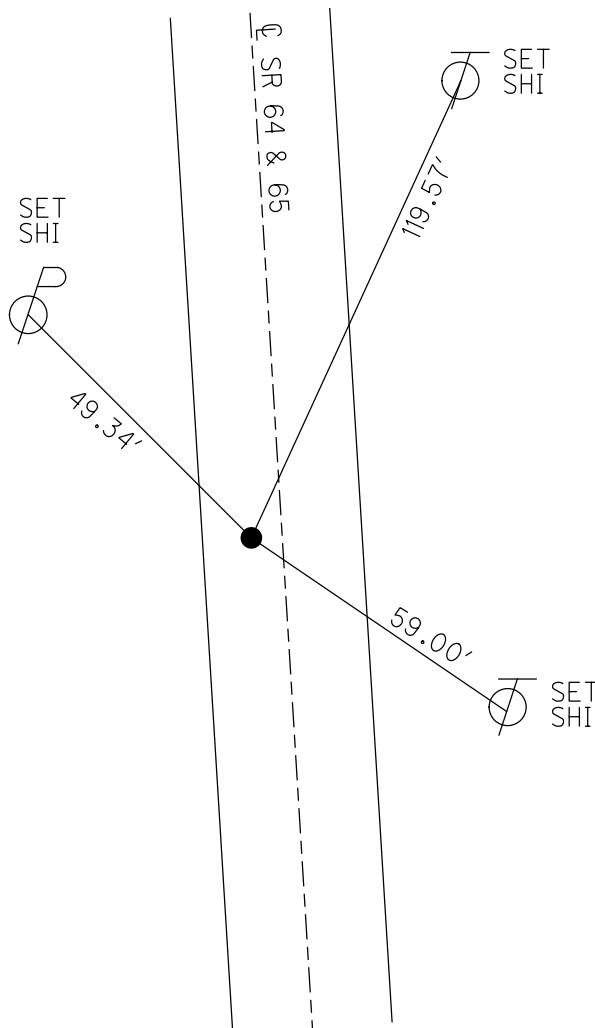

NOTE: SR 64 REF 16B

County Wood S.R. 64 & 65

Date 4-12-84

Township MIDDLETON

Weather Cloudy

Section RIVER TRACT 48


Temp. 50°

T6N, R10E

Personnel HOFFMAN

HOUSEHOLDER H.C.

BARNHISEL R.C.

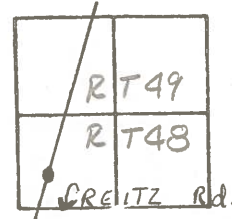

16-B

Fd BOAT SPK @ surface

SLM 608 +81

4.4' Lt. of & Paut

7.2' to Lt. EP

15.9' to RT. EP

Record!
 P.I. STA = 612 + 80.6
 $\Delta = 0^\circ - 55' RT.$

SET Shi



50.17

SET PK/WASHER

11-5-84

SW.H.

119.51



Fd Shi

59.00



Fd Shi

E PAUT SR. 64 & 65

