

O.D.O.T. DISTRICT 2 SURVEY OFFICE (USE ONLY)

PERSONNEL

REFERENCE NO. 22 A

SHEET 3 OF 44

NOTES LEU

DATE 6/12/14

ROUTE SR 65

H.C. HOMAN

WEATHER CLOUDY

COUNTY WOOD

R.C. RHOADES

TEMP. 69°

TOWNSHIP MIDDLETON

WESTFALL

SECTION RT 50

DWG BY RHOADES

PID 92088

T 6 N R 10 E

TYPE MONUMENT P.K./WASHER

ON SURFACE - ~~BELOW~~ ON

OFFSET Q PAVEMENT 0.3' LT : ~~RT~~

9.5' TO LT EDGE PAVEMENT


STATION: 640+30.03

HORIZ.DATUM: NAD83 2011


GEOID: 2018

GRID: NORTHING: 670854.203

EASTING: 1637277.689

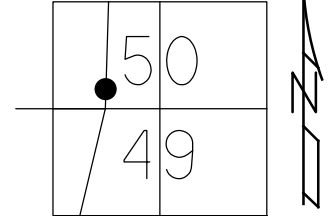

RECORD: P.I.
 $\Delta=0^{\circ}41'$ LT
 SET SM.R.R.SPIKE
 7/13/76, BURNSIDE
 FD SM.R.R.SPIKE
 1984
 SET P.K./WASHER
 8-7-95, SAH
 FD P.K./WASHER
 STA.640+29.67
 6-12-14
 FD R.R.SPIKE
 4" DOWN
 HOLE IN PAVEMENT
 7-28-15, DCH
 FD MAG NAIL
 4" DOWN
 CLO8
 1/24/18, JFO
 FD MONBOX
 W/1" IPIN
 NEWSTA64030
 12/11/20, JFO

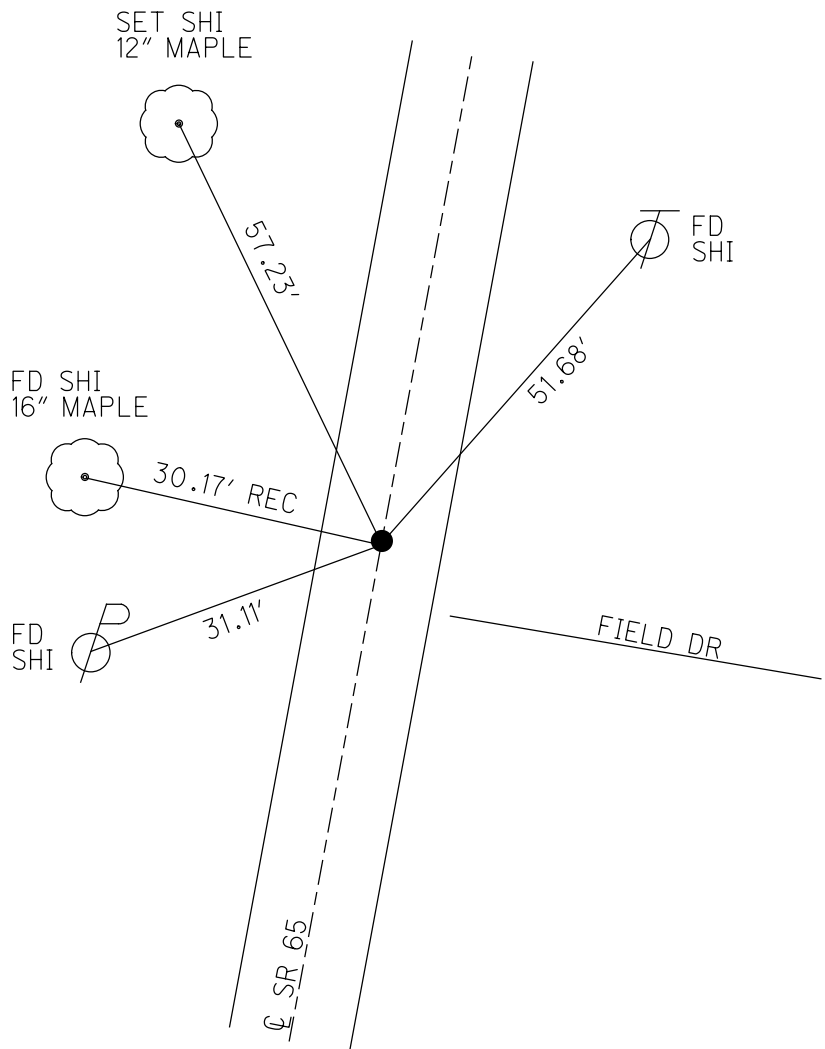


O.D.O.T. DISTRICT 2 SURVEY OFFICE (USE ONLY)

PERSONNEL _____ REFERENCE NO. 22 A SHEET 3 OF 44

NOTES LEU DATE 06-12-14 ROUTE SR 65
 H.C. HOMAN WEATHER CLOUDY COUNTY WOOD
 R.C. RHOADES TEMP. 69°F TOWNSHIP MIDDLETON
 _____ WESTFALL _____ SECTION RT 50
 _____ T 6 N R 10 E

TYPE MONUMENT PK/WASHER
 ON SURFACE - ~~BELOW~~ ON _____
 LEFT - ☉ PAV'T - ~~RIGHT~~ 0.3'
9.5' TO LT EDGE PAVEMENT
 S.L.M. 640+29.67

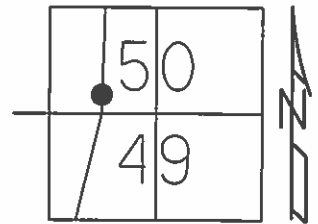


Grid: Northing: 670854.057 Easting: 1637277.571

RECORD
 $\Delta=0^{\circ}41'$ LT.
 FD SMALL RR. SPK
 ON SURFACE
 1984

SET PK/WASHER
 8-7-95, SAH

06-12-14

RR. SPK 4" DOWN
 HOLE IN PAVEMENT
 7-28-15, DCH

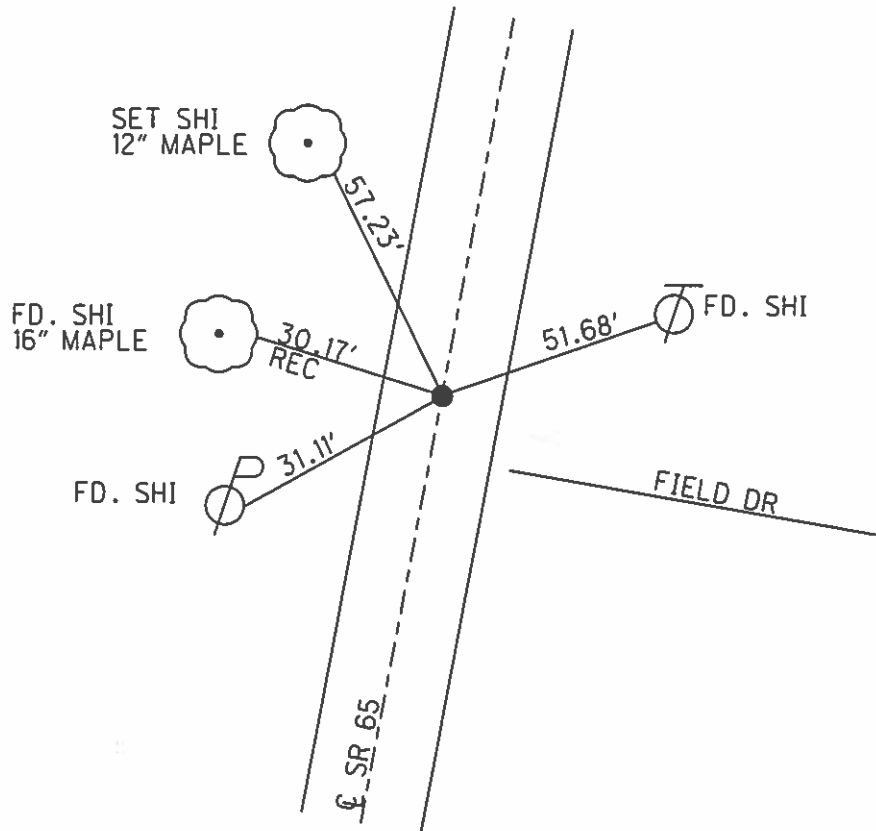

O.D.O.T. DISTRICT 2 SURVEY OFFICE

PERSONNEL _____

REFERENCE NO. _____

SHEET 42 OF 91

NOTES VAU DUSEN

H.C. MOSEK

R.C. HUSS

DATE 5-24-95

WEATHER CLOUDY

TEMP. +60° F

ROUTE SR-65

COUNTY Wood

TOWNSHIP Middleton

SECTION River Tract #50

T 6 N R 10 E

22-A


TYPE MONUMENT P.K. WASHER

ON SURFACE - ~~BELOW~~ Yes

LEFT - ~~C~~ PAV'T. - RIGHT 0.3'


9.5 TO LT EDGE PAVEMENT

S.L.M. 638+29

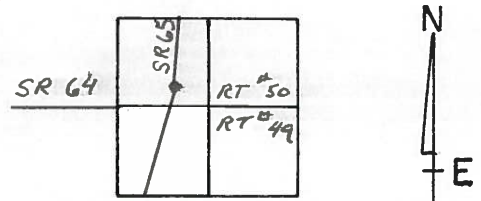

Record: $\Delta = 0^\circ - 41'$ Lt.
 FO. SMALL RR. SPK @ SURFACE
 "1984"

SET PK/WASHER
 8-7-95
 S.A.H.

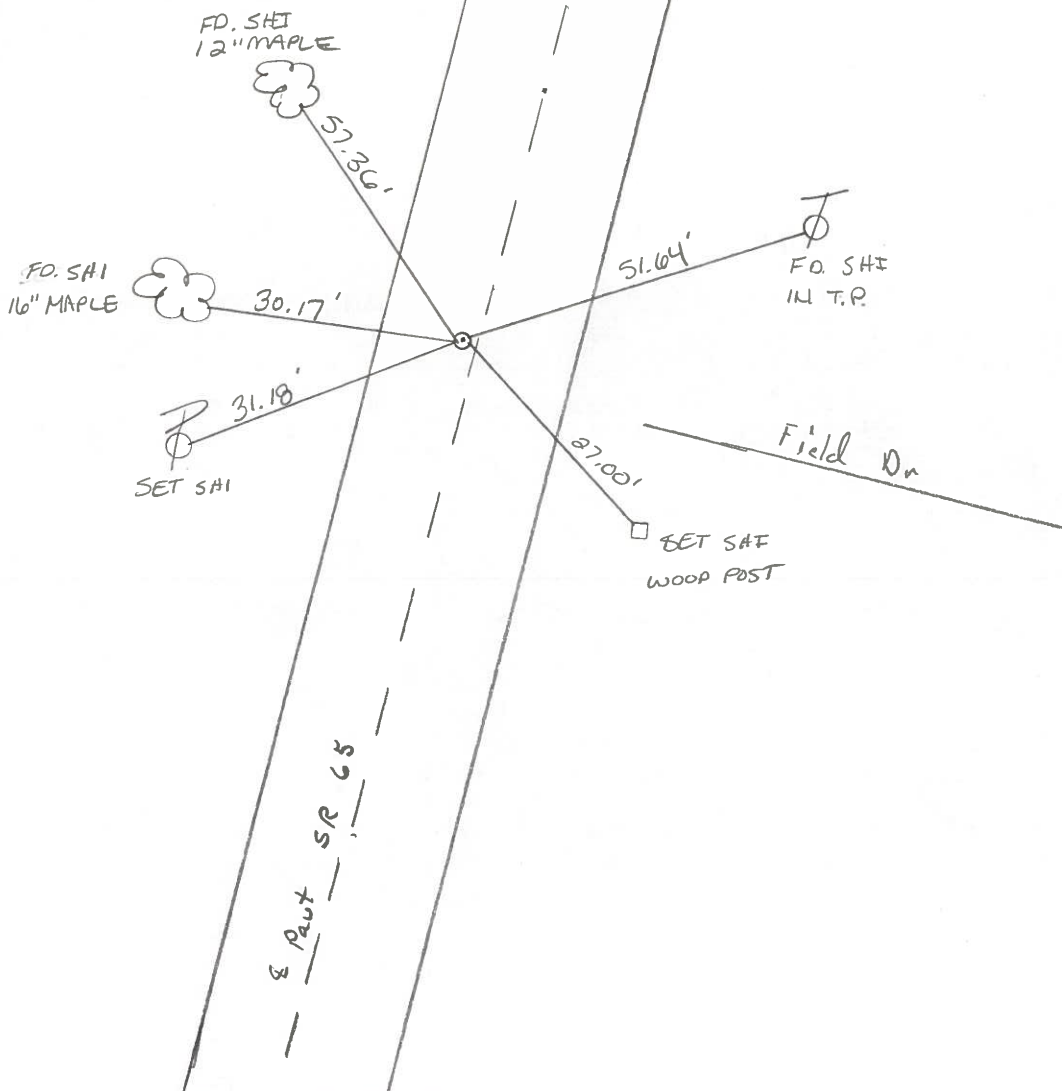

County Wood S.R. 65

Date 4-13-84

Township MIDDLETON

Weather Clear

Section RIVER TRACT #50

Temp. 45°


T6N, R10E

Personnel HOFFMAN

LOEHKE

HOUSEHOLDER H.C.

BARNAISEL R.C.

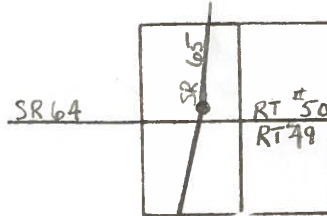

22-A

Fd small R.R. spike @ surface
 0.3' Lt. of & part
 9.0' TO Lt. EP
 9.6' TO RT. EP


SLM = 638 +29

SET PK./WASHER

10-17-84

S.W.H.

Record:
 $\Delta = 0^\circ - 41' \text{ LT.}$

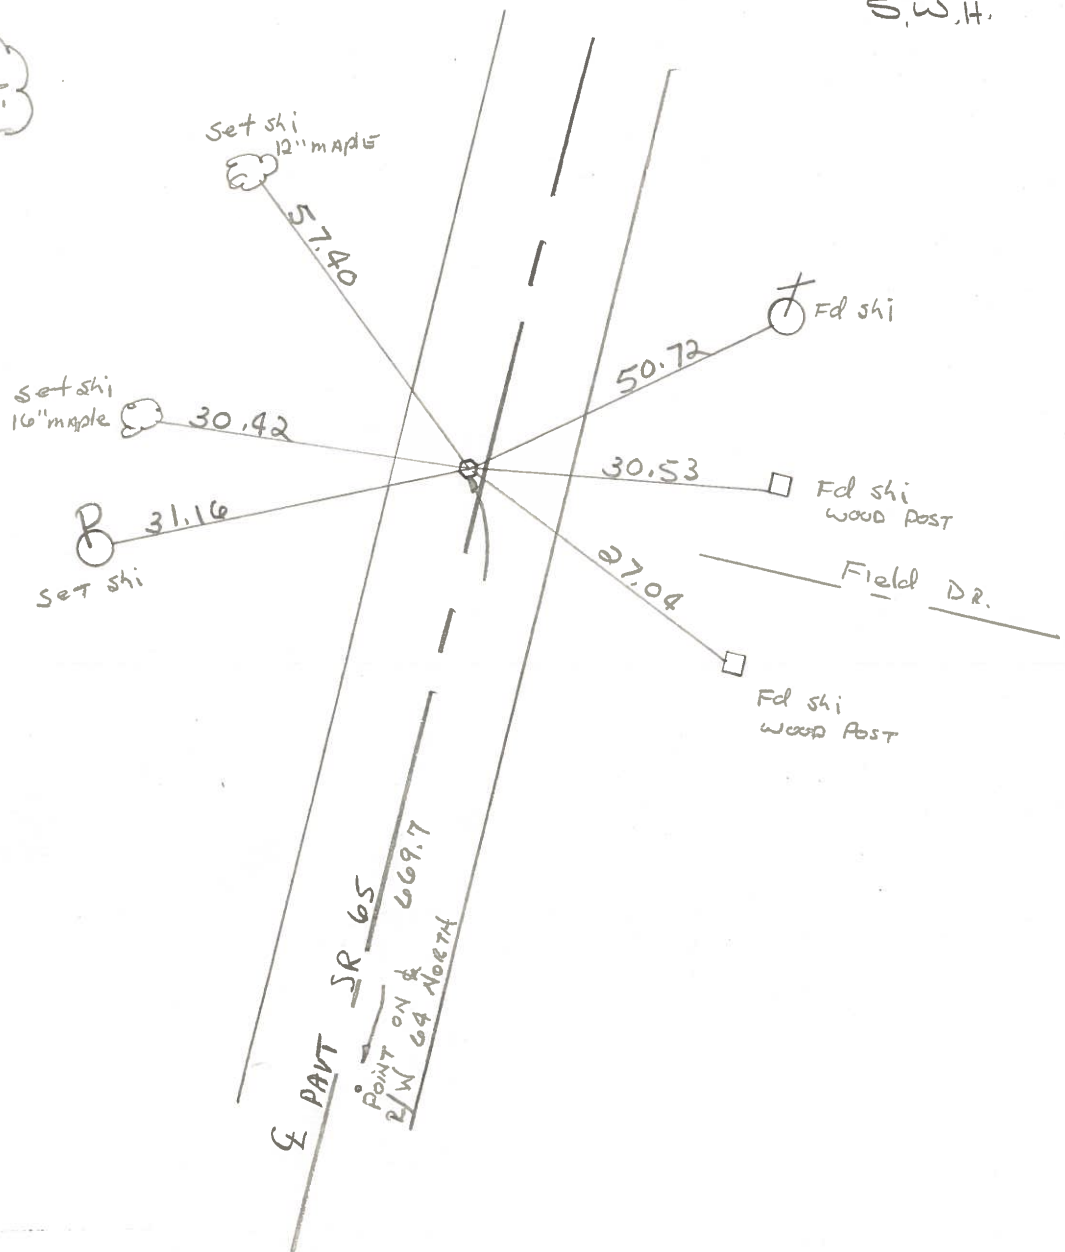

PERSONNEL	TITLE	PERSONNEL	TITLE	COUNTY	WOOD	DATE	7-13-76
BURNSIDE				S. R.	65	WEATHER	CLEAR
SMITH				SEC.	MIDDLETON TWP	TEMP.	+80°
MEAD							

DESCRIPTION ESTABLISH & CONTROL POINTS
 LEFT CENTER LINE RIGHT JOB NO.

