


O.D.O.T. DISTRICT 2 SURVEY OFFICE (USE ONLY)

PERSONNEL _____ REFERENCE NO. 22 D SHEET 6 OF 44
 NOTES LEU DATE 6-12-14 ROUTE SR 65
 H.C. HOMAN WEATHER CLOUDY COUNTY WOOD
 R.C. WESTFALL TEMP. 70°F TOWNSHIP MIDDLETON
 SECTION RT 51
 T 6 N R 10 E

TYPE MONUMENT MAG WASHER
 ON SURFACE - ~~BELOW~~ ON
 LEFT - ☉ PAV'T - ~~RIGHT~~ 1.0'
10.0' TO LT EDGE PAVEMENT
 S.L.M. 655+02.86

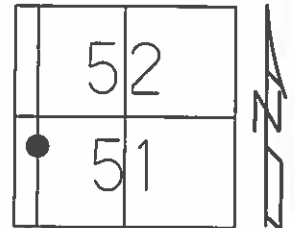


Grid: Northing: 672324.718 Easting: 1637363.620

FD PK @ SURFACE
 5/24/95

NOTE: DIST. 22D-22E = 116.07'

SET PK/WASHER
 8-7-95, SAH

FD P.K./WASHER
 6-12-14
 SET MAG/WASHER
 7-28-15, DCH

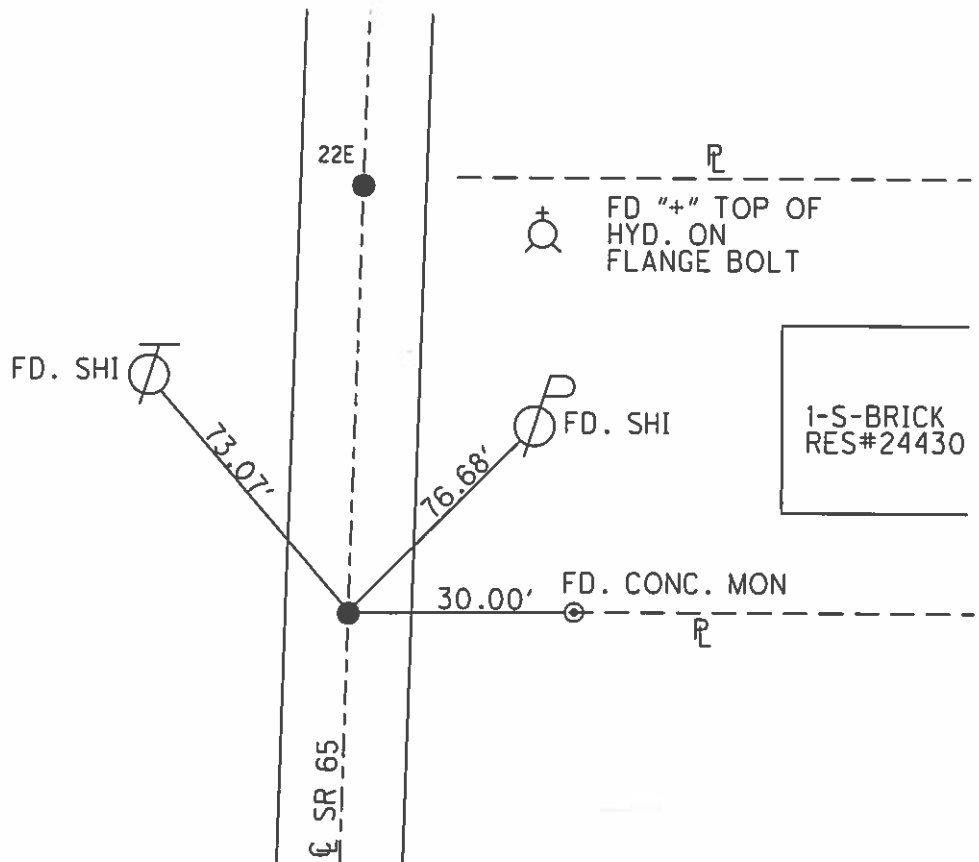

O.D.O.T. DISTRICT 2 SURVEY OFFICE

PERSONNEL _____

REFERENCE NO. _____

SHEET 44 OF 91

NOTES VAW DUSEN

H.C. MOSER

DATE 5-24-95

ROUTE SR 65

R.C. HUSS

WEATHER Cloudy

COUNTY Wood

TEMP. +60 °F

TOWNSHIP Middletown

SECTION _____

T 6 N R 10 E

TYPE MONUMENT P.K. WASHER

22-D

ON SURFACE - ~~BELOW~~ YES

22-E

LEFT - ~~C~~ PAV'T. - RIGHT ("A" = 1.0' Lt) ("B" = 1.0' Lt)


A = 9.9
B = 16.0 TO LT EDGE PAVEMENT

S.L.M. 654+19

SR 65	RT 52
SR 65	RT 51



SET P.K. WASHER BOTH PTS.
B-7-95
S.A.H.

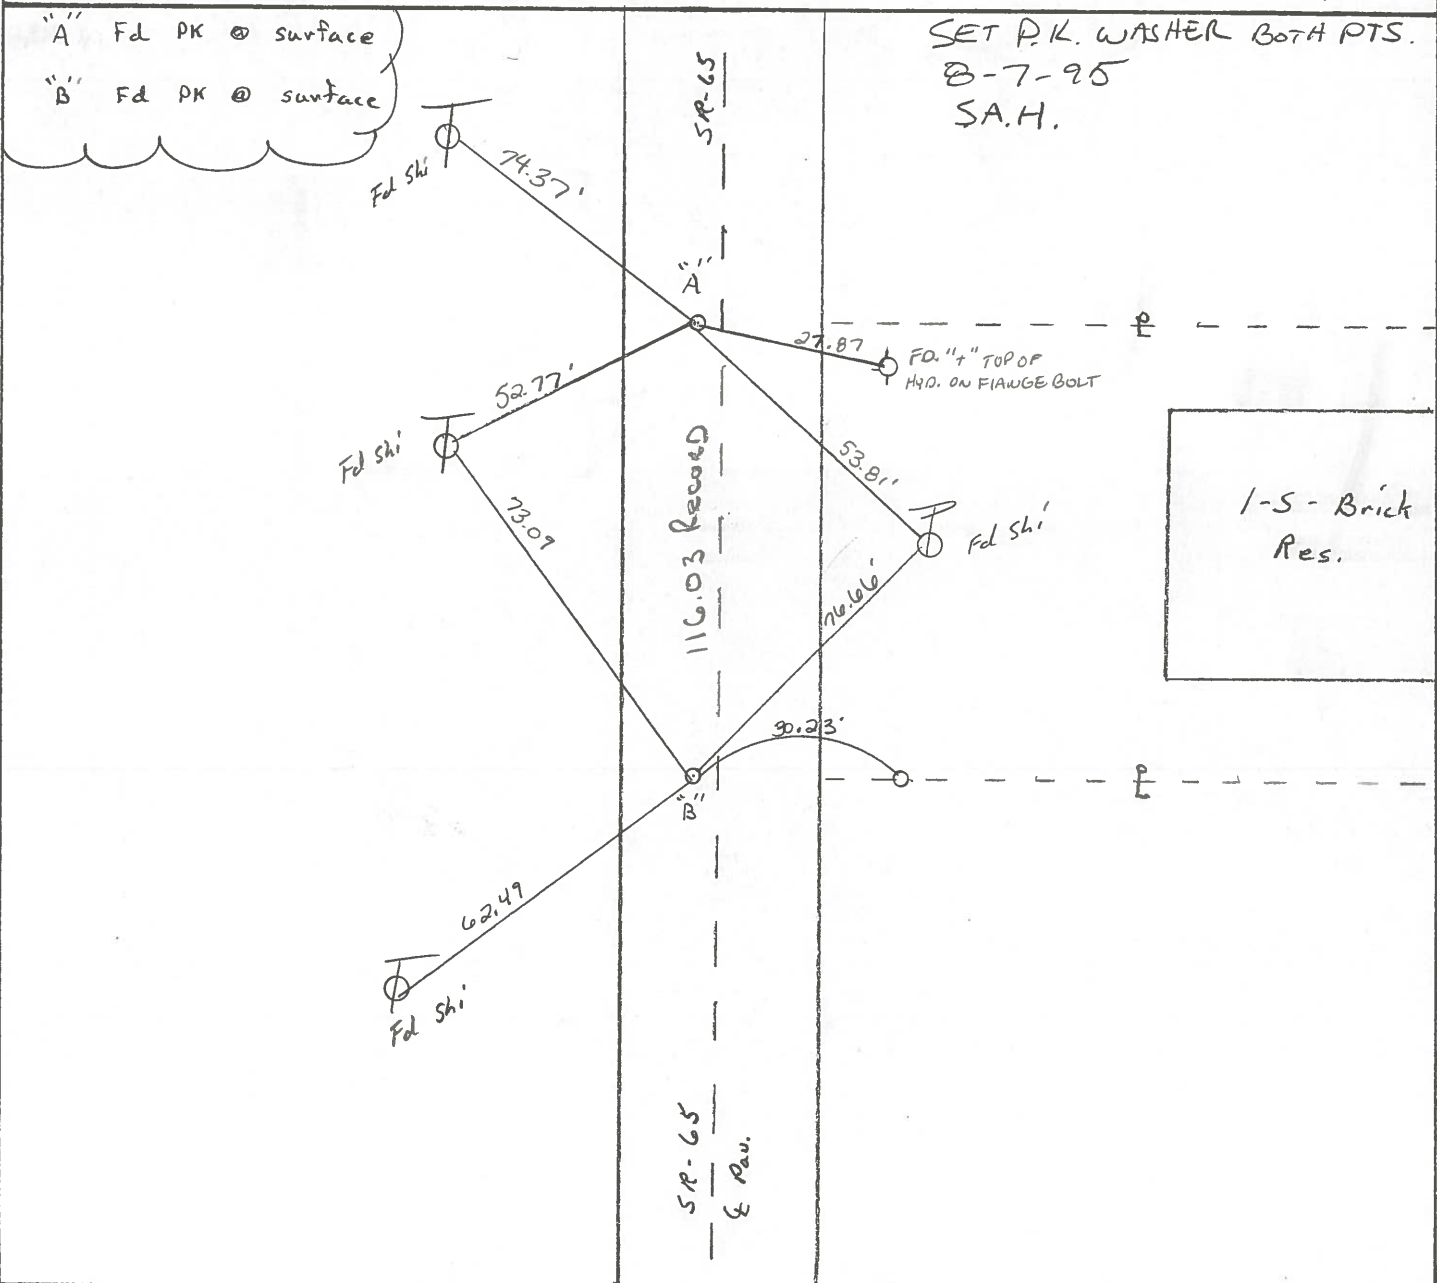

County Wood S.R. 65

Date 4-13-84

Township MIDDLETON

Weather Clear

Section R.T. - 51

Temp. 50°

T6N, R0E

Personnel HOFFMAN

R.T.	52
R.T.	51



22-D
22-E

LOEHRKE
HOUSEHOLDER H.C.
BARANHISEL P.C.


S.L.M. 654+19

"A" = Fd P.K. @ surface
SET PK 1.0' Lt. of & Pavt
10-17-84 9.1' to Lt. EP
SWH 10.2' to RT. EP

"B" = Fd P.K. @ surface
SET PK 1.0' Lt. of & Pavt
10-17-84 9.1' to Lt. EP
SWH 10.1' to RT. EP

"C" Fd P.K. @ surface.
0.25 FROM "B".
ORIGINAL UNKNOWN

DID NOT RESET THIS POINT

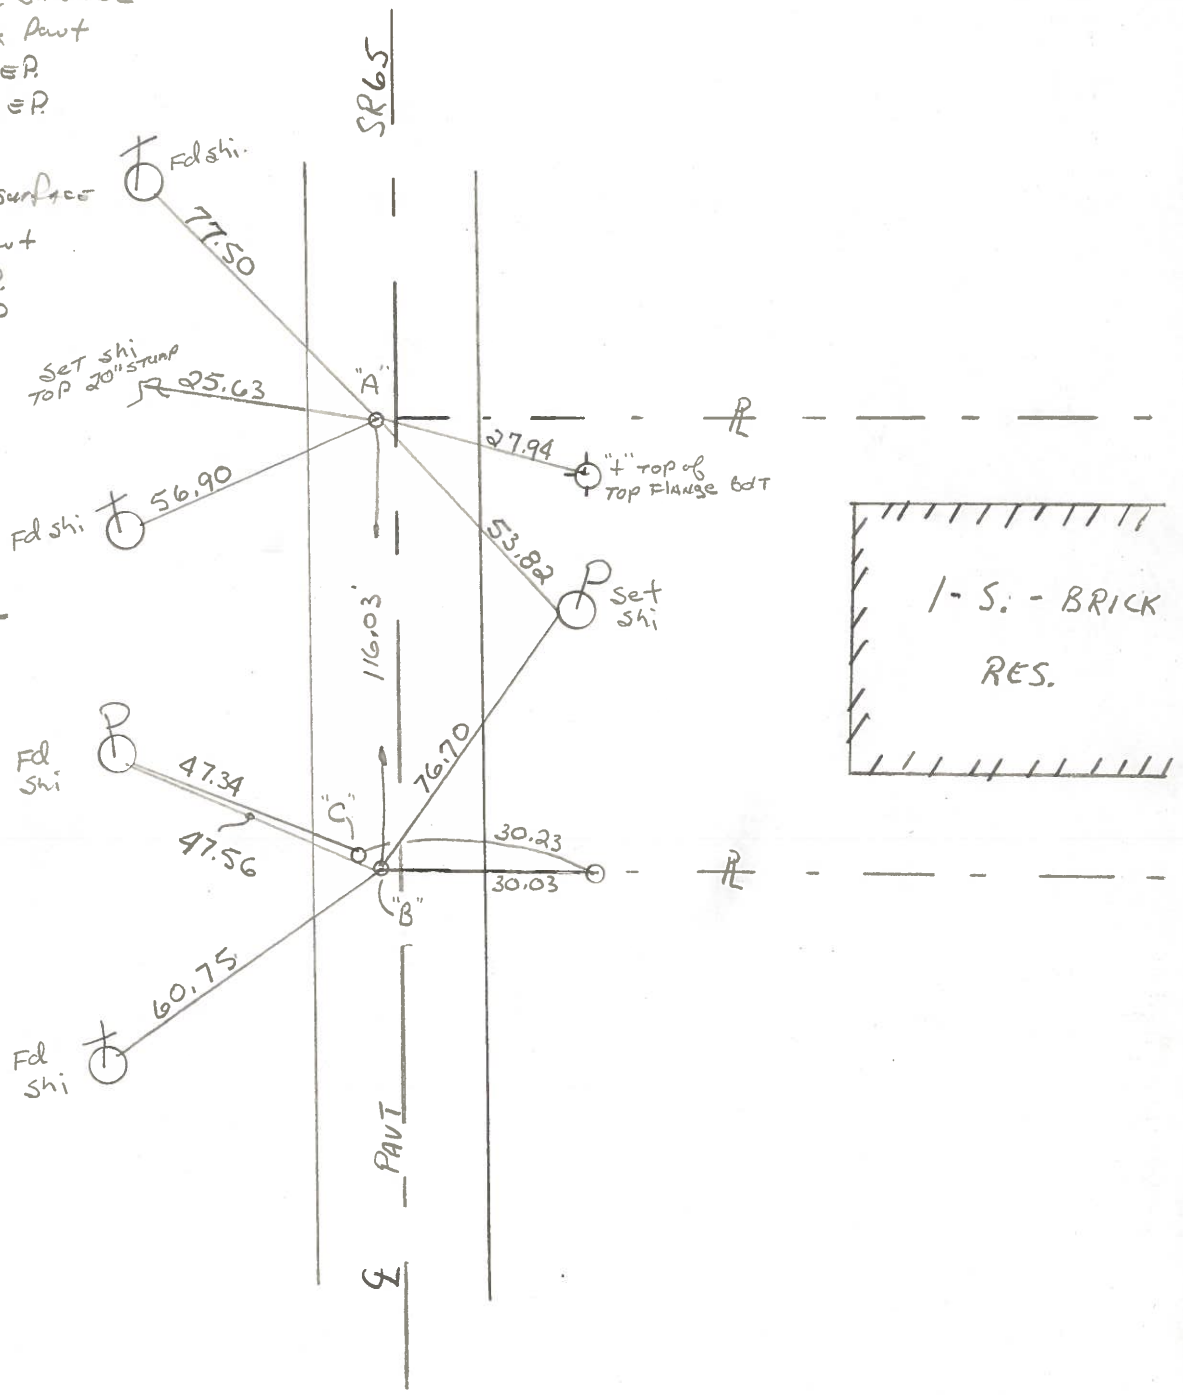

County WOOD S.R. 65

Date 7-10-80

Township MIDDLETON

Weather FAIR



Section R.T. - 51-52

Temp. 85°

T N, R E

Personnel SMITH
BOWERS

22-D
22-E

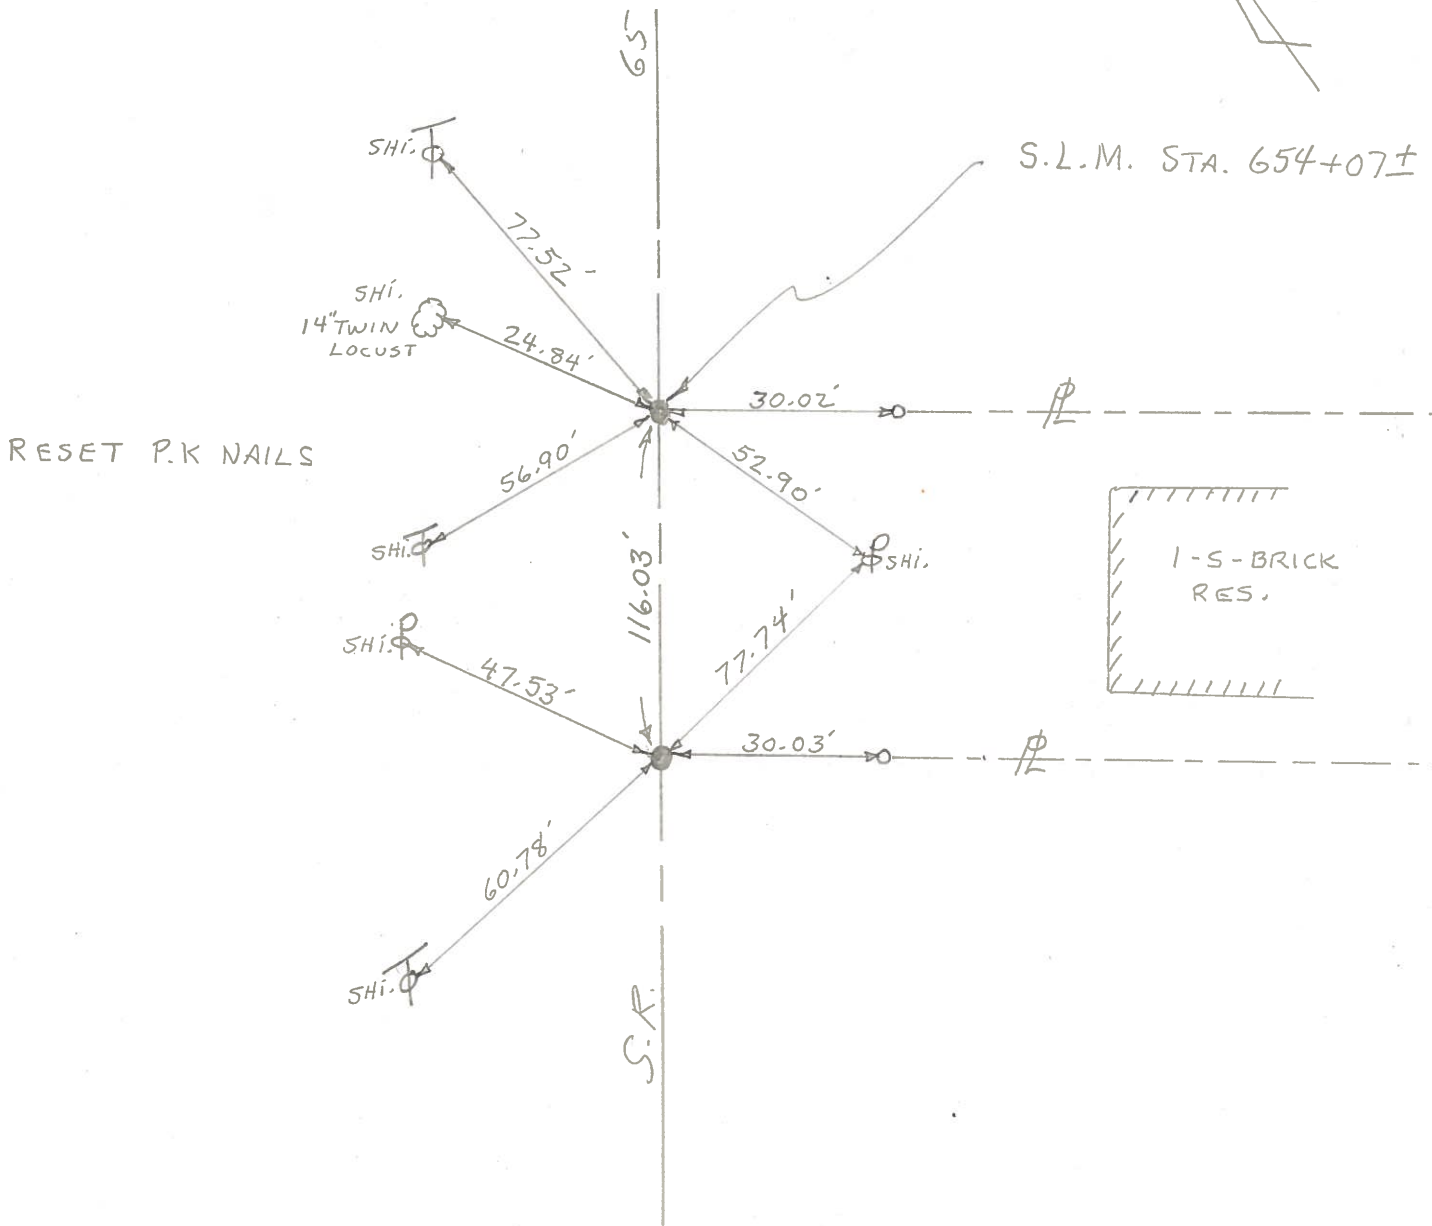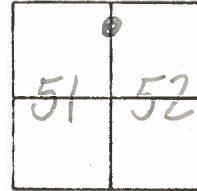

PERSONNEL TITLE PERSONNEL TITLE
 BURNSIDE _____
 SMITH _____
 BOWERS _____
 SRADEJA E.I.T.

COUNTY Wood DATE 4-27-71
 S. R. #65 WEATHER Cloudy
 MIDDLETON TWP
 SEC. 11.96 To 15.53 TEMP. +52°

DESCRIPTION POINTS FOUND BEFORE RESURFACING JOB NO.

