


O.D.O.T. DISTRICT 2 SURVEY OFFICE (USE ONLY)


PERSONNEL _____ REFERENCE NO. 23 D SHEET 13 OF 44
 NOTES VAN DUSEN DATE 5/24/95 ROUTE SR 65
 H.C. MOSER WEATHER CLOUDY COUNTY WOOD
 R.C. HUSS TEMP. 60° TOWNSHIP MIDDLETON
 _____ SECTION RT 53
 _____ T 6 N R 10 E

TYPE MONUMENT P.K.NAIL
 ON SURFACE - ~~BELOW~~ ON _____
 LEFT - ☉ PAV'T - ~~RIGHT~~ 1.0'
7.4' TO LT EDGE PAVEMENT
 S.L.M. 683+65.81

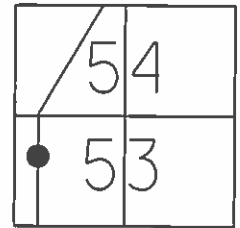

Grid: Northing: 675183.474 Easting: 1637518.312

GPS D23

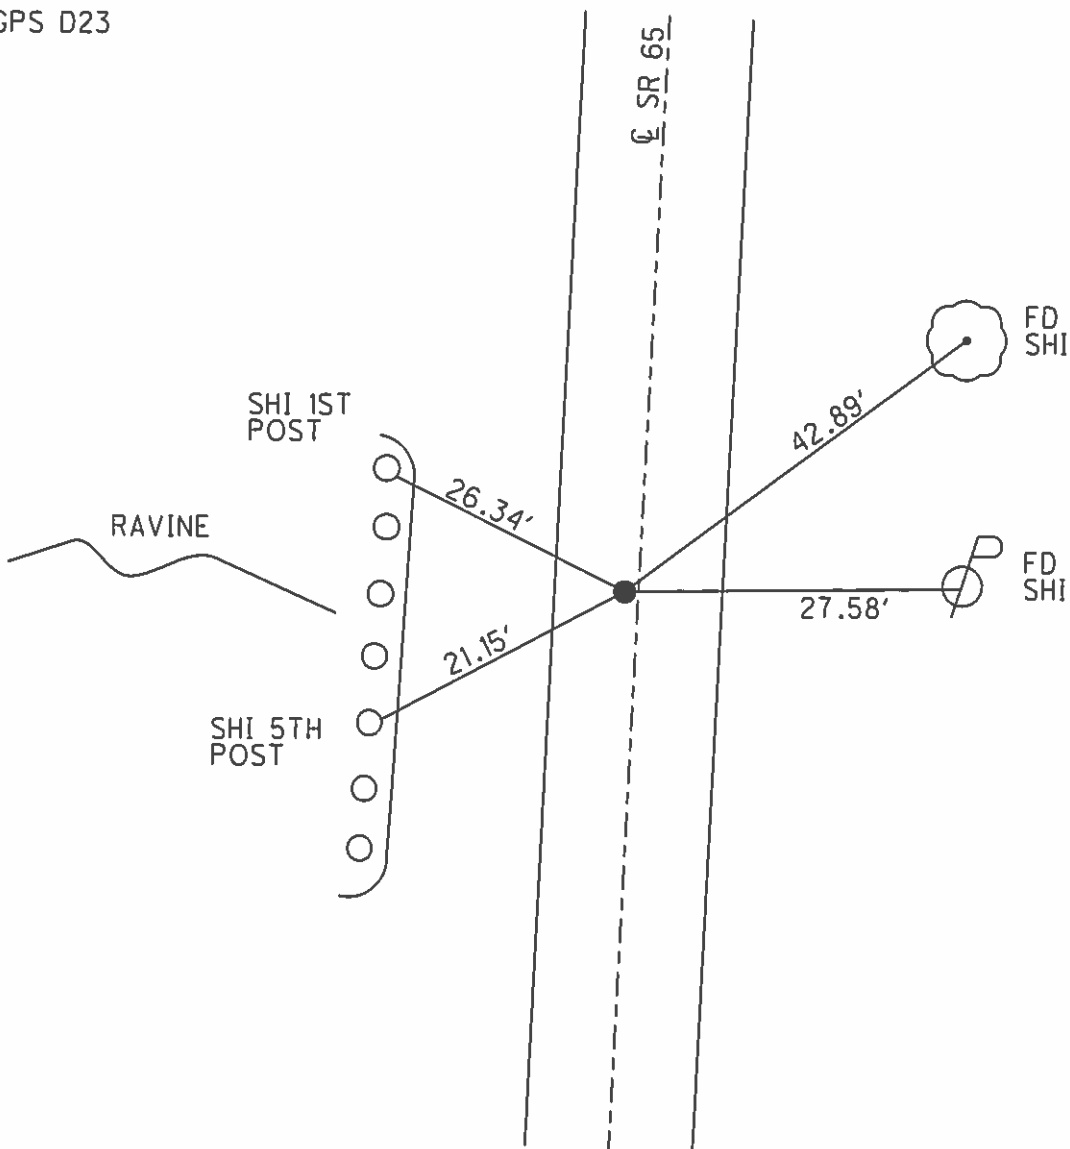

O.D.O.T. DISTRICT 2 SURVEY OFFICE

PERSONNEL _____

REFERENCE NO. _____

SHEET 46 OF 91

NOTES VAN CUSEN

H.C. MOSEK

R.C. HUSS

DATE 5-24-95

WEATHER CLOUDY

TEMP. +60°F

ROUTE SR65

COUNTY WOOD

TOWNSHIP MIDDLETON

SECTION R.T. 53 & 54

T6 N R 10 E

TYPE MONUMENT P.K. / WASHER

ON SURFACE - BELOW

LEFT- C PAV'T. - RIGHT A+B+C 1.0' LT

A = 8.9
B = 7.4
C = 7.3


TO LT EDGE PAVEMENT

S.L.M. A=678+78 B=681+65 C=683+30

23-C

23-D

23-E

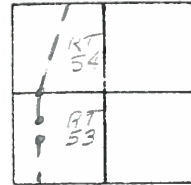


SET PK & WASHER @ ALL 3 POINTS
8-7-95
SAH

REC. SLM 683+30
Fd. PK @ SURFACE
0.5' LT. & P.V.M.T.

REC. SLM 681+65
Fd. PK @ SURFACE
0.5' LT. & P.V.M.T.

REC. SLM 678+78
Fd. SMALL RR SPIK @ SURFACE
0.8' LT. & P.V.M.T.

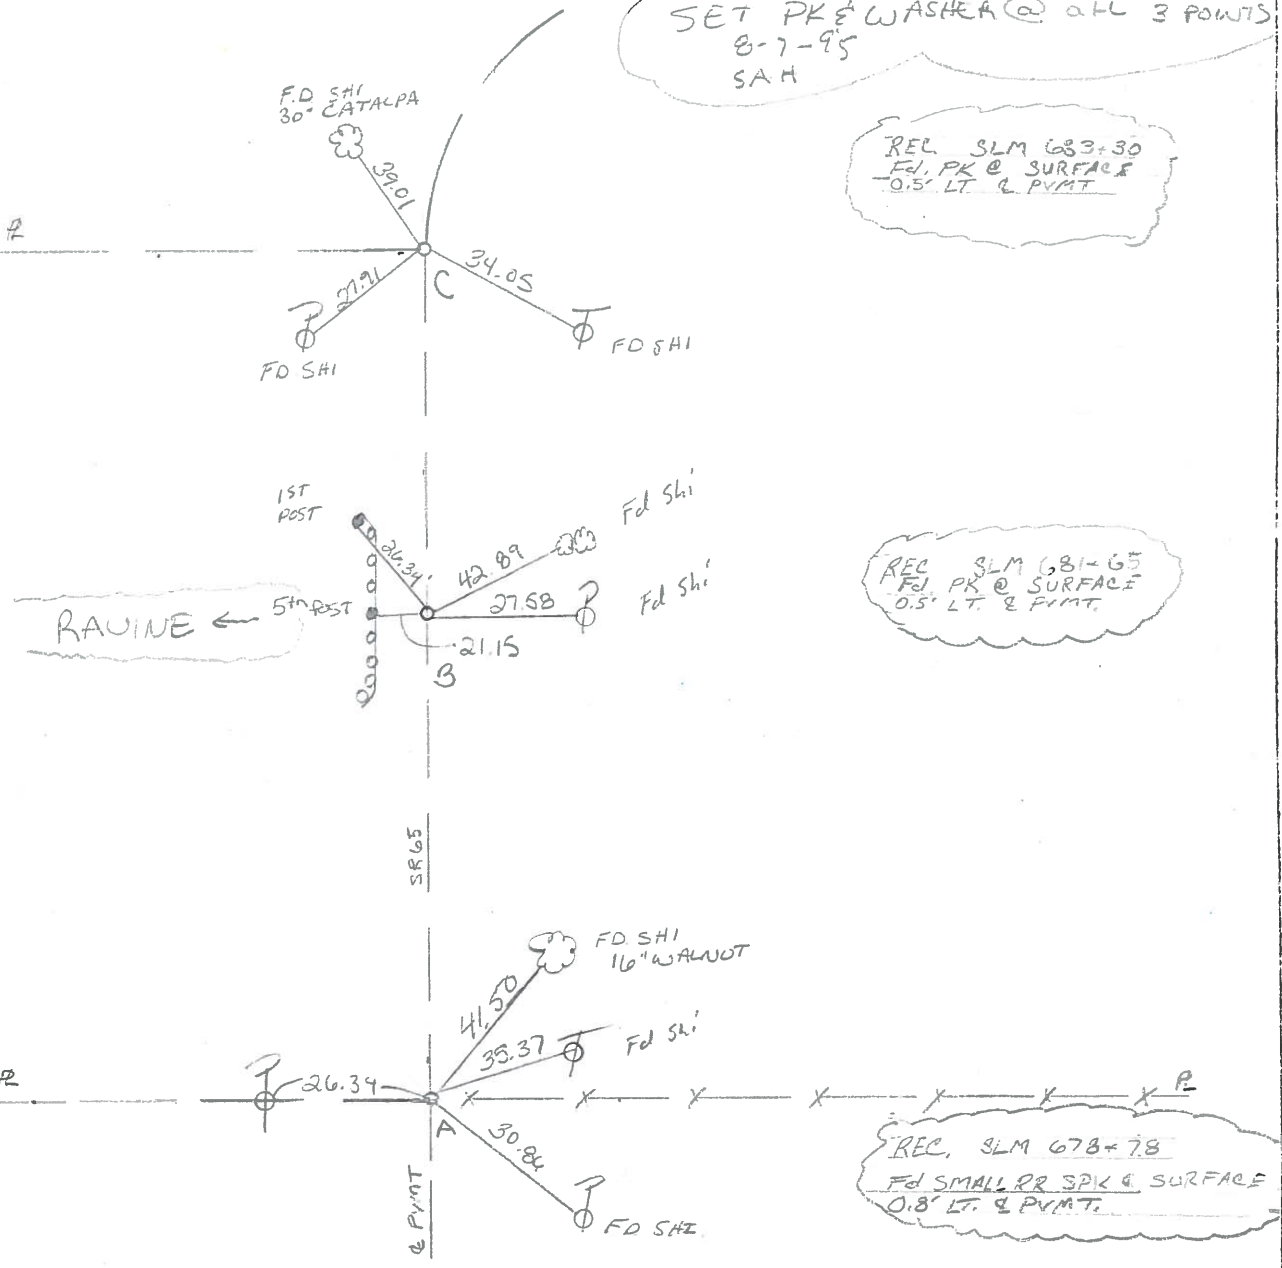

County WOOD S.R. 65

Township MIDDLETON

Section R.T. 53 & 54


T6N, R10E

Personnel HOFFMAN

Date 4-13-84

Weather P. Clear

Temp. 50°

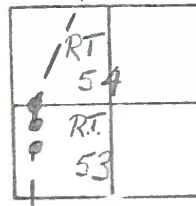

- 23-C**
- 23-D**
- 23-E**

LOEBLIE
HOUSEHOLDER H.C.
BARNHISEL R.C.

SET PK/WASHER



CALL 3 POINTS

10-17-84

S.W.H.

SLM 683+30
 Fd P.K. @ SURFACE
 0.5' Lt. of & PAWT
 9.3' TO Lt. EP
 10.2' TO RT. EP


R

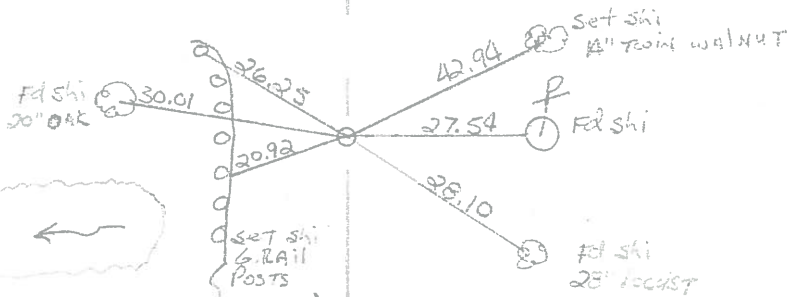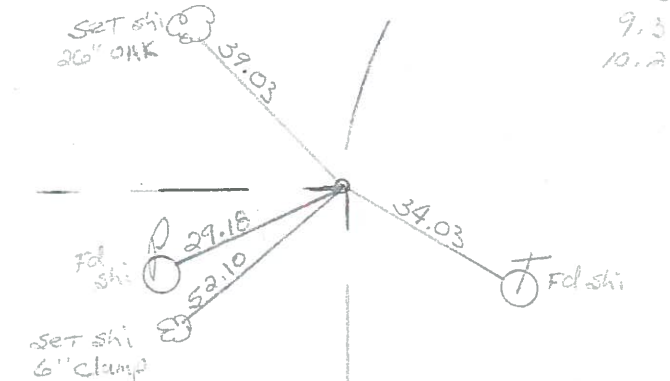

SLM 681+65
 Fd P.K. @ SURFACE
 0.5' Lt. of & PAWT
 9.1' TO Lt EP
 10.8' TO RT. EP



SR. 65

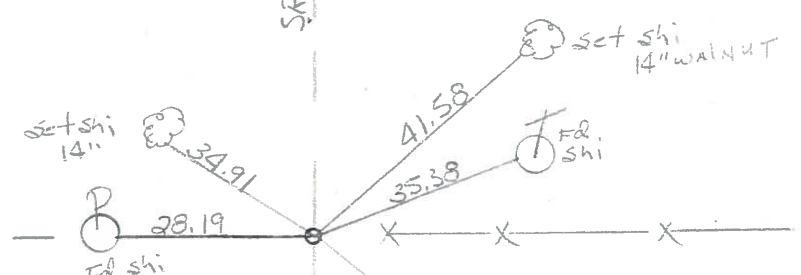

SLM 678+78
 Fd small R.R. SPK @ SURFACE
 0.8' Lt. of & PAWT
 6.7' TO Lt. EP
 9.9' TO RT. EP

PAWT

R

R

County WOOD S.R. 65

Date 7-10-80

Township MIDDLETON

Weather FAIR



Section R.T. 53-54

Temp. 85°

T N, R E

Personnel SMITH
BOWERS

23-C
23-D
23-E

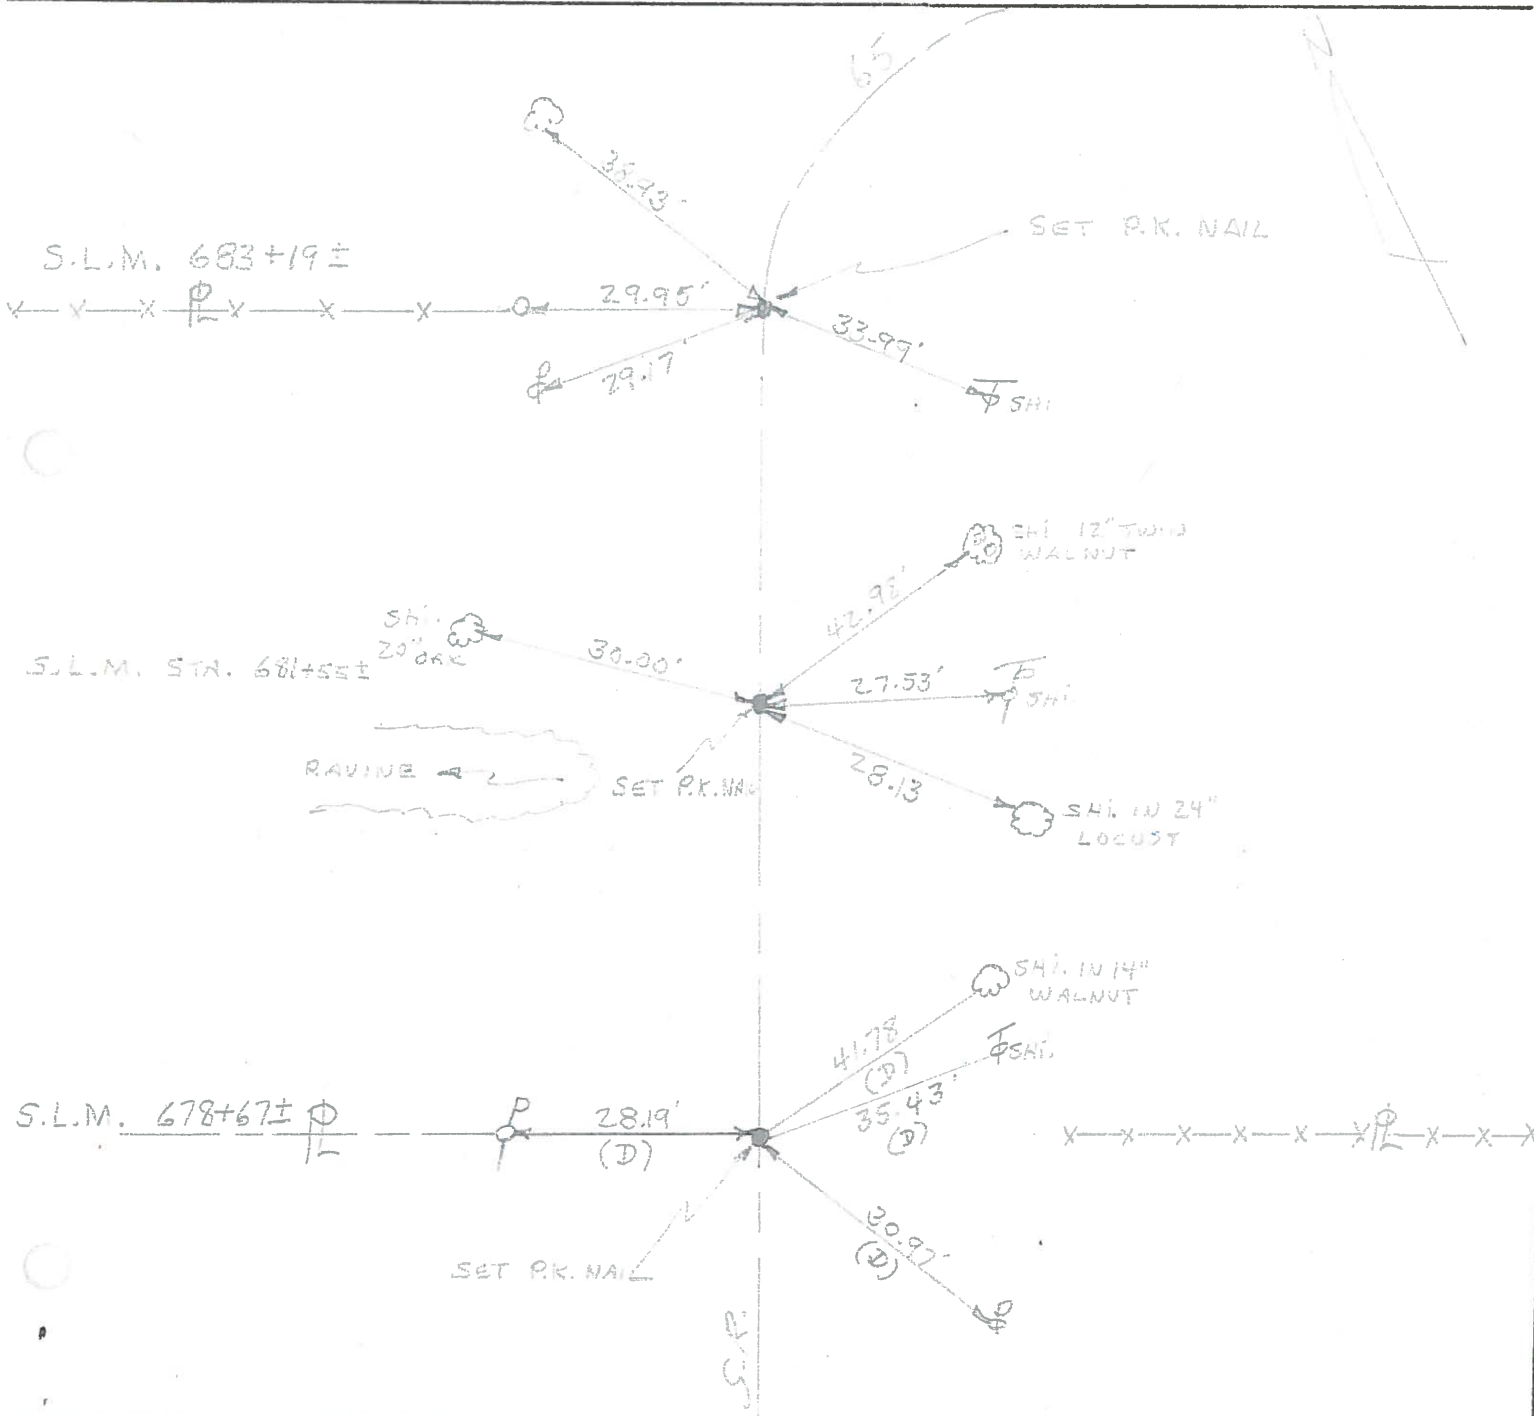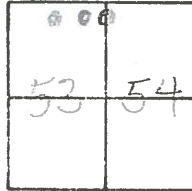

PERSONNEL TITLE PERSONNEL TITLE
BURNSIDE _____
SMITH _____
BOWERS _____

COUNTY Wood DATE 4-18-72
 S. R. 65 WEATHER CLEAR
 SEC MIDDLETON TWP TEMP. +77°

DESCRIPTION _____ LEFT _____ CENTER LINE _____ RIGHT _____ JOB NO. _____

