


O.D.O.T. DISTRICT 2 SURVEY OFFICE (USE ONLY)


PERSONNEL \_\_\_\_\_ REFERENCE NO. 23 E SHEET 14 OF 44  
 NOTES VAN DUSEN DATE 5/24/95 ROUTE SR 65  
 H.C. MOSER WEATHER CLOUDY COUNTY WOOD  
 R.C. HUSS TEMP. 60° TOWNSHIP MIDDLETON  
 SECTION RT 53, 54  
 T 6 N R 10 E

TYPE MONUMENT P.K.NAIL  
 ON SURFACE - ~~BELOW~~ ON  
 LEFT - ☉ PAV'T - ~~RIGHT~~ 1.0'  
9.3' TO LT EDGE PAVEMENT  
 S.L.M. 685+29.33

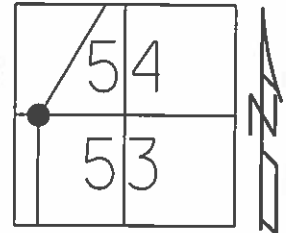

Grid: Northing: 675346.719 Easting: 1637527.682

GPS E23

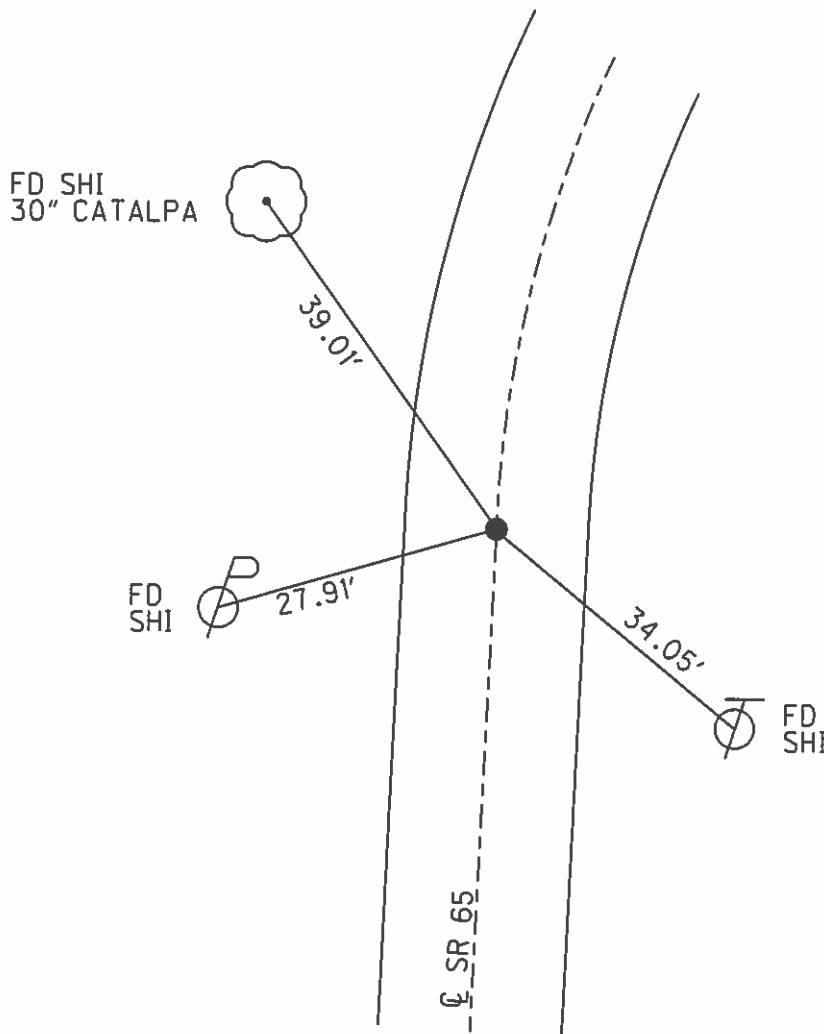

# O.D.O.T. DISTRICT 2 SURVEY OFFICE

PERSONNEL \_\_\_\_\_

REFERENCE NO. \_\_\_\_\_

SHEET 46 OF 91

NOTES VAW OUSEN

H.C. MOSEY

R.C. HUSS

DATE 5-24-95

WEATHER CLOUDY

TEMP. +60°F

ROUTE SR 65

COUNTY WOOD

TOWNSHIP MIDDLETON

SECTION R.T. 53 & 54

T 6 N R 10 E

TYPE MONUMENT P.K. / WASHER

ON SURFACE - BELOW

LEFT - C PAV'T. - RIGHT A+B+C 1.0' LT

A - 0.9  
B - 7.4  
C - 7.3


TO LT EDGE PAVEMENT

S.L.M. A=678+78 B=681+65 C=683+30

**23-C**

**23-D**

**23-E**

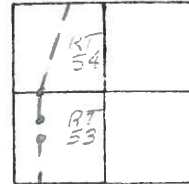


SET PK & WASHER @ ALL 3 POINTS  
8-7-95  
SAH

REC. SLM 683+30  
F.d. PK @ SURFACE  
0.5' LT. & PYMT.

REC. SLM 681+65  
F.d. PK @ SURFACE  
0.5' LT. & PYMT.

REC. SLM 678+78  
F.d. SMALL RR SPK @ SURFACE  
0.8' LT. & PYMT.

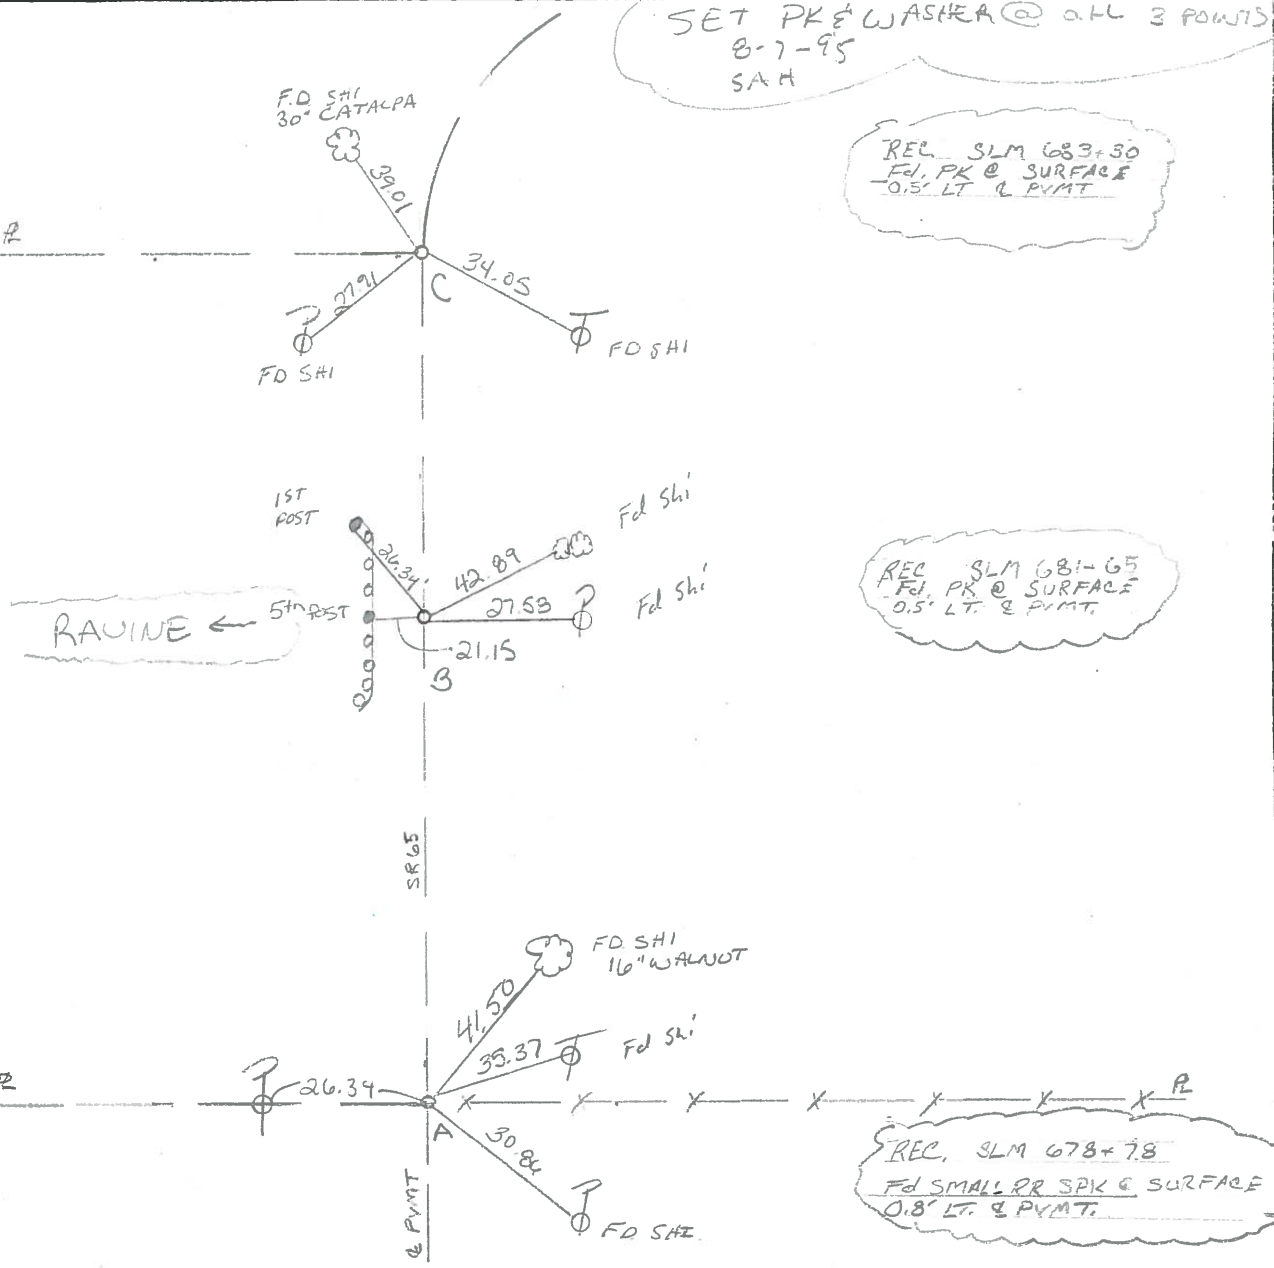

County WOOD S.R. 65

Township MIDDLETON

Section R.T. 53 & 54


T6N, R10E

Personnel HOFFMAN

Date 4-13-84

Weather P. Clear

Temp. 50°

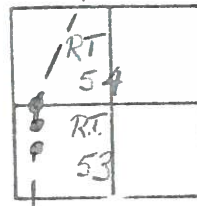

- 23-C**
- 23-D**
- 23-E**

LOENBLE  
Hausenholzer H.C.  
BARNHISEL R.C.


SET PK/WASHER

CALL 3 POINTS

10-17-84

S.W.H.

SLM 683+30  
 Fd P.K. @ surface  
 0.5' Lt. of & Post  
 9.3' to Lt. EP  
 10.2' to Rt. EP

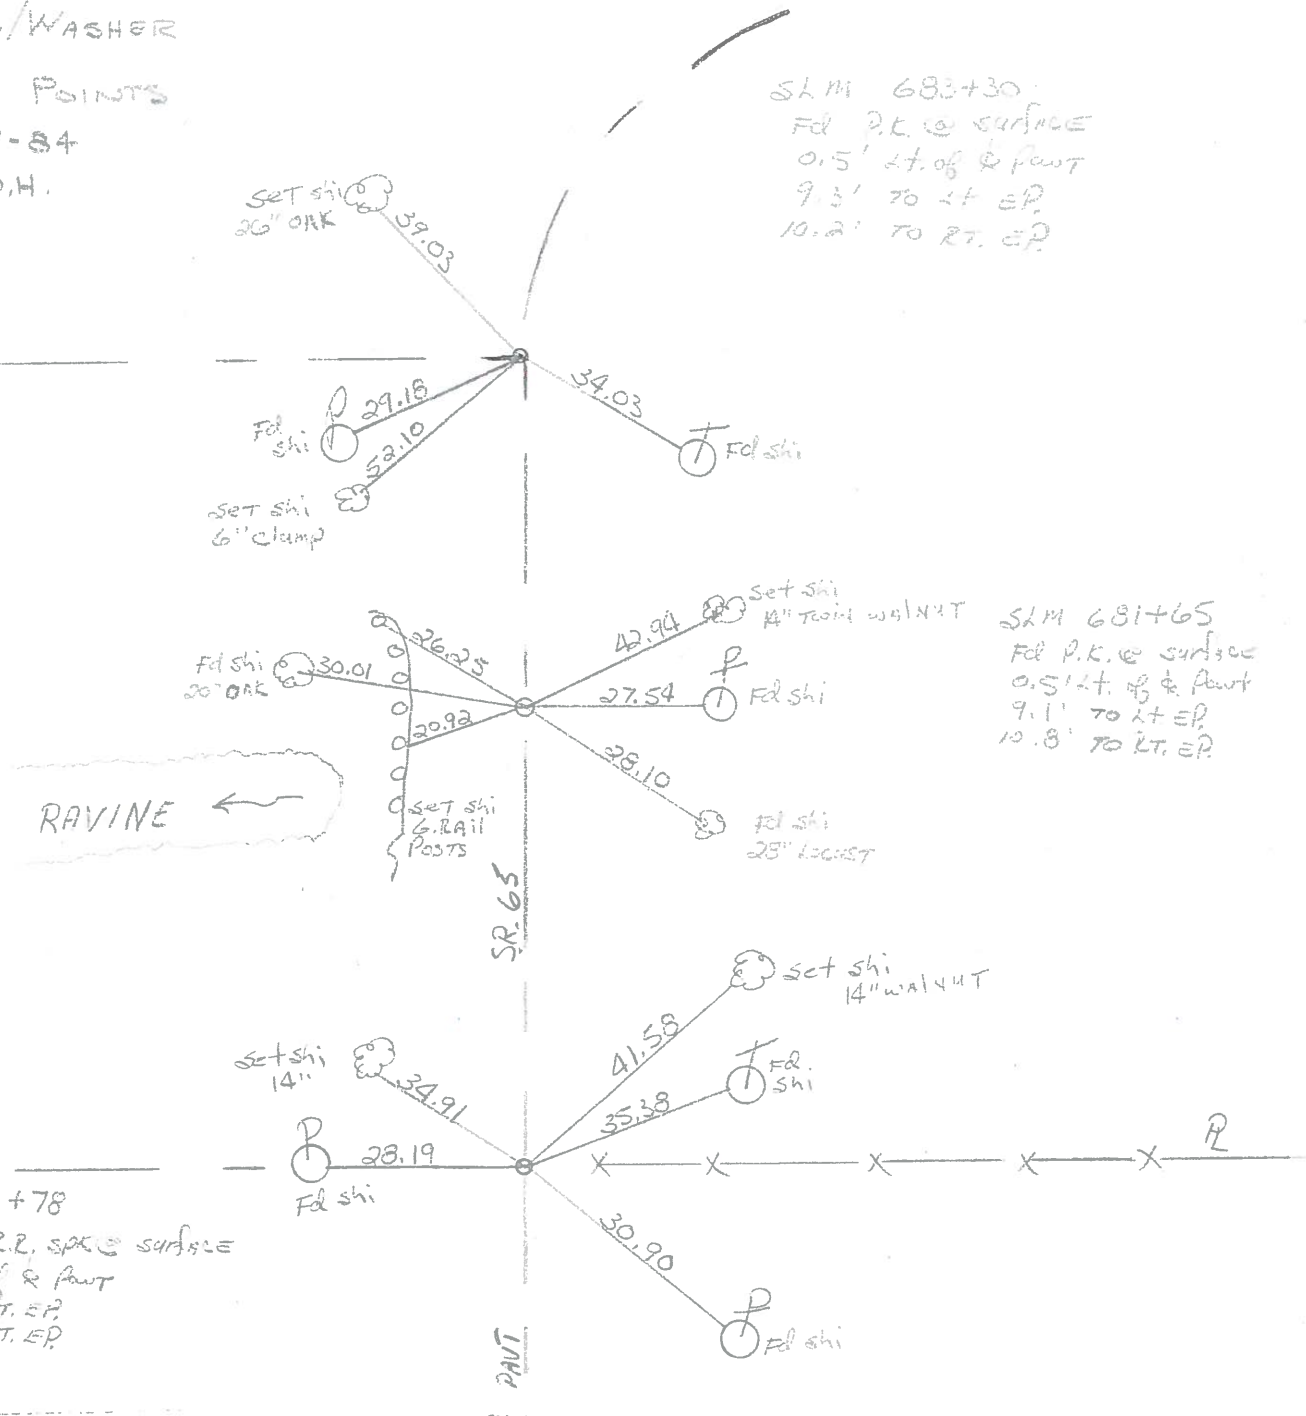

SLM 681+65  
 Fd P.K. @ surface  
 0.5' Lt. of & Post  
 9.1' to Lt. EP  
 10.8' to Rt. EP

SLM 678+78  
 Fd small P.K. spk @ surface  
 0.8' Lt. of & Post  
 6.7' to Lt. EP  
 9.9' to Rt. EP

Q PAWT

County WOOD S.R. 65

Date 7-10-80

Township MIDDLETON

Weather FAIR


Section R.T. 53-54

Temp. 85°

T\_N, R\_E

Personnel SMITH

23-C

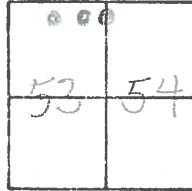

BOWERS


\_\_\_\_\_

\_\_\_\_\_

\_\_\_\_\_

23-D

23-E

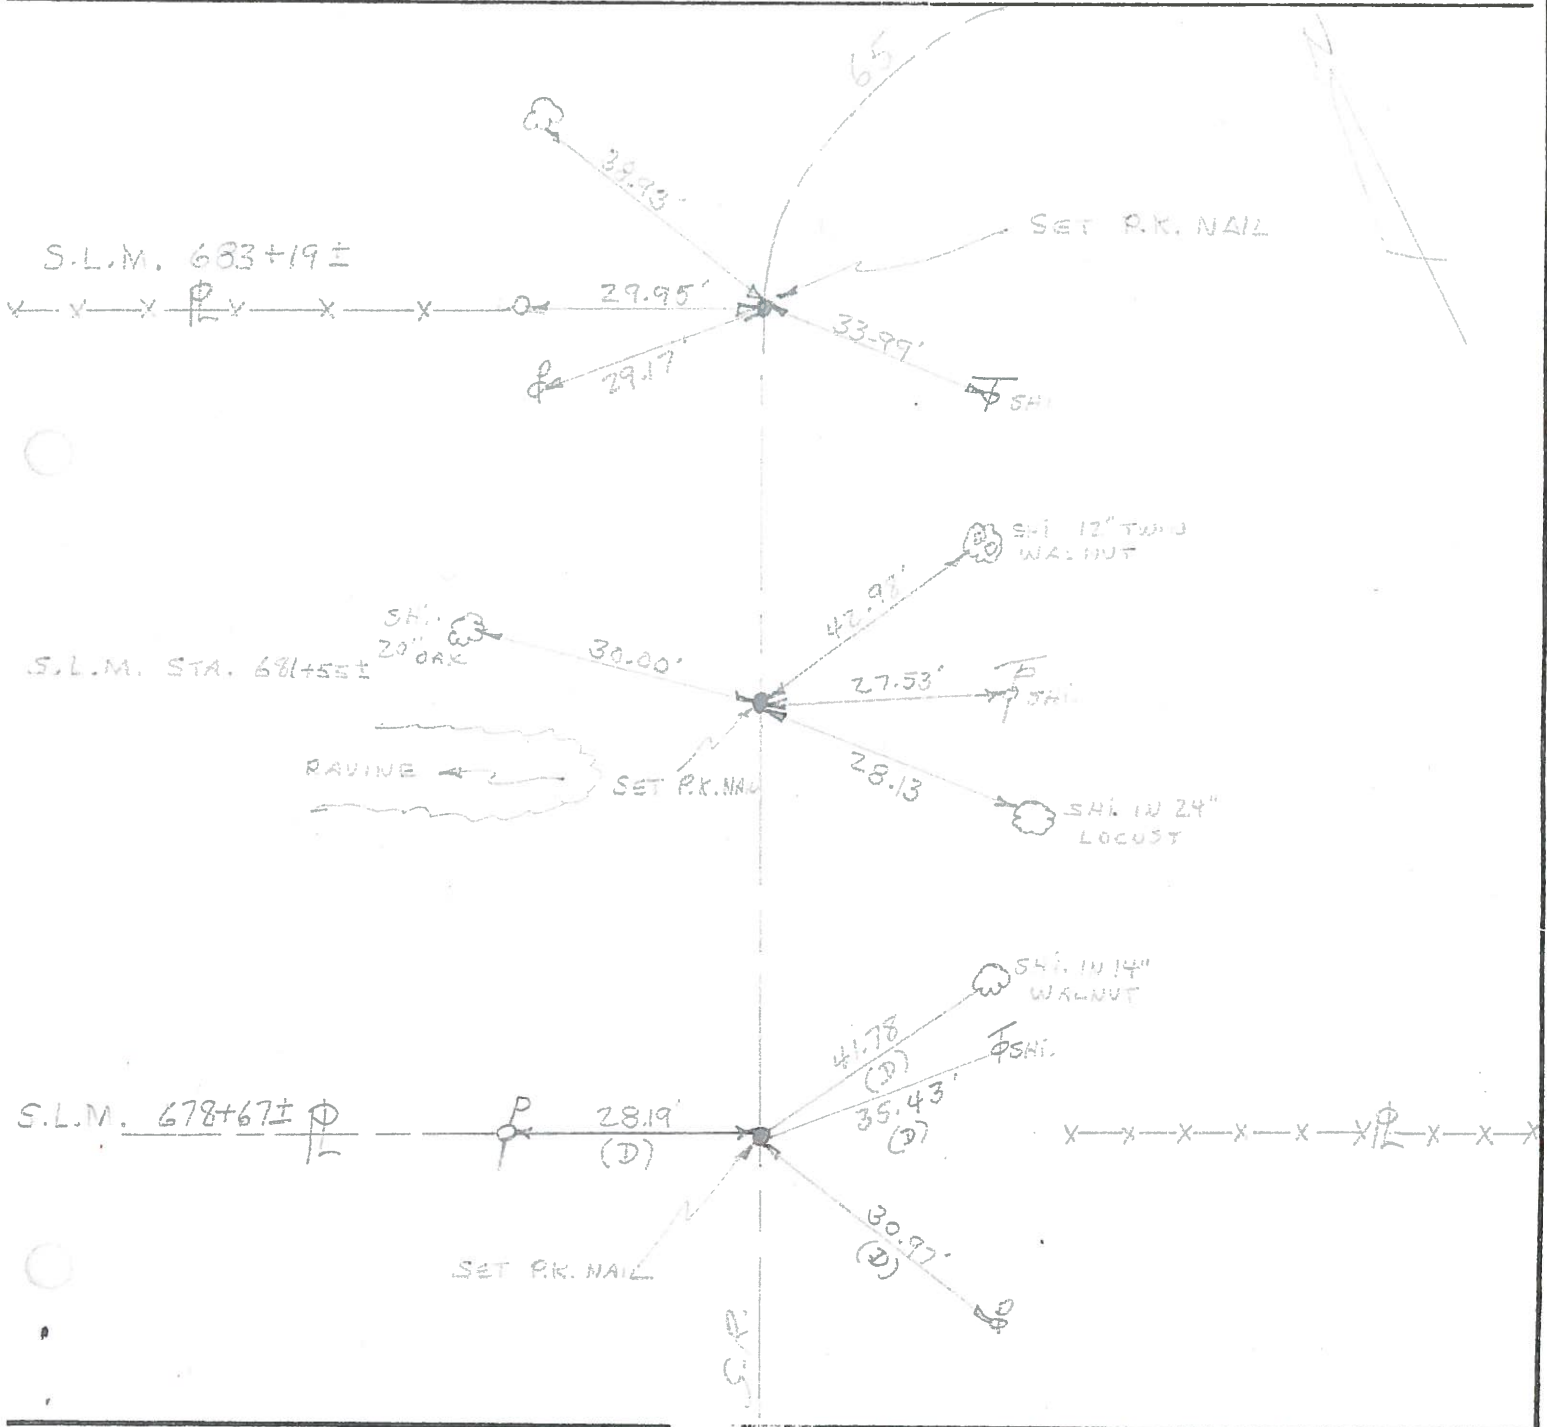

PERSONNEL	TITLE	PERSONNEL	TITLE	COUNTY	DATE	WEATHER	TEMP.
BURNSIDE				Wood	4-18-72	CLEAR	+77°
SMITH				S. R. 65			
BOWERS				SEC MIDDLETON TWP			

DESCRIPTION	LEFT	CENTER LINE	RIGHT	JOB NO.
-------------	------	-------------	-------	---------

