



O.D.O.T. DISTRICT 2 SURVEY OFFICE (USE ONLY)

PERSONNEL _____ REFERENCE NO. 23 H SHEET 18 OF 44
 NOTES HOMAN DATE 6/23/14 ROUTE 18
 H.C. LEU WEATHER SUNNY COUNTY WOOD
 R.C. HOMAN TEMP. 75° TOWNSHIP MIDDLETON
 _____ SECTION RT 54
 _____ T 7 N R 10 E

TYPE MONUMENT P.K.NAIL
 ON SURFACE - ~~BELOW~~ ON
 LEFT - C PAV'T - RIGHT ON
10' TO RT EDGE PAVEMENT
 S.L.M. 706+44.64

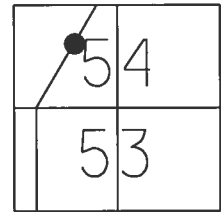


RECORD:
 FD R.R.SPIKE
 3" DOWN
 ORIGIN UNKNOWN
 SET P.K./WASHER
 10/17/84
 FD P.K./WASHER
 5/24/95, SAH
 SET P.K./WASHER
 8/7/95, SAH
 FD P.K.NAIL
 REFH23
 9/18/12, SAH
 FD P.K. NAIL
 REFH23
 6/23/14, DCH
 SET MAG/WASHER
 6/2/17, DCH

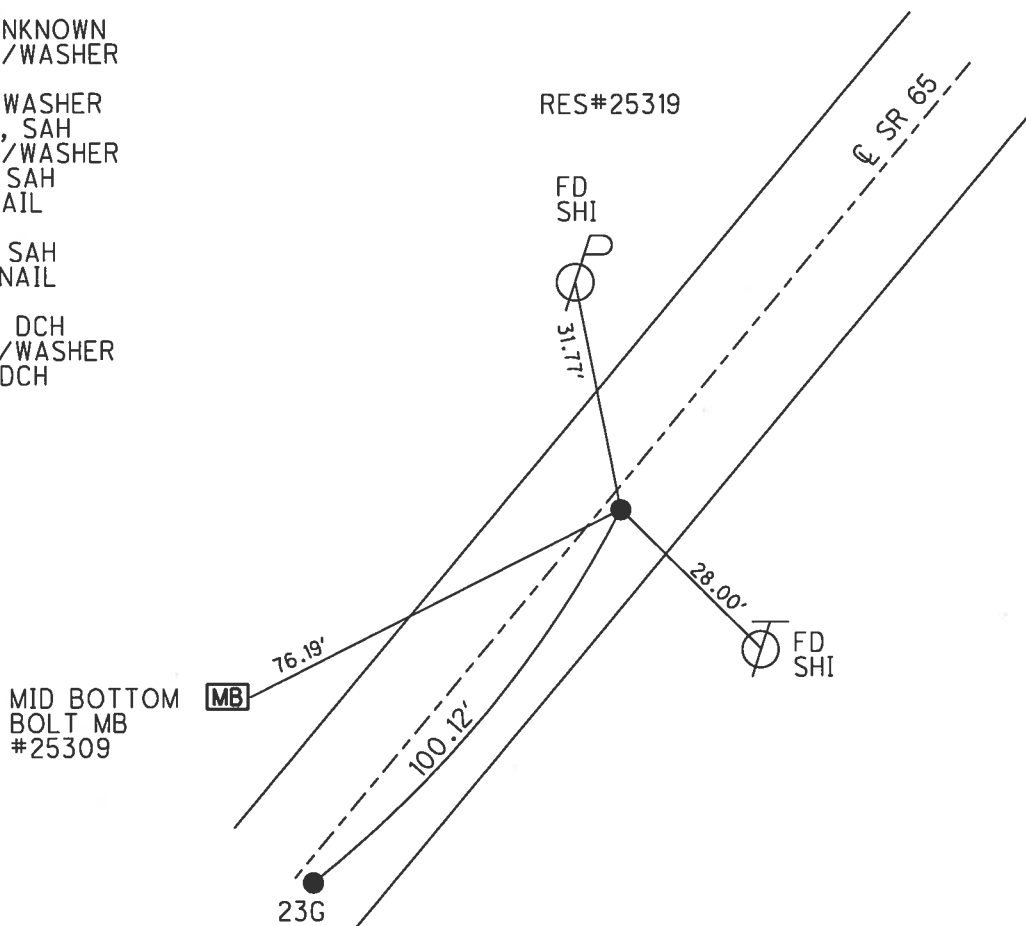

O.D.O.T.: DISTRICT 2 SURVEY OFFICE (USE ONLY)

PERSONNEL _____ REFERENCE NO. 23 H SHEET 18 OF 44
 NOTES VANDUSEN DATE 5/24/95 ROUTE 18
 H.C. MOSER WEATHER CLOUDY COUNTY WOOD
 R.C. HUSS TEMP. 60° TOWNSHIP MIDDLETON
 _____ SECTION RT 54
 _____ T 7 N R 10 E

TYPE MONUMENT P.K./WASHER
 ON SURFACE - ~~BELOW~~ ON
 LEFT - ℄ PAV'T - RIGHT ON
10' TO RT EDGE PAVEMENT
 S.L.M. 706+44.64

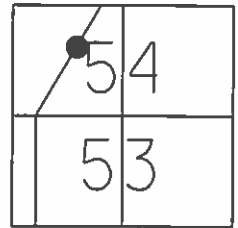


Grid: Northing: 677136.158 Easting: 1638625.649

RECORD:
 SET P.K./WASHER
 10/17/84

SET P.K./WASHER
 8/7/95, SAH

FD P.K.NAIL
 GPS, REFH23
 9/18/12, SAH

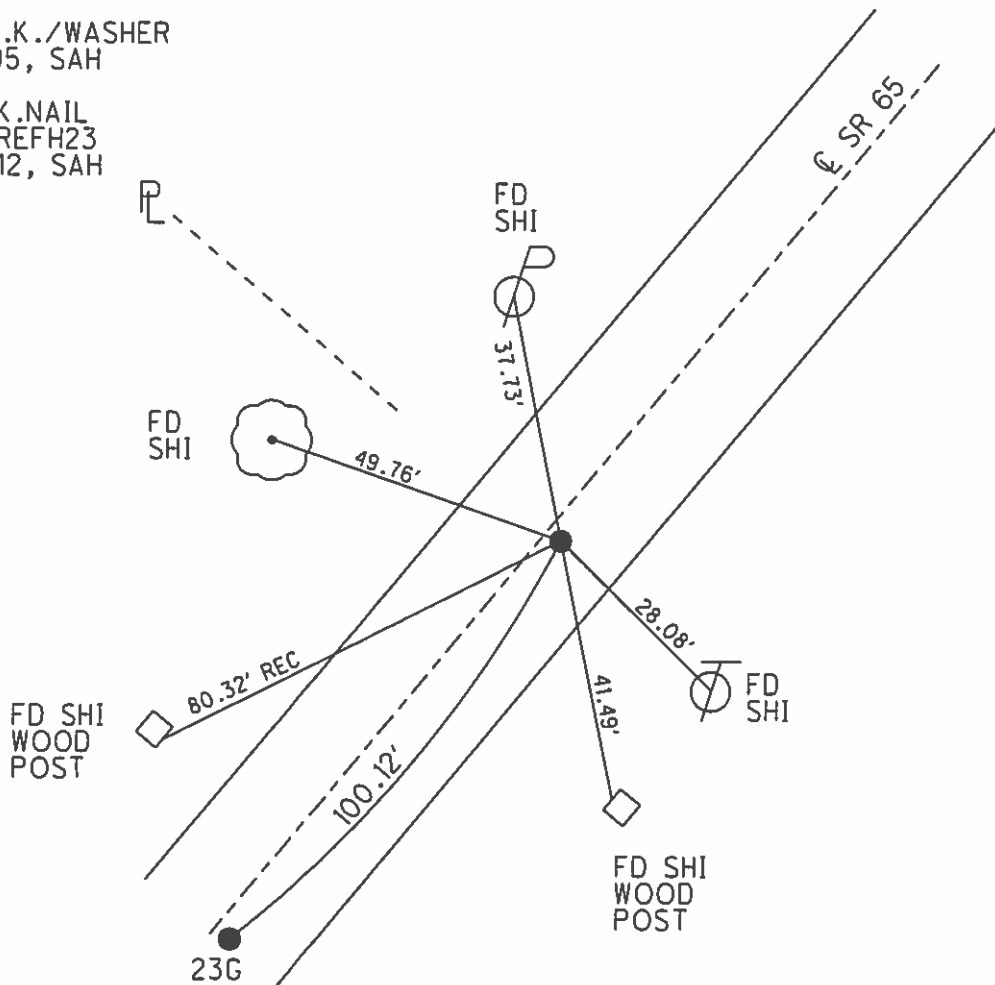

O.D.O.T. DISTRICT 2 SURVEY OFFICE

PERSONNEL _____

REFERENCE NO. _____

SHEET 48 OF 91

NOTES VAN DUSEN

H.C. MOSEK

R.C. HUSS

DATE 5-24-95

WEATHER CLOUDY

TEMP. +60°F

ROUTE SR 65

COUNTY Wood

TOWNSHIP Perrysburg

SECTION RT 54

T 7 N R 10 E

TYPE MONUMENT PK/WASHER

ON SURFACE - ~~BELOW~~ YES



~~LEFT - & PAV'T. - RIGHT~~ A & B

10.0 TO RT EDGE PAVEMENT

S.L.M. A = 703+42 B = 704+42

23-G

23-H

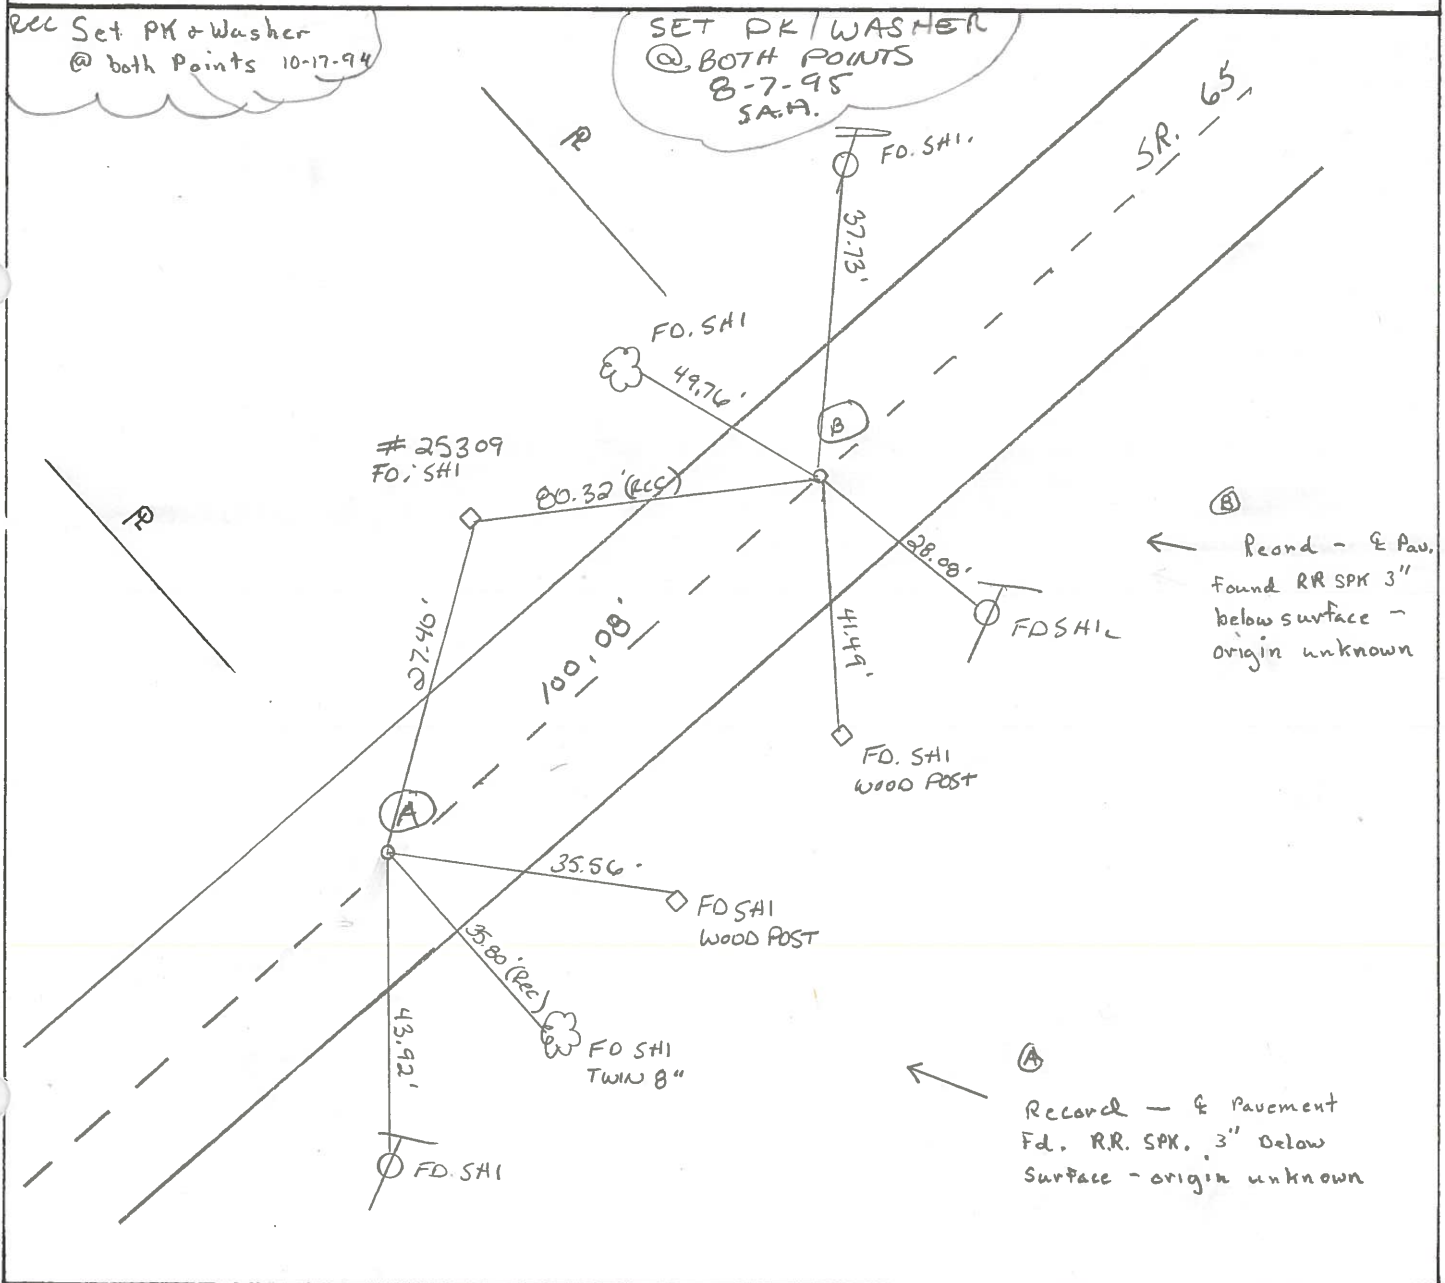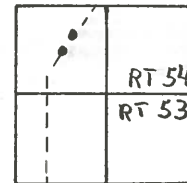

County WOOD S.R. 65

Date 4-13-84

Township PERRYSBURG

Weather P. CLEAR

Section R.T. 54

Temp. 55°

TZN, R/OE

Personnel HOFFMAN

23-G

LOEHRKE

23-H

HOUSEHOLDER H.C.

BARNHISEL R.C.

