



O.D.O.T. DISTRICT 2 SURVEY OFFICE (USE ONLY)

PERSONNEL _____ REFERENCE NO. 23 1 SHEET 19 OF 44
 NOTES LEU DATE 6/12/14 ROUTE SR 65
 H.C. WESTFALL WEATHER CLOUDY COUNTY WOOD
 R.C. HOMAN TEMP. 69° TOWNSHIP MIDDLETON
RHOADES SECTION RT 55
 T 7 N R 10 E

TYPE MONUMENT P.K.NAIL
 ON SURFACE - ~~BELOW~~ ON _____
~~LEFT~~ - C PAV'T - RIGHT 0.5'
10.3' TO LT EDGE PAVEMENT
 S.L.M. 710+82
 Grid: Northing: 677500.736 Easting: 1638867.237

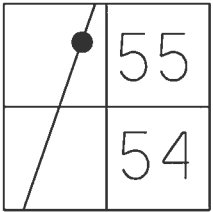


RECORD:
 SET P.K./WASHER
 10/17/84
 FD P.K./WASHER
 5/24/95, SAH
 SET P.K./WASHER
 8/7/95, SAH
 FD P.K.NAIL
 REFI23
 9/18/12, SAH
 FD P.K.NAIL
 REFI23
 6/12/14, DCH
 SET MAG/WASHER
 6/2/17, DCH

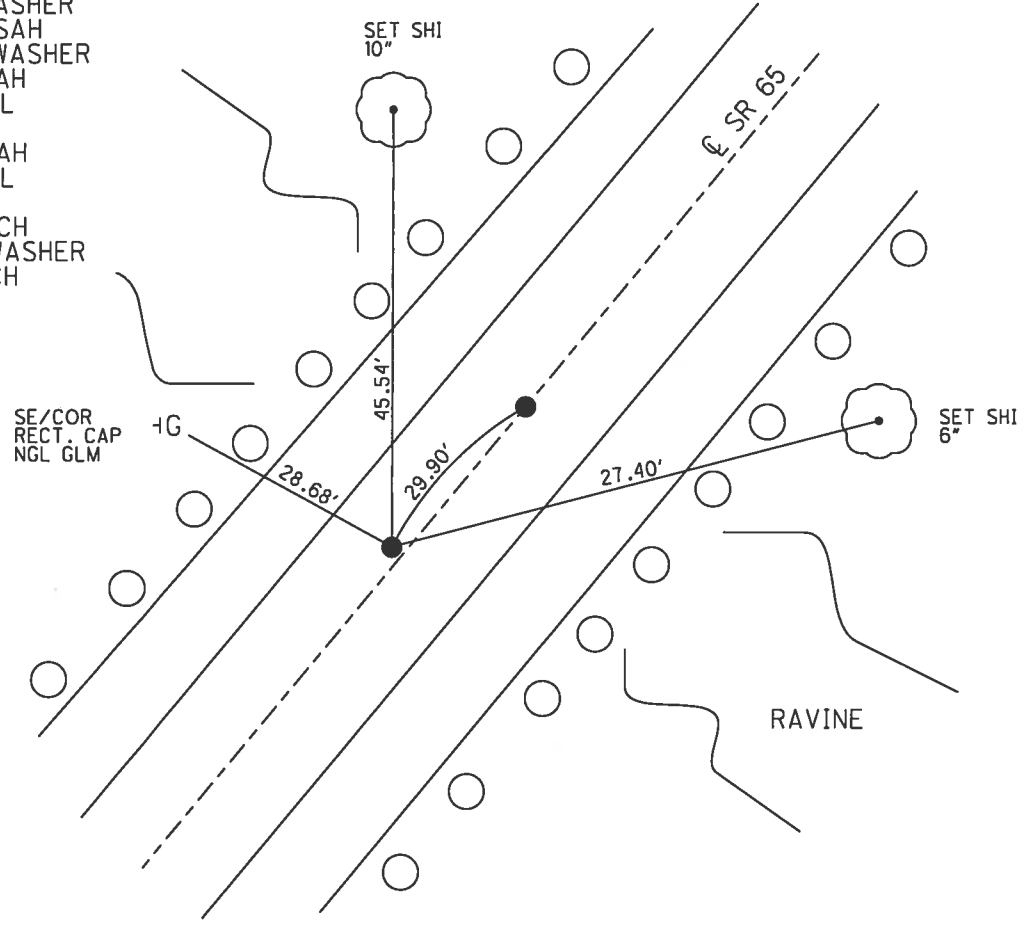

O.D.O.T. DISTRICT 2 SURVEY OFFICE (USE ONLY)


PERSONNEL _____ REFERENCE NO. 231 SHEET 19 OF 44
 NOTES VAN DUSEN DATE 5/24/95 ROUTE SR 65
 H.C. MOSER WEATHER CLOUDY COUNTY WOOD
 R.C. HUSS TEMP. 60° TOWNSHIP MIDDLETON
 _____ SECTION RT 55
 _____ T 7 N R 10 E

TYPE MONUMENT P.K./WASHER
 ON SURFACE - ~~BELOW~~ ON
 LEFT - ☉ PAV'T - ~~RIGHT~~ 0.5'
9.9' TO LT EDGE PAVEMENT
 S.L.M. 710+82

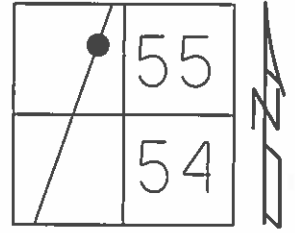

Grid: Northing: 677500.736 Easting: 1638867.237

RECORD:
 SET P.K./WASHER
 10/17/84
 SET P.K./WASHER
 8/7/95, SAH
 FD P.K.NAIL
 GPS, REF123
 9/18/12, SAH

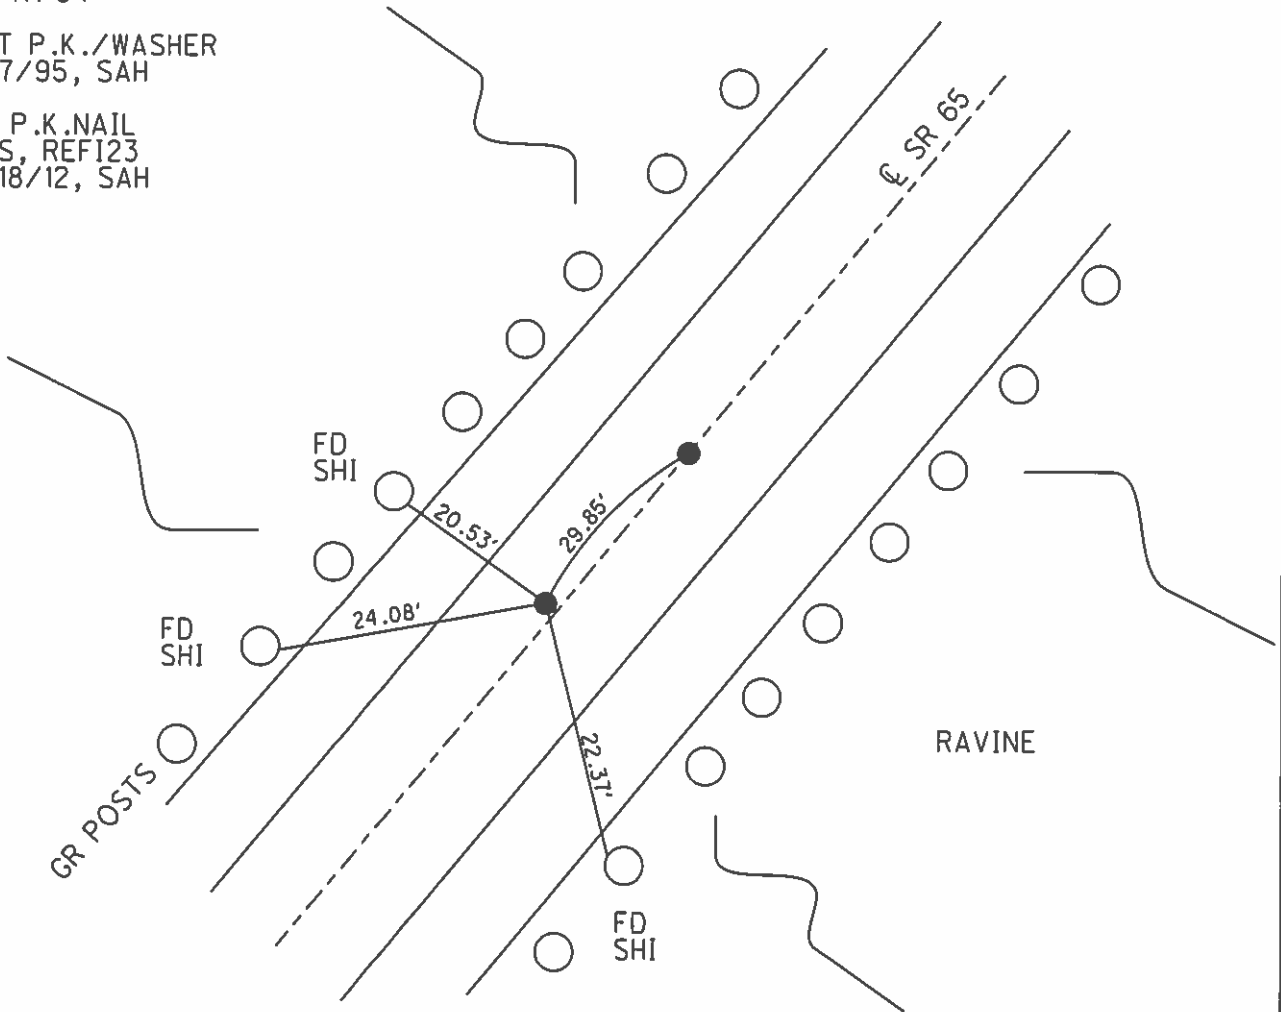

O.D.O.T. DISTRICT 2 SURVEY OFFICE

PERSONNEL _____

REFERENCE NO. _____

SHEET 49 OF 91

NOTES VAN DUSEN

H.C. MOSER

R.C. HUSS

DATE 5-24-95

WEATHER CLOUDY / DRIZZLE

TEMP. +60°F

ROUTE SR 65

COUNTY Wood

TOWNSHIP Middleton

SECTION RT - 55

T 7 N R 10 E

TYPE MONUMENT PK/WASHER

ON SURFACE - BELOW


LEFT - CL PAV'T. - RIGHT A=0.5' LT B=0.0' CL

A=7.9
B=70.3 TO LT EDGE PAVEMENT

S.L.M. A=709+10 B=708+80


23-I

23-J

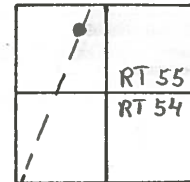

REC Set PK/Washer
Both Points
10-17-84
SWH

SET P.K./WASHER @
BOTH POINTS
8-7-95

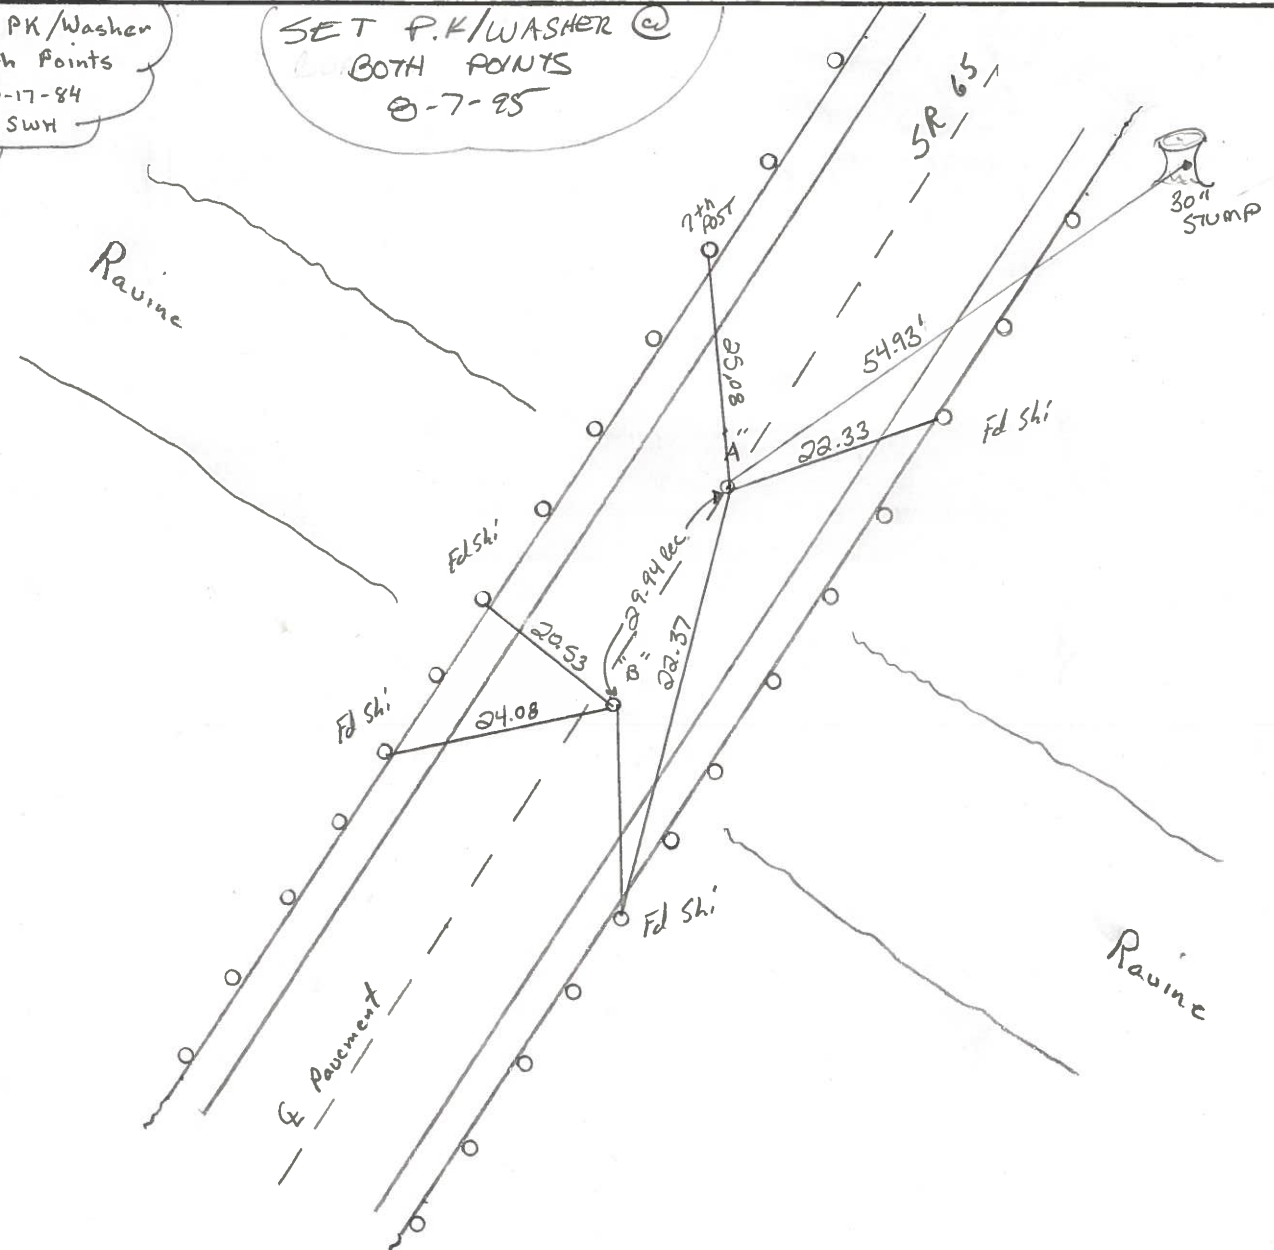

County WOOD S.R. 65

Date 4-13-84

Township MIDDLETON


Weather P. Clear

Section R.T. 55

Temp. 55°

T7N, R10E

Personnel HOFFMAN

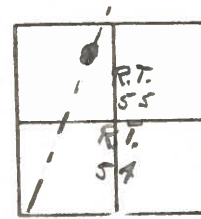

23-I
23-J


LOEMRKE
HOUSEHOLDER H.C.
BARNHISEL R.C.

"A" Fd P.K. @ SURFACE
on & PAWT
8.8' TO LT. EP.
9.6' TO RT. EP.

SLM 709+10

SET PK/WASHER
@ BOTH POINTS
10-17-84
S.W.H.

PAWT. SR. 65

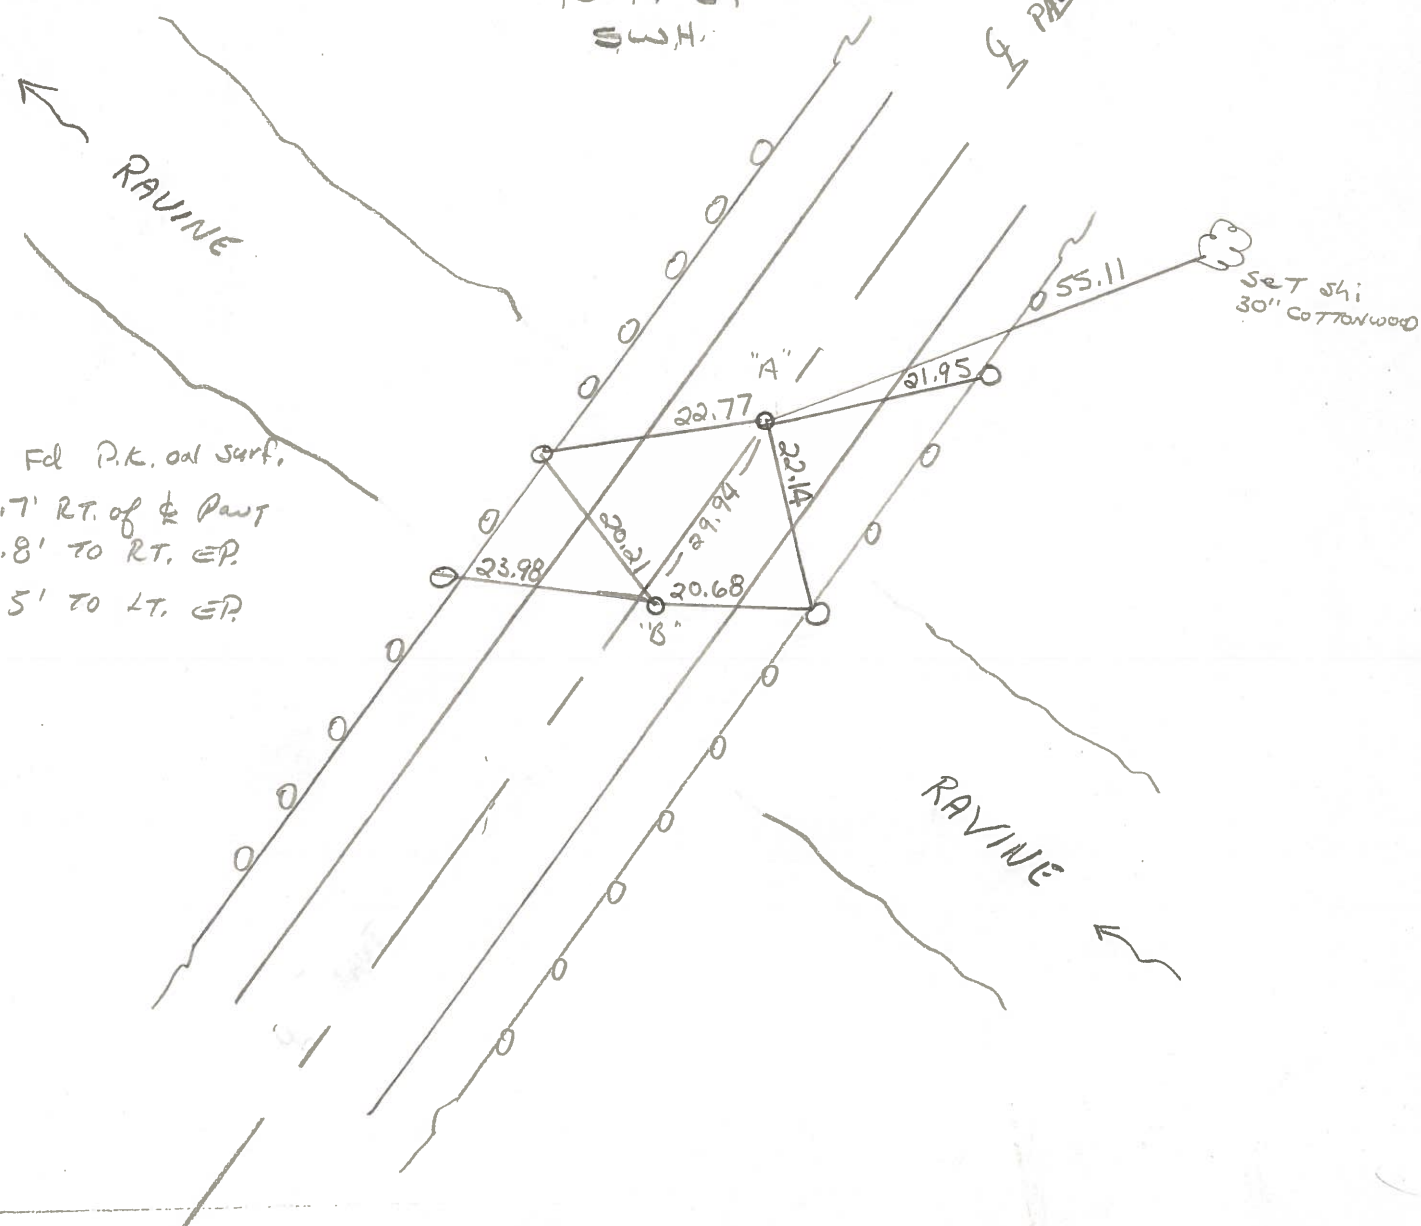

"B" Fd P.K. on surf.
0.7' RT. of & PAWT
8.8' TO RT. EP.
9.5' TO LT. EP.

County WOOD S.R. 65

Date 7-11-80

Township MIDDLETON

Weather FAIR


Section R.T. 55

Temp. 82°

T_N, R_E

Personnel SMITH


23-I

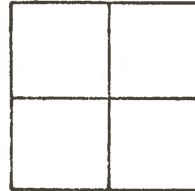

BOWERS

23-J

RESET P.K. NAIL
800'± SOUTH OF
ROACHTON ROAD
S.L.M. STA. 708+99±

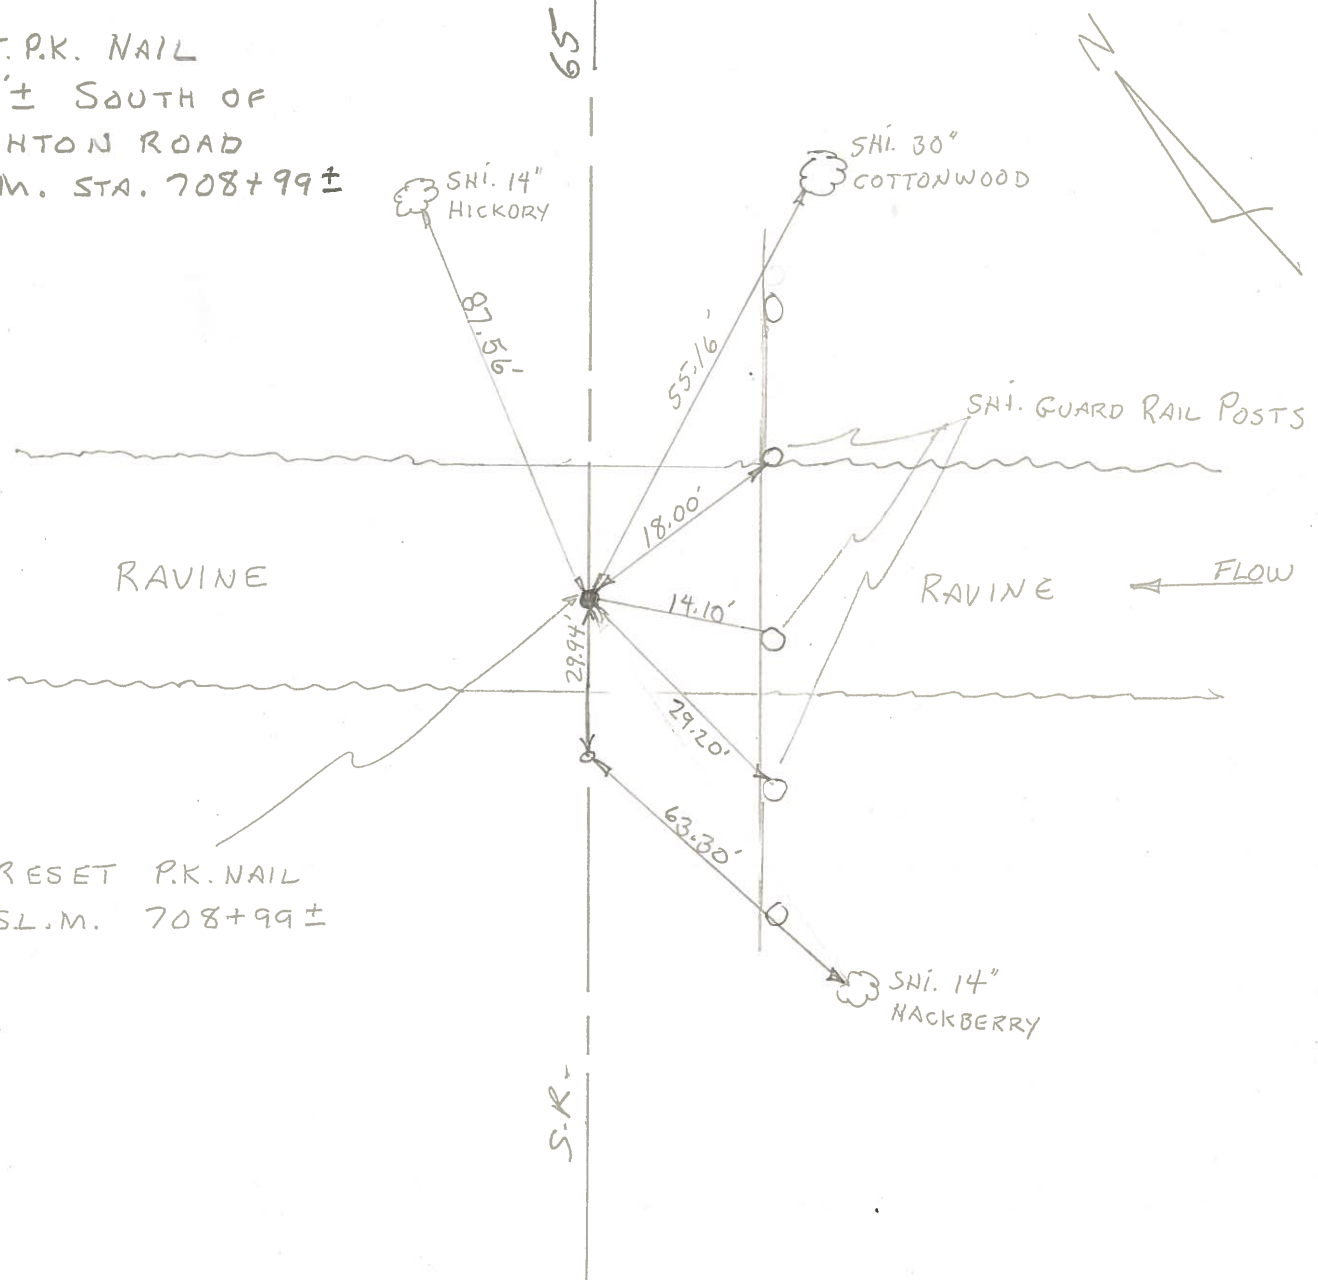

RESET P.K. NAIL
S.L.M. 708+99±

| PERSONNEL | TITLE | PERSONNEL | TITLE |
|------------|------------|-----------|-------|
| Delventhal | Hoover | | |
| Young | Ruffer | | |
| | Delventhal | | |
| | Young | | |
| | Hoff | | |

COUNTY Wood DATE 8-17-60
 OK 2-23-66
 S. R. 65 WEATHER Clear
 SEC. 11.96-17.65 TEMP. 80's

DESCRIPTION CONTROL POINTS LEFT CENTER LINE RIGHT JOB NO.

