


O.D.O.T. DISTRICT 2 SURVEY OFFICE (USE ONLY)


PERSONNEL _____ REFERENCE NO. 23 K SHEET 21 OF 44
 NOTES LEU DATE 6/12/14 ROUTE SR 65
 H.C. WESTFALL WEATHER CLOUDY COUNTY WOOD
 R.C. HOMAN TEMP. 75° TOWNSHIP MIDDLETON
RHOADES SECTION RT 55
 T 7 N R 10 E

TYPE MONUMENT P.K.SHANK
 ON SURFACE - ~~BELOW~~ ON _____
~~LEFT~~ - C PAV'T - RIGHT 0.7'
9.7' TO RT EDGE PAVEMENT
 S.L.M. 714+76.96
 Grid: Northing: 677830.126 Easting: 1639085.157

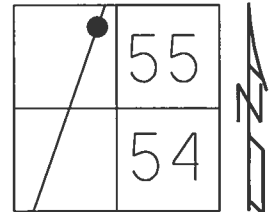

RECORD:
 SET P.K./WASHER
 10/17/84
 FD P.K./WASHER
 5/23/95, SAH
 SET P.K./WASHER
 8/8/95, SAH
 FD P.K.NAIL
 REFK23
 9/18/12, SAH
 FD P.K.SHANK
 REFK23
 6/12/14, DCH
 SET MAG/WASHER
 6/2/17, DCH


NOTE:
 335'± S OF ROACHTON RD

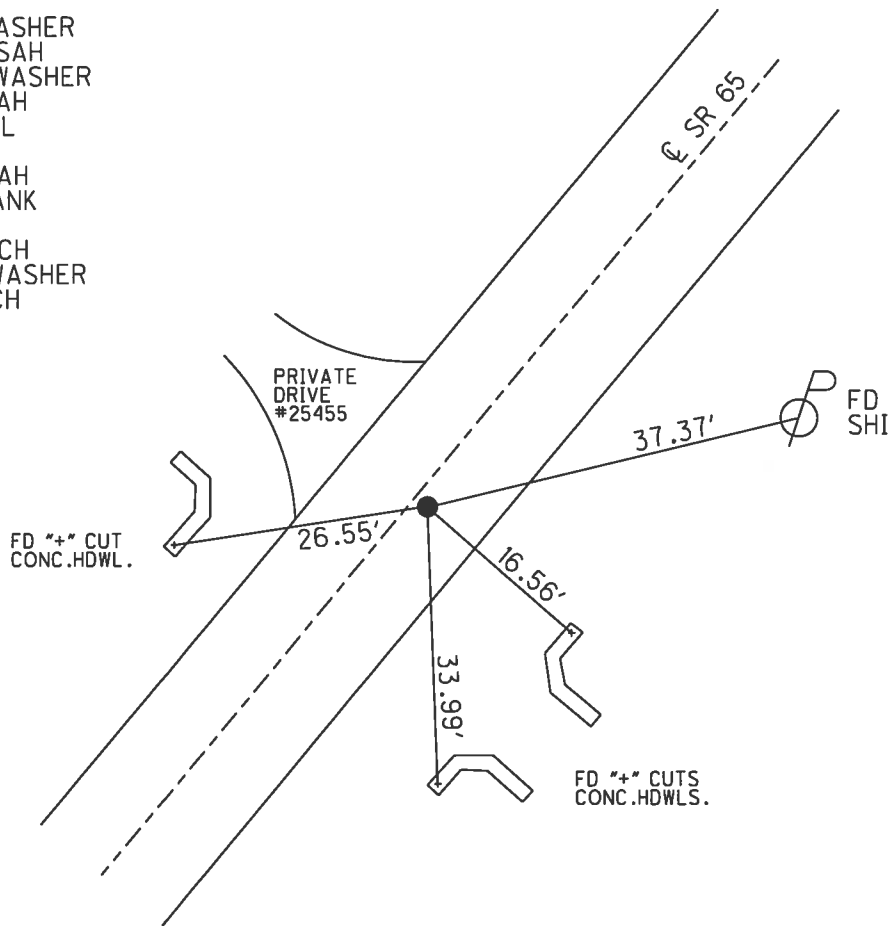

O.D.O.T. DISTRICT 2 SURVEY OFFICE (USE ONLY)

PERSONNEL _____ REFERENCE NO. 23 K SHEET 21 OF 44
 NOTES VAN DUSEN DATE 5/23/95 ROUTE SR 65
 H.C. MOSER WEATHER SUNNY COUNTY WOOD
 R.C. HUSS TEMP. 80° TOWNSHIP MIDDLETON
 _____ SECTION RT 55
 _____ T 7 N R 10 E


TYPE MONUMENT P.K./WASHER
 ON SURFACE - ~~BELOW~~ ON
~~LEFT~~ - Q PAV'T - RIGHT 0.7'
9.7' TO RT EDGE PAVEMENT
 S.L.M. 714+76.96
 Grid: Northing: 677830.126 Easting: 1639085.157

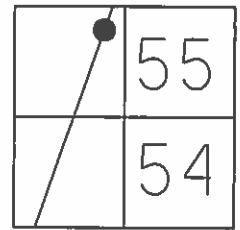

RECORD:
 SET P.K./WASHER
 10/17/84

SET P.K./WASHER
 8/8/95, SAH

FD P.K.NAIL
 GPS, REFK23
 9/18/12, SAH

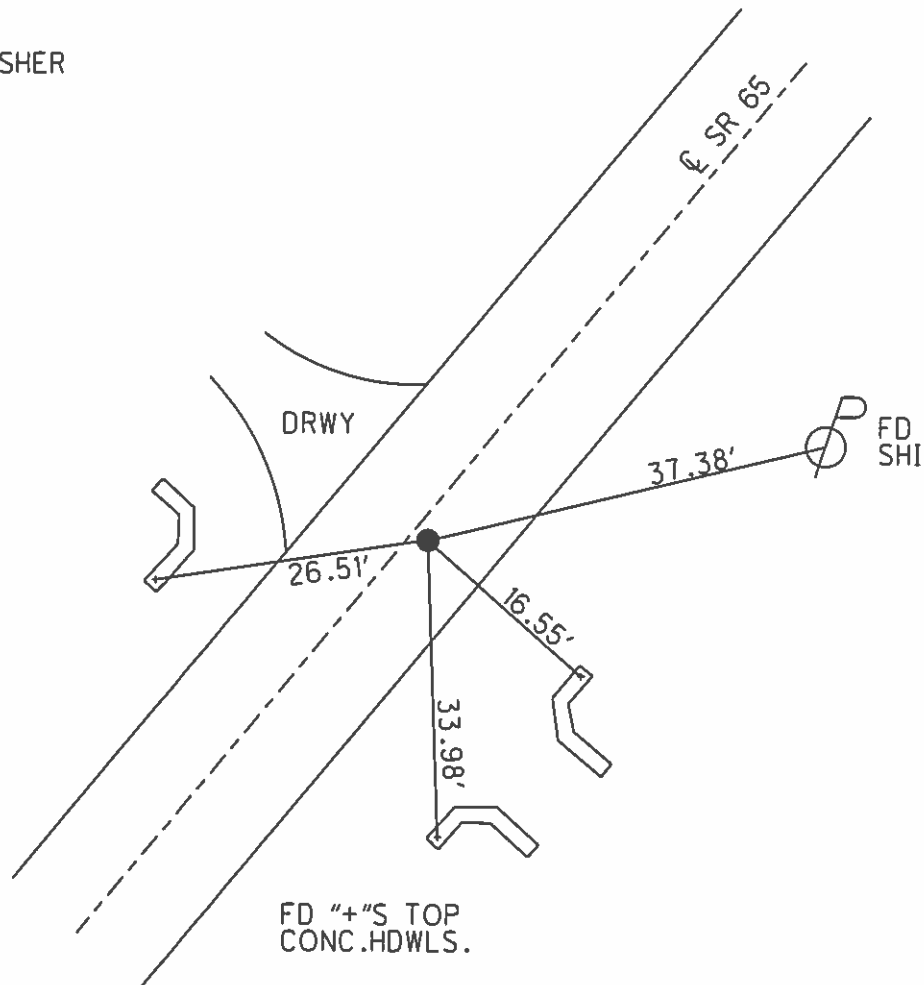

O.D.O.T. DISTRICT 2 SURVEY OFFICE

PERSONNEL _____

REFERENCE NO. _____

SHEET 50 OF 91

NOTES V. Andersen

H.C. MOSER

R.C. HUSS

CORDES

DATE 5-23-95

WEATHER Sunny

TEMP. +80°F

ROUTE SR-65

COUNTY Wood

TOWNSHIP Middleton

SECTION RT-55

T 7 N R 10 E

TYPE MONUMENT PK/WASHER


ON SURFACE - ~~BELOW~~ Yes

~~LEFT-C PAV'T.~~ - RIGHT 0.7' RT

9.7 TO RT EDGE PAVEMENT


S.L.M. 712 + 76

23-K

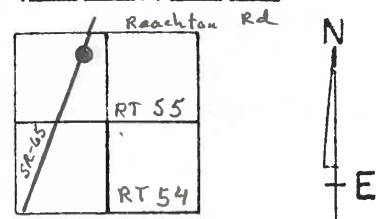

Record Set PK/Washer 10-17-84
± 335' South Roachton Rd
S.W.H.

SET PK/WASHER
8-8-95
SAH

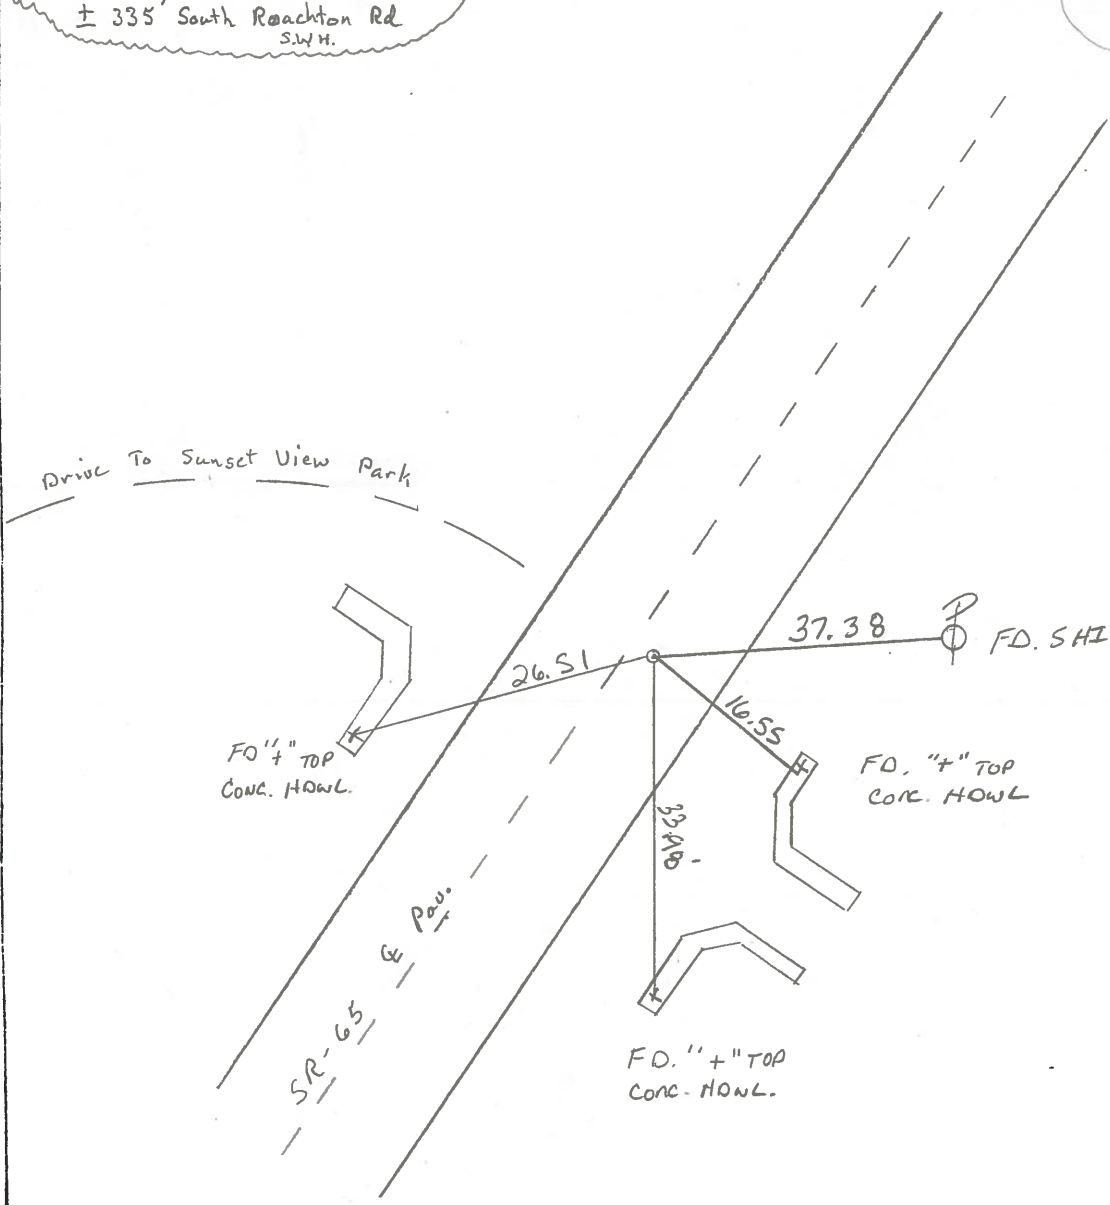

County WOOD S.R. 65

Date 4-16-84

Township MIDDLETON

Weather cloudy

Section R.T. 55

Temp. 45°

TZN, R10E


Personnel HOFFMAN

LOEHKE

HOUSEHOLDER H.C.

BARNHISEL R.C.

23-K

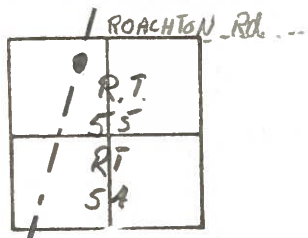

Fd P.K. @ SURFACE

0.7' RT. of ϕ PAWT

8.9' TO RT. EP

10.3' TO LT. EP

\pm 335' South of ROACHTON ROAD

SLM 712+76


SET PK/WASHER

10-17-84

SW.H.

S.R. 65

DRIVE TO SUNSET VIEW PARK

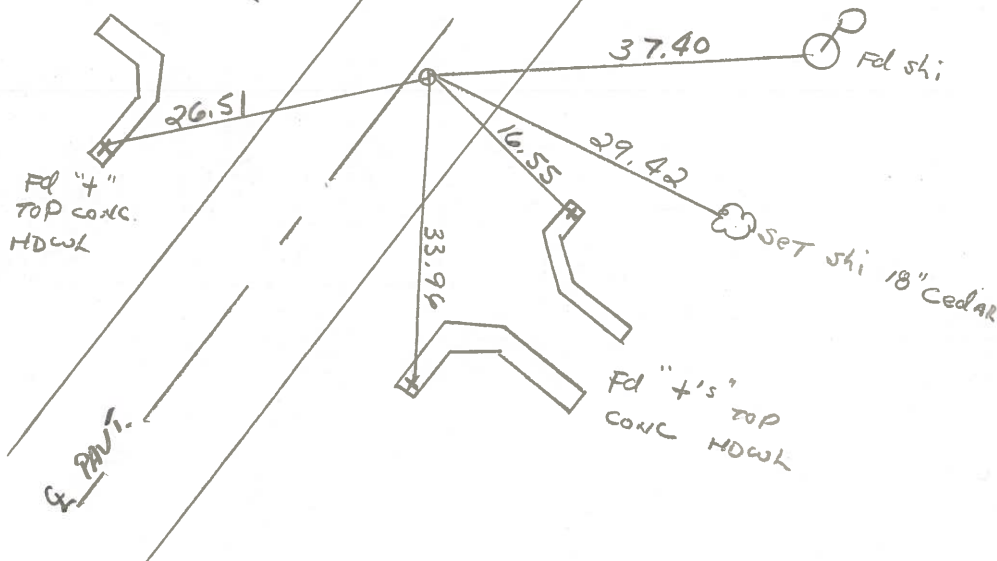

O.D.O.T. DISTRICT 2 SURVEY OFFICE

SHEET 8 OF

County WOOD S.R. 65

Date 7-11-80

Township MIDDLETON

Weather FAIR

Section 55


Temp. 80°

T N, R E

Personnel SMITH

BOWERS

23-K

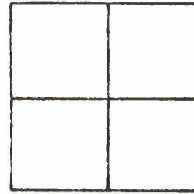

P.K. NAIL

S.L.M. 712+65±

335± SOUTH OF

ROACHTON RD.

DRIVE TO SUNSET VIEW PARK

4" CUT ON
TOP CONC
HDWL.


26.58'

37.43'

16.54'

33.92'

4" CUT ON TOP
CONC. HDWLS.

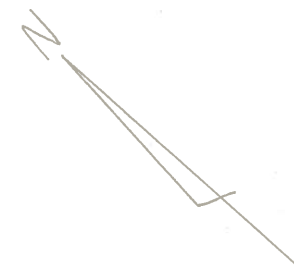

SKI.



PERSONNEL	TITLE	PERSONNEL	TITLE
BURNSIDE			
SMITH			
BOWERS			

COUNTY Wood DATE 4-18-72

S. R. 65 WEATHER CLEAR


SEC. MIDDLETON TWP TEMP. +76°

DESCRIPTION	LEFT	CENTER LINE	RIGHT	JOB NO.
-------------	------	-------------	-------	---------

23-K

(SET P.K. 5-5-72)
 F.D. P.K. NAIL
 S.L.M. STA. 712+65

335± SOUTH OF
 ROACHTON ROAD

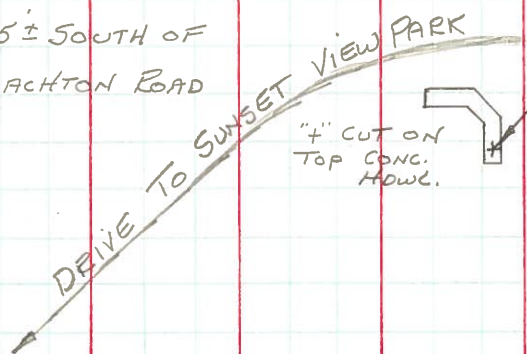

4" CUT ON
 TOP CONC.
 HDWLS.

26.52'

36.06'

PSHI.

16.54'

33.92'

4" CUT ON TOP
 CONC. HDWLS.

