


O.D.O.T. DISTRICT 2 SURVEY OFFICE (USE ONLY)

PERSONNEL _____ REFERENCE NO. 24 B SHEET 24 OF 44
 NOTES LEU DATE 6/12/14 ROUTE SR 65
 H.C. MOSER WEATHER CLOUDY COUNTY WOOD
 R.C. WESTFALL TEMP. 71° TOWNSHIP PERRYSBURG
 _____ RHOADES _____ SECTION RT 57
 _____ T 7 N R 10 E


TYPE MONUMENT P.K./WASHER
 ON SURFACE - ~~BELOW~~ ON _____
~~LEFT~~ - ☉ PAV'T - RIGHT 1'
10.7' TO LT EDGE PAVEMENT
 S.L.M. 739+00.02

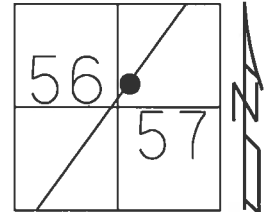

Grid: Northing: 679850.697 Easting: 1640422.514

RECORD:
 FD LG.R.R.SPIKE
 SET BY H.FREY FOR
 THE WILLOWBROOK SUB.
 -FARNHAM, WIRRES & BERNING
 10/17/84
 FD P.K./WASHER
 5/23/95, SAH
 SET P.K./WASHER
 8/8/95, SAH
 FD P.K./WASHER
 REFB24
 9/18/12, SAH
 FD P.K./WASHER
 REFB24
 6/12/14, DCH
 SET MAG/WASHER
 3/16/16, DCH

USE TOP OF 8TH
 BRICK FROM BOT.
 DRIVE MARKER
 #25815

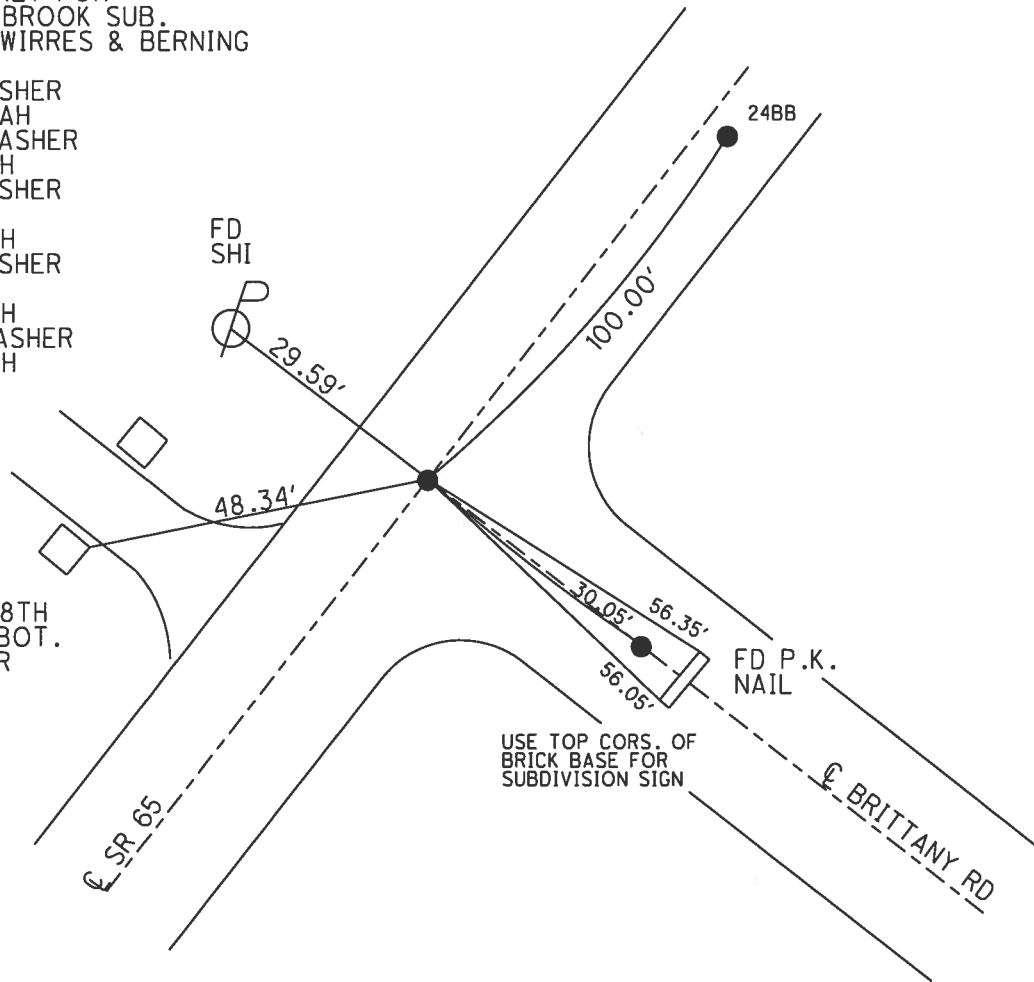


USE TOP CORS. OF
 BRICK BASE FOR
 SUBDIVISION SIGN

O.D.O.T. DISTRICT 2 SURVEY OFFICE (USE ONLY)

PERSONNEL _____ REFERENCE NO. 24 B SHEET 24 OF 44
 NOTES VAN DUSEN DATE 5/23/95 ROUTE SR 65
 H.C. MOSER WEATHER SUNNY COUNTY WOOD
 R.C. HUSS TEMP. 80° TOWNSHIP PERRYSBURG
 _____ SECTION RT 57
 _____ T 7 N R 10 E

TYPE MONUMENT P.K./WASHER
 ON SURFACE - ~~BELOW~~ ON _____
 LEFT - ☉ PAV'T - RIGHT ON _____
10.7' TO LT EDGE PAVEMENT
 S.L.M. 739+00.02

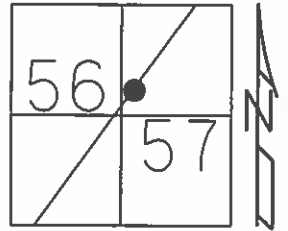


Grid: Northing: 679850.697 Easting: 1640422.514

RECORD:
 FD LG.R.R.SPIKE
 AT SURFACE.
 SET BY H.FREY FOR
 THE WILLOWBROOK SUB.
 -FARNAHM, WIRRES & BERNING
 10/17/84

SET P.K./WASHER
 8/8/95, SAH

USE TOP OF 8TH
 BRICK FROM BOT.
 DRIVE MARKER
 #25815

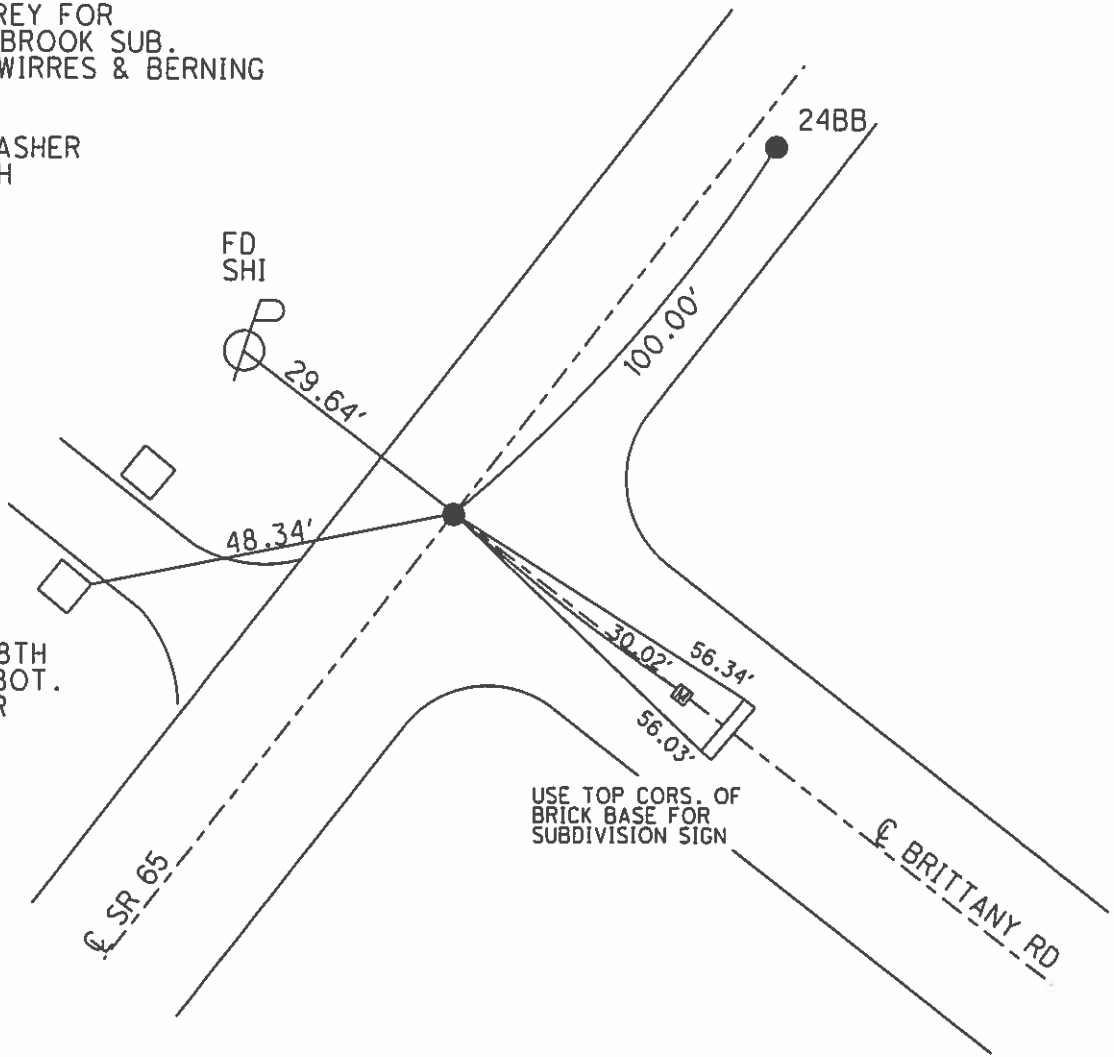

USE TOP CORS. OF
 BRICK BASE FOR
 SUBDIVISION SIGN

O.D.O.T. DISTRICT 2 SURVEY OFFICE

PERSONNEL _____

REFERENCE NO. _____

SHEET 53 OF 91

NOTES VAN DUSEN

H.C. MOSEK

DATE 5-23-95

ROUTE Wood

R.C. HUSS

WEATHER SUNNY

COUNTY SR-65

COLAES

TEMP. +80°F

TOWNSHIP Pennysburg

SECTION R.T. 57-38

T 7 N R 10 E

TYPE MONUMENT PK/WASHER

24-B


ON SURFACE - ~~BELOW~~

24-C

~~LEFT~~ - PAV'T. - RIGHT A=4 B=3.0' RT

^{A=10.7} TO ^{LT} RT EDGE PAVEMENT

S.L.M. A = 736+99 B = 737+99

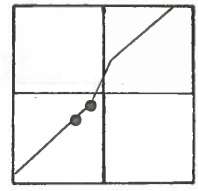


RECORD PT A.

FD LARGE R.F. SPK @
SURFACE & PAVT
S.R. US 10.7' LTER.
SET BY H. FREY FOR
WILLIAM BENO SUB.
(FARNAHM, WILKES & BERNING)
10-17-84

RECORD PT B.

FD. SMALL R.R. SPK
@ SURFACE
SLM 737+99

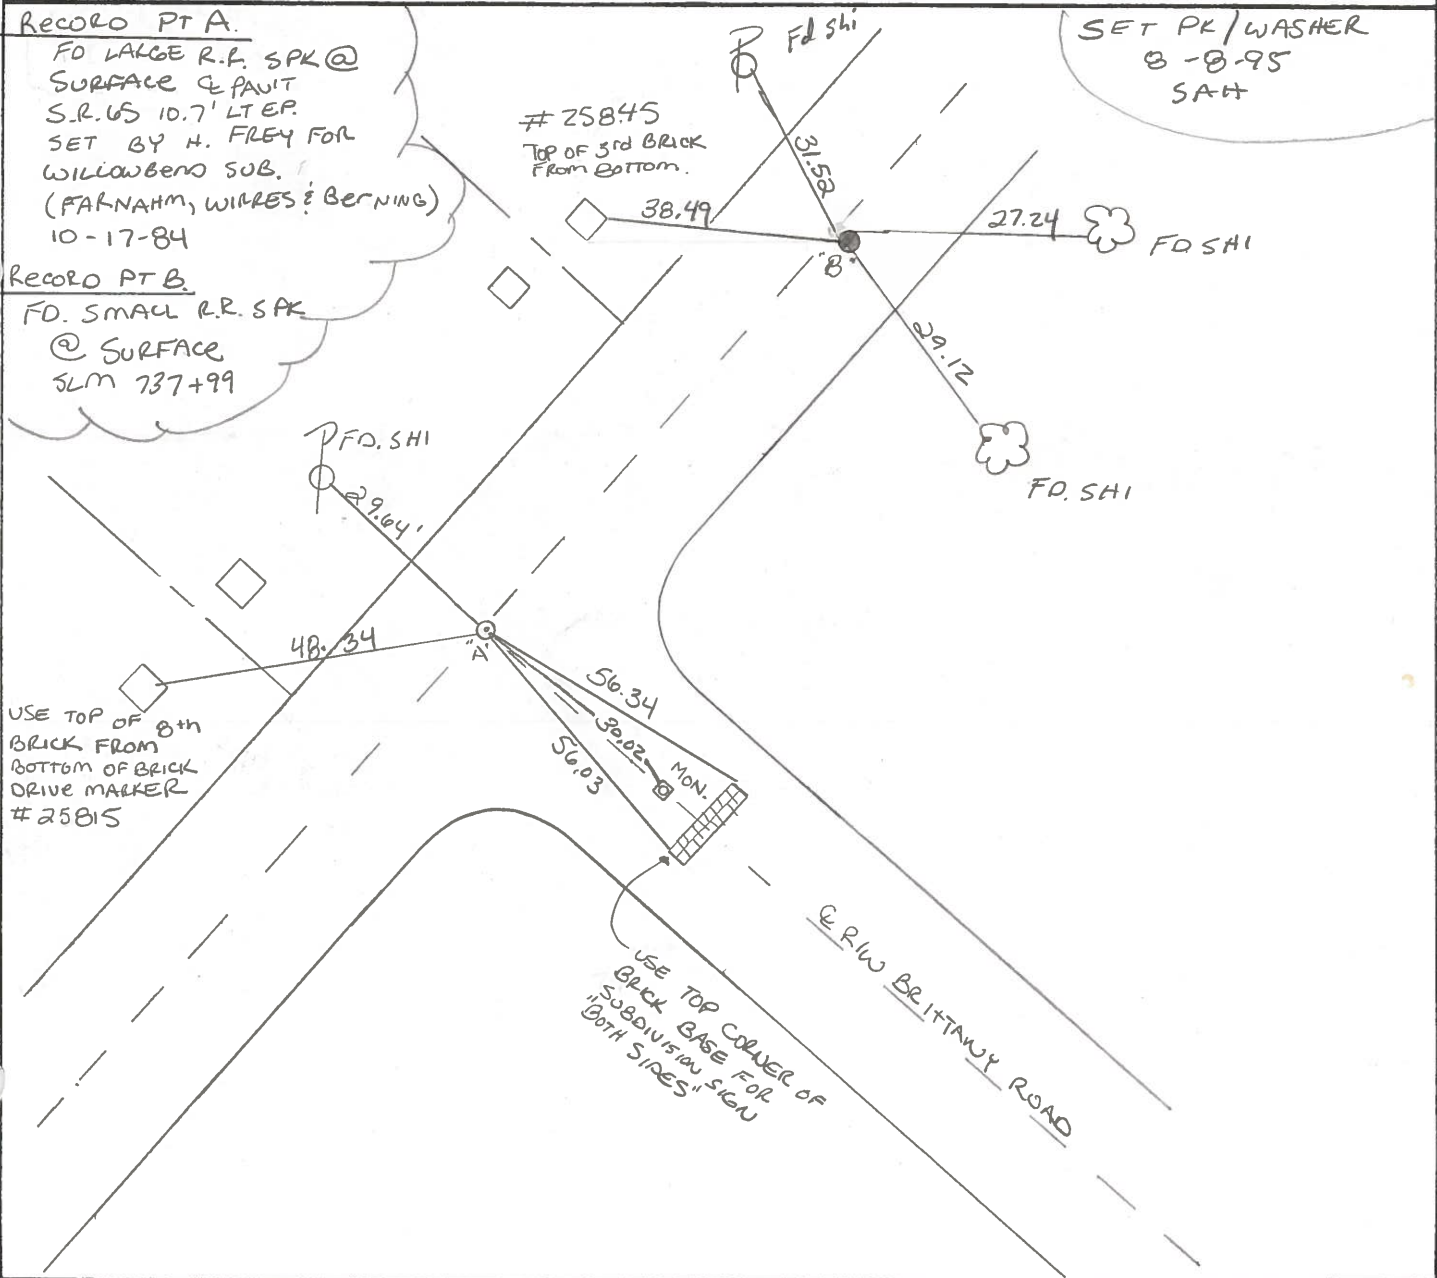

County WOOD S.R. 65

Date 4-16-84

Township PERRYS BURG


Weather Cloudy

Section RT. 57-58 (Willow Bend Sub.)

Temp. 45°

T7N, R10E

Personnel HOFFMAN
LOEHRLE
HOUSEHOLDER H.C.
BARNHISEL R.C.

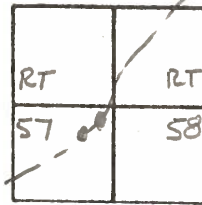

24-B
24-C

SLM 737+99
 Fd small R.R. spk @ surface
 1.8' RT. of & Pant
 7.7' TO RT. EP.
 11.1' TO LT. EP.

SET P.K./WASHER
 10-17-84
 S.W.H.

Record:
 P.I. = 738+90.6
 Δ = LT.

