


O.D.O.T. DISTRICT 2 SURVEY OFFICE (USE ONLY)

PERSONNEL _____ REFERENCE NO. 24 C SHEET 26 OF 44
 NOTES VAN DUSEN DATE 5/23/95 ROUTE SR 65
 H.C. MOSER WEATHER SUNNY COUNTY WOOD
 R.C. HUSS TEMP. 80° TOWNSHIP PERRYSBURG
 _____ SECTION RT 57
 _____ T 7 N R 10 E


TYPE MONUMENT P.K./WASHER
 ON SURFACE - ~~BELOW~~ ON _____
 LEFT - ☉ PAV'T - ~~RIGHT~~ 1.4'
8.6' TO LT EDGE PAVEMENT
 S.L.M. 741+70.63

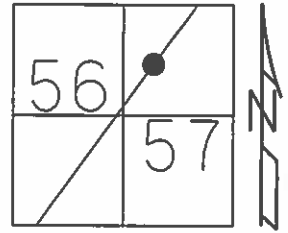

Grid: Northing: 680083.077 Easting: 1640560.846

RECORD: P.C.
 FD SM.R.R.SPIKE
 4/18/84

SET P.K./WASHER
 8/8/95, SAH

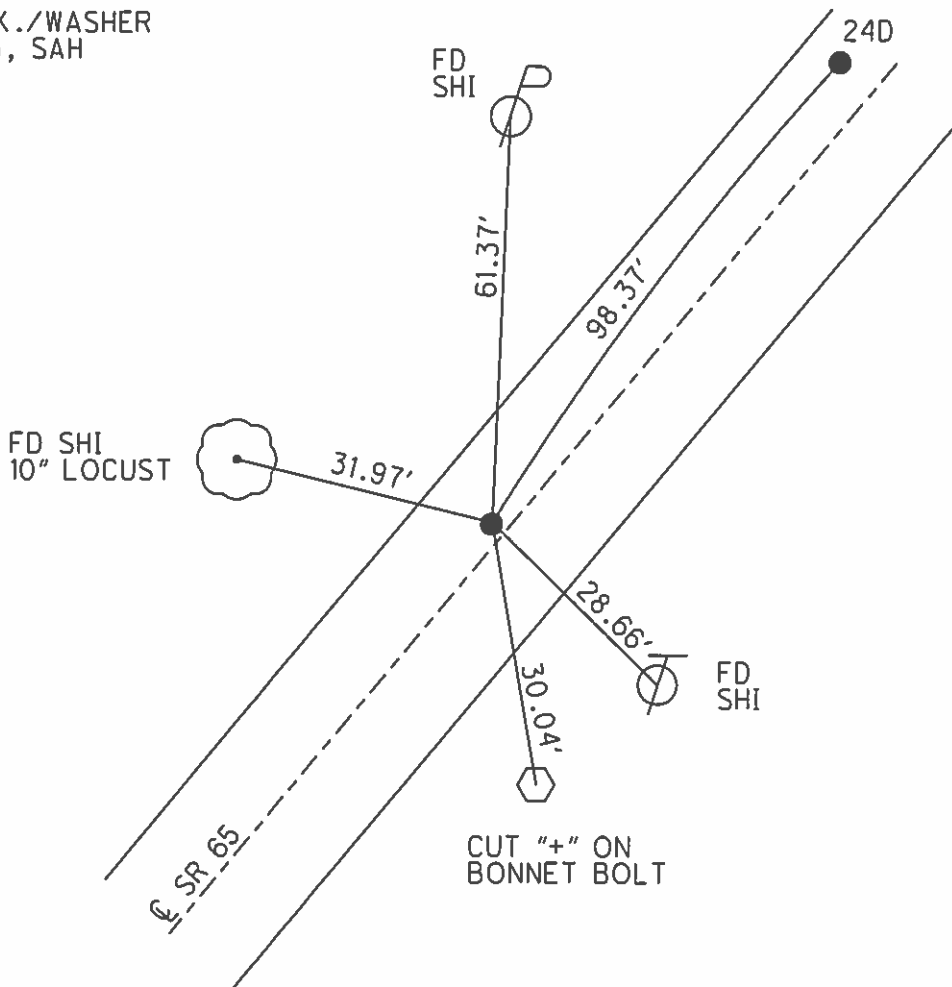

O.D.O.T. DISTRICT 2 SURVEY OFFICE

PERSONNEL _____

REFERENCE NO. _____

SHEET 54 OF 91

NOTES VANAJSEN

H.C. MOSEL

R.C. HUSS

CORRES

DATE 5-23-95

WEATHER SUNNY

TEMP. +80°F

ROUTE SR 65

COUNTY WOOD

TOWNSHIP Perryburg

SECTION R.T. 58 (Willow bend)

T. 7 N R. 10 E

TYPE MONUMENT PK / WASHER (MAG LITE'S)

ON SURFACE - BELOW

LEFT - C PAV'T. - RIGHT A=1.4LT B=5.2LT C=0.5'LT


TO EDGE PAVEMENT

S.L.M. A=740+61.32 B=741+59.72 C=742+57.55

24-D

24-E


24-F

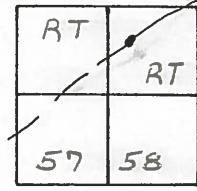

RECORD PTA
FD. SM. RR. SPK @ SURF.
RECORD P.C. 740+61.32
4-18-84

RECORD PT B
FD. SM. RR. SPK @ SURF.
PI=741+59.72
Δ=7°-50'-51" RT

RECORD PTC
FD PK @ SURFACE
P.T. 742+57.55

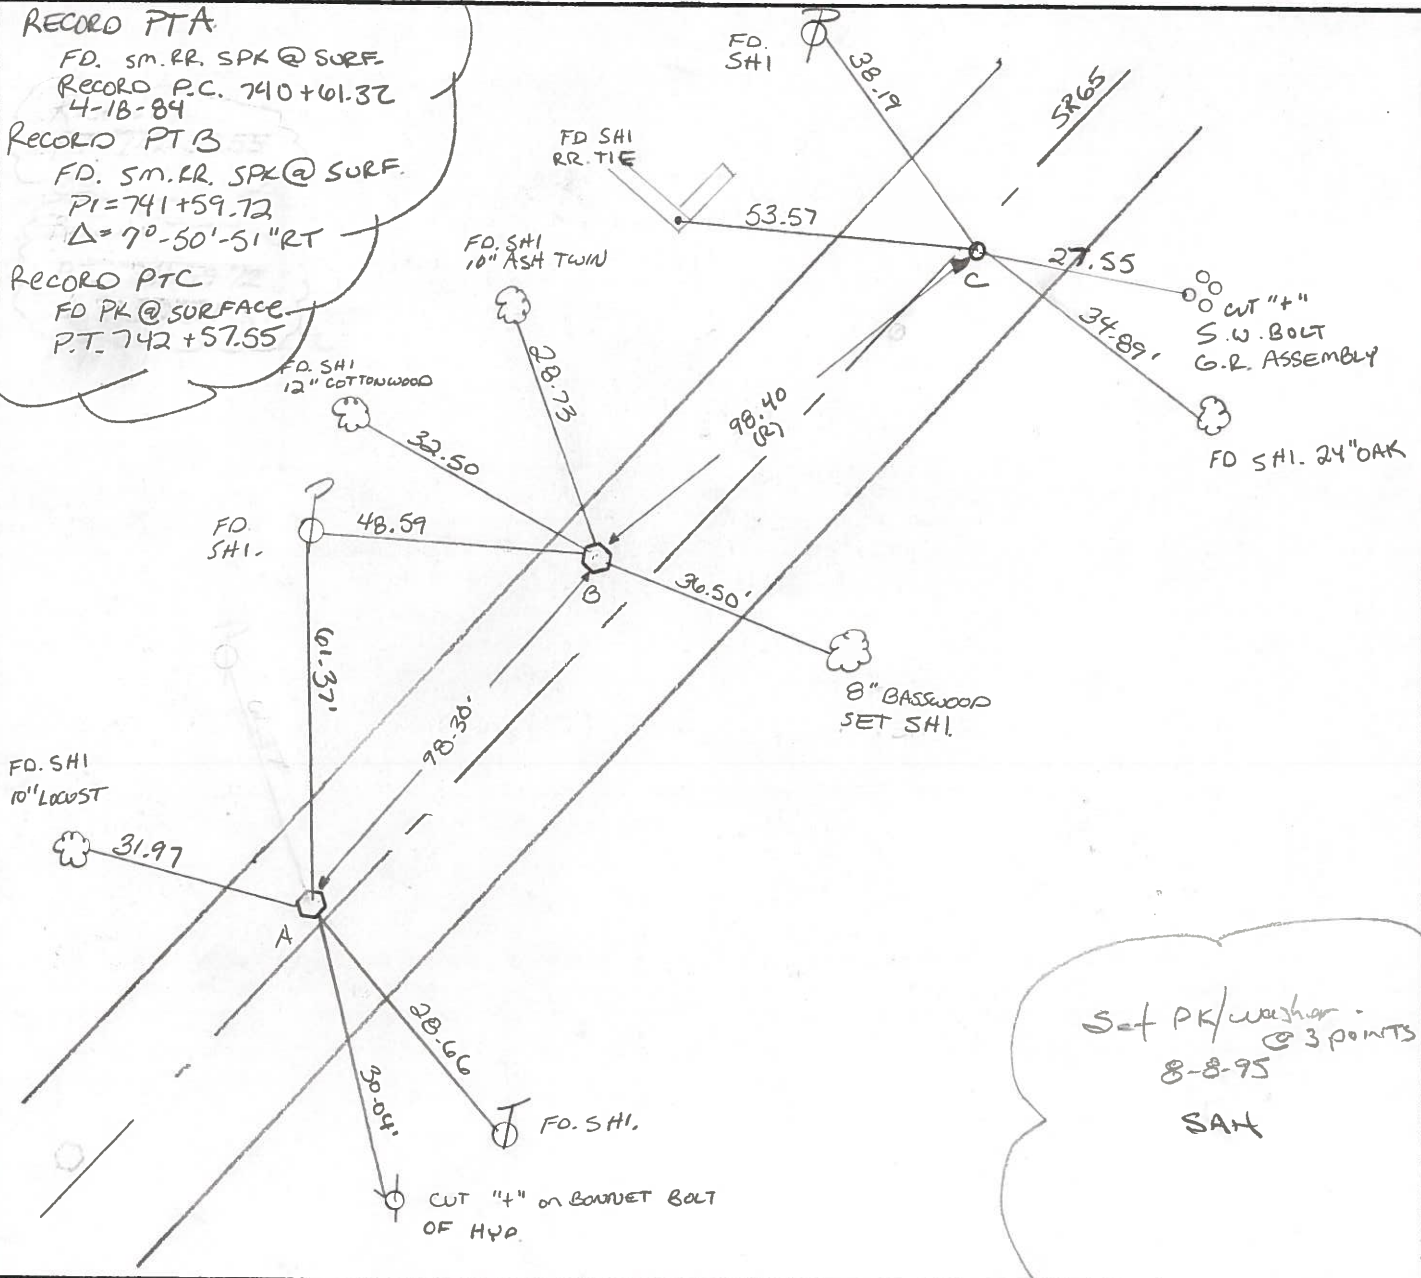

Set PK/washer -
@ 3 points
8-8-95
SAH

County WOOD S.R. 65

Date 11-8-79

Township PERRYSBURG

Weather LT. RAIN


Section _____ (WILLOWBEND SUBDIVISION)

Temp. +40°


T7N, R10E

Personnel BURNSIDE
SMITH
MEAD


24-D
24-E
24-F

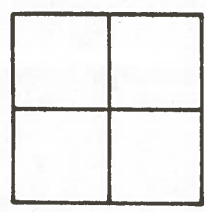

P.T.
 STA. 742+57.55
 FD. P.K. NAIL
 @ SURFACE

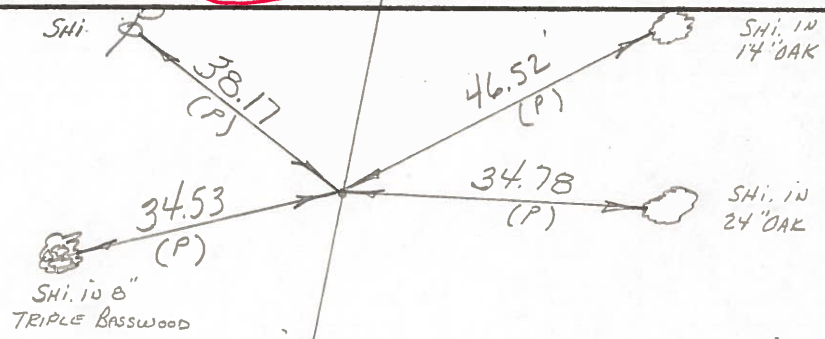

P.I.
 STA. 741+59.72
 Δ = 7° 50' 51" RT.
 FD. SMALL R.R. SPK.
 @ SURFACE

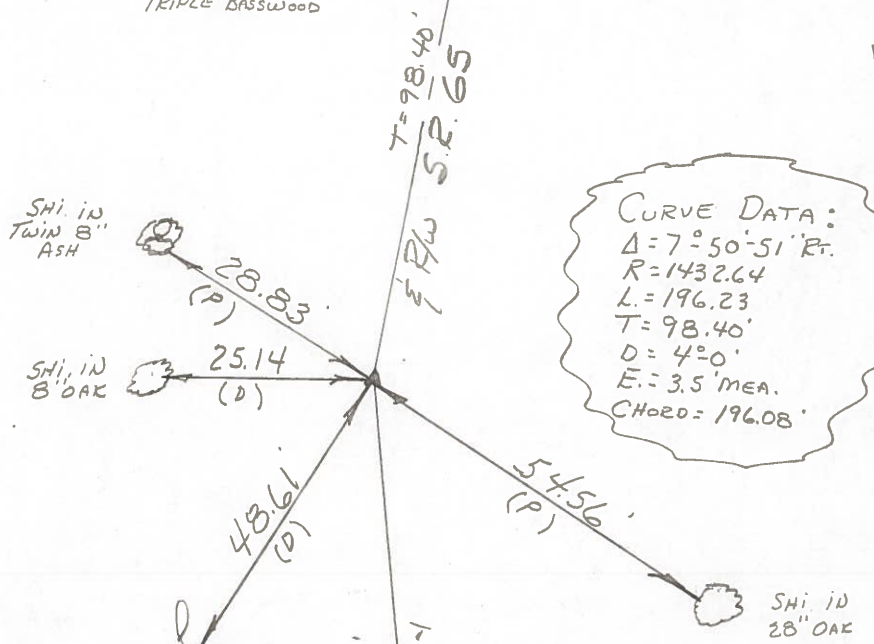

CURVE DATA:
 Δ = 7° 50' 51" RT.
 R = 1432.64
 L = 196.23
 T = 98.40'
 D = 4° 0'
 E = 3.5' MEA.
 CHORD = 196.08'

P.C.
 STA. 740+61.32
 FD. SMALL R.R. SPK.
 @ SURFACE

