


O.D.O.T. DISTRICT 2 SURVEY OFFICE (USE ONLY)

PERSONNEL _____ REFERENCE NO. 24 F SHEET 28 OF 44


NOTES LEU DATE 6/12/14 ROUTE SR 65
 H.C. HOMAN WEATHER CLOUDY COUNTY WOOD
 R.C. WESTFALL TEMP. 72° TOWNSHIP PERRYSBURG
RHOADES SECTION RT 57
T 7 N R 10 E

TYPE MONUMENT P.K./WASHER
 ON SURFACE - ~~BELOW~~ ON _____
 LEFT - ☉ PAV'T - ~~RIGHT~~ 0.5'
9.7' TO RT EDGE PAVEMENT
 S.L.M. 743+67.32

Grid: Northing: 680247.408 Easting: 1640668.101

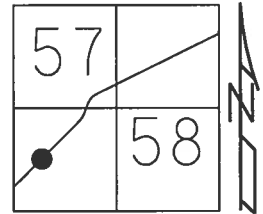


RECORD: P.T.
 STA. 742+57.55
 FD P.K./WASHER
 5/23/95, SAH
 SET P.K./WASHER
 8/8/95, SAH
 FD P.K./WASHER
 REFF24
 9/18/12, SAH
 FD P.K.NAIL
 REFF24
 6/12/14, DCH
 SET MAG/WASHER
 3/16/16, DCH

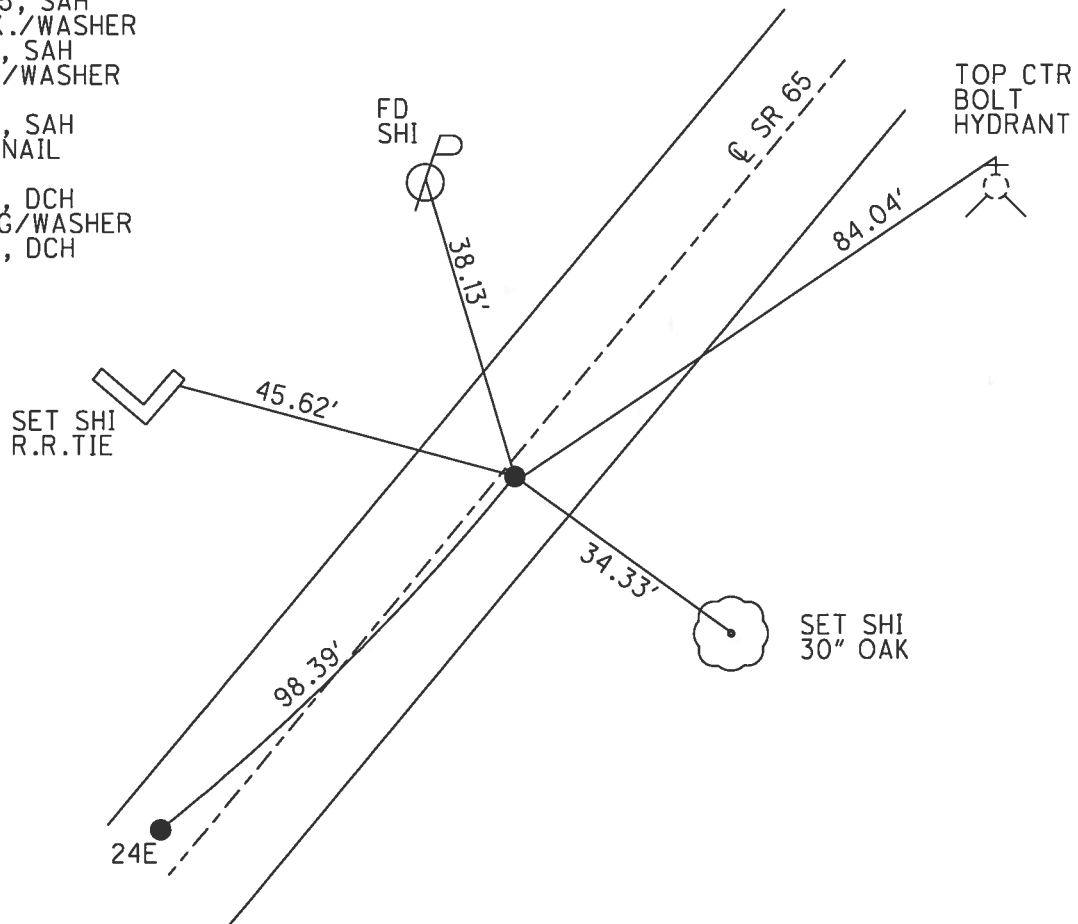

O.D.O.T. DISTRICT 2 SURVEY OFFICE (USE ONLY)

PERSONNEL _____ REFERENCE NO. 24 E SHEET 28 OF 44
 NOTES VAN DUSEN DATE 5/23/95 ROUTE SR 65
 H.C. MOSER WEATHER SUNNY COUNTY WOOD
 R.C. HUSS TEMP. 80° TOWNSHIP PERRYSBURG
CORDES SECTION RT 57
 T 7 N R 10 E


TYPE MONUMENT P.K./WASHER
 ON SURFACE - ~~BELOW~~ ON
~~LEFT~~ - Q PAV'T - RIGHT 0.5'
9.7' TO RT EDGE PAVEMENT
 S.L.M. 743+67.32

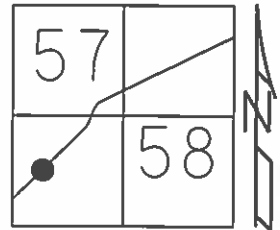

Grid: Northing: 680247.408 Easting: 1640668.101

RECORD: P.T.
 FD P.K.NAIL
 AT SURFACE
 4/18/84

SET P.K./WASHER
 8/8/95, SAH

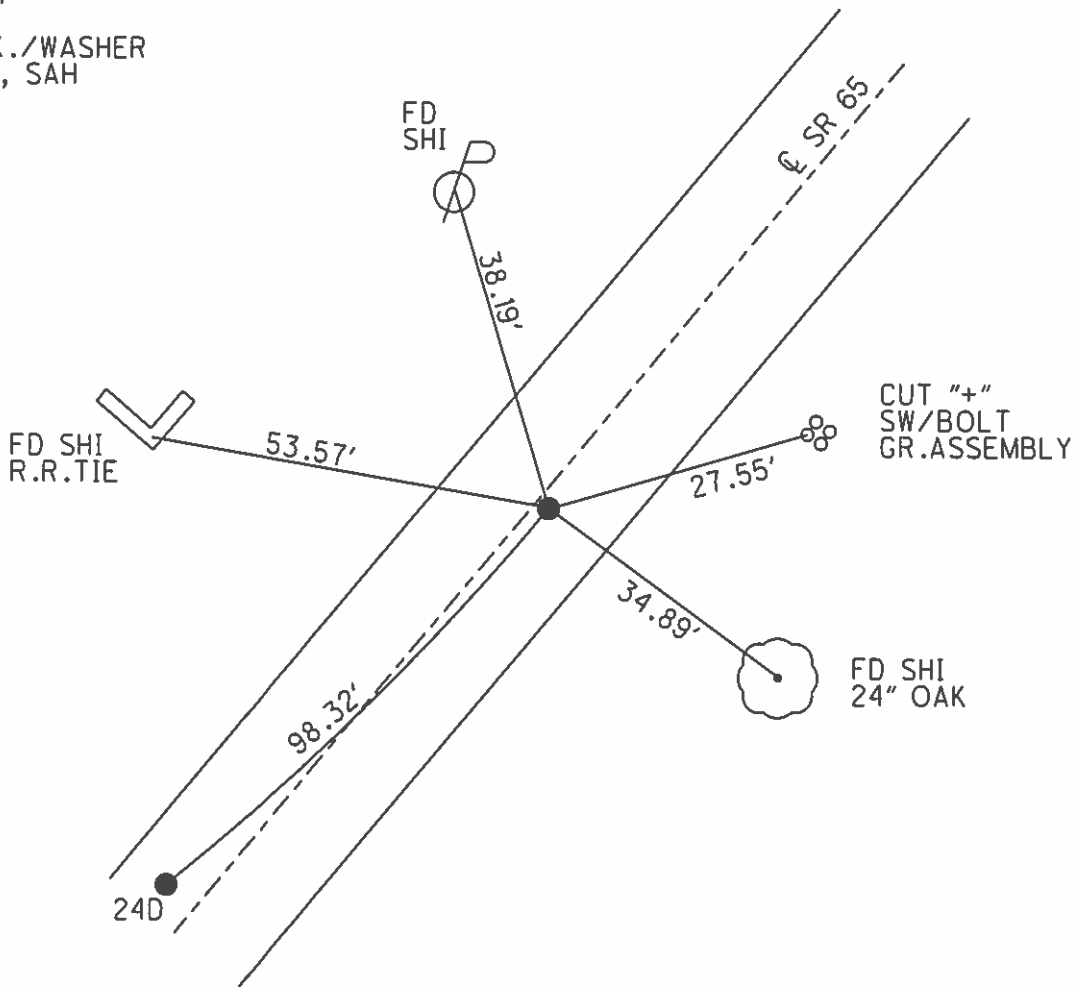

O.D.O.T. DISTRICT 2 SURVEY OFFICE

PERSONNEL _____

REFERENCE NO. _____

SHEET 54 OF 91

NOTES VANOSSEN

H.C. MOSEK

DATE 5-23-95

ROUTE SR 65

R.C. HUSS

WEATHER SUNNY

COUNTY WOOD

CORDES

TEMP. +80°F

TOWNSHIP Perryburg

SECTION R.T. 58 (Willow bend)

T 7 N R 10 E

TYPE MONUMENT PK/WASHER (MAG LITE'S)

ON SURFACE - BELOW

LEFT-C PAV'T. - RIGHT A=1.4LT B=5.2LT C=0.5'LT



TO EDGE PAVEMENT

S.L.M. A=740+61.32 B=741+59.72 C=742+57.55

24-D

24-E

24-F

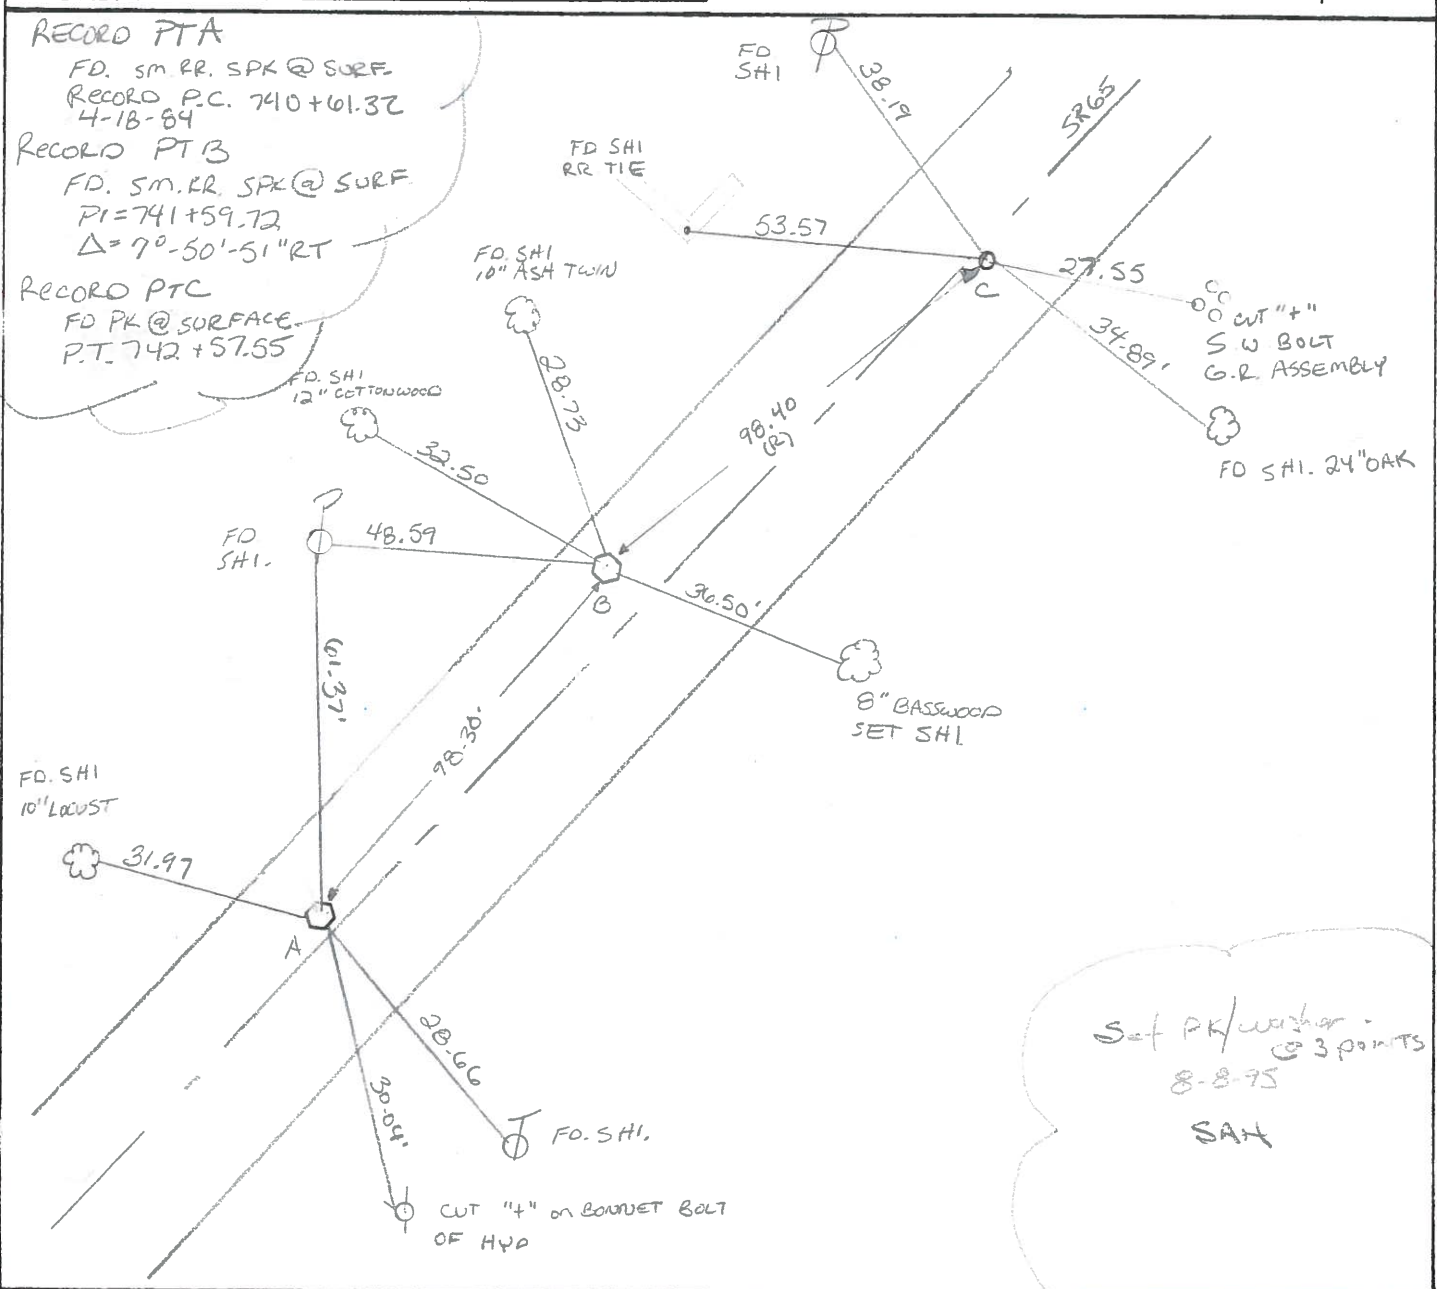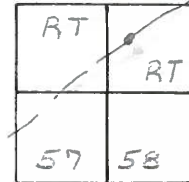

RECORD PTA
 FD. SM. RR. SPK @ SURF.
 RECORD P.C. 740+61.32
 4-18-84

RECORD PT B
 FD. SM. RR. SPK @ SURF.
 PI=741+59.72
 Δ=7°-50'-51" RT

RECORD PTC
 FD PK @ SURFACE
 P.T. 742+57.55

Set PK/washer -
 @ 3 points
 8-8-95
 SAH

County Wood S.R. 65

Date 4-18-84

Township Perrysburg

Weather cloudy

Section R.T. 58 (willow bend)

Temp. 40°

L7N, R10E


Personnel Hoffman
Householder H.C.
Barnhisel R.C.

R.T.	R.T.
57	58



24-D
 24-E
 24-F

Curve Data!
 $\Delta = 7^\circ - 50' - 51''$ RT
 $R = 1432.64$
 $L = 196.23$
 $T = 98.40$
 $D = 4^\circ - 0'$
 $E = 3.5'$ meas 11-79
 Chord: 196.08

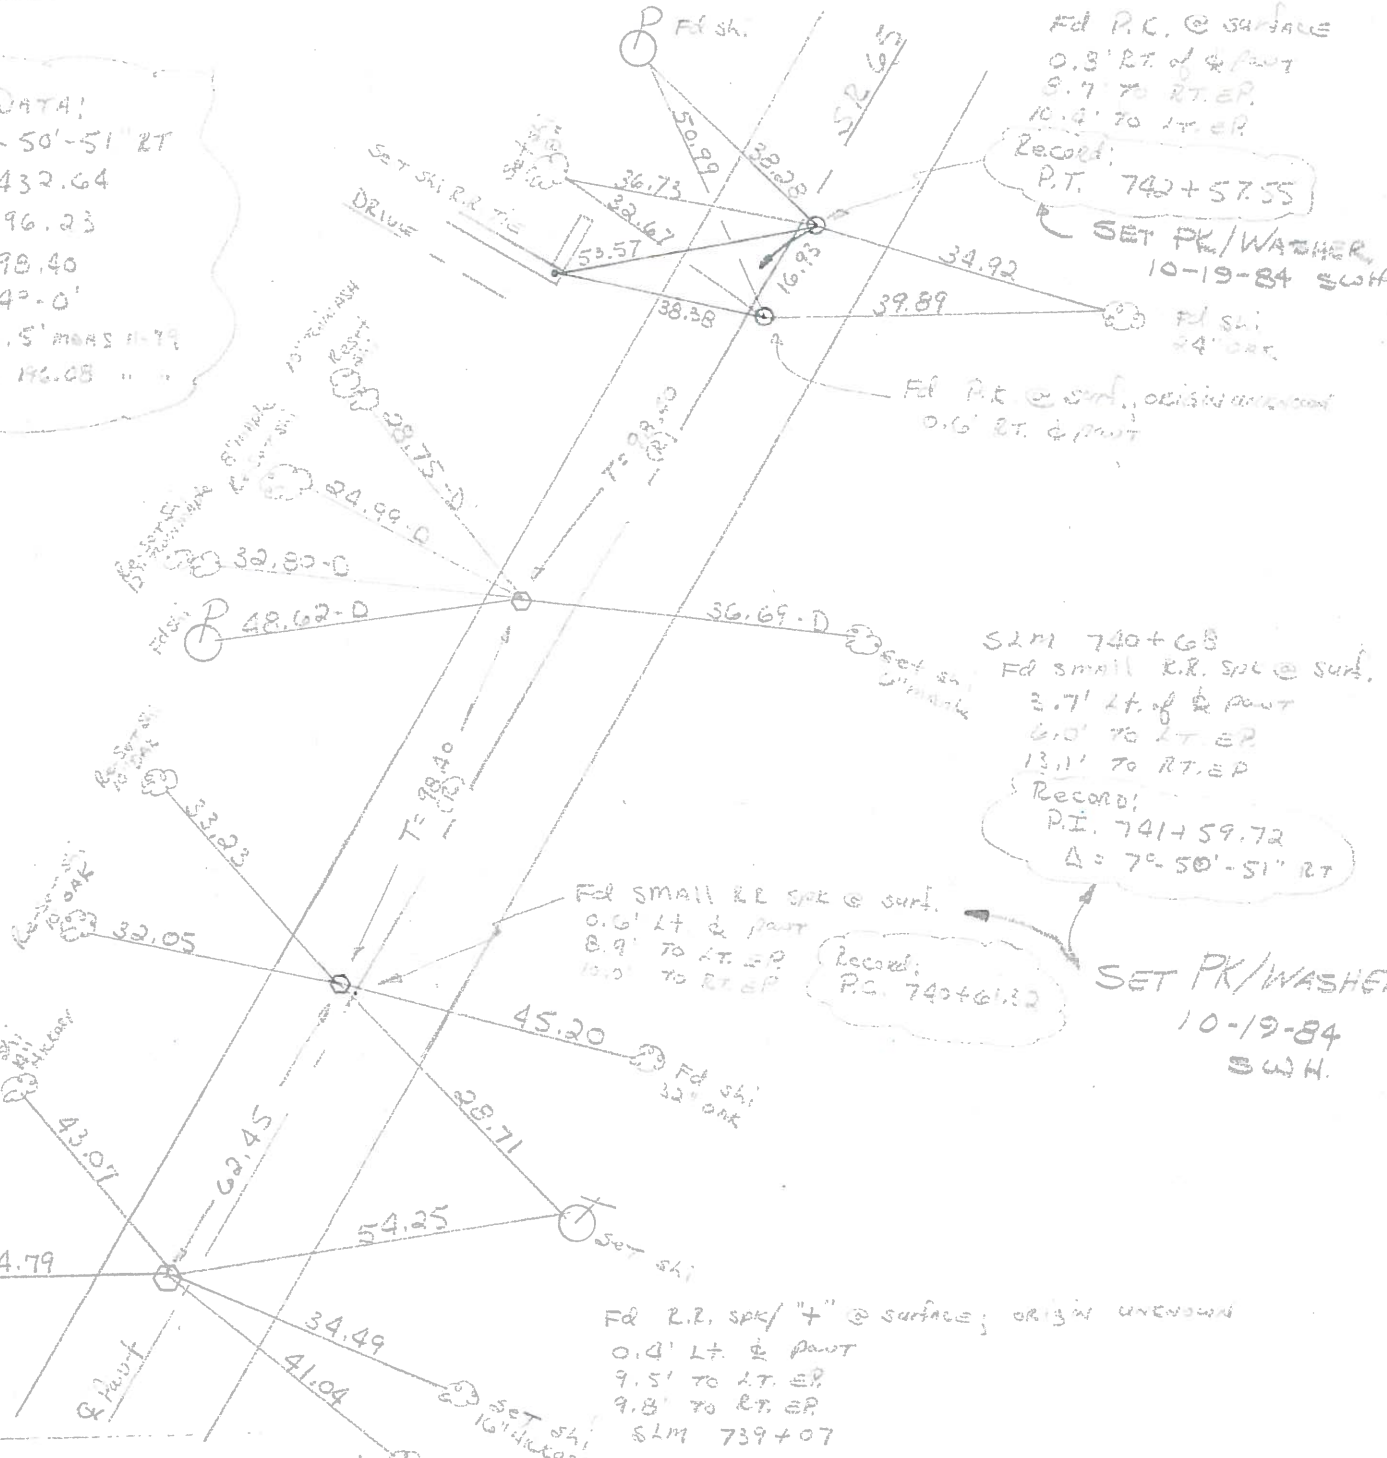

Fd P.C. @ surface
 0.3' RT of & part
 8.7' to RT.EP
 10.4' to LT.EP
 Record!
 P.T. 742+57.55
 SET PK/WASHER
 10-19-84 SWH

SLM 740+68
 Fd small R.R. spk @ surf.
 2.7' Lt. of & part
 6.0' to LT.EP
 13.1' to RT.EP
 Record!
 P.I. 741+59.72
 $\Delta = 7^\circ - 50' - 51''$ RT

Record!
 P.C. 740+61.32
 SET PK/WASHER
 10-19-84 SWH.

Fd R.R. spk/ "T" @ surface; origin unknown
 0.4' Lt. & part
 9.5' to LT.EP
 9.8' to RT.EP
 SLM 739+07


County Wood S.R. 65
 Township PERRYSBURG
 Section _____ (WILLOWBEND SUBDIVISION)

Date 11-8-79
 Weather LT. RAIN
 Temp. +40°

T7N, R10E

Personnel BURNSIDE
SMITH
MEAD


(24-D)
 (24-E)
 (24-F)

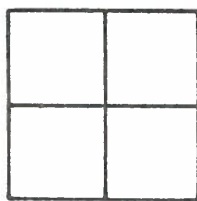

P.T.
 STA. 742+57.55
 FD, P.K. NAIL
 @ SURFACE

P.I.
 STA. 741+59.72
 $\Delta = 7^{\circ}50'51''$ Rt.
 FD, SMALL R.R. SPK.
 @ SURFACE

P.C.
 STA. 740+61.32
 FD, SMALL R.R. SPK.
 @ SURFACE

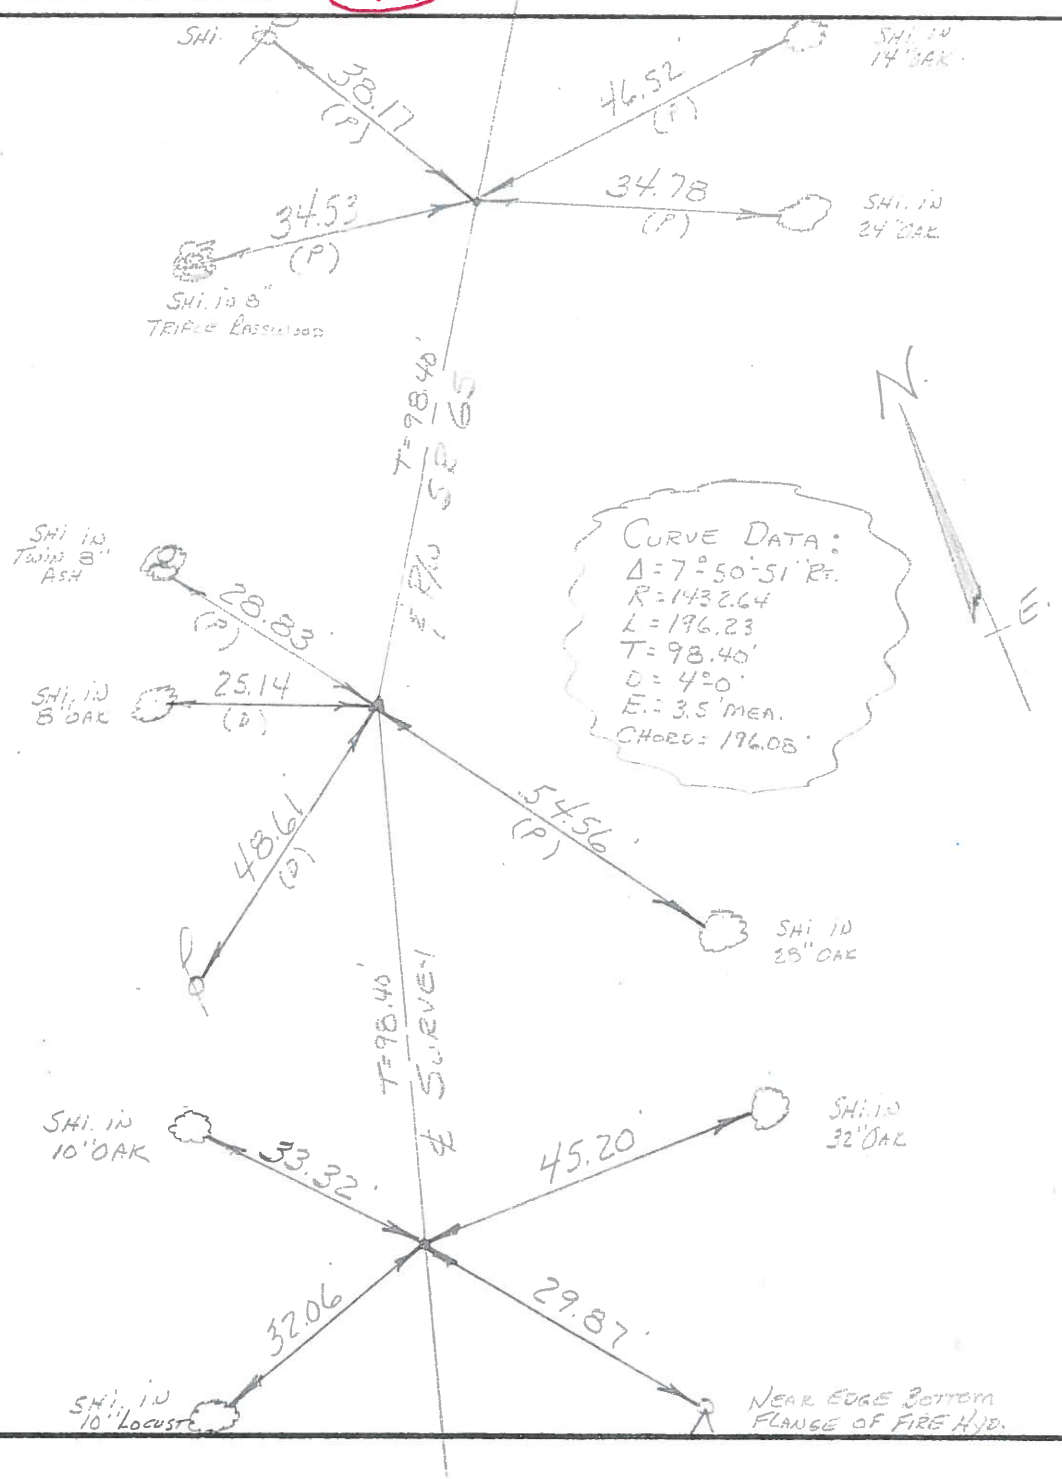

SHI. IN 8" TRIPLE BRASS

SHI. IN TWIN 8" ASH

SHI. IN 8" OAK

SHI. IN 28" OAK

SHI. IN 10" OAK

SHI. IN 32" OAK

SHI. IN 10" LOCUST

NEAR EDGE BOTTOM FLANGE OF FIRE HYD.