

O.D.O.T. DISTRICT 2 SURVEY OFFICE (USE ONLY)

PERSONNEL _____ REFERENCE NO. 241 SHEET 32 OF 44

NOTES HOMAN DATE 6-18-14 ROUTE SR 65
 H.C. HOMAN WEATHER CLOUDY COUNTY WOOD
 R.C. THOMAS TEMP. 90°F TOWNSHIP PERRYSBURG
 _____ SECTION RT 57
 _____ T 7 N R 10 E

TYPE MONUMENT RR. SPIKE


~~ON SURFACE~~ - BELOW 4"

LEFT - ☉ PAV'T - RIGHT ON


10.8 TO LT EDGE PAVEMENT

S.L.M. 758+67.92

Grid: Northing: 681541.408 Easting: 1641395.731

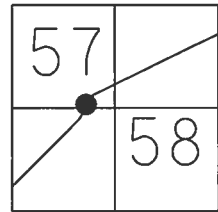

RECORD:
 SLM 756+67
 FD R.R.SPIKE
 SET PK/WASHER
 10-19-84, SWH
 SET PK/WASHER
 8-8-95, SAH
 FD P.K./WASHER
 9/19/12, SAH
 FD P.K./WASHER
 REF124
 6-18-14
 SET MAG/WASHER
 08-03-2015, JLL

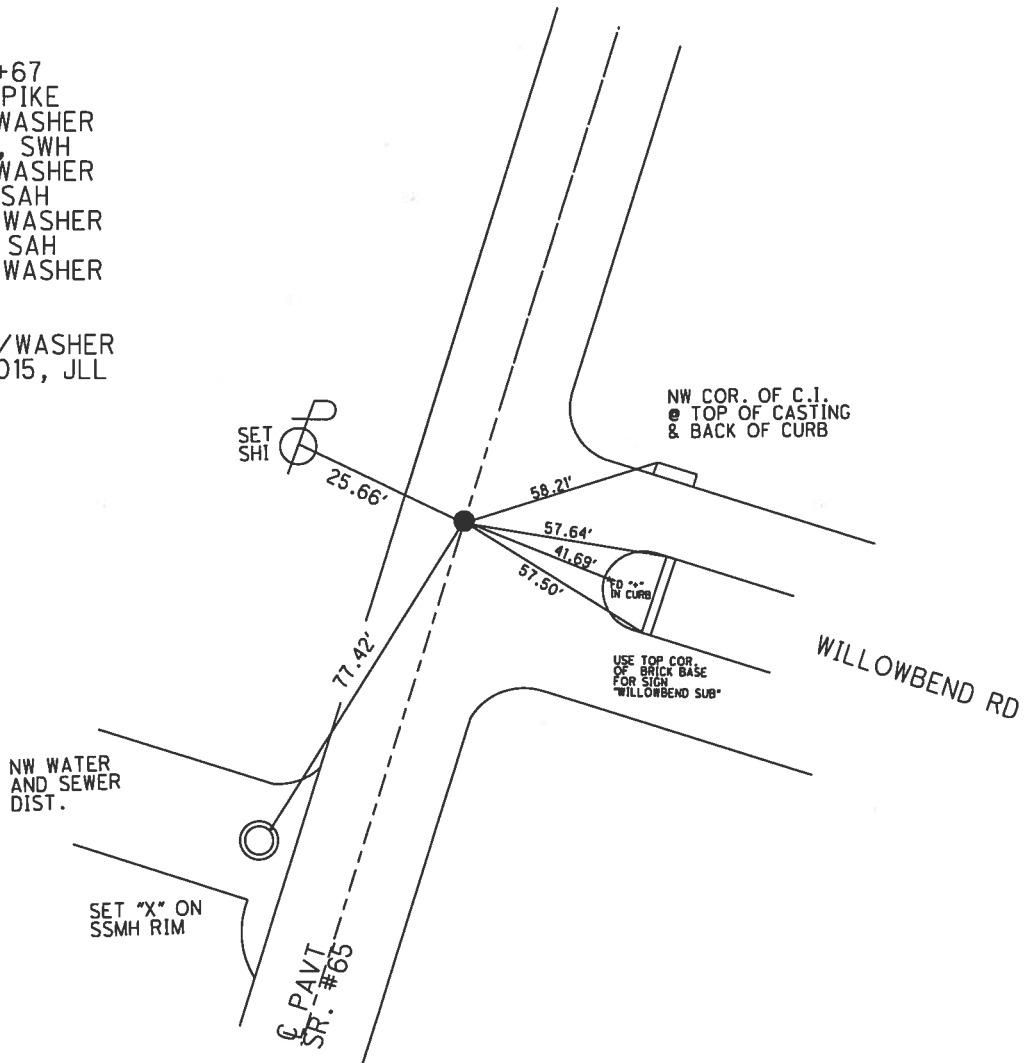

O.D.O.T. DISTRICT 2 SURVEY OFFICE

PERSONNEL _____

REFERENCE NO. _____

SHEET 58 OF 91

NOTES VADUSEN

H.C. MOSEK

DATE 5-23-95

ROUTE SR-65

R.C. CORDES

WEATHER SUNNY

COUNTY Wood

HUSS

TEMP. +80°F

TOWNSHIP Perrysburg

SECTION RT-58

T 7 N R 10 E

TYPE MONUMENT PK/WASHER


ON SURFACE - BELOW

~~LEFT~~ - PAV'T. - RIGHT

10.8 TO LT EDGE PAVEMENT

S.L.M. 756+67


24-1

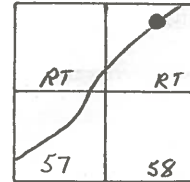

Record:
S.L.M. 756+67
Fd RR spk. @ surface
on E Pav.

Set PK/Washer
10-19-84
S.W.H.

SET PK/WASHER
8-8-95
SAH

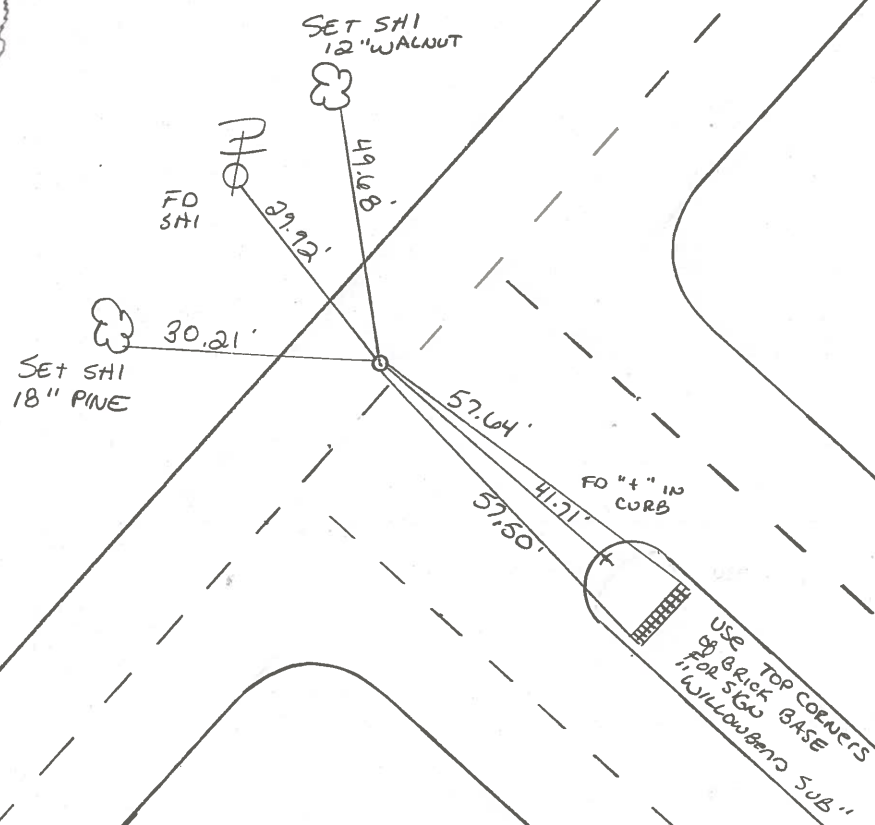

USE TOP CORNERS
OF BRICK BASE
FOR SIGS
W/LOWLAND SUB"

County WOOD S.R. 65

Date 4-24-84

Township PERRYSBURG

Weather OVERCAST


Section R.T. 58 Willowbend Sub.

Temp. 45°

T1N, R10E

Personnel HOFFMAN
HOUSEHOLDER H.C.
BARANISEL P.C.

24-I

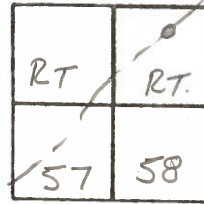

SET P.K./WASHER
 10-19-84
 S.W.H.

SLM = 756+67

Fd. P.K. SPK @ SURFACE; SET BY H. FREY
 ON ~~SPK~~ & PAWT TO LT. EP.
 FARAHAM, WIRKES & BERNING
 FOR Willowbend Sub.

