


O.D.O.T. DISTRICT 2 SURVEY OFFICE (USE ONLY)

PERSONNEL _____ REFERENCE NO. 24 Q SHEET 34 OF 44


NOTES HOMAN DATE 6-23-14 ROUTE SR 65
 H.C. LEU WEATHER SUNNY COUNTY WOOD
 R.C. THOMAS TEMP. 70°F TOWNSHIP PERRYSBURG
 _____ SECTION RT 58
 _____ T 7 N R 10 E

TYPE MONUMENT PK/WASHER
 ON SURFACE - ~~BELOW~~ ON _____
 LEFT - ☉ PAV'T - ~~RIGHT~~ 8.4'
1.2' TO LT EDGE PAVEMENT
 S.L.M. 770+19.50

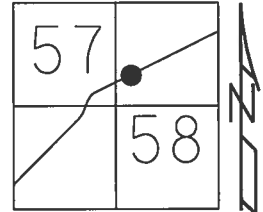

RECORD:

- STA. 768+18
- FD PK NAIL
- 1984
- SET PK/WASHER
- 10-19-84, SWH
- FD P.K./WASHER
- 5/23/95, SAH
- SET PK/WASHER
- 8-8-95, SAH
- FD P.K./WASHER
- REFQ24
- 9/19/12, SAH
- 6-23-14, JLL
- SET MAG/WASHER
- 08-03-15, JLL

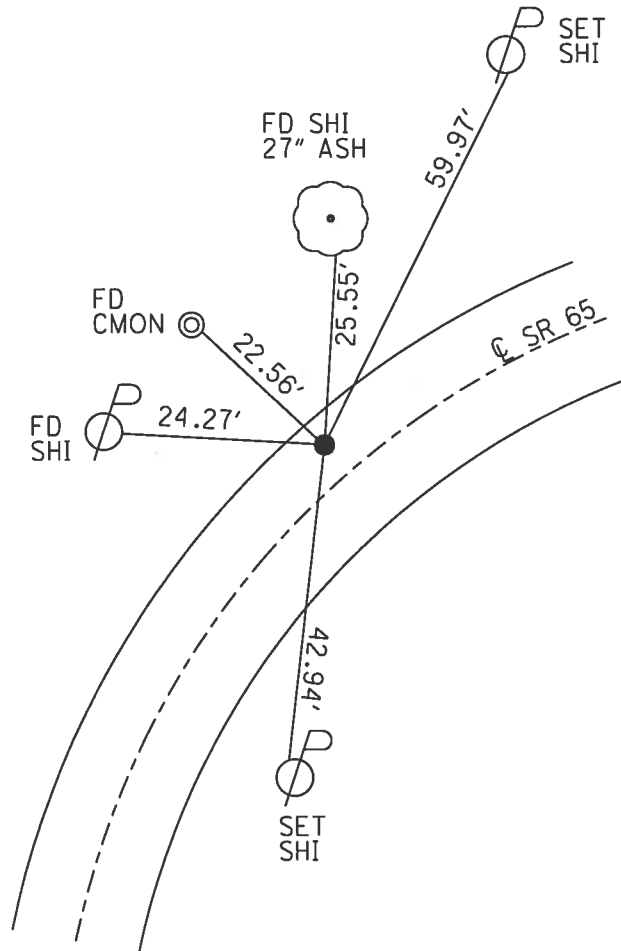

Grid: Northing: 682551.508 Easting: 1641931.242

O.D.O.T. DISTRICT 2 SURVEY OFFICE

PERSONNEL _____

REFERENCE NO. _____

SHEET 62 OF 91

NOTES VANDUSEN

H.C. MOSEK

DATE 5-23-95

ROUTE SR-65

R.C. CORDES

WEATHER Sunny

COUNTY Wood

HUSS

TEMP. +80°F

TOWNSHIP Perrysburg

SECTION RT-59

T 7 N R 10 E

TYPE MONUMENT PK WASHER


ON SURFACE - ~~BELOW~~

LEFT- ~~E~~ PAV'T. - RIGHT 8.4 LT


1.2 TO LT EDGE PAVEMENT

S.L.M. 768+15

24-Q

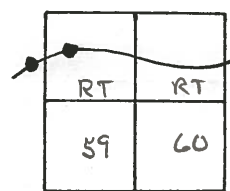

Record:
 Fd PK at surface
 8.4' Lt of E Pav.
 1.0' to Lt E.P.
 17.8' to Rt E.P.
 Set PK/Washer
 10-19-84
 S.W.H.

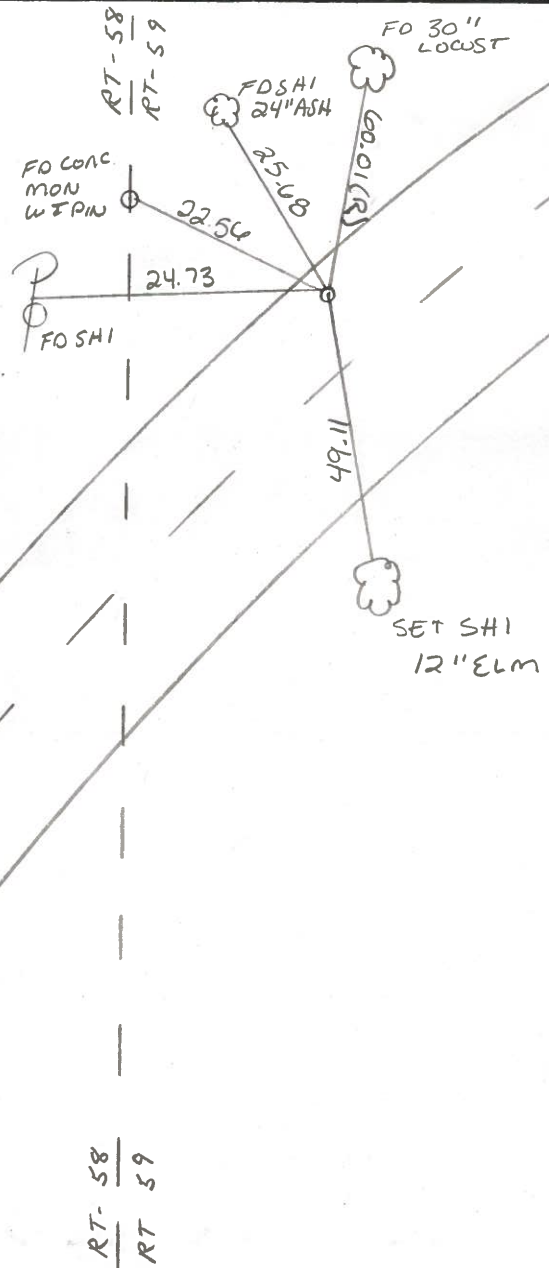

SET PK/WASH.
 8-8-95
 SAH

SR-65
 E Pav

RT-58
 RT-59

SET SH1
 12" ELM

County WOOD S.R. 65

Date 4-24-84

Township PERRYSBURG

Weather OVERCAST

Section R.T. 59

Temp. 45°

TZN, R10E

Personnel HOFFMAN

HOUSEHOLDER H.C.

BARNHISEL R.C.

24-Q

RT	RT
59	60



Fd P.K. @ SURFACE

8.4' LT. of & PAWT

1.0' TO LT. CP

17.8' TO RT. CP


+

SET PK/WASHER

10-19-84

S.W.H.

SLM = 768+15

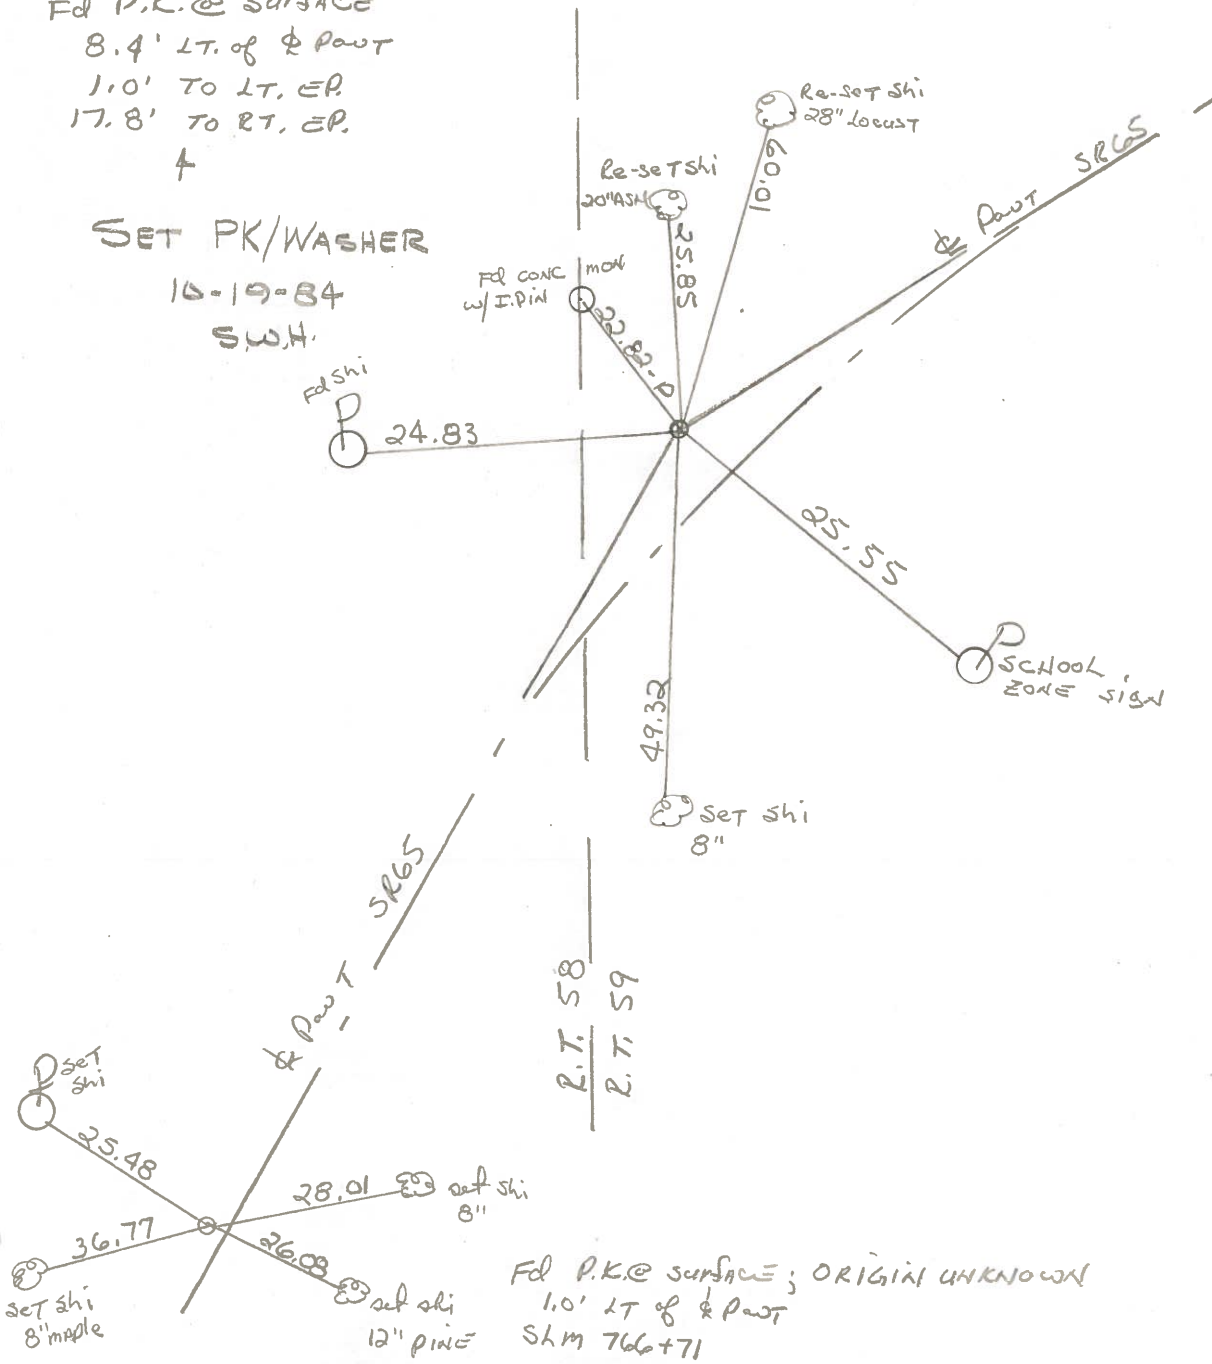

Fd P.K. @ SURFACE; ORIGINAL UNKNOWN
 1.0' LT of & PAWT
 SLM 766+71

County WOOD S.R. 65

Date 7-24-80

Township PERRYSBURG

Weather _____

Section _____



Temp. _____

T N, R E

Personnel SMITH

BOWERS


24-Q

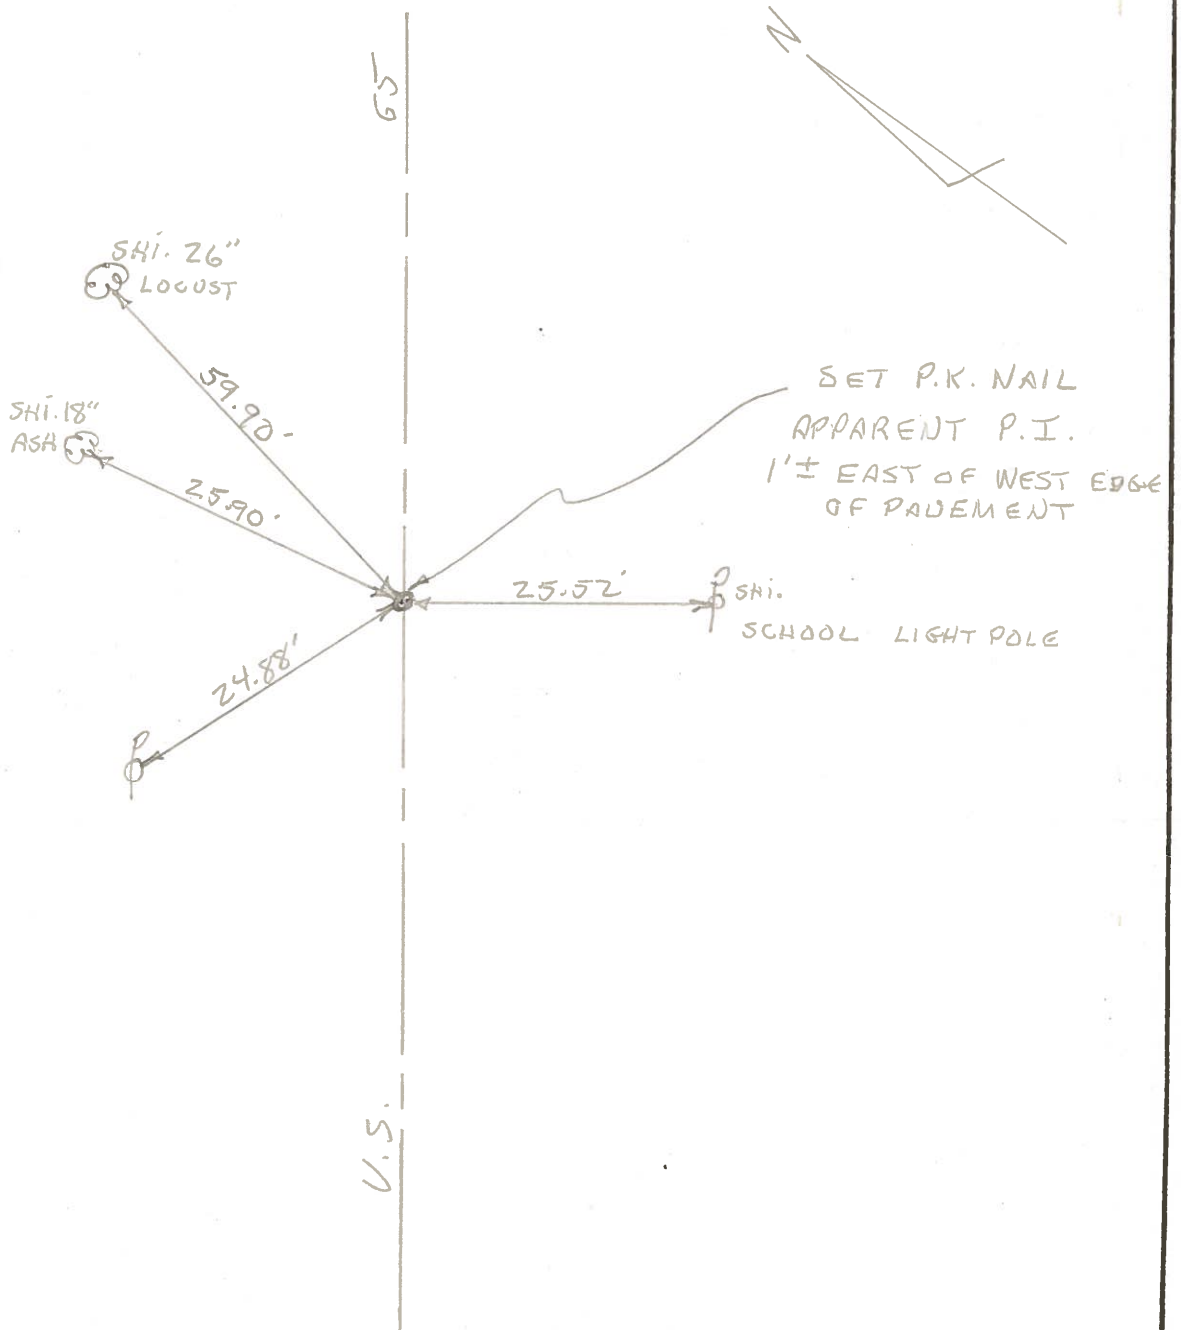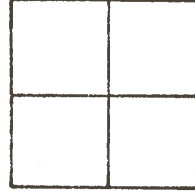

PERSONNEL TITLE PERSONNEL TITLE
BURNSIDE _____
SMITH _____
BOWERS _____
SARDEJA E.I.T. _____


COUNTY WOOD DATE 4-29-71
 S. R. #65 WEATHER CLEAR
 SEC. PERRYSBURG TWP TEMP. +52°

DESCRIPTION CONTROL POINTS JOB NO. _____
 LEFT CENTER LINE RIGHT

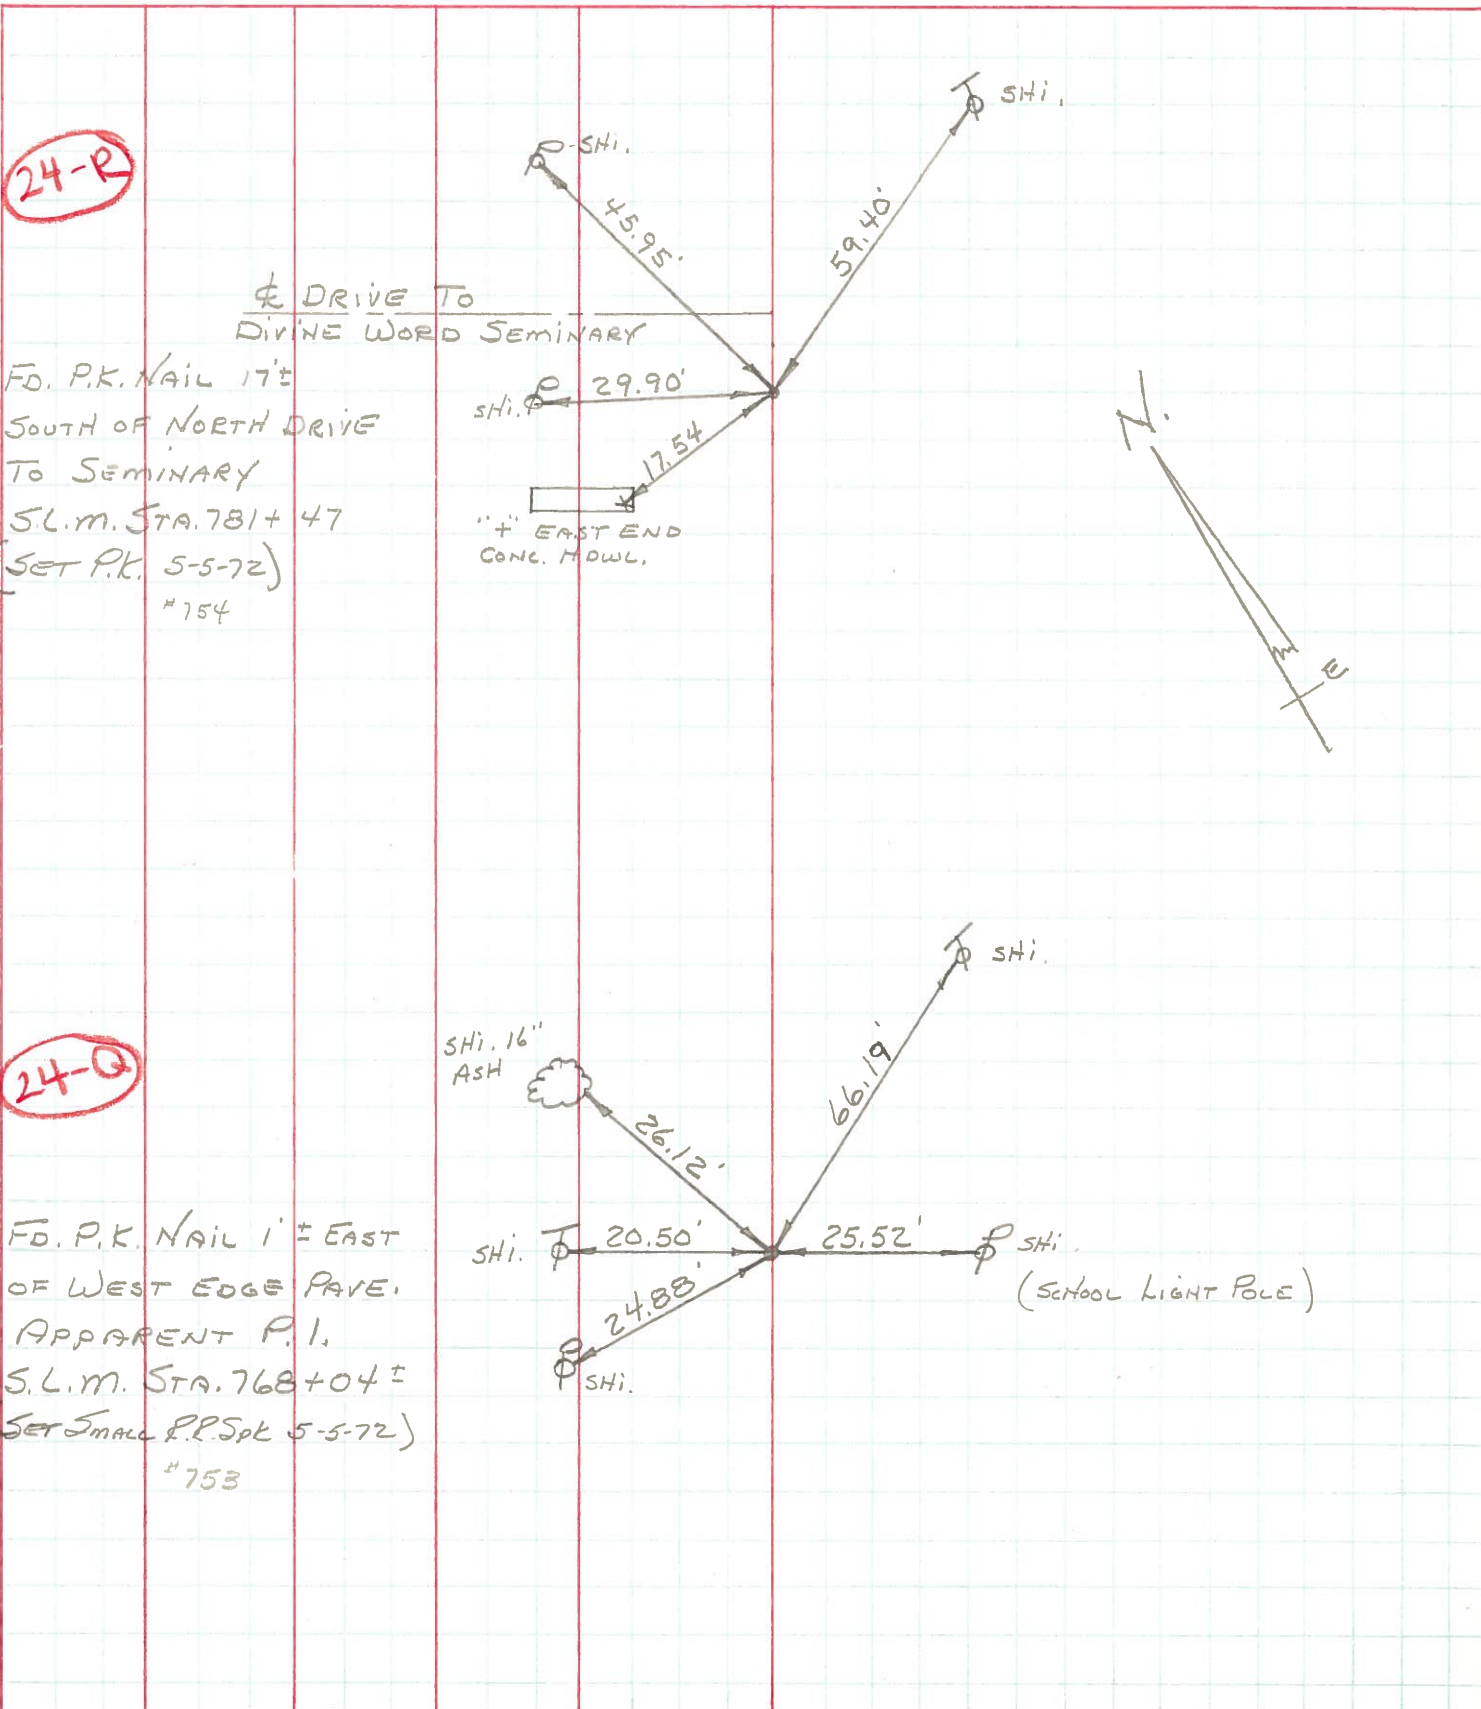

SK
 4-19-72

OK
 4-19-72

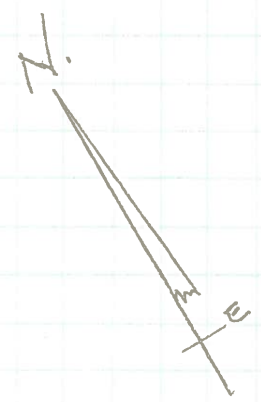

PERSONNEL	TITLE	PERSONNEL	TITLE
Delventhal			
Young			

COUNTY Wood DATE 8-18-60
 S. R. 65 WEATHER Clear
 SEC. 11.96-17.65 TEMP. 80's


DESCRIPTION _____ CONTROL POINTS _____ JOB NO. _____
 LEFT CENTER LINE RIGHT

24-Q

#753

Shiner in Twin 16" "Tree"?

Shiner in P

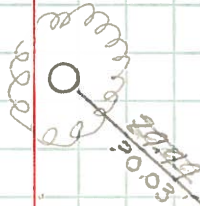

66.16
66.08
66.14

OK-2-23-66

Placed PK 12-5-60

Found Small RR spike
 5100' (approx.) N. of
 Roachton Rd. 1 \pm in
 from E. edge of part.

Shiner in P

24-R

#754

Shiner in P

E drive to Divine Word Seminary

Chiseled "X" in E end of retaining wall

45.95

17.56

60.74

OK-2-23-66

Placed PK 12-5-60

Found Iron rod
 17' \pm S. of E drive
 to Divine Word Seminary
 (on E SR 65)

Shiner in P