



O.D.O.T. DISTRICT 2 SURVEY OFFICE (USE ONLY)

PERSONNEL _____ REFERENCE NO. 24 R SHEET 35 OF 44
 NOTES HOMAN DATE 6-23-14 ROUTE SR 65
 H.C. LEU WEATHER SUNNY COUNTY WOOD
 R.C. THOMAS TEMP. 70°F TOWNSHIP PERRYSBURG
 _____ SECTION RT 58
 _____ T 7 N R 10 E

TYPE MONUMENT P.K.NAIL
~~ON SURFACE~~ - BELOW 4"
 LEFT - ℄ PAV'T - ~~RIGHT~~ 1.0'
9.3' TO LT EDGE PAVEMENT
 S.L.M. 783+62.89
 Grid: Northing: 683536.548 Easting: 1642844.690

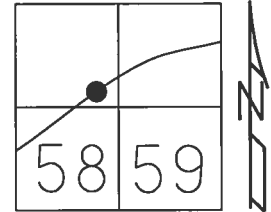

RECORD:
 STA.781+58
 FD PK NAIL
 1984
 SET PK/WASHER
 10-19-84, SWH
 FD P.K./WASHER
 5/23/95, SAH
 SET PK/WASHER
 8-8-95, SAH
 FD P.K./WASHER
 REFQ24
 9/19/12, SAH
 FD P.K.NAIL
 0.4' DOWN
 REFR24
 6-23-14, JLL
 SET MAG/WASHER
 08-03-15, JLL

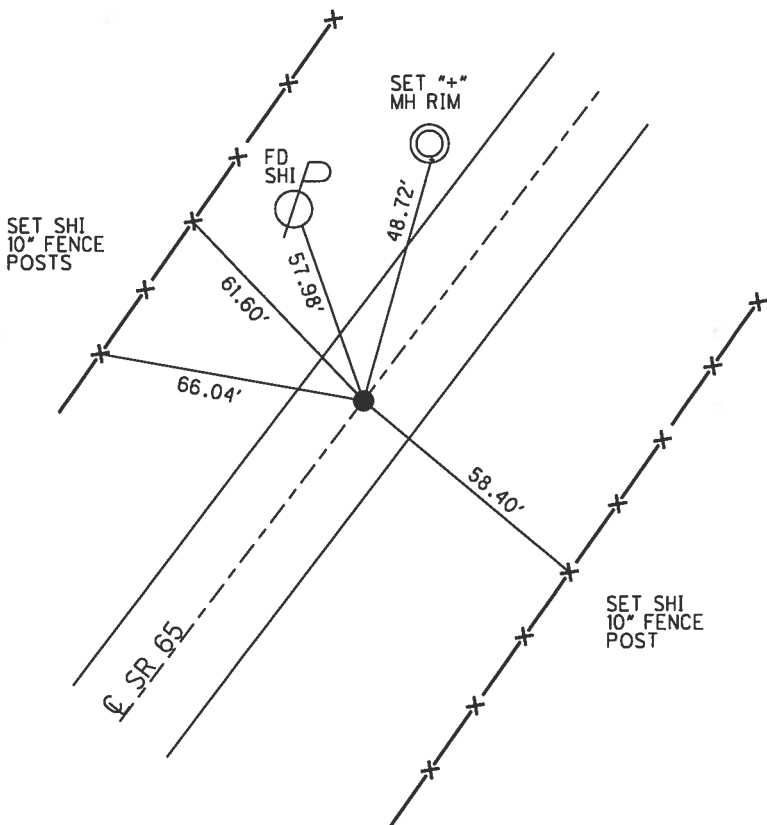

O.D.O.T. DISTRICT 2 SURVEY OFFICE

PERSONNEL _____

REFERENCE NO. _____

SHEET 63 OF 91

NOTES VANDUSEN

H.C. MOSEB

DATE 5-23-95

ROUTE SR-65

R.C. CORDES

WEATHER Sunny

COUNTY Wood

RUSS

TEMP. +80°F

TOWNSHIP Perrysburg

SECTION RT-59

T 7 N R 10 E

TYPE MONUMENT PK/WASHER


ON SURFACE - ~~BELOW~~ _____

LEFT- ~~PAV'T. - RIGHT~~ 1.0 LT

9.3 TO LT EDGE PAVEMENT

S.L.M. 781+58

24-R

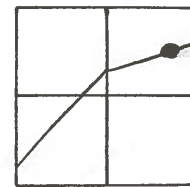


Record:
Fd PK Nail @ surface
1.0' Lt of & pav.
8.9' to Lt E.P.
10.7' to Rt E.P.
± 17' South of N. Drive

Set PK/Washer
10-19-84
S.W.H.

Record:
Crosscuts on East
Ends of Headwalls

SET PK/WASHER
8-8-95
SAH

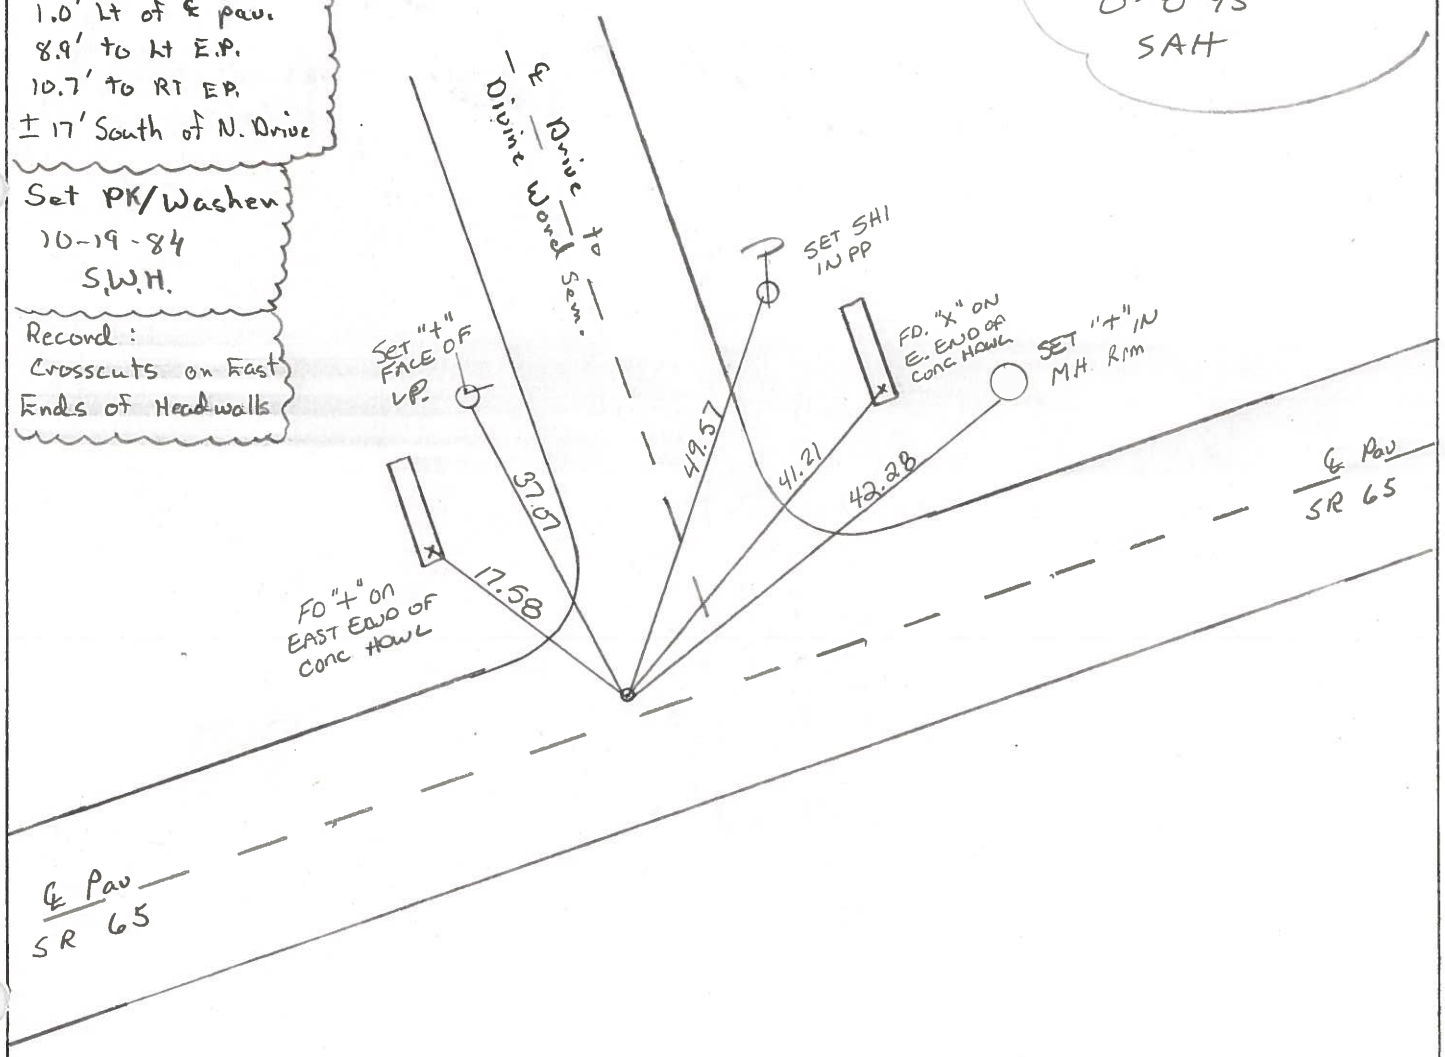

County WOOD S.R. 65

Date 5-9-84

Township PerrysBURG

Weather OVERCAST


Section RIVER TRACT 59

Temp. 40°

T7N, R10E

Personnel HOFFMAN
HOUSEHOLDER H.C.
BARNHISEL R.C.

24-R

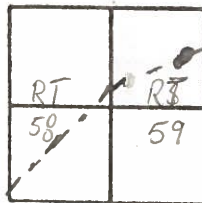

Fcl P.K. Nail @ surface


SLM 781+58

- 1.0' LT. of & part
- 8.9' to LT. EP
- 10.7' to RT. EP

SET PK/WASHER

10-19-84
S.W.H.

± 17' SOUTH of NORTH DRIVE

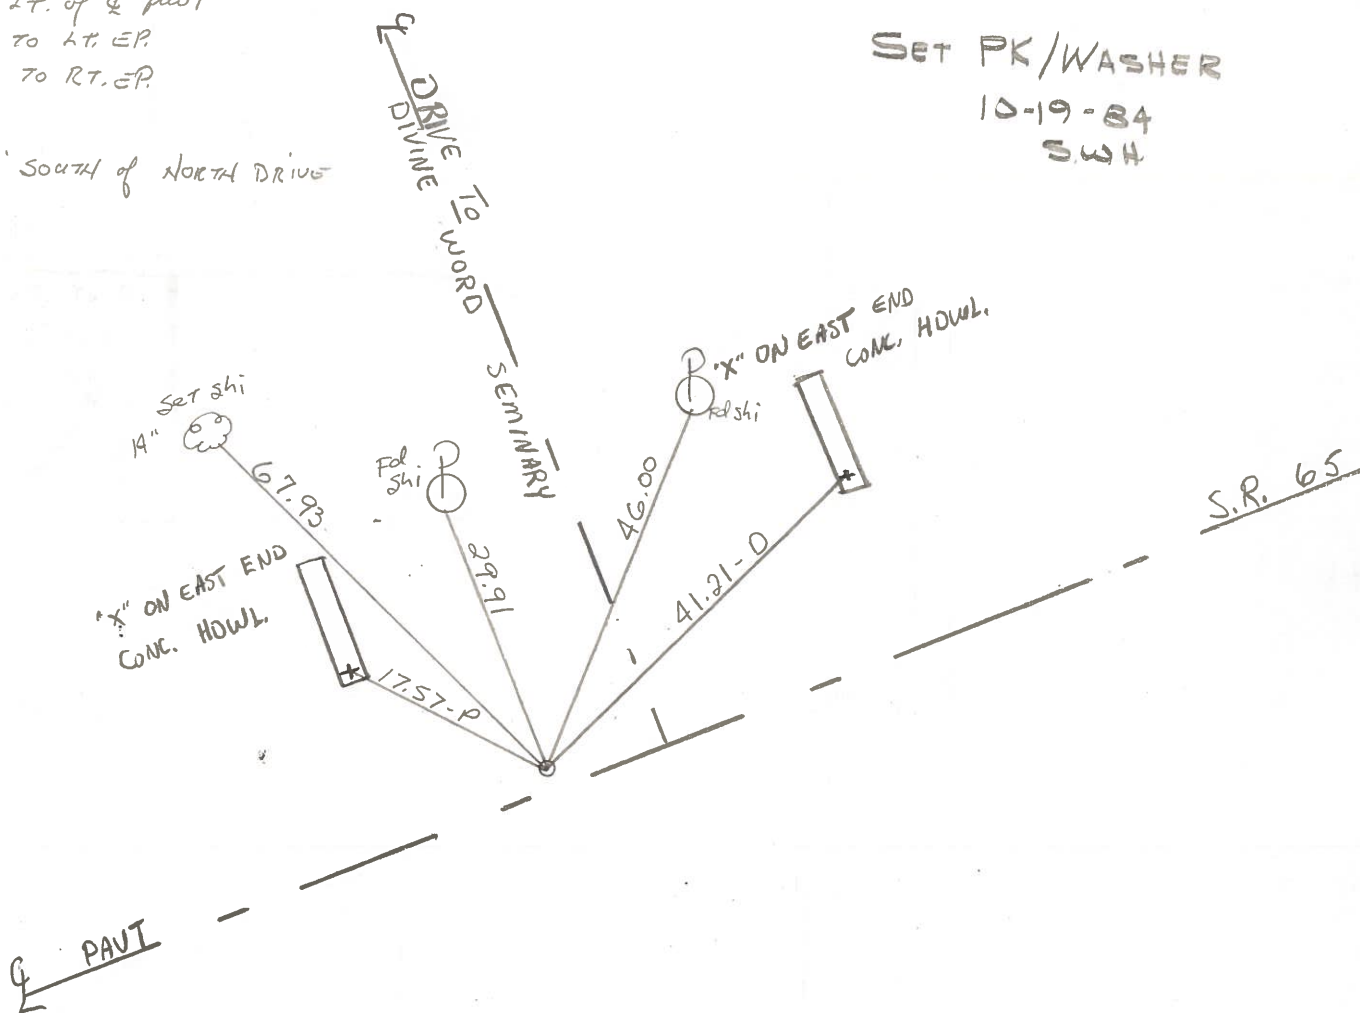

County Wood S.R. 65

Date 4-24-84

Township Perrysburg

Weather OVERCAST

Section R.T. 58

Temp. 45°

T7N, R10E


Personnel HOFFMAN
HOUSEHOLDER H.C.
BARNHISEL P.C.

RT	RT
57	58



DID NOT RESET

SLM = 765+49
 Fd P.K. @ surf.
 ORIGIN UNKNOWN
 ON & PAWT
 TO LT. EP.
 TO RT. EP

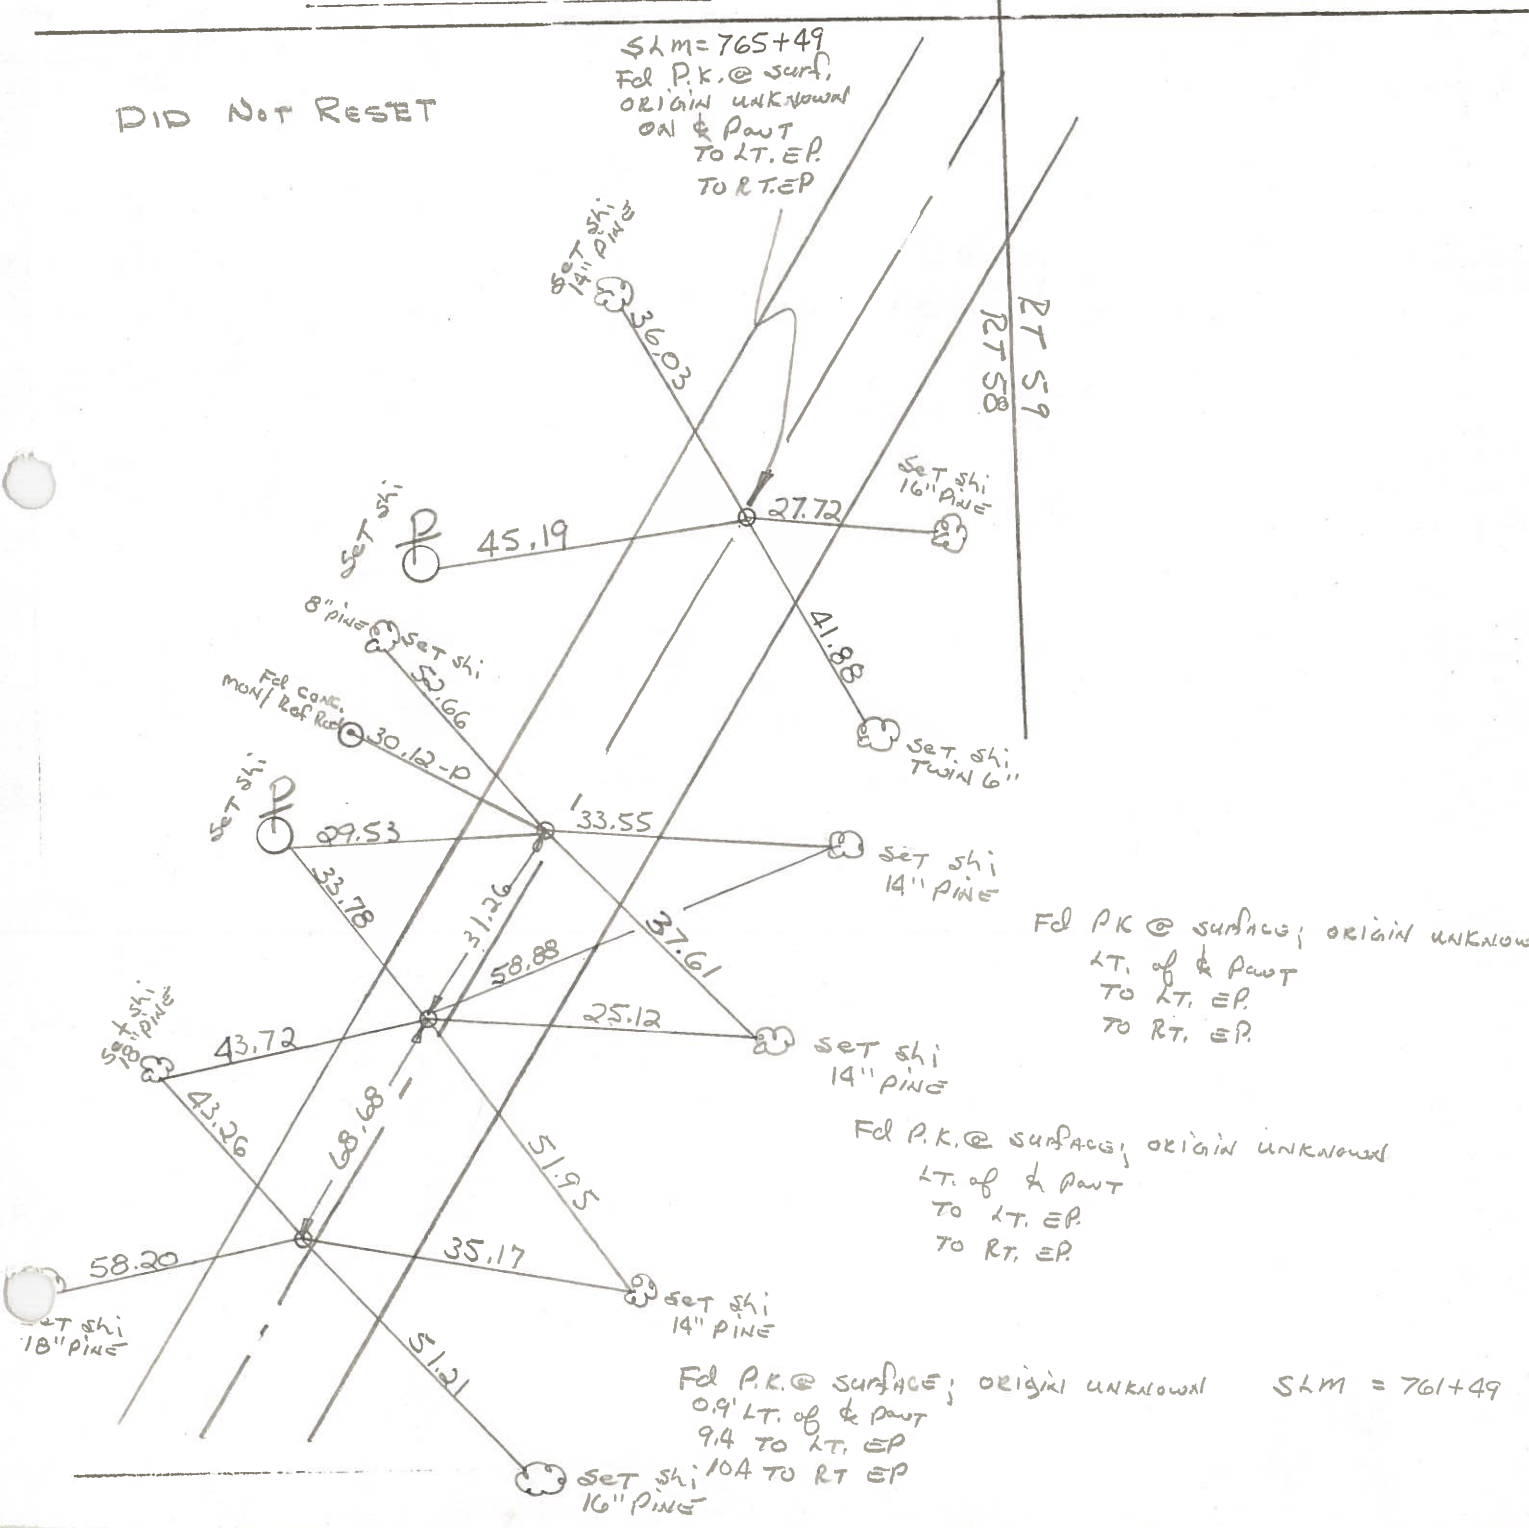

Fd P.K. @ surface; origin unknown
 LT. of & PAWT
 TO LT. EP.
 TO RT. EP.

Fd P.K. @ surface; origin unknown
 LT. of & PAWT
 TO LT. EP.
 TO RT. EP.

Fd P.K. @ surface; origin unknown
 0.9' LT. of & PAWT
 9.4 TO LT. EP
 10.4 TO RT EP
 SLM = 761+49

County WOOD S.R. 65

Date 7-24-80

Township PERRYSBURG

Weather _____

Section _____



Temp. _____

T_N, R_E

Personnel SMITH


BOWERS

24-R

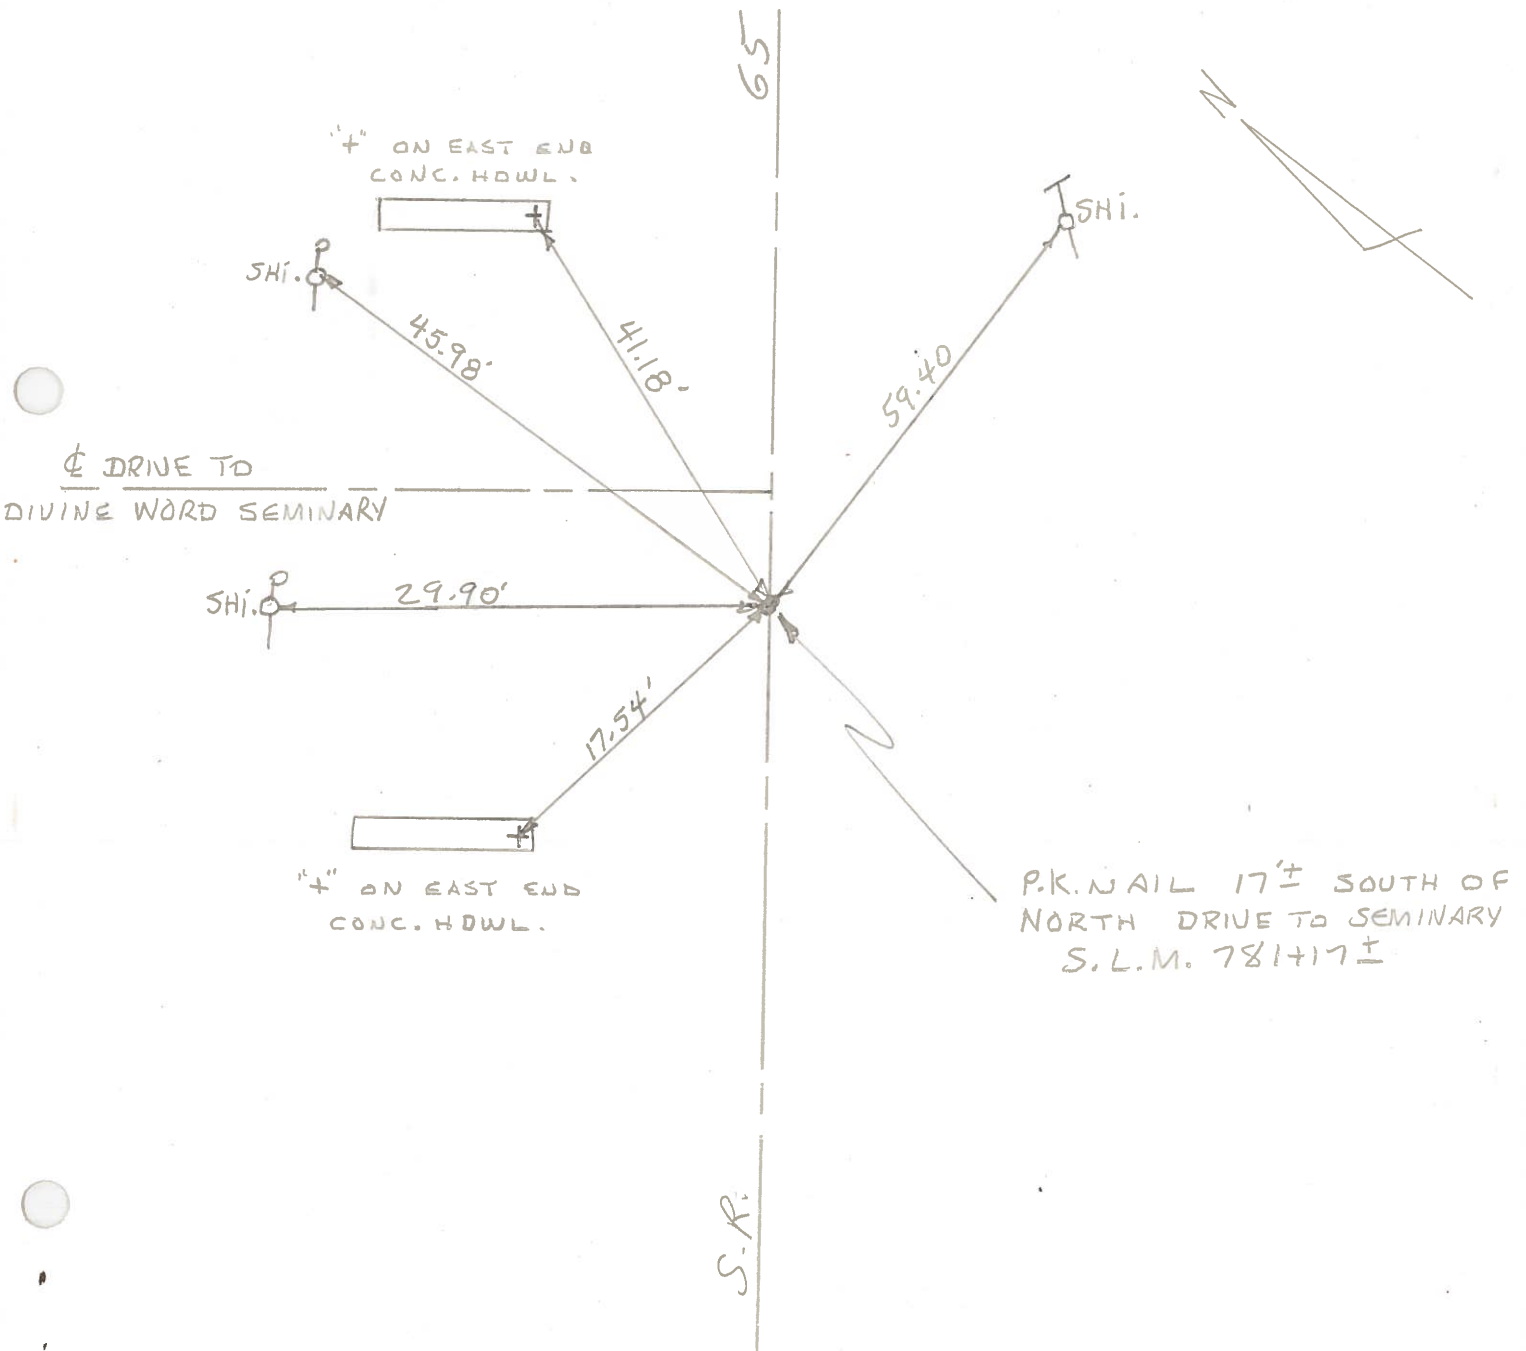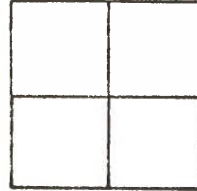

PERSONNEL	TITLE	PERSONNEL	TITLE	COUNTY	DATE
BURNSIDE				WOOD	4-29-71
SMITH				S. R. #65	WEATHER CLEAR
BOWERS				SEC. PERRYSBURG TWP	TEMP. +52°
SARDEJA	E.I.T.				

DESCRIPTION CONTROL POINTS JOB NO.

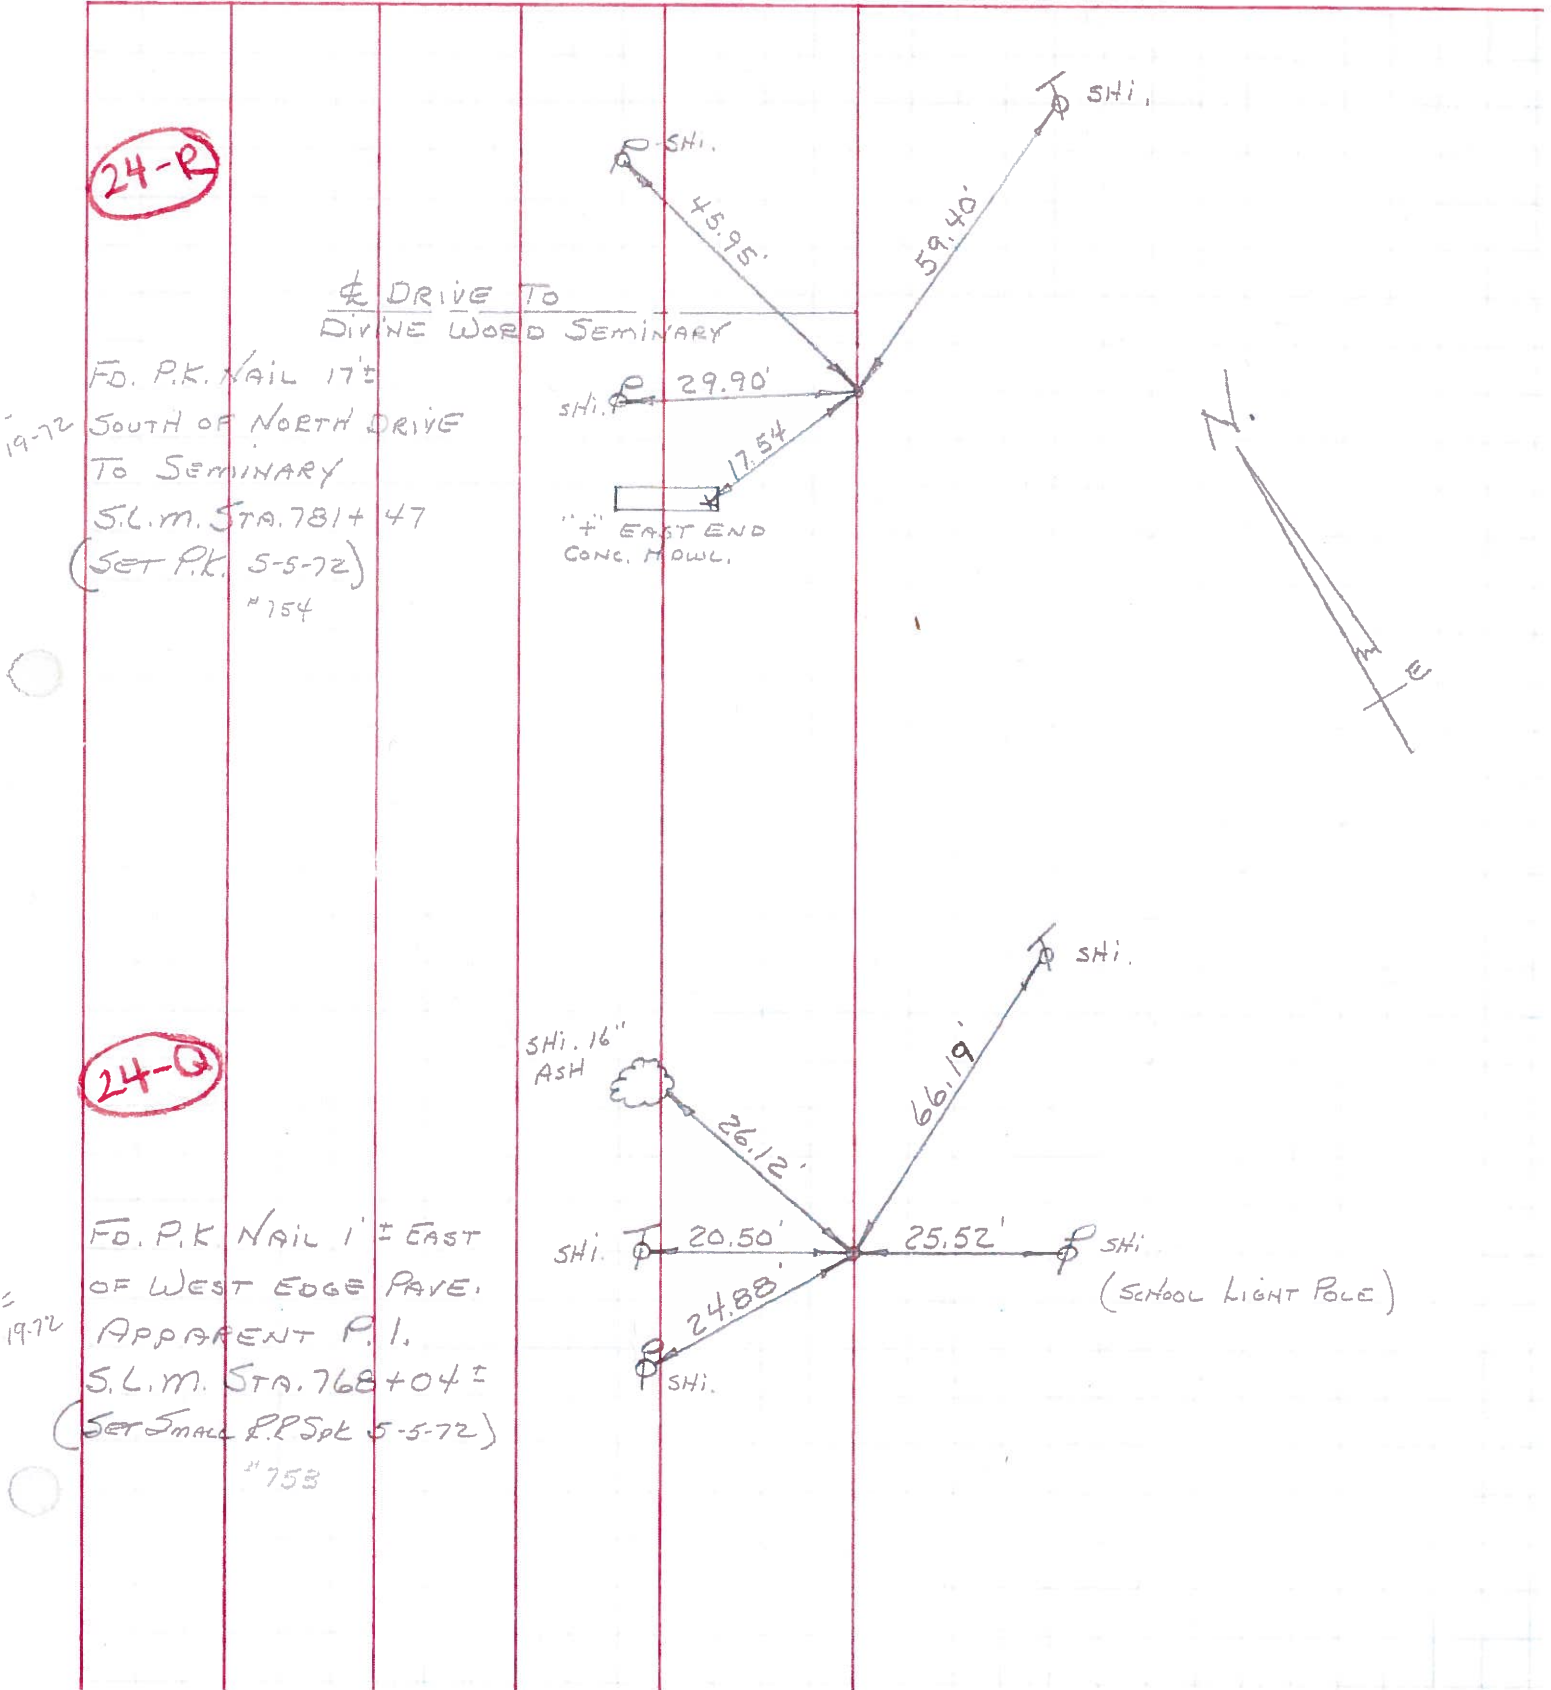


PERSONNEL TITLE PERSONNEL TITLE
 Delventhal _____
 Young _____

COUNTY Wood DATE 8-18-60
 S. R. 65 WEATHER Clear
 SEC. 11.96-17.65 TEMP. 80's


DESCRIPTION CONTROL POINTS LEFT CENTER LINE RIGHT JOB NO.

24-Q

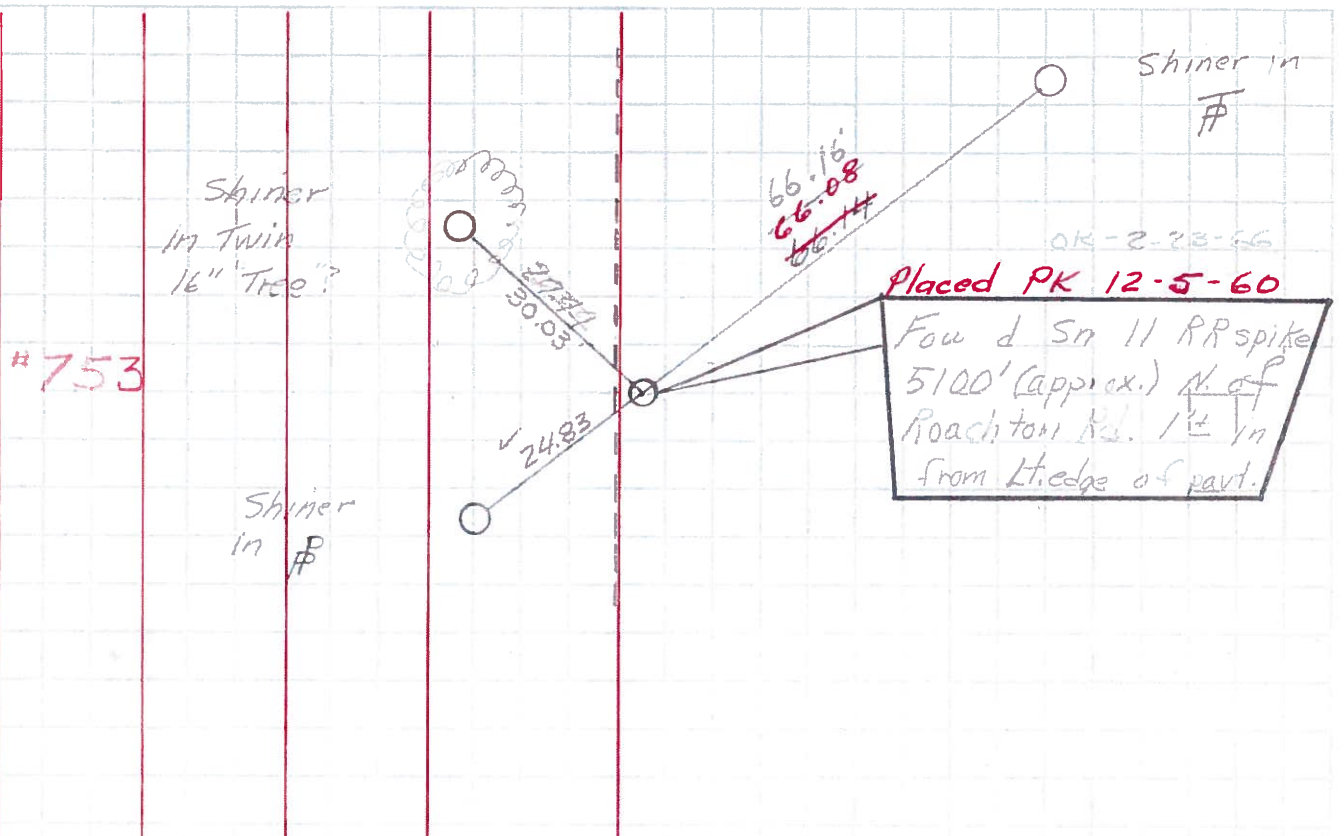

753

24-R

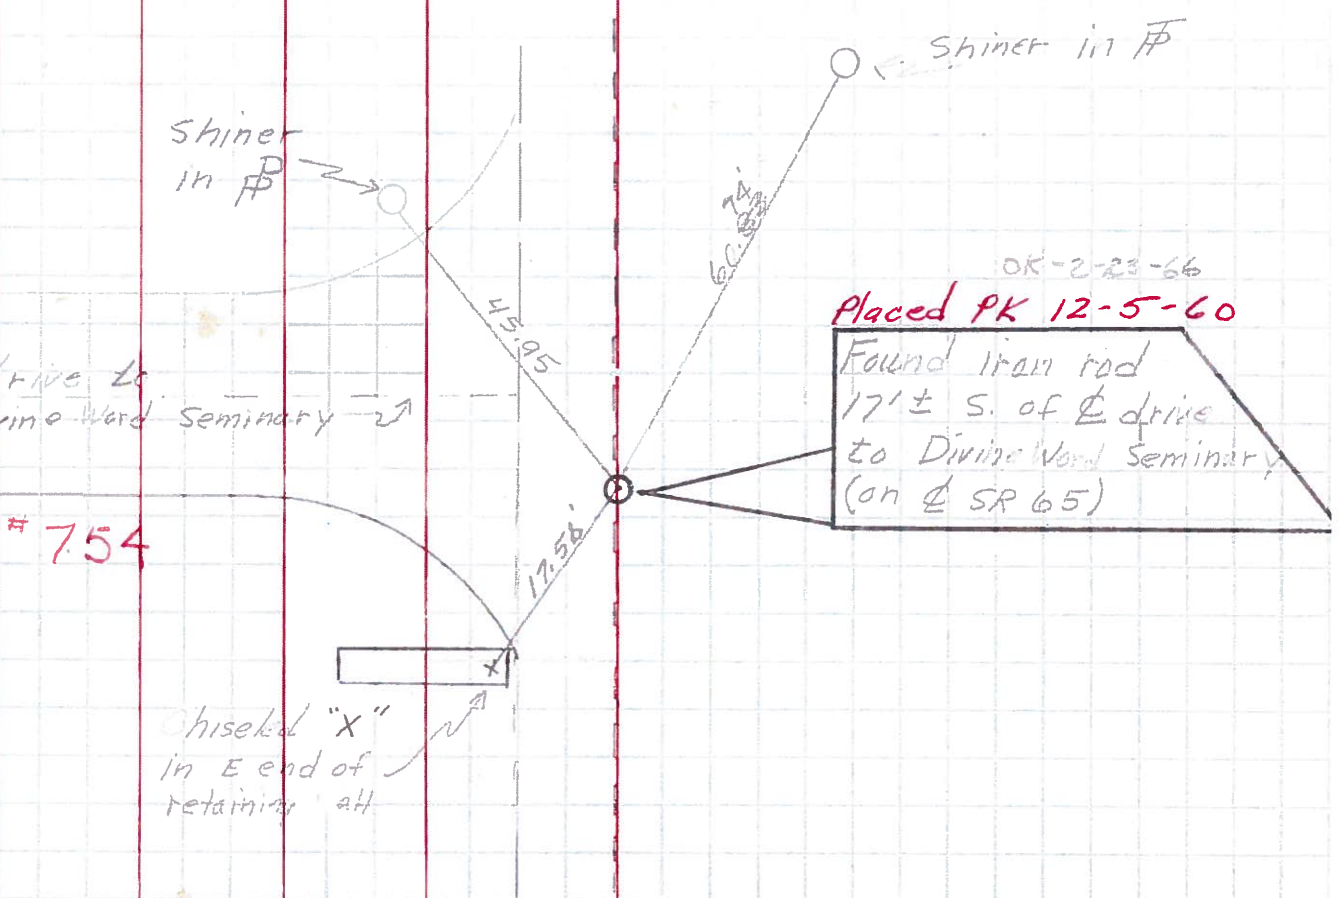

754