



O.D.O.T. DISTRICT 2 SURVEY OFFICE (USE ONLY)

PERSONNEL _____ REFERENCE NO. 24 T SHEET 37 OF 44
 NOTES HOMAN DATE 6-23-14 ROUTE SR 65
 H.C. LEU WEATHER CLEAR COUNTY WOOD
 R.C. THOMAS TEMP. 80°F TOWNSHIP PERRYBURG
 _____ SECTION RT 59
 _____ T 7 N R 10 E

TYPE MONUMENT 3/4" IPIN
 ON SURFACE - ~~BELOW~~ ON
 LEFT - ℄ PAV'T - ~~RIGHT~~ 34.47'
34.30' LT TO LT EDGE PAVEMENT
 S.L.M. 797+72.43
 Grid: Northing: 684568.984 Easting: 1643804.316

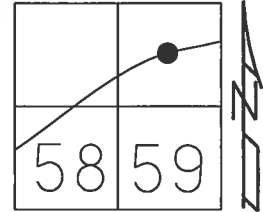

RECORD: P.I.
 1924 PLAN
 STA 164+17
 $\Delta = 32^\circ 48'$
 $D = 8^\circ 00'$
 $R = 716.78$
 $T = 210.95$
 $L = 410.00$
 FD 3/4" IPIN
 1/31/90, MB
 FD 3/4" IPIN
 REFT24
 9/21/12, SAH
 6-23-14, JLL

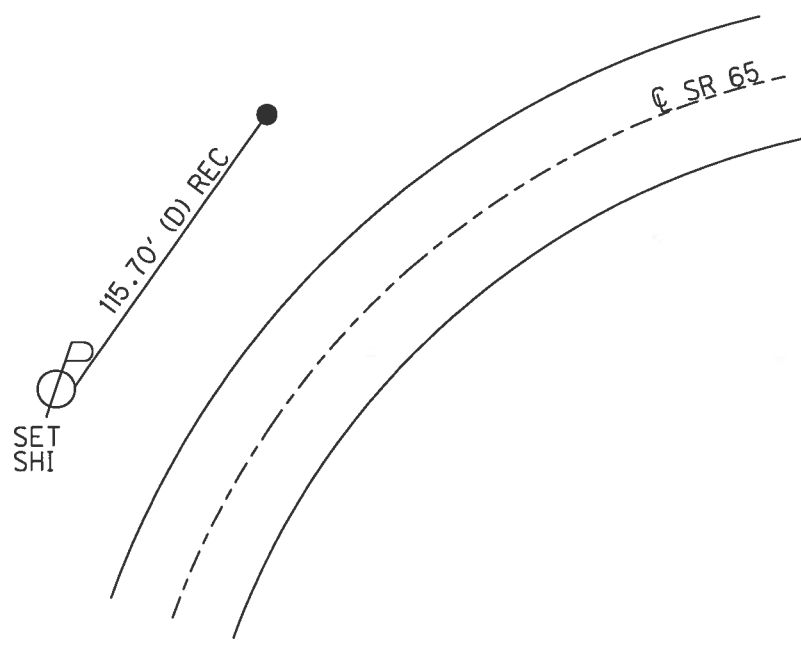

O.D.O.T. DISTRICT 2 SURVEY OFFICE

PERSONNEL _____

REFERENCE NO. _____

SHEET 65-A OF _____

NOTES HOFFMAN

H.C. LOSHKUS

R.C. BARWISSEL

DATE 1-31-90

WEATHER CLEAR

TEMP. 40°

ROUTE SR 65

COUNTY Wood

TOWNSHIP Perryssburg

SECTION _____

T. _____ R. _____

TYPE MONUMENT 3/4"

ON SURFACE - BELOW YES

LEFT-~~☉~~ PAV'T. - RIGHT 34.0'

_____ TO _____ EDGE PAVEMENT

S.L.M. _____

○	○
RT	RT
60	61



"Believe" this to be P.I. of CURVE - 1924 PLAN sta 164+17

- $\Delta = 32^{\circ}-48'$
 - $D = 8^{\circ}-00'$
 - $R = 716.78$
 - $T = 210.95$
 - $L = 410.00$
- } RECORD

