

County Wood S.R. 65

Date 5-9-84

Township Perrysburg

Weather OVERCAST

Section R.T. 60

Temp. +40°

TZN, R10E

Personnel HOFFMAN  
HOUSEHOLDER HC  
BARWISSEL RC

RT	RT
60	61




"A" = Fd PK @ surface, ORIGIN UNKNOWN  
 0.5' RT of PAUT  
 9.3' TO RT. EP.  
 10.3' TO LT. EP.

SLM PT. "A" = 793+33

"B" = Fd P.K. @ surface, ORIGIN UNKNOWN  
 0.5' LT. of PAUT  
 9.1' TO LT. EP.  
 10.2' TO RT. EP.

DID NOT RESET

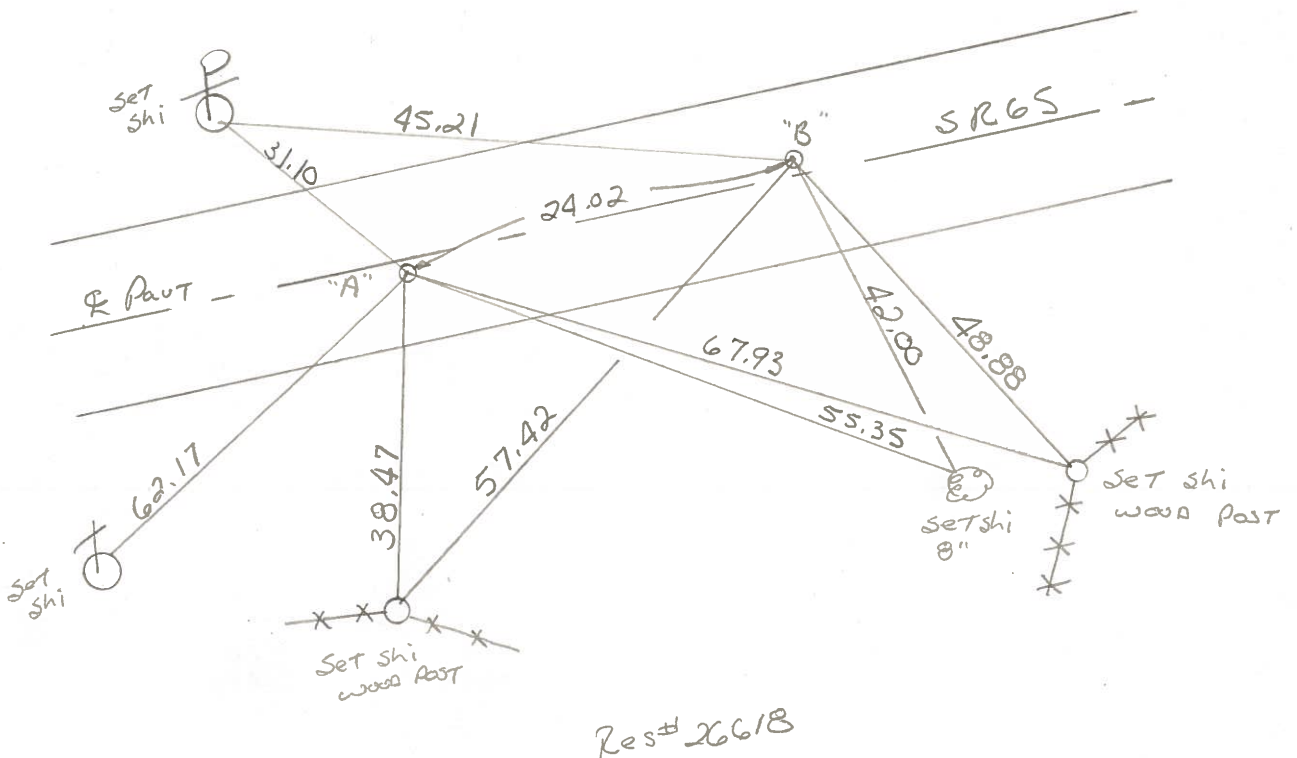

Res# 26618