


O.D.O.T. DISTRICT 2 SURVEY OFFICE (USE ONLY)


PERSONNEL _____ REFERENCE NO. 24 U SHEET 38 OF 44
 NOTES HOMAN DATE 6-23-14 ROUTE SR 65
 H.C. LEU WEATHER SUNNY COUNTY WOOD
 R.C. THOMAS TEMP. 80°F TOWNSHIP PERRYSBURG
 SECTION RT 60
 T 7 N R 10 E

TYPE MONUMENT P.K.NAIL
 ON SURFACE - ~~BELOW~~ ON _____
~~LEFT~~ - Q PAV'T - RIGHT 0.5'
9.7' TO RT EDGE PAVEMENT
 S.L.M. 802+92

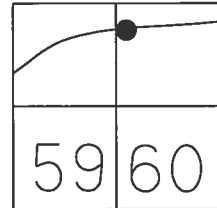

Grid: Northing: 684700.324 Easting: 1644318.945

SET BY FARNAHM & WIRRES
 RECORD:
 STA. 800+88
 FD P.K.NAIL
 SET P.K./WASHER
 10-19-84, SWH
 FD P.K./WASHER
 5/23/95, SAH
 SET PK/WASHER
 8-8-95, SAH
 FD P.K./WASHER
 REFU24
 9/21/12, SAH
 6-23-14, JLL
 SET MAG/WASHER
 08-03-15, JLL

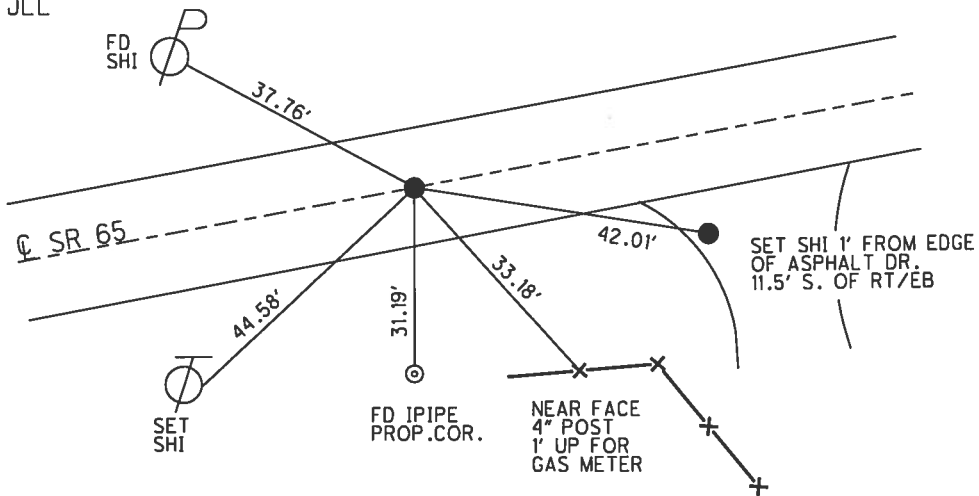

O.D.O.T. DISTRICT 2 SURVEY OFFICE

PERSONNEL _____

REFERENCE NO. _____

SHEET 66 OF 91

NOTES VAUDUSEN

H.C. MOSEK

R.C. COLOS

HUSS

DATE 5-23-95

WEATHER Sunny

TEMP. +80°F

ROUTE SR-65

COUNTY Wood

TOWNSHIP Perrysburg

SECTION RT-60

T 7 N R 10 E

TYPE MONUMENT PK/WASHER


ON SURFACE - BELOW

~~LEFT - PAV'T.~~ - RIGHT 0.5' RT.

9.7 TO RT. EDGE PAVEMENT

S.L.M. 800 + 88


24-U

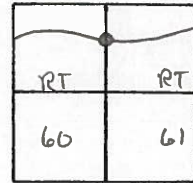

Record: Set by Farnham & Worries
 Fd PK @ surface - believe it to be on right line
 0.5' RT of E of Pav.
 9.2' to RT EP.
 10.3' to Lt EP

SET PK/WASHER
8-8-95
SAA.

Set PK/Washer
10-19-84
SWH

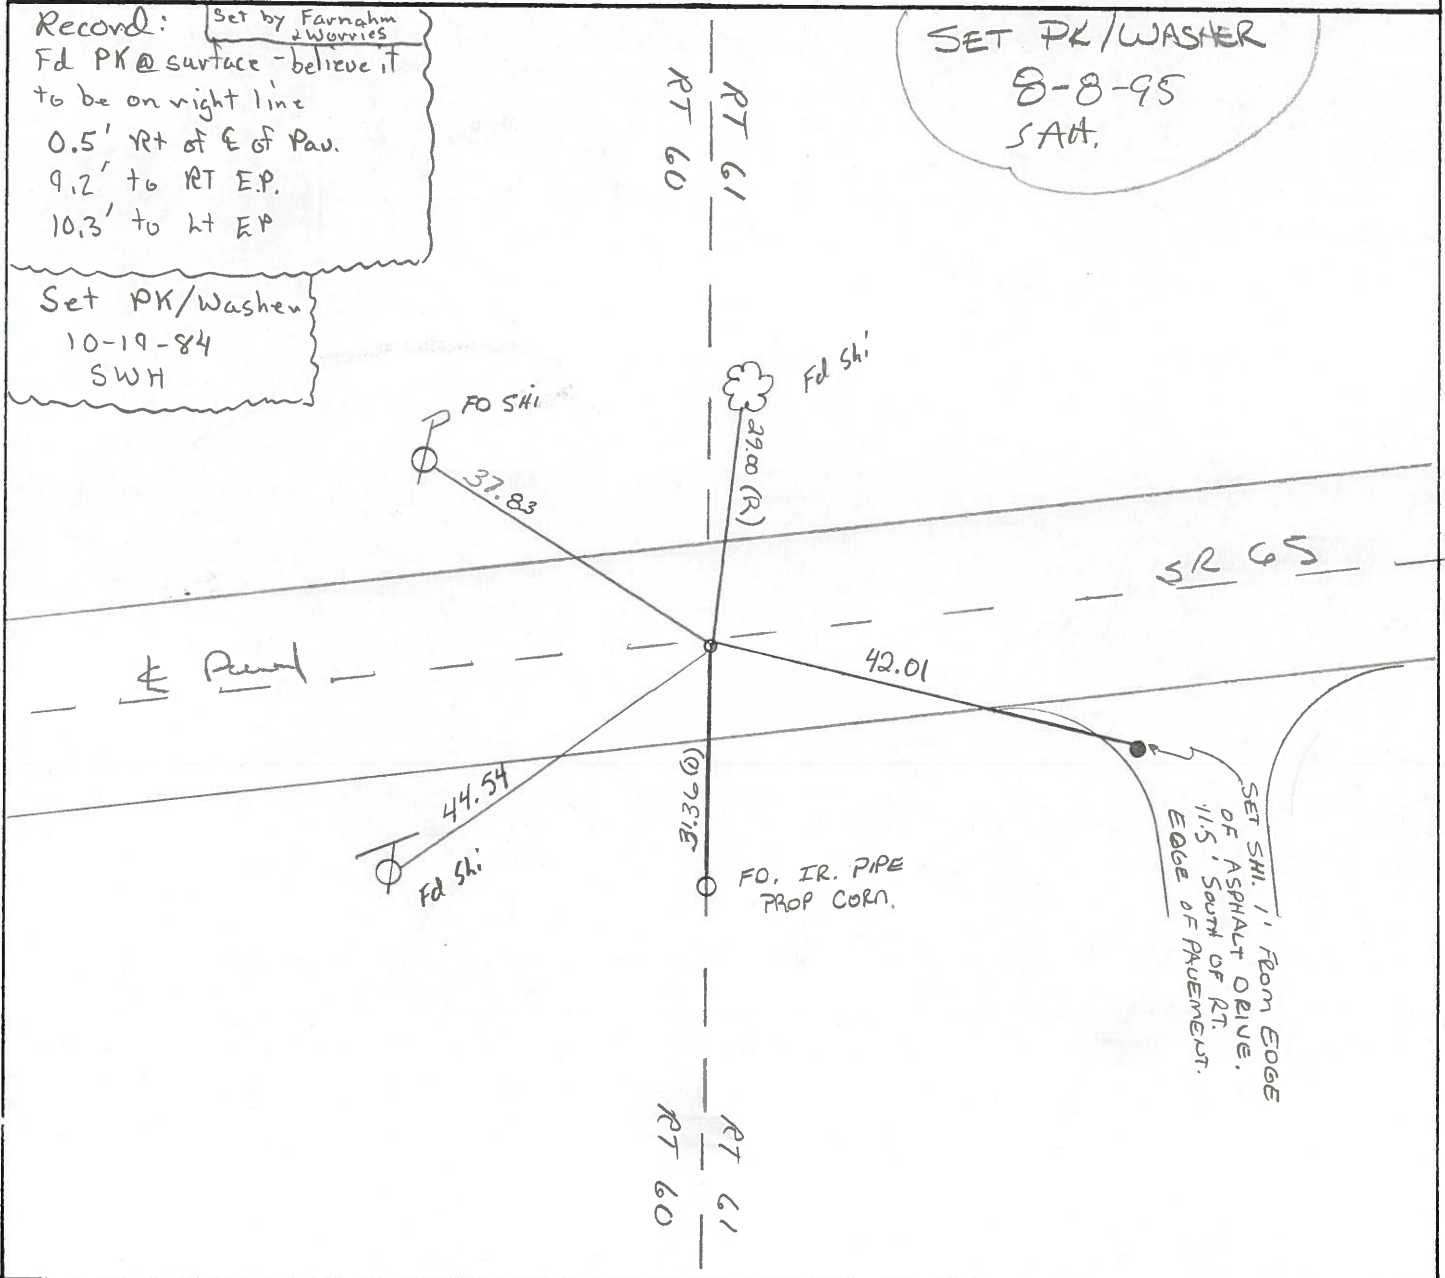

County Wood S.R. 65

Date 5-9-84

Township Perrysburg

Weather OVERCAST

Section RT 60

Temp. 40°


TZN, RICE

Personnel Hoffman

HOUSEHOLDER HC

BARNHISEL RC

24-U

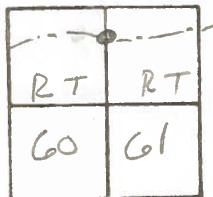

Fd P.K. @ surface, set by "FARNHAM WIRRIES & BERLING"

SLM 800+88

Believe IT TO BE ON

R.T. LINE

0.5' RT. of & PAUT

9.2' TO RT. EP.

10.3' TO LT. EP.

SET PK/WASHER

10-19-84

SWH.

