



O.D.O.T. DISTRICT 2 SURVEY OFFICE (USE ONLY)

PERSONNEL \_\_\_\_\_ REFERENCE NO. 25 A SHEET 41 OF 44  
 NOTES LEU DATE 08-14-14 ROUTE SR 65  
 H.C. HOMAN WEATHER SUNNY COUNTY WOOD  
 R.C. WESTFALL TEMP. 65°F TOWNSHIP PERRYSBURG  
 SECTION RT 61  
 T 7 N R 10 E

TYPE MONUMENT P.K.NAIL  
~~ON SURFACE~~ - BELOW 2"  
~~LEFT~~ - Q PAV'T - RIGHT 1.3"  
9.2' TO RT EDGE PAVEMENT  
 S.L.M. 818+95.83  
 Grid: Northing: 685155.319 Easting: 1645852.655

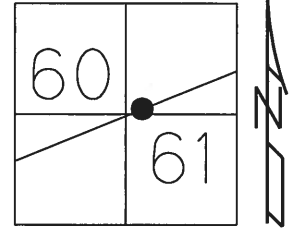

RECORD:  
 SLM 816+90  
 FD NAIL  
 STA. 816+48.5  
 11/5/84  
 FD P.K./WASHER  
 5/23/95, SAH  
 SET P.K./WASHER  
 8-8-95, SAH  
 FD P.K.NAIL  
 2" DOWN  
 REFA25  
 8-14-14, JLL  
 SET MAG/WASHER  
 8-3-15, DCH

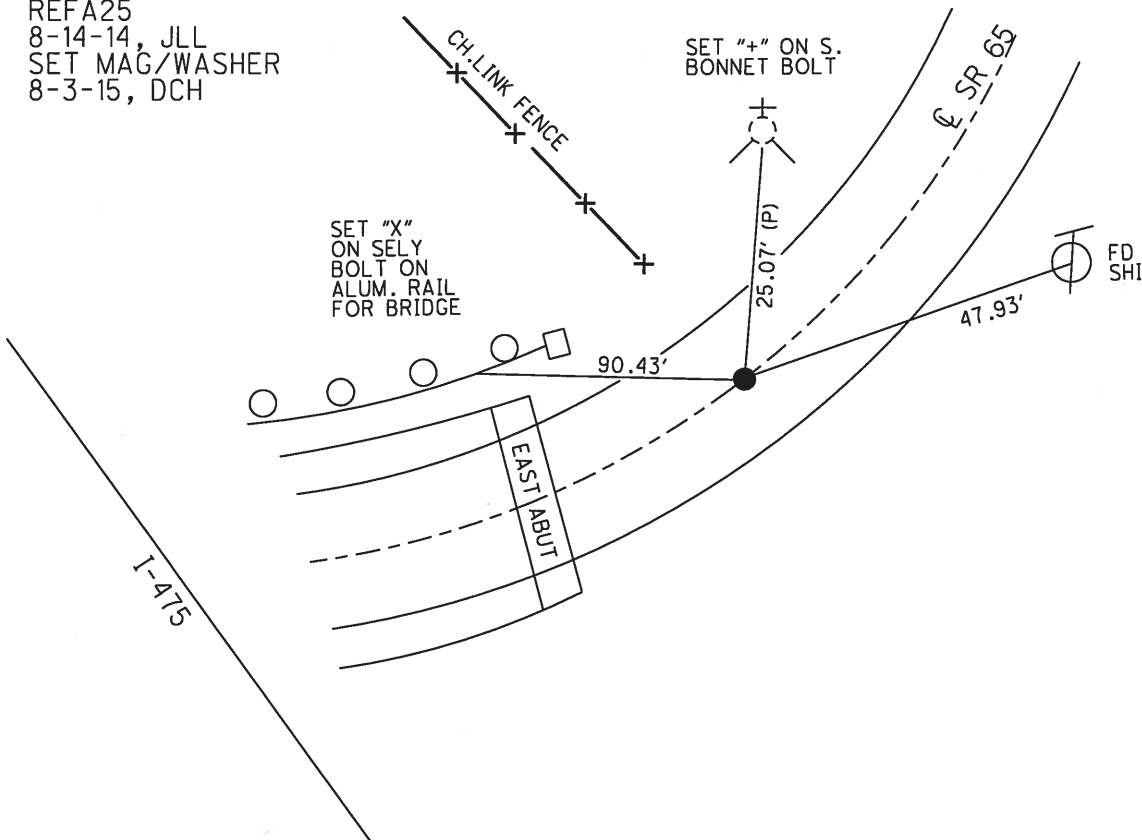

# O.D.O.T. DISTRICT 2 SURVEY OFFICE

PERSONNEL

REFERENCE NO. 25-A

SHEET 69 OF 91

NOTES VANDUSEN

H.C. MOSEY

R.C. CORDES

HUSS

DATE 5-23-95

WEATHER Sunny

TEMP. +80°F

ROUTE S.R. 65

COUNTY Wood

TOWNSHIP Perrysburg

SECTION RT. 61

T     R    


TYPE MONUMENT PK/WASHER

ON SURFACE - ~~BELOW~~

LEFT - ~~C~~ PAV'T. - RIGHT 1.9


9.6 TO RT. EDGE PAVEMENT

S.L.M. 816+90

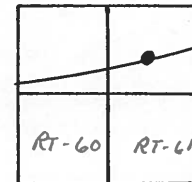

RECORD = SLM 816+90  
 FD. NAIL TO SURFACE  
 STA. 816+48.50  
 11-5-84

SET PK/WASHER  
 8-8-95  
 SAH

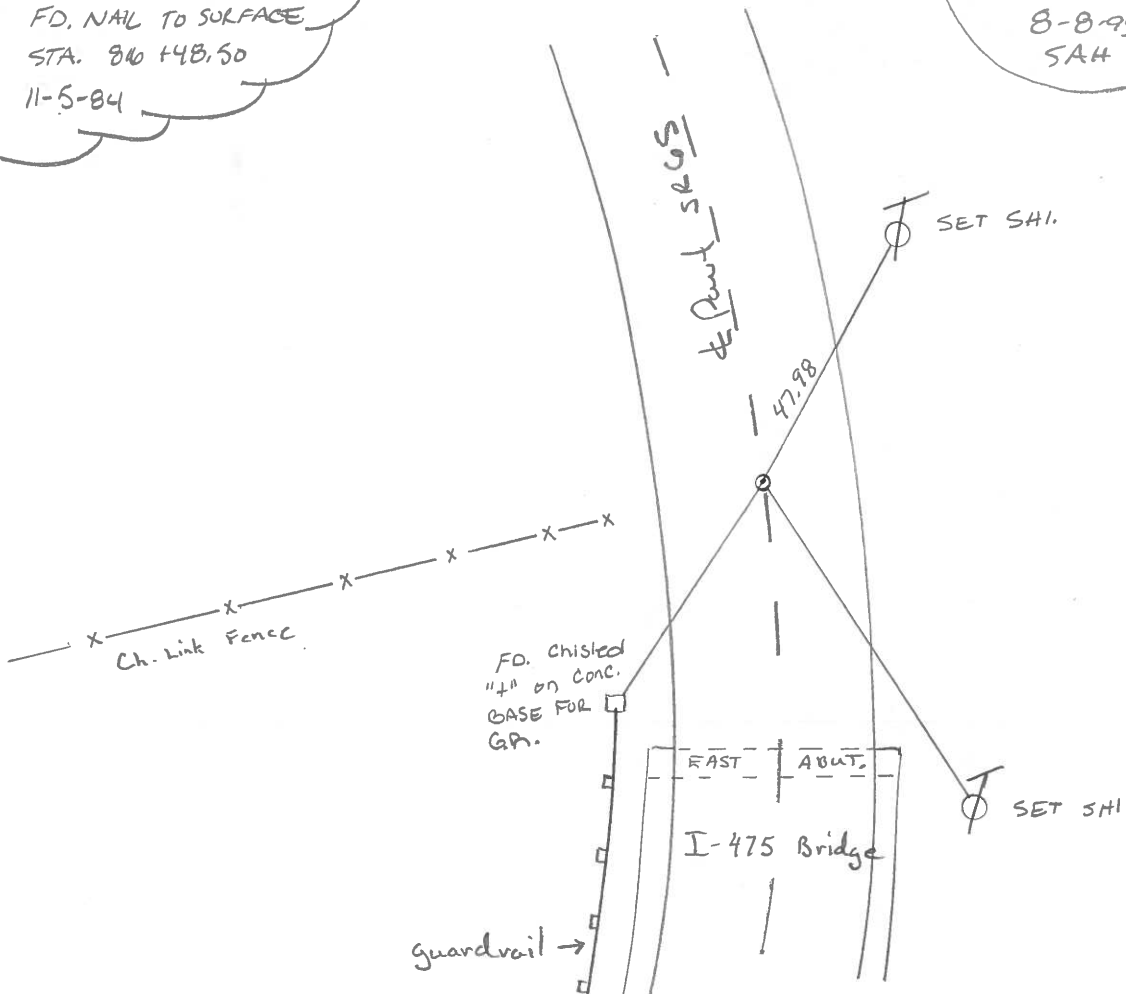

County Wood S.R. # 65

Date 4 Aug. 80

Township Pennsburg

Weather Warm

Section RT-61

Temp. 80°


T\_N, R\_E

Personnel L. Stone

P. Neuser

R. Michalak

D. Curtis

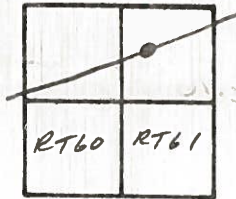


5-10-81  
 Clear  
 +45°  
 H  
 L  
 H  
 B

Ref. No. 25-A

SLM  
816 +90

could not find nail

Fd ties & evidence of nail only

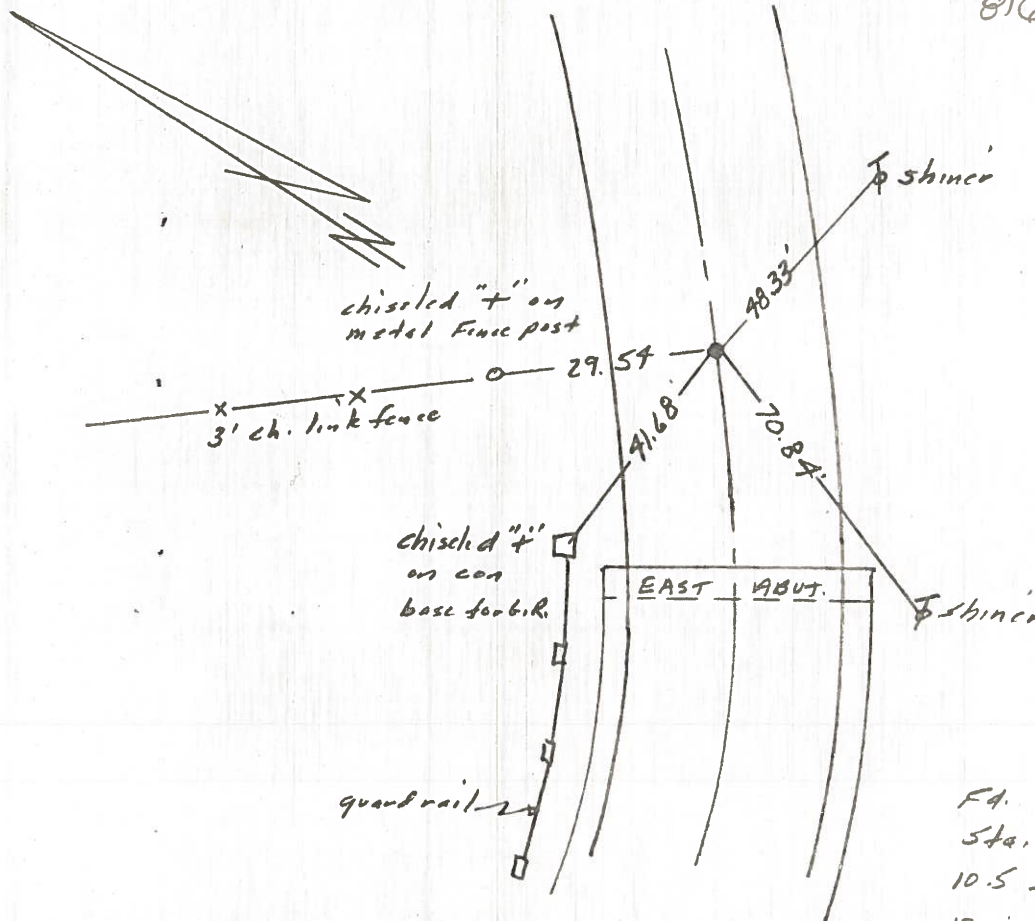

Fd. Nail To Surface  
 Sta. 816+48.50  
 10.5 to S. edge put.  
 13.7 to N. edge put.

1.7 RT of & PAU'T  
 SET PK / WASHER

11-5-84  
 SWH

County Wood S.R. #65

Date 4 Aug. 80

Township Pennsburg


Weather Windy

Section RT-61


Temp. 80°

T    N, R    E

Personnel I. Stone  
P. Neuser  
R. Michalak  
D. Curtis

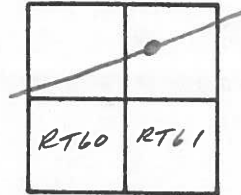

Ref. No. 25-A

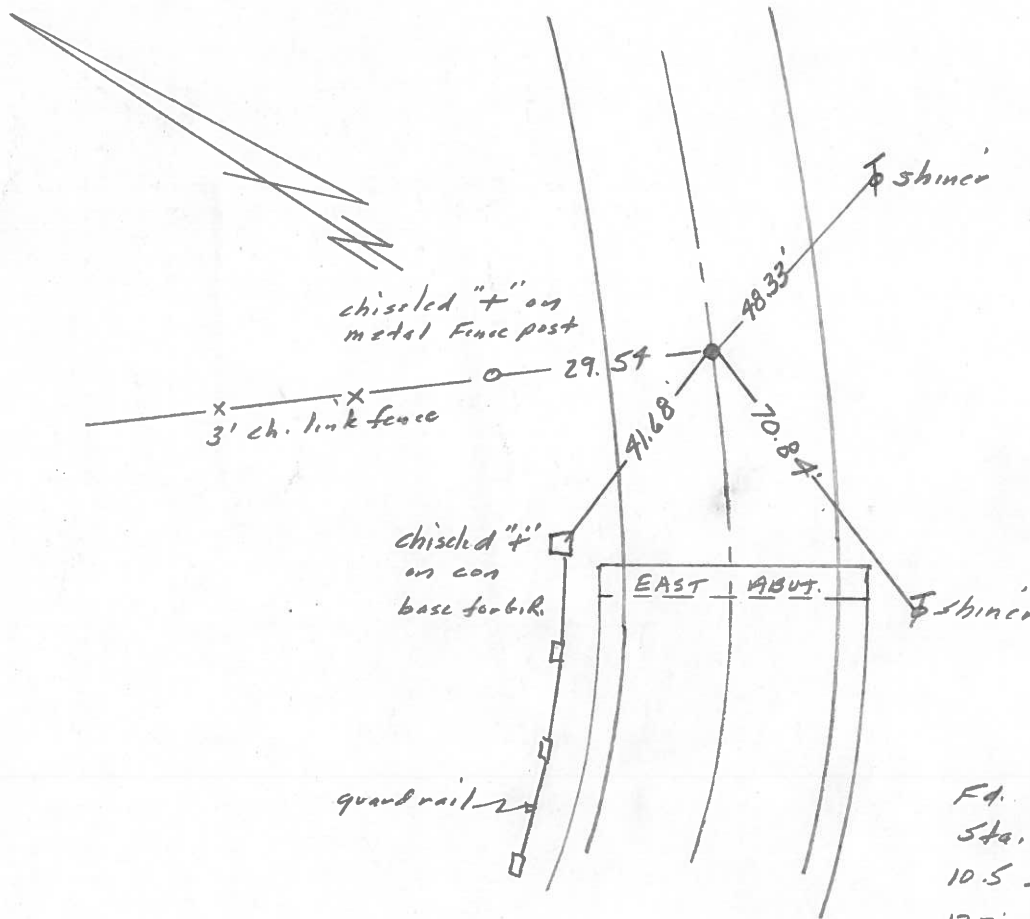

Fd. Nail To Surface  
 Sta. 816+48.50  
 10.5 to S. edge put.  
 13.7 to N. edge put.

PERSONNEL TITLE PERSONNEL TITLE  
Delventhal \_\_\_\_\_  
Young \_\_\_\_\_

COUNTY Wood WEATHER Clear  
S. R. 65

SEC. 11.96-17.65 TEMP. 80's

DESCRIPTION CONTROL Points JOB NO. \_\_\_\_\_  
LEFT CENTER LINE RIGHT

