


O.D.O.T. DISTRICT 2 SURVEY OFFICE (USE ONLY)


PERSONNEL _____ REFERENCE NO. 25 B SHEET 42 OF 44
 NOTES LEU DATE 08-14-14 ROUTE SR 65
 H.C. HOMAN WEATHER SUNNY COUNTY WOOD
 R.C. WESTFALL TEMP. 65°F TOWNSHIP PERRYSBURG
 SECTION 61
 T 7 N R 10 E

TYPE MONUMENT P.K.NAIL
 ON SURFACE - ~~BELOW~~ ON _____
~~LEFT~~ - CL PAV'T - RIGHT 0.7'
10.5' TO RT EDGE PAVEMENT
 S.L.M. 820+72.62

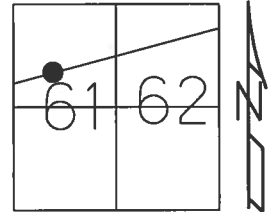

Grid: Northing: 685225.978 Easting: 1646014.710

RECORD:
 SLM 818+69
 FD P.K./WASHER
 5/19/95, SAH
 SET P.K./WASHER
 8-8-95, SAH
 FD P.K.NAIL
 REFB25
 9/21/12, SAH
 08-14-14, JLL
 SET MAG/WASHER
 8-3-15, DCH

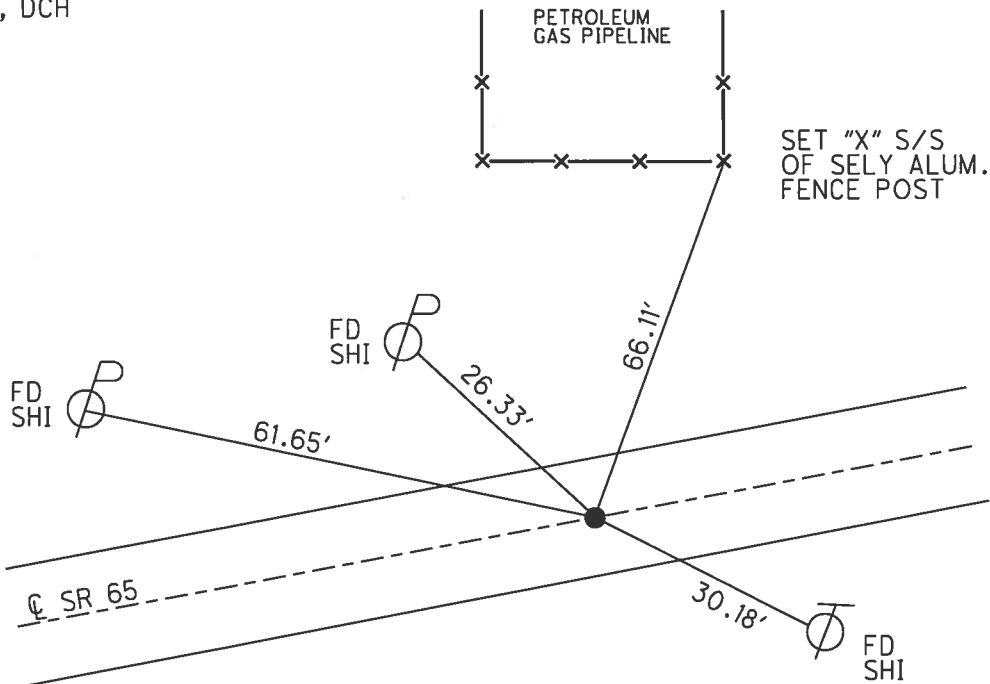

O.D.O.T. DISTRICT 2 SURVEY OFFICE

PERSONNEL

REFERENCE NO. _____

SHEET 70 OF 91

NOTES MIKE BARNHISEL

H.C. BEN CORDES

R.C. MIKE BARNHISEL

DATE 5-19-95

WEATHER Sunny

TEMP. 77.8 °F

ROUTE SR-65

COUNTY Wood

TOWNSHIP Perrysburg

SECTION RT. 61

T 7 N R 10 E

TYPE MONUMENT PK/WASHER


ON SURFACE - BELOW

~~LEFT - C~~ PAV'T. - RIGHT 1.0' RT


10.5 TO RT EDGE PAVEMENT

S.L.M. 818 + 69

25-B

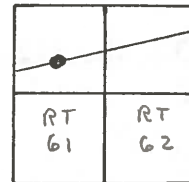

SET PK/WASHER
8-8-95
SAH

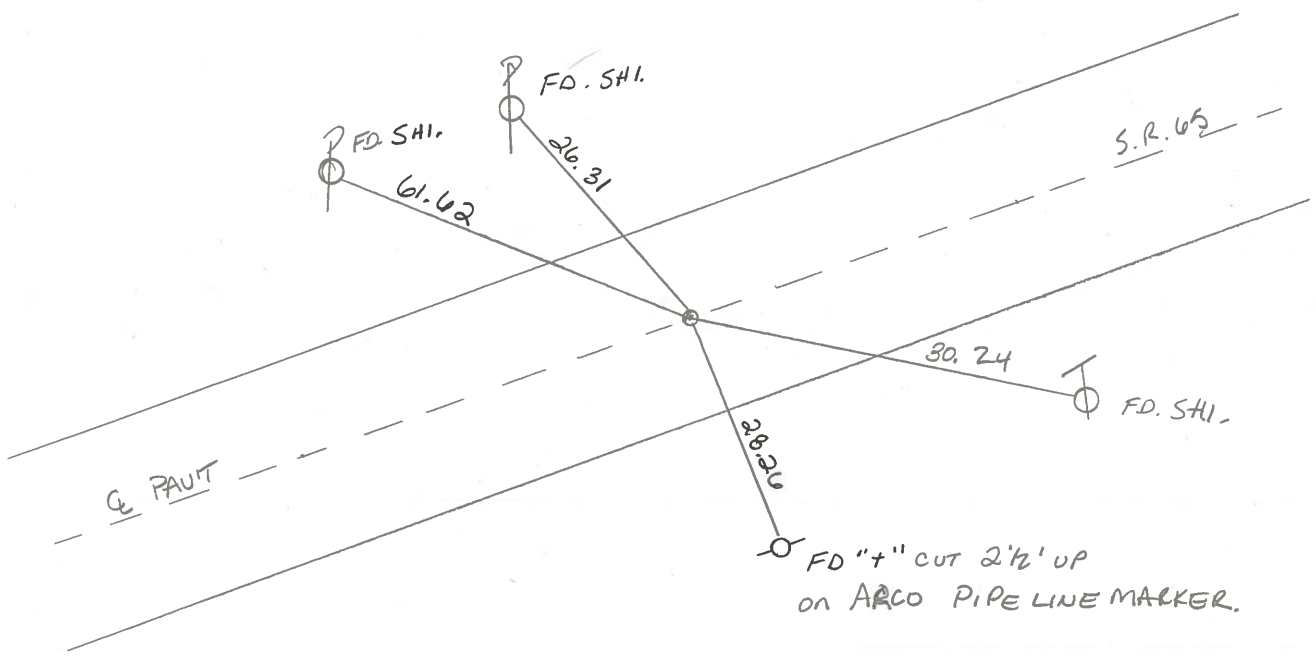

County Wood S.R. 65

Date 5-10-84

Township Perrysburg

Weather Clear

Section R.T.

Temp. 40°

T2N, R10E


Personnel HOFFMAN

25-B

LOGHRKE

HOUSEHOLDER H.C.

BARNHISEL R.C.

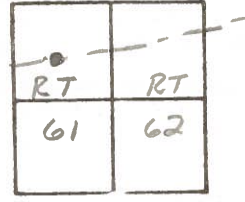

Fd P.K. @ surface; original unknown
 on & part
 11.1 to RT. EP.
 12.2 to LT. EP.

\$LM = 818 + 69

SET PK/WASHER
 11-5-84
 S.W.H.

