


O.D.O.T. DISTRICT 2 SURVEY OFFICE (USE ONLY)


PERSONNEL _____ REFERENCE NO. 26 D SHEET 4 OF 25
 NOTES LEU DATE 8/14/14 ROUTE SR 65
 H.C. HOMAN WEATHER SUNNY COUNTY WOOD
 R.C. WESTFALL TEMP. 70° TOWNSHIP PERRYSBURG
 _____ SECTION RT 62
 _____ T 7 N R 10 E

TYPE MONUMENT MONBOX
 ON SURFACE - ~~BELOW~~ ON _____
~~LEFT~~ - CL PAV'T - RIGHT 1'
8.7' TO LT EDGE PAVEMENT
 S.L.M. 845+13.97

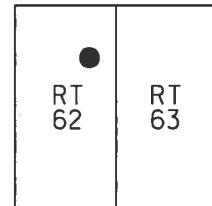

Grid: Northing: 686131.867 Easting: 1648278.353

RECORD:
 CORP.LINE
 FD MONBOX
 REFE26
 9/21/12, SAH
 FD MONBOX
 REFD26
 8/14/14, DCH

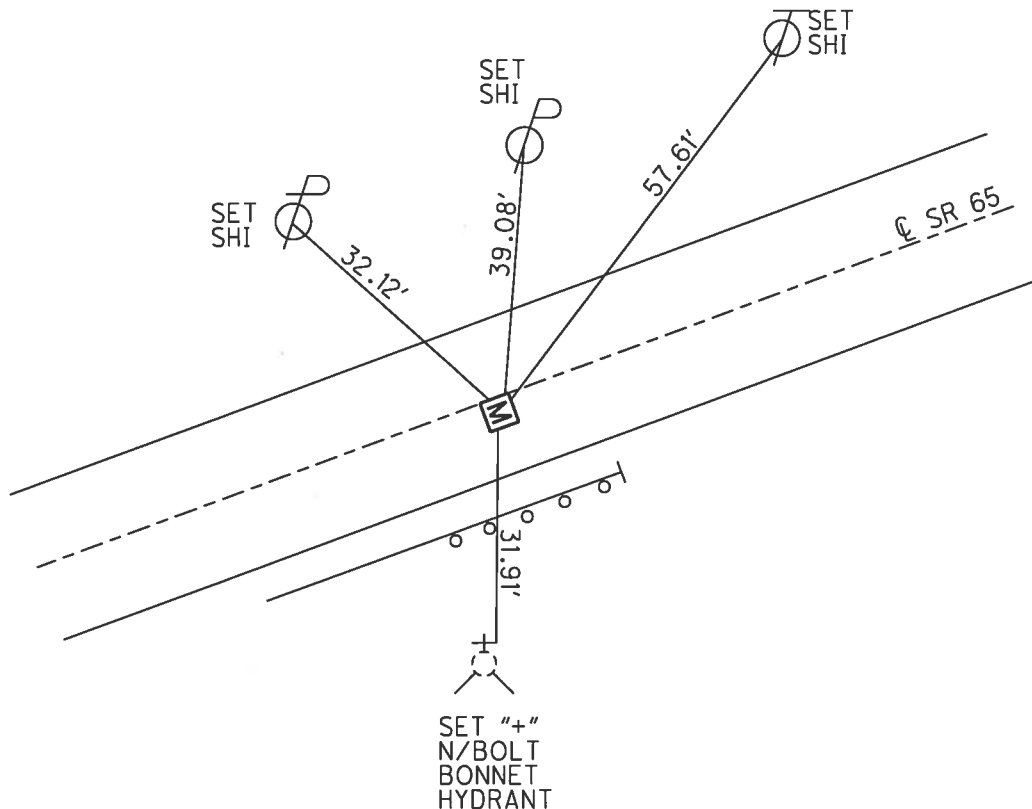

O.D.O.T. DISTRICT 2 SURVEY OFFICE

PERSONNEL _____

REFERENCE NO. _____

SHEET 75 OF 91

NOTES BARNHISEL

H.C. CORDES

R.C. BARNHISEL

DATE 5-19-95

WEATHER SUNNY

TEMP. +75° F

ROUTE S.R. 65

COUNTY WOOD

TOWNSHIP PERRYSBURG

SECTION 63

T 7 N R 10 E

TYPE MONUMENT P.K. WASHER


ON SURFACE - ~~BELOW~~

~~LEFT - C~~ PAV'T. - RIGHT 11.1' Rt

1.6' TO RT EDGE PAVEMENT

S.L.M. 846 + 70

26-D

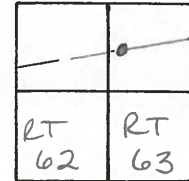


RECORD: SLM = 846+70

PI = STA = 846+28.70

$\Delta = 20^\circ - 00' - 00''$ LT

SET PK/WASHER
8-8-95
SAH.

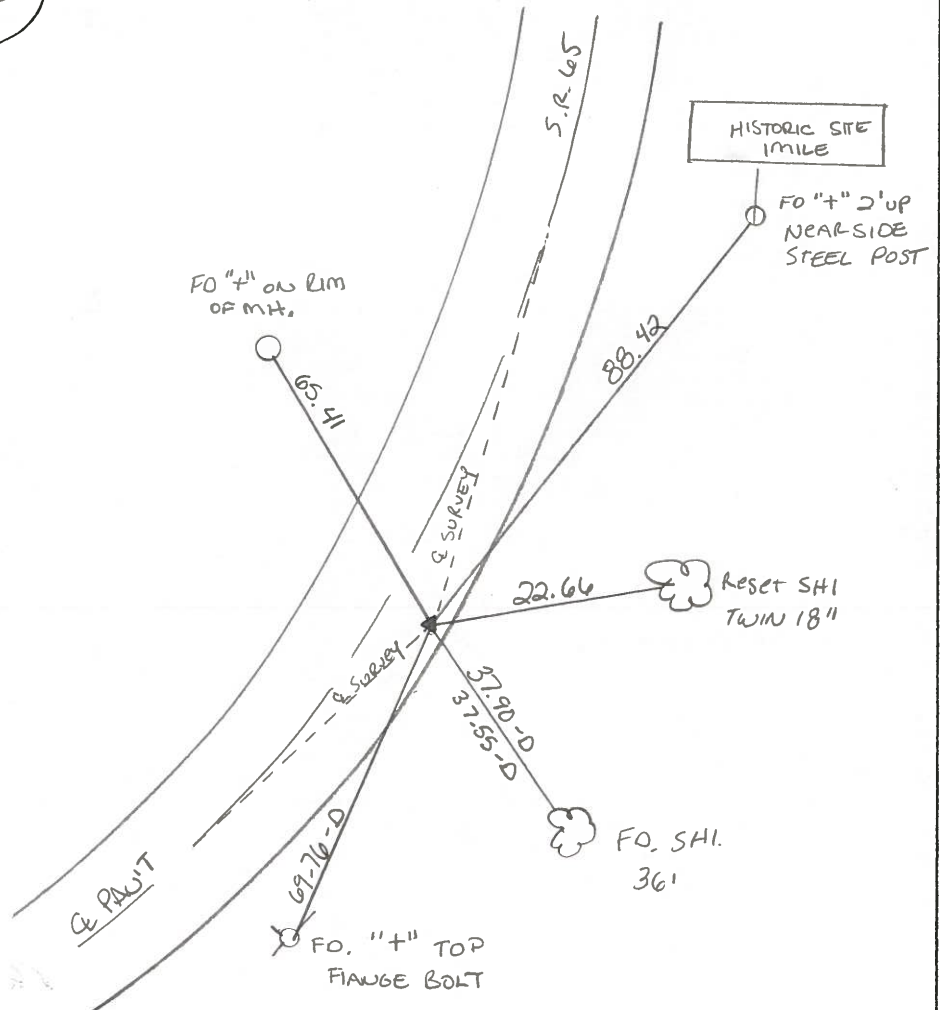

County WOOD S.R. 65

Date 5-10-84

Township PERRYSBURG

Weather CLEAR

Section R.T. 63

Temp. 50°


T7N, R10E

Personnel HOFFMAN

LOEHRKE

HOUSEHOLDER HC

BARNHISEL RC

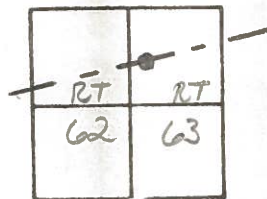


Ref. # 26-D

Fd Shank of P.K. Nail 1" Below surface
 11.8' RT. of & PAVT
 1.5' RT. of RT. EP.

SLM 846+70

SET PK/WASHER
 11-5-84
 SWH

RECORD:
 P.I. STA = 846 + 28.70
 $\Delta = 20^{\circ} - 00' \text{ LT.}$

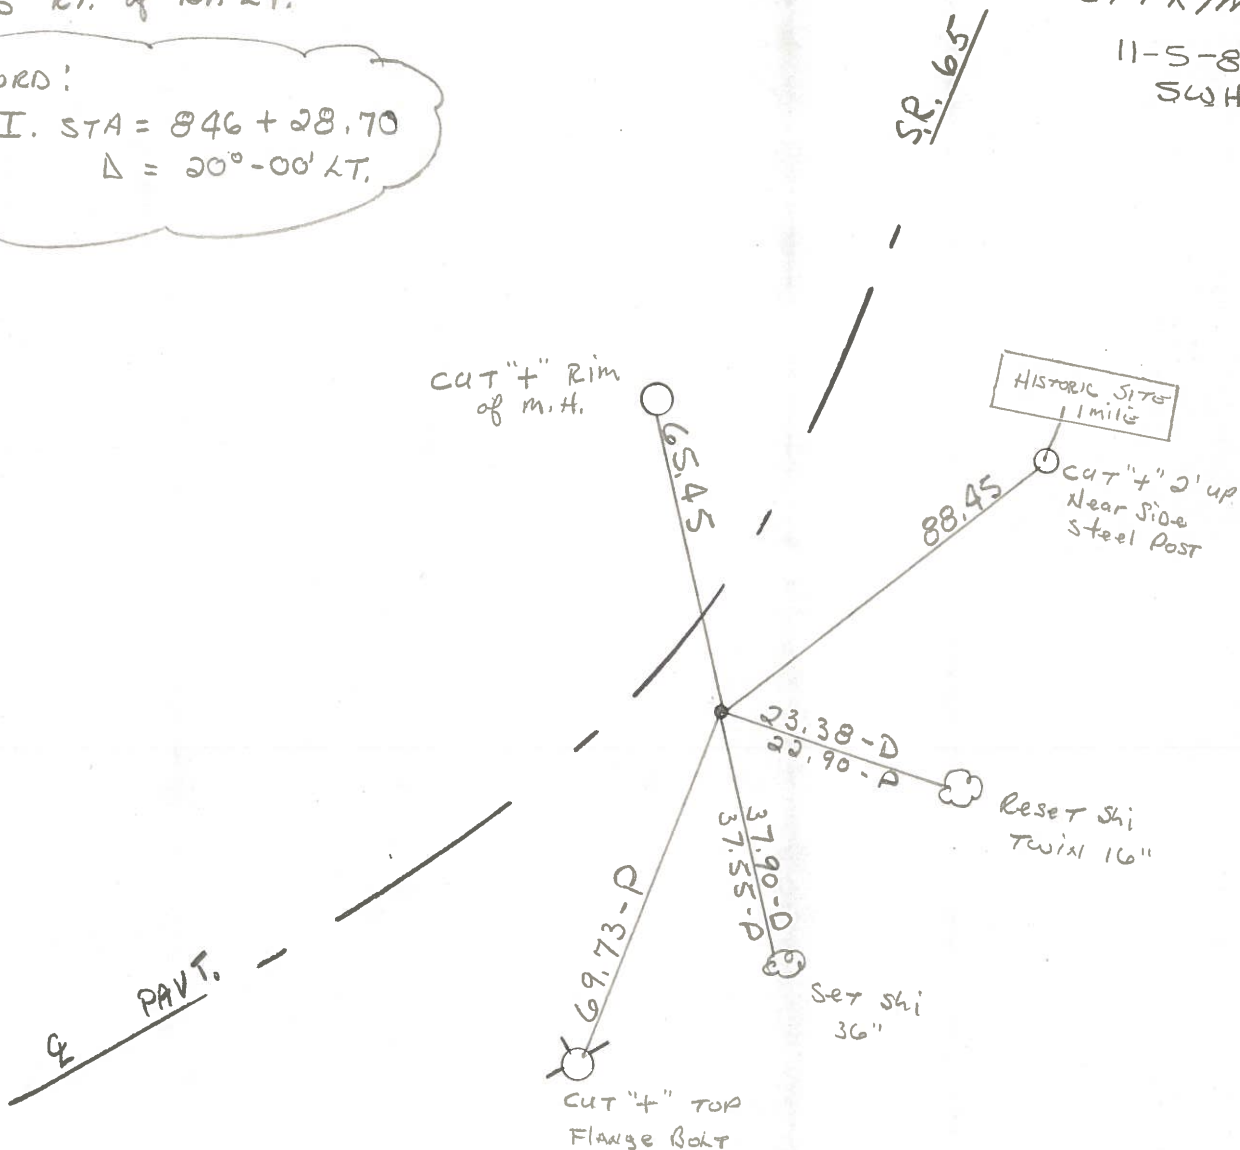

County Wood S.R. # 65

Date 4 Aug. 80

Township Pennsburg

Weather Warm

Section RT-63

Temp. 80°


T N, R E

Personnel J. Stone


R. Michalak

P. Neuser

D. Curtis

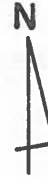

#26-D

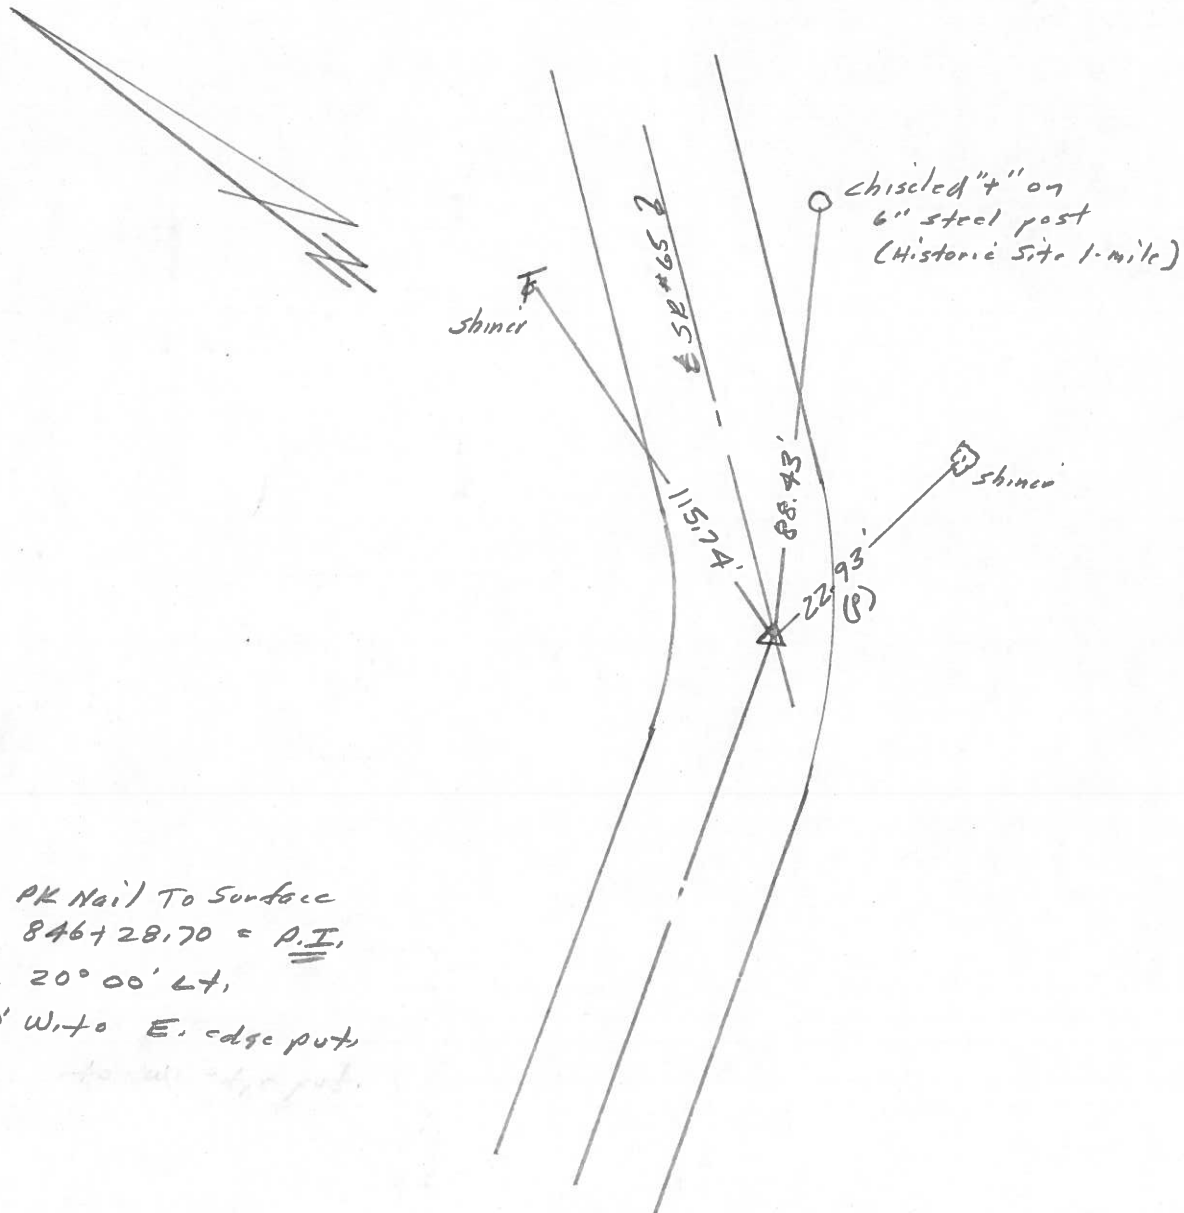

Fd PK Nail To Surface
 Sta. 846+28.70 = P.I.
 $\Delta = 20^{\circ}00' \text{ Lt.}$
 2.0' W. to E. edge put