



O.D.O.T. DISTRICT 2 SURVEY OFFICE (USE ONLY)

PERSONNEL _____ REFERENCE NO. 26 F SHEET 5 OF 25
 NOTES LEU DATE 8/14/14 ROUTE SR 65
 H.C. HOMAN WEATHER SUNNY COUNTY WOOD
 R.C. WESTFALL TEMP. 75° TOWNSHIP PERRYSBURG
 SECTION RT 63
 T 7 N R 10 E

TYPE MONUMENT MONBOX
 ON SURFACE - ~~BELOW~~ ON _____
~~LEFT~~ - ☉ PAV'T - RIGHT 11.4'
 2' RT TO RT EDGE PAVEMENT
 S.L.M. 848+74.69
 Grid: Northing: 686231.465 Easting: 1648625.059

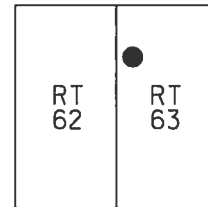

RECORD: P.I.
 STA. 846+28.7
 $\Delta = 20^\circ 00' \text{ LT}$
 FD P.K./WASHER
 5/19/95, MB
 SET P.K./WASHER
 8/8/95, SAH
 FD MONBOX
 COULD NOT OPEN
 REFF26
 9/21/12, SAH
 FD MONBOX
 COULD NOT OPEN
 SET "+" W/DIMPLE
 ON LID
 REFE26
 8/14/14, DCH

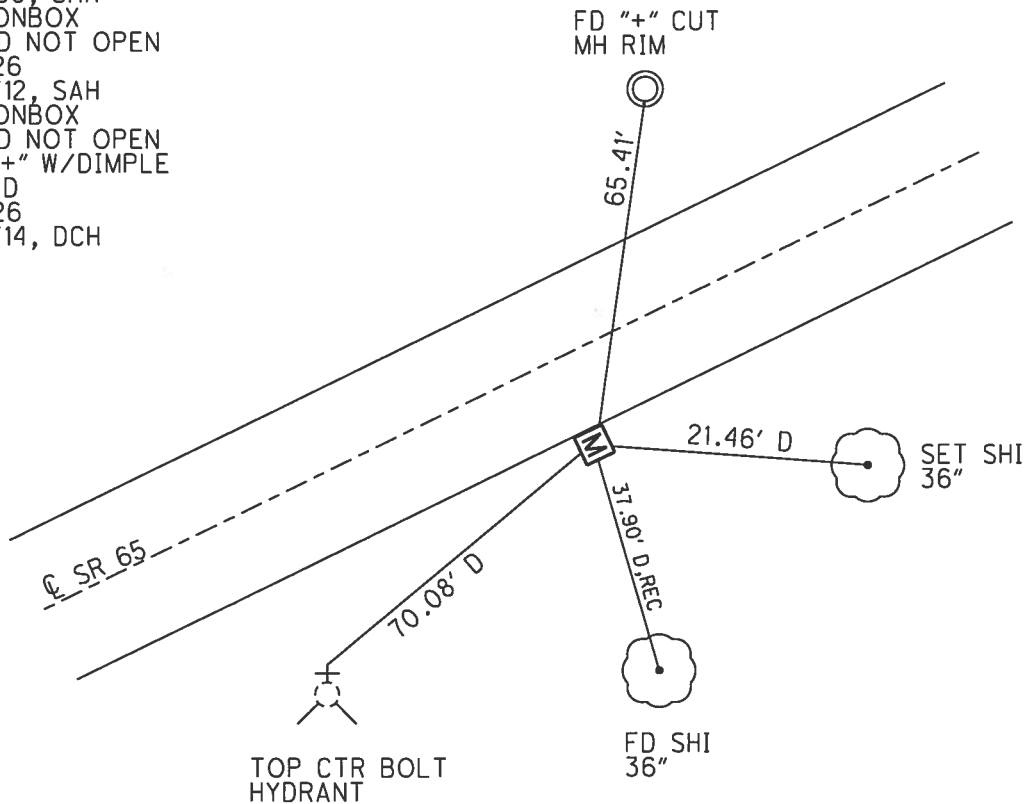

O.D.O.T. DISTRICT 2 SURVEY OFFICE

PERSONNEL _____

REFERENCE NO. _____

SHEET 75 OF 91

NOTES BARNHISEL

H.C. CORDES

R.C. BARNHISEL

DATE 5-19-95

WEATHER SUNNY

TEMP. +75° F

ROUTE S.R. 65

COUNTY WOOD

TOWNSHIP PERRYSBURG

SECTION 63

T 7 N R 10 E


TYPE MONUMENT P.K. WASHER

ON SURFACE - ~~BELOW~~ _____

~~LEFT - C~~ PAV'T. - RIGHT 11.1' Rt


1.6' TO RT EDGE PAVEMENT

S.L.M. 846 + 70

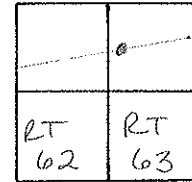

RECORD: SLM = 846+70
 PI STA = 846+28.70
 $\Delta = 20^\circ - 00' - 00'$ LT

SET PK WASHER
 8-8-95
 SAA.

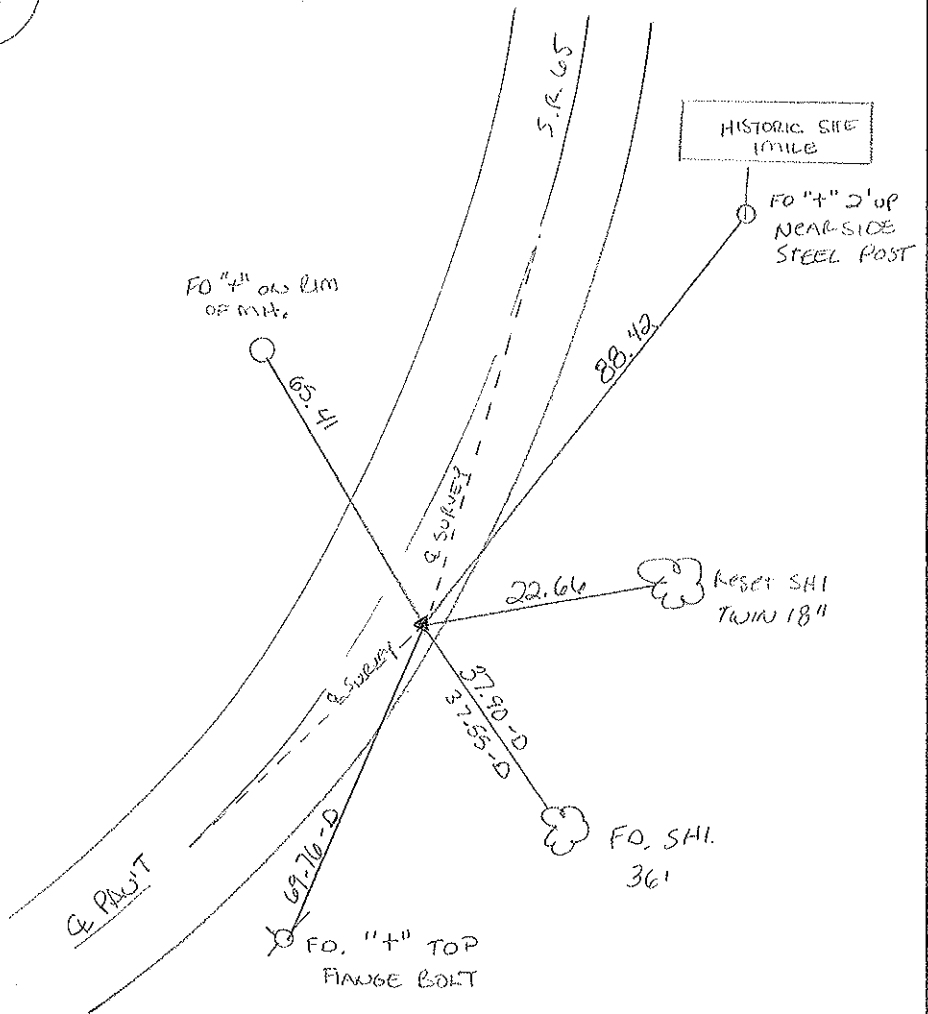

PERSONNEL	TITLE	PERSONNEL	TITLE
Granata			
Newser			
Vanyo			
Jackson			

COUNTY Wood DATE Aug. 11, 1971

S. R. #65 WEATHER Fair

SEC. _____ TEMP. 70¹⁵

DESCRIPTION Reference Mon. on S.R. #65 JOB NO. _____

