

O.D.O.T. DISTRICT 2 SURVEY OFFICE (USE ONLY)

PERSONNEL \_\_\_\_\_ REFERENCE NO. 26 G SHEET 6 OF 25

NOTES LEU DATE 8/19/14 ROUTE SR 65  
 H.C. WESTFALL WEATHER SUNNY COUNTY WOOD  
 R.C. RHOADES TEMP. 70° TOWNSHIP PERRYSBURG  
 SECTION RT 63  
 T 7 N R 10 E

TYPE MONUMENT P.K.NAIL


~~ON SURFACE~~ - BELOW 3"

LEFT - CL PAV'T - ~~RIGHT~~ 1.5'


9.1' TO LT EDGE PAVEMENT

S.L.M. 850+48.42

Grid: Northing: 686333.602 Easting: 1648765.595

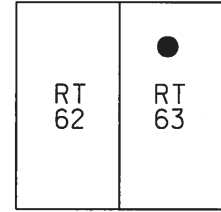

RECORD:  
 STA. 848+41  
 FD P.K./WASHER  
 ORIGIN UNKNOWN  
 5/19/95, MB  
 SET P.K./WASHER  
 8/15/95, CL  
 FD P.K.SHANK  
 REFG26  
 9/24/12, SAH  
 FD P.K.NAIL  
 REFF26  
 8/19/14, EBW  
 SET MAG/WASHER  
 6/8/17, DCH

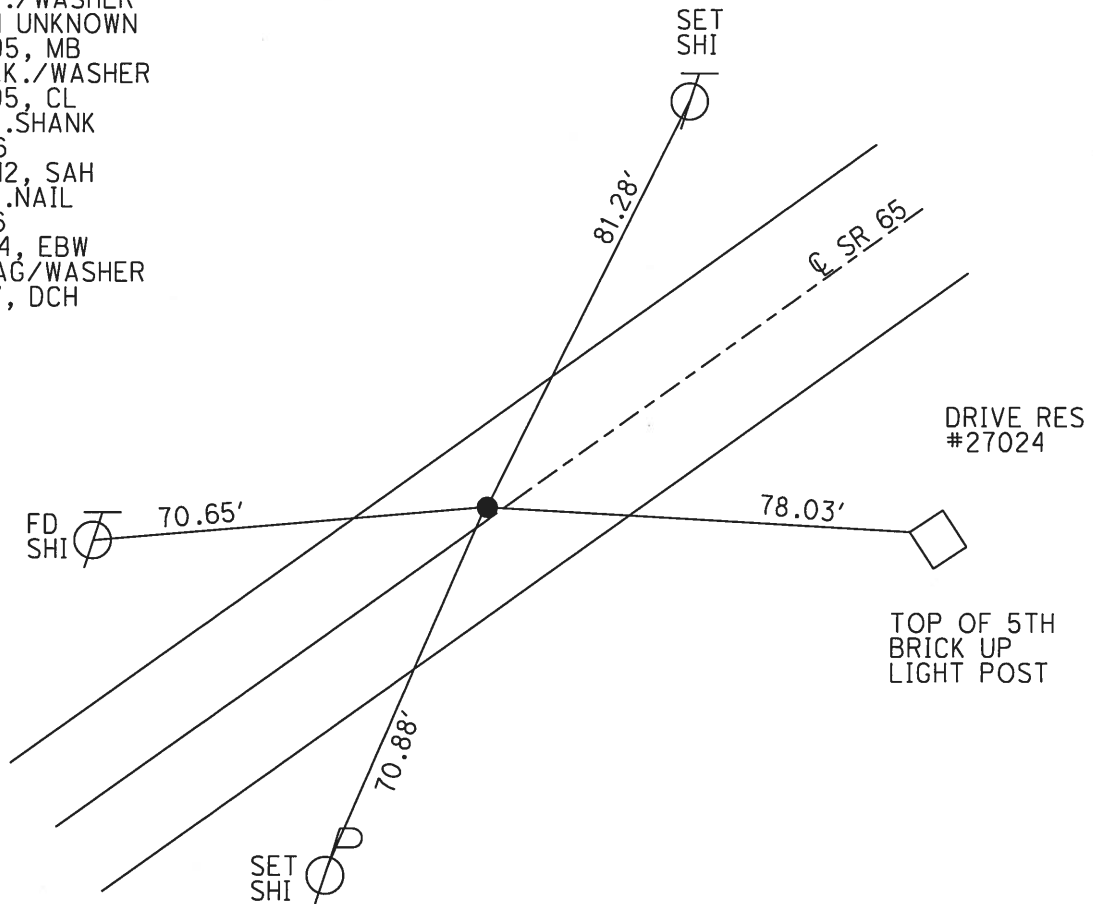

# O.D.O.T. DISTRICT 2 SURVEY OFFICE

PERSONNEL \_\_\_\_\_

REFERENCE NO. \_\_\_\_\_

SHEET 76 OF 91

NOTES BARNHISEL

H.C. CORDES

R.C. BARNHISEL

DATE 5-19-95

WEATHER SUNNY

TEMP. +75°F

ROUTE S.R. 65

COUNTY WOOD

TOWNSHIP DERRYSBURG

SECTION 2563

T 7 N R 10 E


TYPE MONUMENT PK/WASHER

ON SURFACE - BELOW

LEFT - C PAV'T - RIGHT 1.1' LT


9.1 TO LT EDGE PAVEMENT

S.L.M. 848 + 41

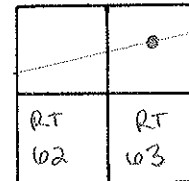

RECORD: SLM 848+41  
 FD. PK/WASHER @ SURFACE;  
 ORIGIN UNKNOWN  
 11-5-84

SET PK/WASHER  
 8-15-95  
 C.L.

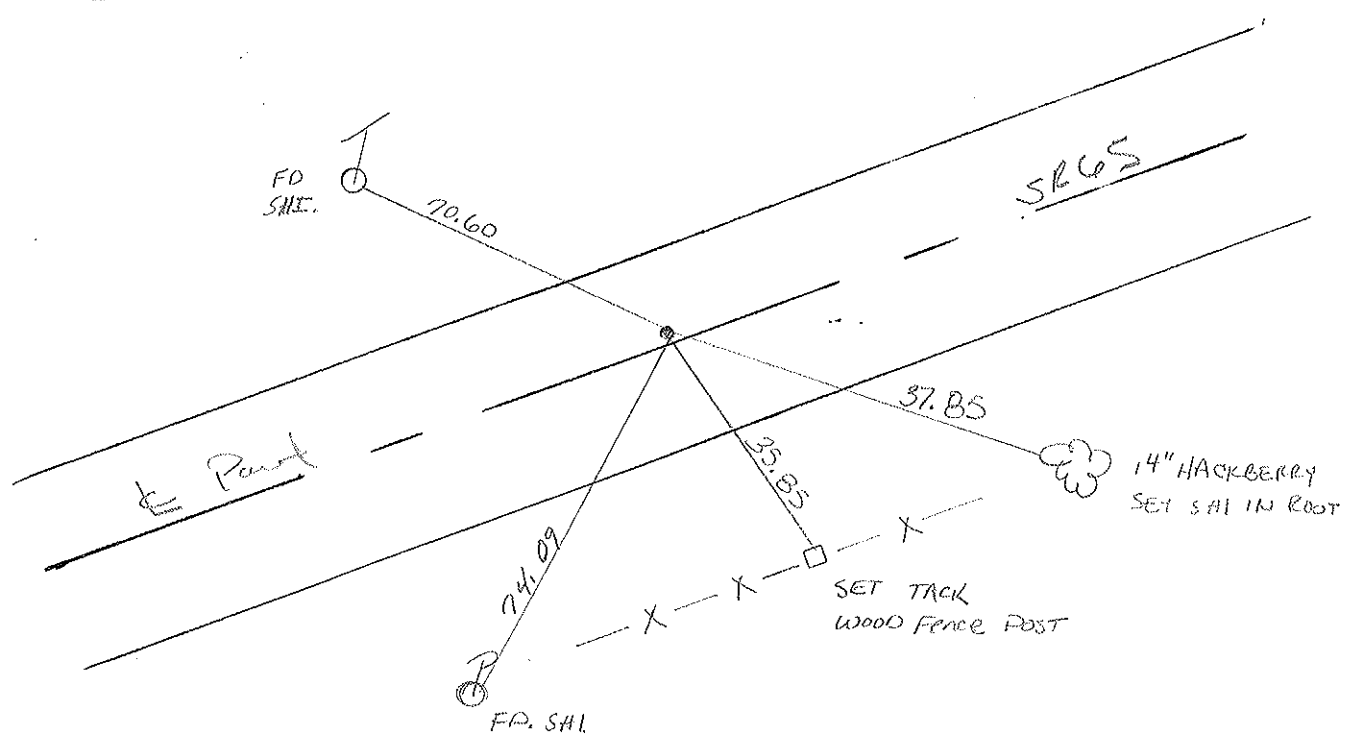

County Wood S.R. 65

Township Perrysburg

Section RT. 63

T7N, R10E

Personnel Noffman

LOENRKE

Householder H.C.

BARNHISEL R.C.

26-6

Date 5-10-84

Weather CLEAR

Temp. 50°

	•
RT	RT
62	63



Fcd R.R. spk @ surface; ORIGINAL UNKNOWN. SLM = 898 + 41

1.0' LT. of & PAUT

9.0' TO LT. EP.

10.8' TO RT. EP.

SET PK/WASHER

11-5-84

SLW.

