


O.D.O.T. DISTRICT 2 SURVEY OFFICE (USE ONLY)


PERSONNEL \_\_\_\_\_ REFERENCE NO. 26 H SHEET 7 OF 25  
 NOTES LEU DATE 8/19/14 ROUTE SR 65  
 H.C. WESTFALL WEATHER SUNNY COUNTY WOOD  
 R.C. RHOADES TEMP. 70° TOWNSHIP PERRYSBURG  
 \_\_\_\_\_ SECTION RT 63  
 \_\_\_\_\_ T 7 N R 10 E

TYPE MONUMENT P.K./WASHER  
 ON SURFACE - ~~BELOW~~ ON \_\_\_\_\_  
 LEFT - CL PAV'T - ~~RIGHT~~ 9.7'  
3.2' TO LT EDGE PAVEMENT  
 S.L.M. 860+11.08

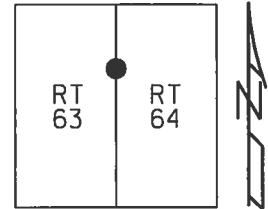

Grid: Northing: 686899.759 Easting: 1649544.162

RECORD: P.I.  
 STA. 857+89.62  
 $\Delta = 10^\circ 20' 20''$   
 FD P.K.  
 11/5/84  
 FD SM.R.R.SPIKE  
 5/19/95, MB  
 SET SM.R.R.SPIKE  
 8/15/95, CL  
 FD SM.R.R.SPIKE  
 REFH26  
 9/24/12, SAH  
 FD P.K./WASHER  
 REFG26  
 8/19/14, DCH

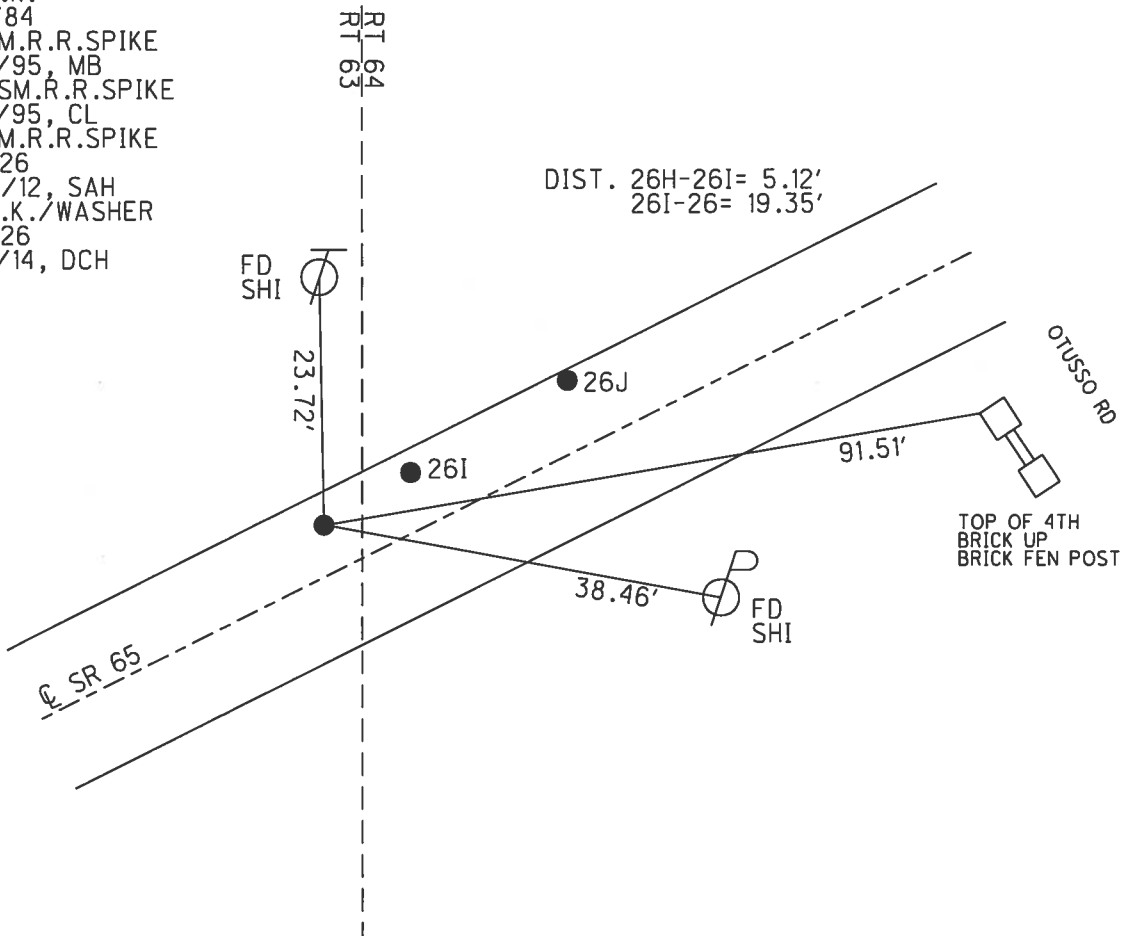

# O.D.O.T. DISTRICT 2 SURVEY OFFICE

PERSONNEL \_\_\_\_\_

REFERENCE NO. \_\_\_\_\_

SHEET 77 OF 91

NOTES BARNHISEL

H.C. COROSS

R.C. BARNHISEL

DATE 5-19-95

WEATHER Sunny

TEMP. +75°

ROUTE S.R. 65


COUNTY WOOD

TOWNSHIP Perrysburg

SECTION 63 & 64

T 7 N R 10 E

TYPE MONUMENT PK WASHER (B+C) ~ sm RR SPIKE (A)  
ON SURFACE - BELOW

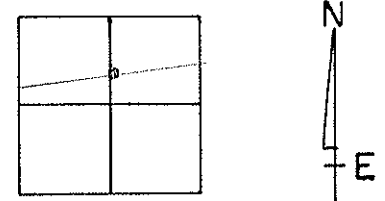

LEFT - C PAV'T - RIGHT A=12.0 B=10.9 C=7.7

<sup>A=9.7</sup>  
<sup>B=4.4 C=4.9</sup> TO LT EDGE PAVEMENT

S.L.M. 858+29

RECORD A:

P.I. STA = 857+89.62  
 $\Delta = 10^\circ - 20' - 20''$  R.T.

FD PK @ SURFACE  
11-5-84


RECORD B:

FD. PK WASHER  
Appears to be on BACK TANG.  
11-5-84

RECORD C:

FD. PK WASHER  
Appears to be on BACK TANG.  
 $\frac{1}{2}$  R.T. LINE  
11-5-84

SET SM. RR SPIKE ON PT A  
SET PK/WASHER PT'S B & C  
8-15-95  
CL.

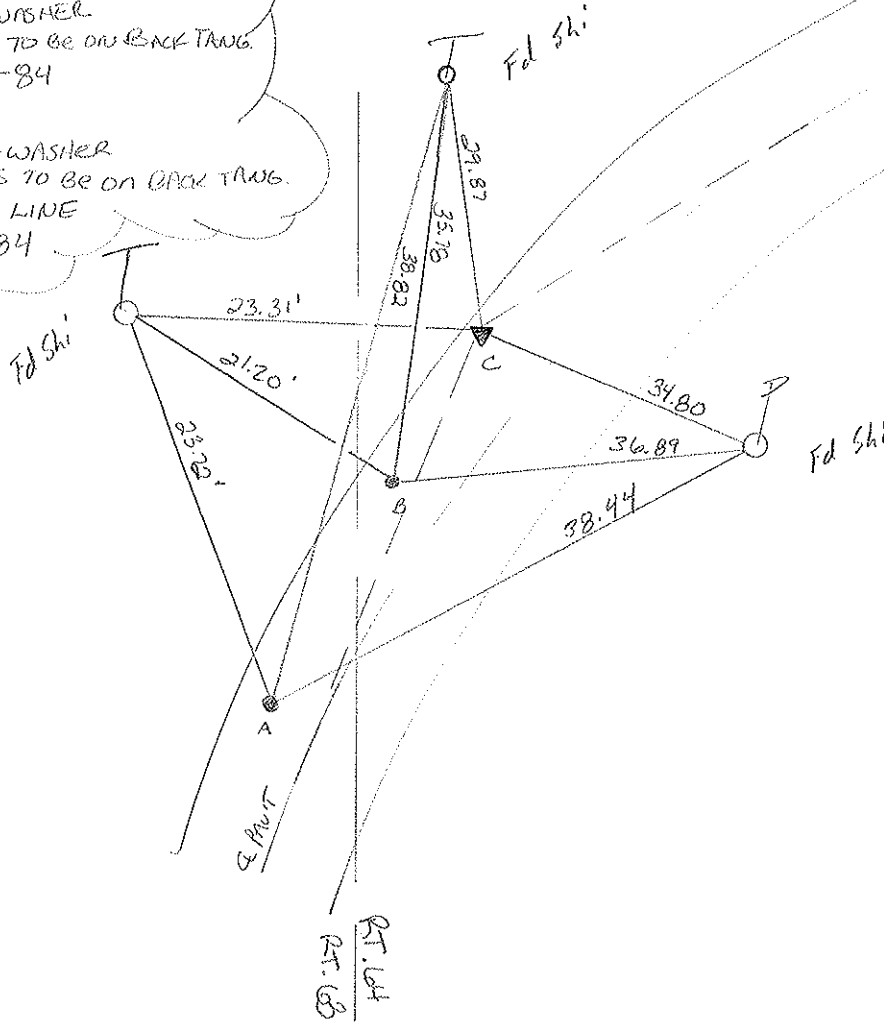



County WOOD S.R. 65

Township PERRYSBURG

Section RT. 63

T1N, R10E

Personnel HOFFMAN

26-H

LOENRKE

26-I

HOUSEHOLDER



26-J

BARANISEL

Date 5-10-84

Weather CLEAR

Temp. 50°

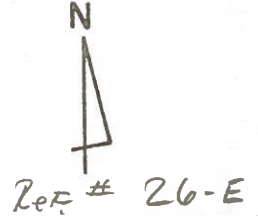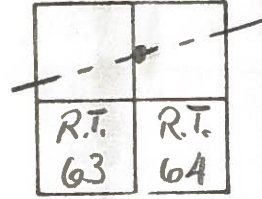

SLM = 858+29

SET PK/WASHER

@ PT 'A' + PT 'D'

SET PK @ PT C

11-5-84

SWH

DID NOT SET 'B' OR 'E'

"A" Fd P.K. @ SURFACE  
7.4' LT. of & PAWT  
2.5' TO LT. EP.  
16.8' TO RT. EP.

Record!  
P.I. STA = 857+89.62  
A = 10°-20'-20" RT.



Set shi 8"  
48.33

"B" Fd PK @ SURFACE  
9.5' LT. of & PAWT  
APPEARS TO BE ON  
FWD TANG. & R.T. LINE

"C" Fd P.K. @ SURFACE  
5.7' LT. of & PAWT  
APPEARS TO BE ON  
BACK TANG.

"D" Fd R.R. SPK @ SURFACE  
5.4' LT. of & PAWT  
APPEARS TO BE ON  
BACK TANG. &  
R.T. LINE

"E" Fd R.R. SPK  
@ SURFACE  
APPEARS TO  
BE ON  
R.T. LINE

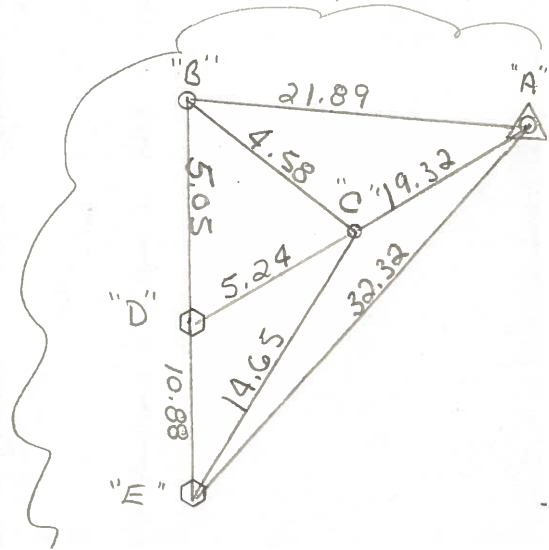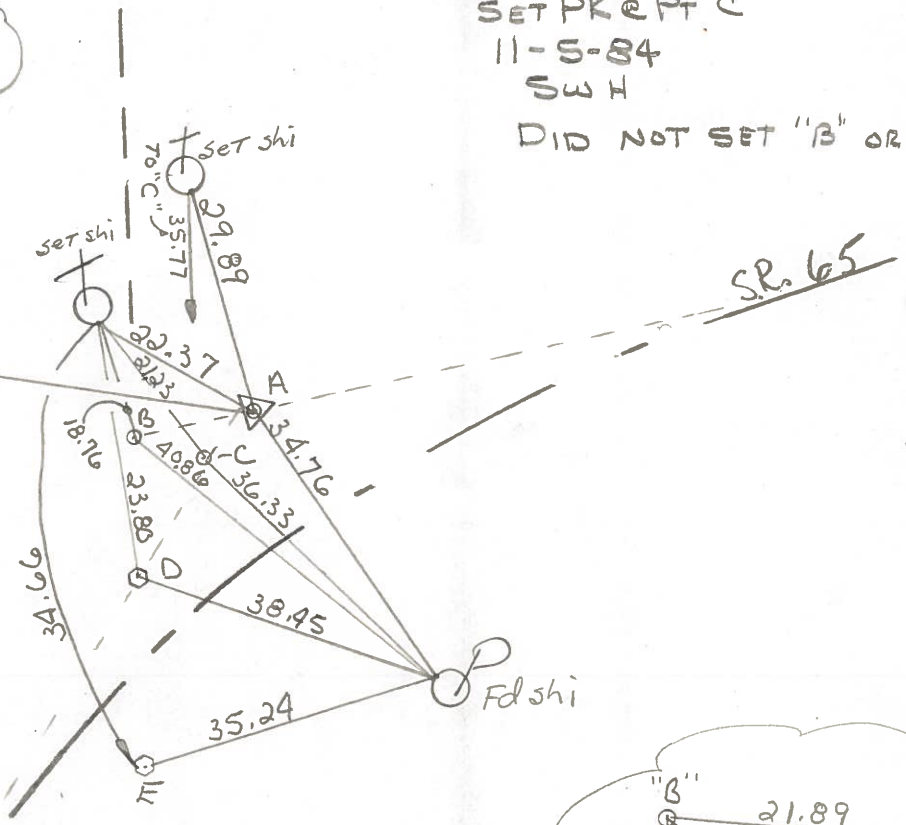

R.T. 64  
R.T. 63

County Wood S.R. #65

Date 7 Aug. 80

Township Perrysburg

Weather Warm


Section RT-64

Temp. 800

T    N, R    E


Personnel 1. Stone  
R. Michalak  
P. Neuser  
D. Curtis

26-H

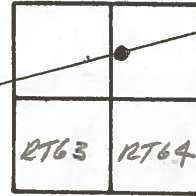

26-E

RT-63 E

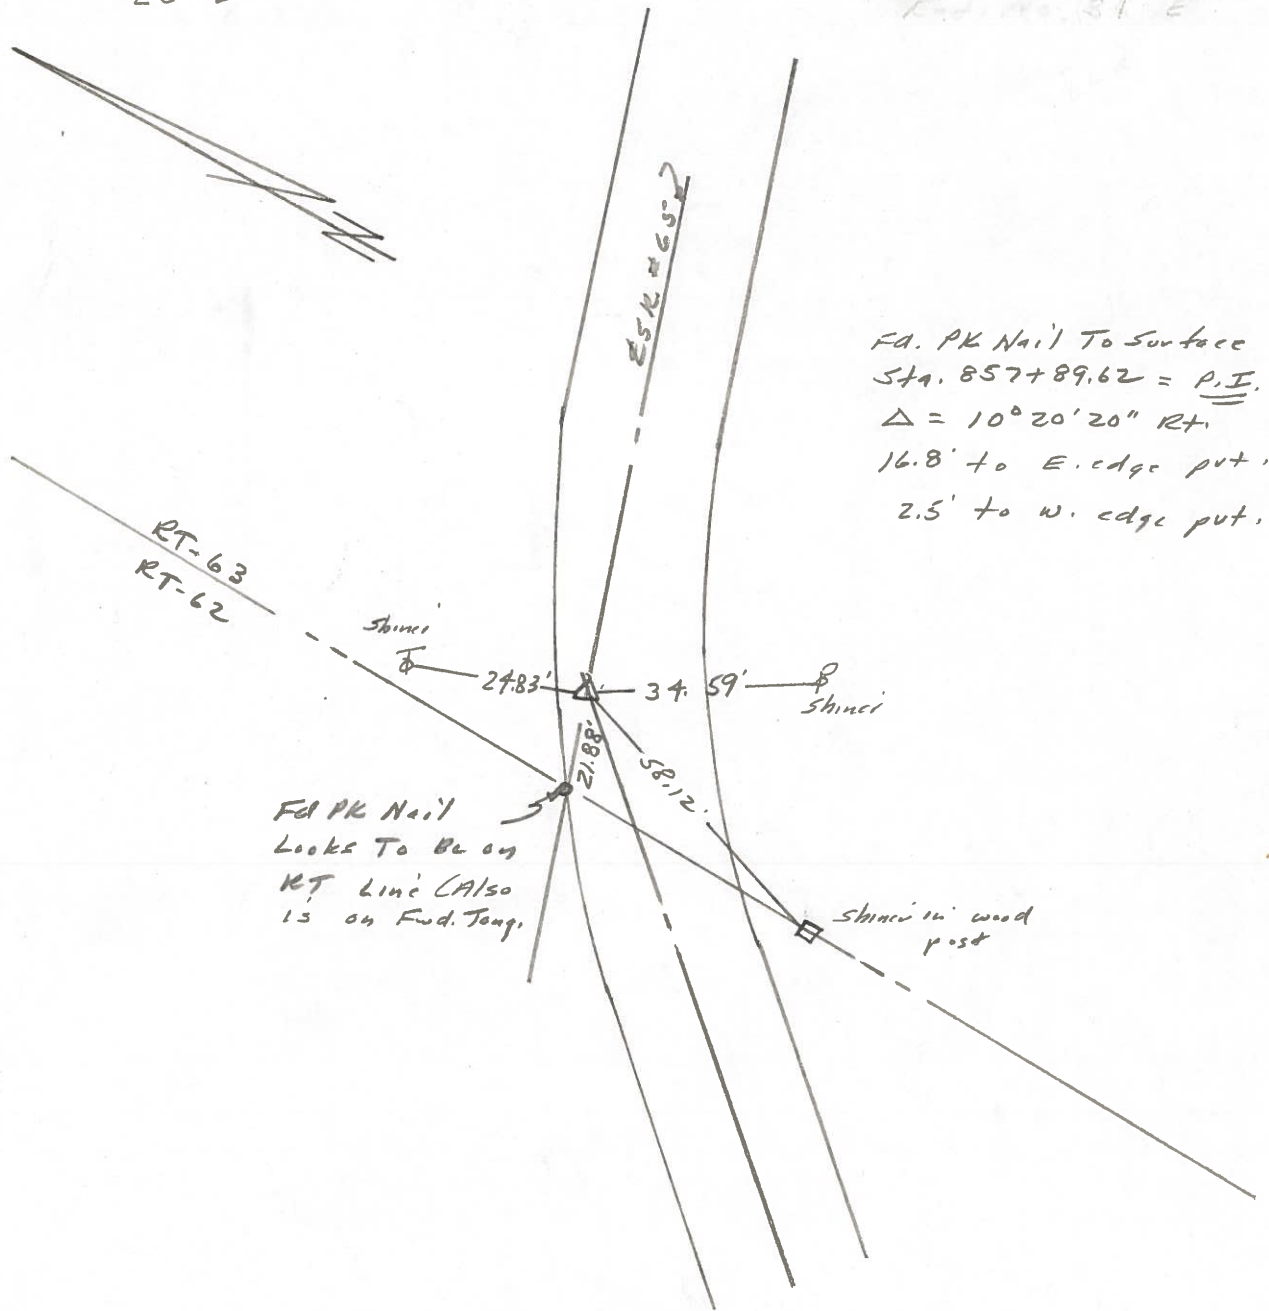

Fd. PK Nail To Surface  
Sta. 857+89.62 = P.I.  
 $\Delta = 10^{\circ} 20' 20''$  RT.  
16.8' to E. edge put.  
2.5' to W. edge put.

Fd PK Nail  
Looks To Be on  
RT Line (Also  
is on Fwd. Tang.)

Shiner in wood  
post