


O.D.O.T. DISTRICT 2 SURVEY OFFICE (USE ONLY)

PERSONNEL _____ REFERENCE NO. 26 R SHEET 14 OF 25


NOTES LEU DATE 8/19/14 ROUTE SR 65
 H.C. WESTFALL WEATHER SUNNY COUNTY WOOD
 R.C. RHOADES TEMP. 72° TOWNSHIP PERRYSBURG
 SECTION RT 64
T 7 N R 10 E

TYPE MONUMENT MAG NAIL
~~ON SURFACE~~ - BELOW 2"
~~LEFT~~ - CL PAV'T - RIGHT 1.7'
7.9' TO RT EDGE PAVEMENT
 S.L.M. 875+58.45

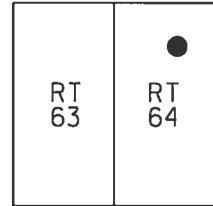

Grid: Northing: 687574.349 Easting: 1650936.303

RECORD: P.I.
 STA. 873+13.01
 $\Delta = 0^\circ 06' 40''$ LT
 FD BOAT SPIKE
 5/10/84, SAH
 FD P.K./WASHER
 5/18/95, SAH
 SET P.K./WASHER
 8/15/95, CL
 FD P.K./WASHER
 REFR26
 9/24/12, SAH
 FD P.K./WASHER
 REFJJ26
 8/19/14, EBW
 SET MAG/WASHER
 6/8/17, DCH

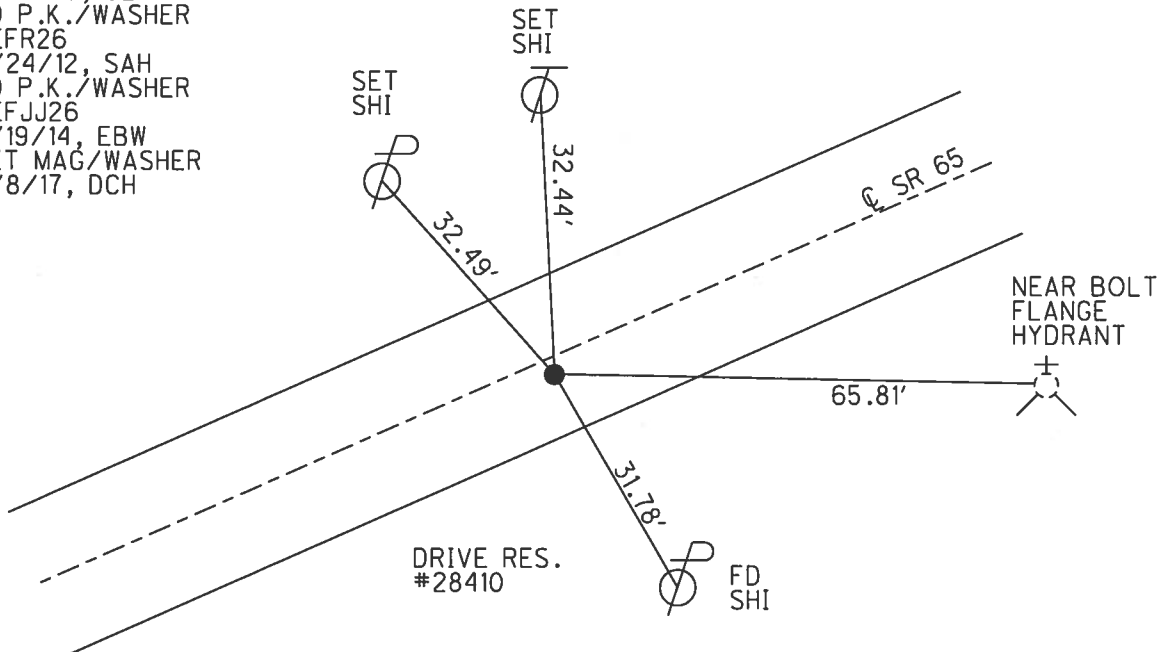

O.D.O.T. DISTRICT 2 SURVEY OFFICE

PERSONNEL

REFERENCE NO. 26 J

SHEET 82 OF 91

NOTES Don Dusen

H.C. Moser

R.C. Huss

DATE 5-18-95

WEATHER Cloudy

TEMP. +55° F.

ROUTE SR 65

COUNTY Wood

TOWNSHIP Perrysburg

SECTION RT-64

T 7 N R 10 E


TYPE MONUMENT PK/Washer

ON SURFACE - ~~BELOW~~ on surface


~~LEFT~~ - PAV'T. - RIGHT Right of R

8.1 TO RT. EDGE PAVEMENT

S.L.M. 873 +51

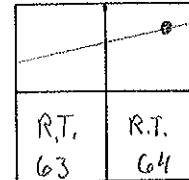

Set PK/Washer
8-15-98 C.L.

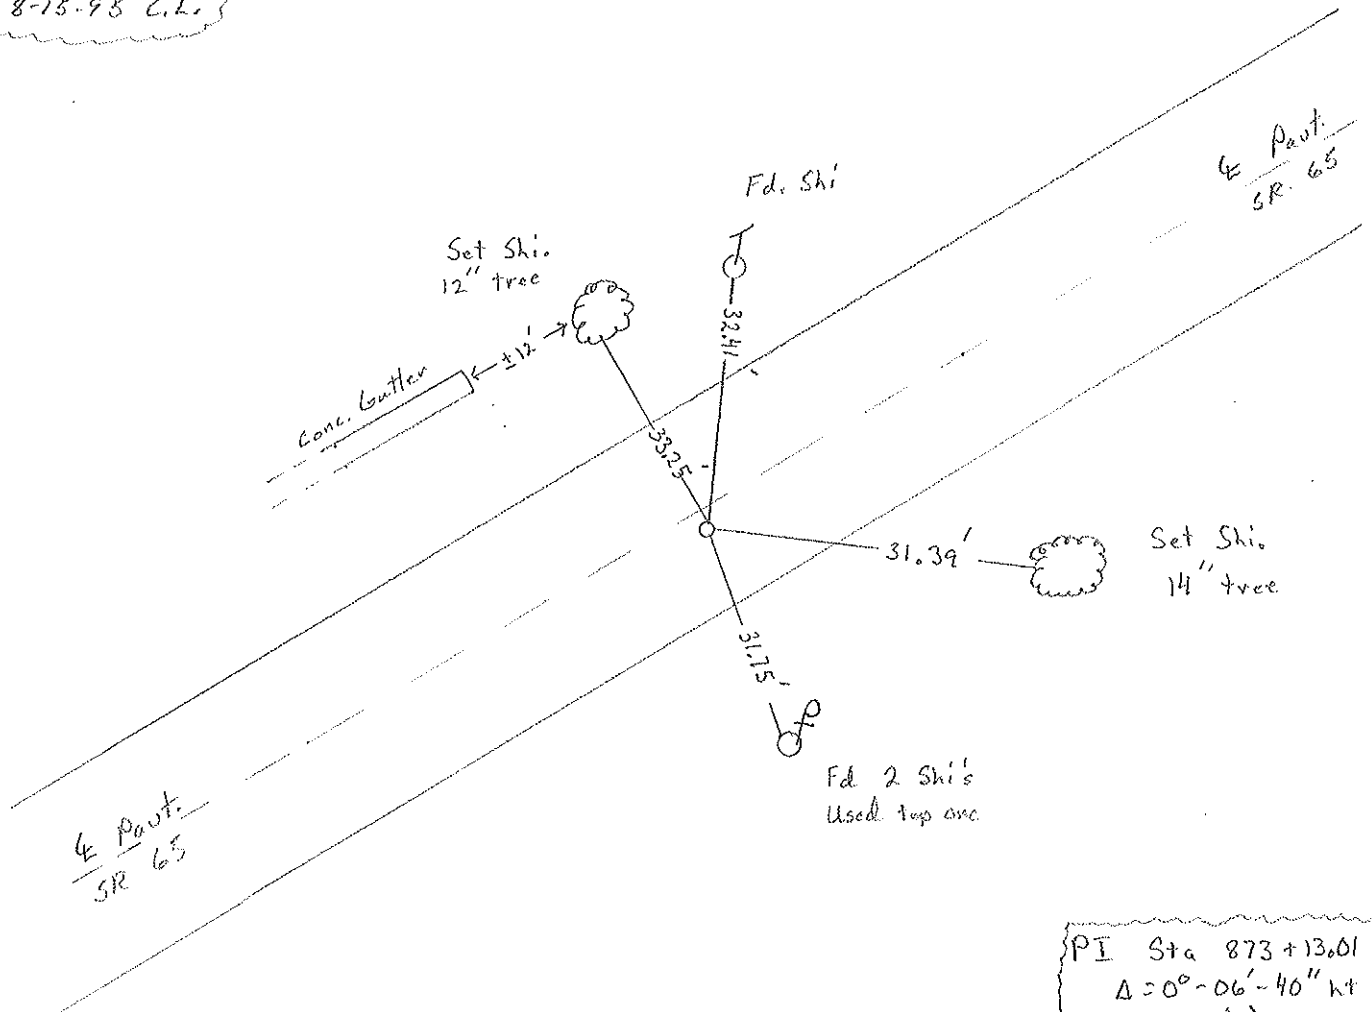

PI Sta 873 +13.01
 $\Delta = 0^{\circ} - 06' - 40''$ ht
 (Record)
 Fd. Road Spk. 2 surface
 1.5' RT G
 7.8' RT EOP 5-10-84
 11.5' LT EOP S.H.

County Wood S.R. 65

Date 5-10-84

Township PERRYSBURG

Weather CLEAR

Section R.T. - 64

Temp. 60°

TZN, R/OE


Personnel HOFFMAN

LOEHRKE

HOUSEHOLDER H.C.

BARWISSEL R.C.

26-R

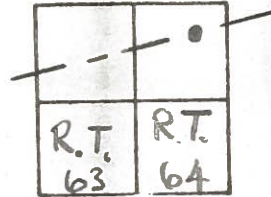

26-J

Fd BOAT SPK @ surface

1.5' RT. of & PAVT

7.8' TO RT. EP.

11.5' TO LT. EP.

SLM 873+51

SET PK/WASHER


11-5-84

S.W.H.

Record:

P.I. STA = 873+13.01

A = 0°-06'-40" LT.

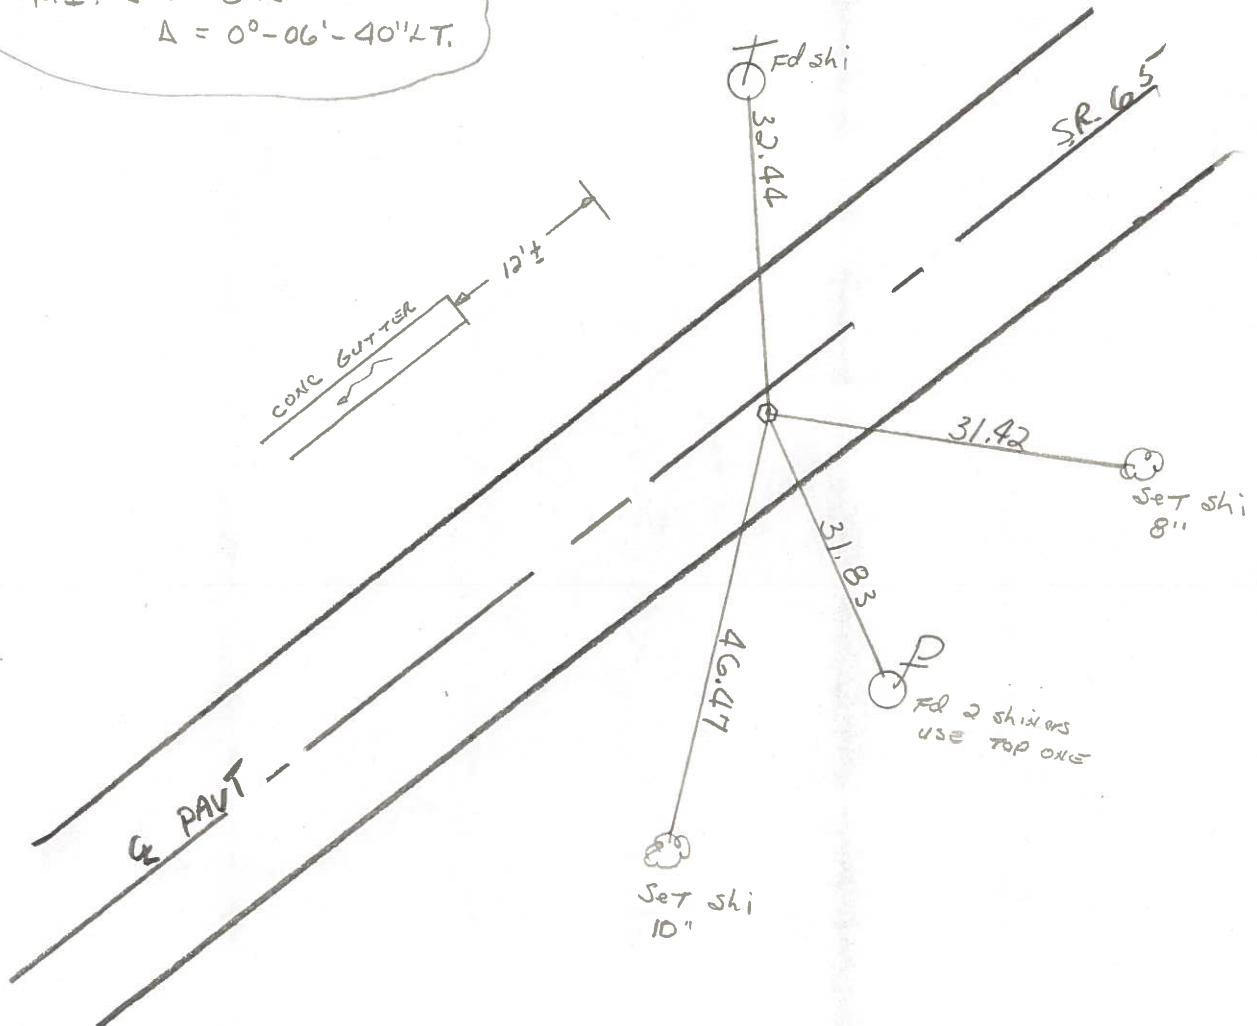

OD.O.T. DISTRICT 2 SURVEY OFFICE

Sht. ___ of ___

County Wood S.R. #65

Date 5 Aug 80

Township Perryburg

Weather Humid

Section RT. 64

Temp. 80°

T_N, R_E


Personnel I. Stone

R. Michalke

P. Newco



D. Curtis

26-R

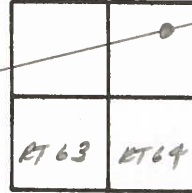

26-J

Ref. No. 36

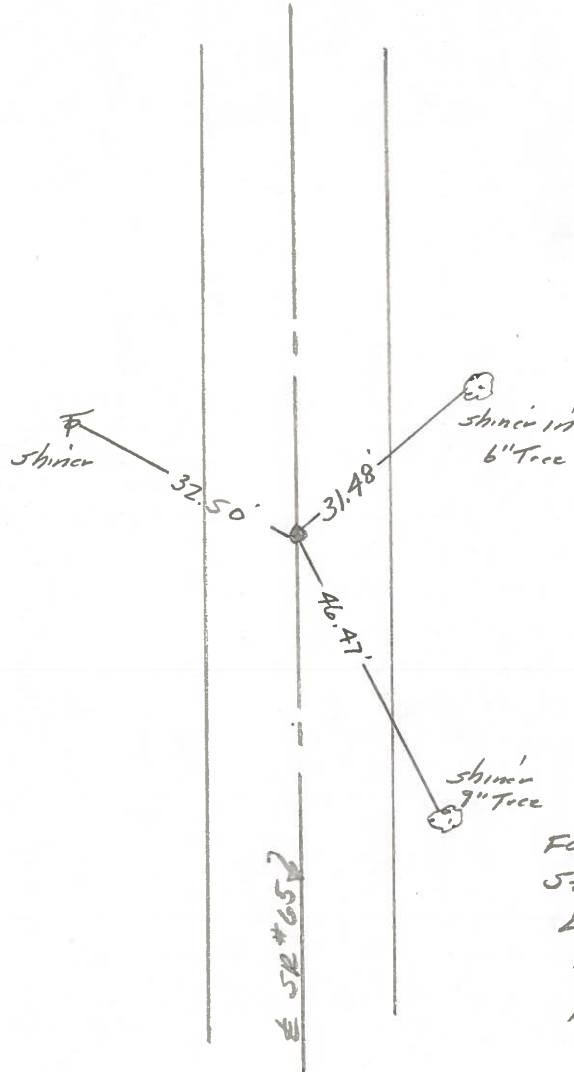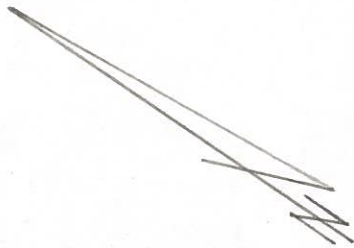

Ed. Beat 5pk. To Sur tree
 Sta. 873+13.01 = P.I.
 $\Delta = 0^{\circ} 06' 40''$ Lt.
 7.8' to E. edge put.
 11.5' to W. edge put.

PERSONNEL TITLE PERSONNEL TITLE
 BURNSIDE _____
 SMITH _____
 BOWERS _____
 SARDEJA _____

COUNTY Wood DATE 4-30-71
 S. R. #65 WEATHER CLEAR
 SEC. 11.96 To 15.53 TEMP. +60°

DESCRIPTION CONTROL POINTS PERRYSBURG TWP JOB NO. _____
 LEFT CENTER LINE RIGHT

