


O.D.O.T. DISTRICT 2 SURVEY OFFICE (USE ONLY)


PERSONNEL _____ REFERENCE NO. 26 S SHEET 15 OF 25

NOTES LEU DATE 8/19/14 ROUTE SR 65
 H.C. WESTFALL WEATHER SUNNY COUNTY WOOD
 R.C. RHOADES TEMP. 75° TOWNSHIP PERRYSBURG
 SECTION RT 64
 T 7 N R 10 E

TYPE MONUMENT P.K./WASHER
 ON SURFACE - ~~BELOW~~ ON _____
~~LEFT~~ - CL PAV'T - RIGHT 3'
6.9' TO RT EDGE PAVEMENT
 S.L.M. 882+14.29
 Grid: Northing: 687857.622 Easting: 1651527.816

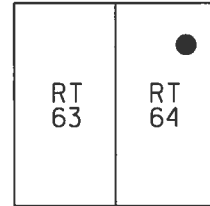

RECORD:
 FD P.K./WASHER
 5/10/84, SAH
 FD P.K./WASHER
 5/18/95, SAH
 SET P.K./WASHER
 8/15/95, CL
 FD P.K./WASHER
 REFS26
 9/24/12, SAH
 FD P.K./WASHER
 REFKK26
 8/19/14, EBW
 SET MAG/WASHER
 6/8/17, DCH

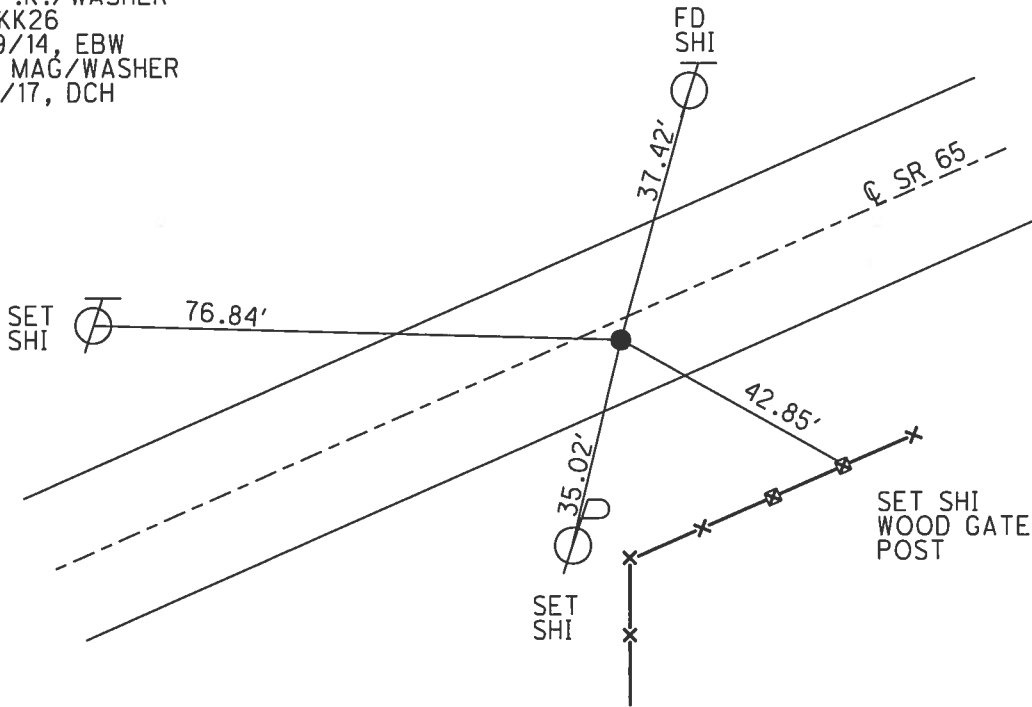

O.D.O.T. DISTRICT 2 SURVEY OFFICE

PERSONNEL

REFERENCE NO. 26K

SHEET 83 OF 91

NOTES Van Dusen

H.C. Moser

R.C. Huss

DATE 5-18-95

WEATHER Cloudy

TEMP. +55° F.

ROUTE SR-65

COUNTY Wood

TOWNSHIP Perrysburg

SECTION RT 64

T 7 N R 10 E


TYPE MONUMENT RK/Washer

ON SURFACE - ~~BELOW~~ on surface


LEFT - C PAV'T. - RIGHT 2.4' RT of C

7.2 TO RT EDGE PAVEMENT

S.L.M. 880+08

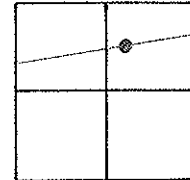

Set PK/Washer
8-15-95 C.L.

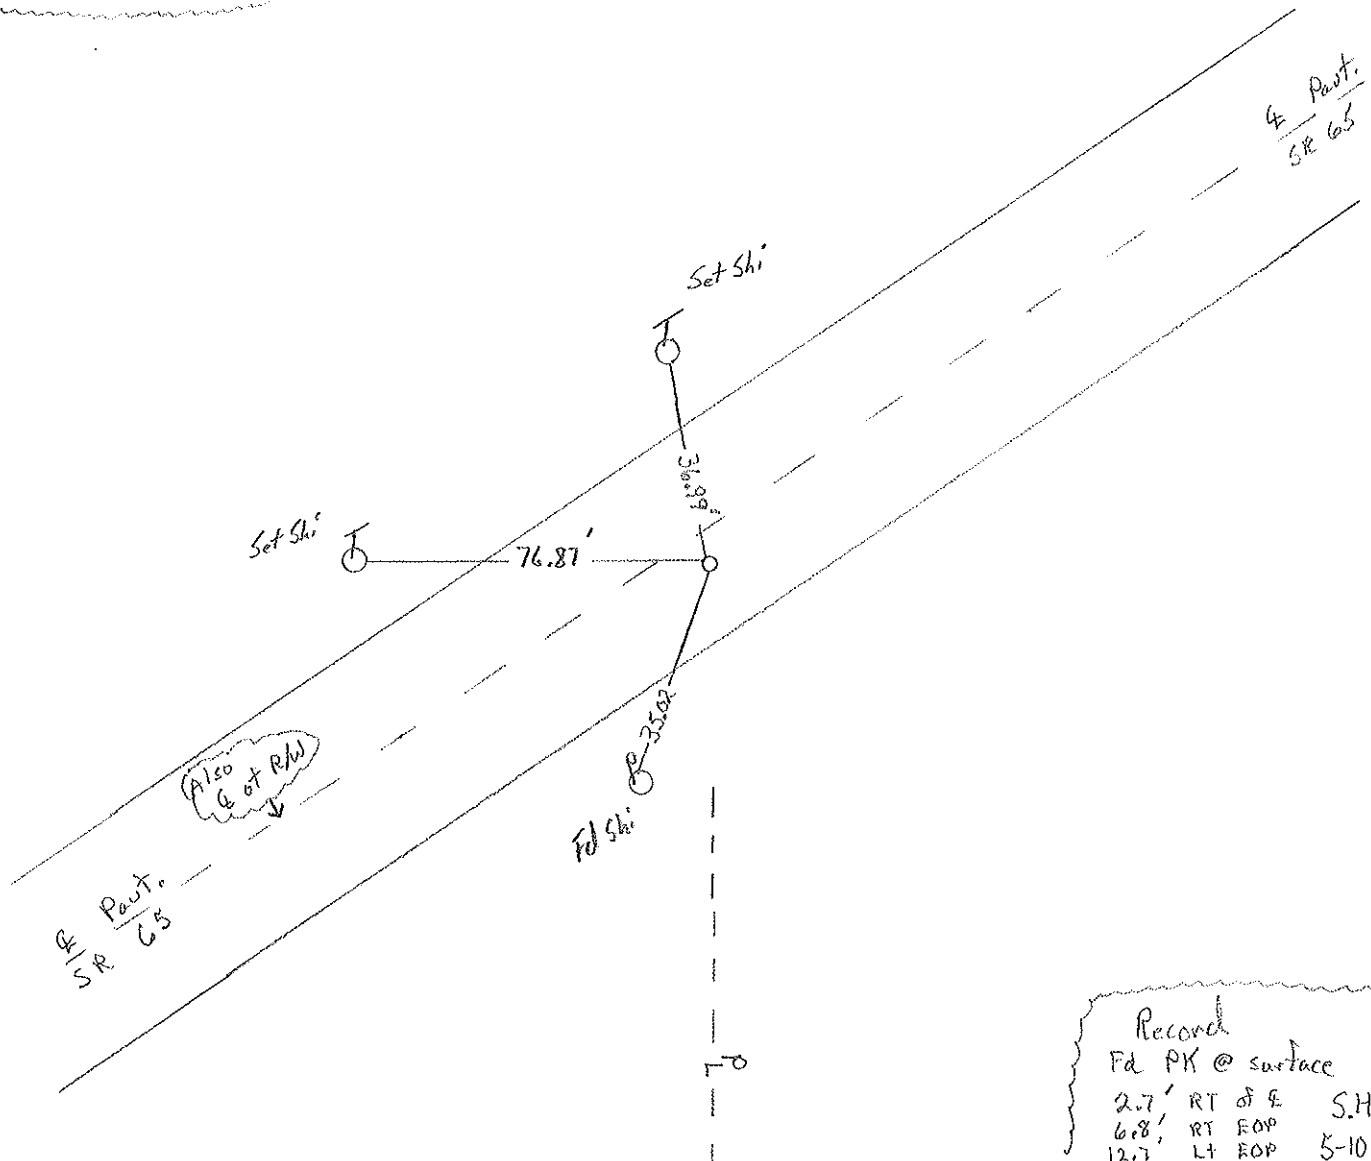

Recon'd
Fd PK @ surface
2.7' RT of E S.H.
6.8' RT EOP
12.7' LT EOP 5-10-84

County WOOD S.R. 65

Township PERRYS BURG

Section RT-64

T7N, R10E

Personnel HOFFMAN

LOENRKE


HOUSEHOLDER H.C.

BARNHISEL R.C.

Date 5-10-84

Weather CLEAR

Temp. 60°

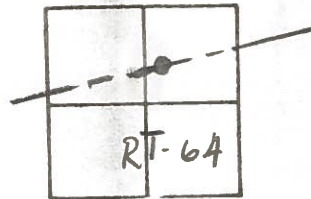

26-K

26-S

Fd P.K. @ surface

2.7' RT. of & PAVT

6.8' TO RT. EP.

12.7' TO LT. EP.


SLM 880+08

SET P.K./WASHER

11-5-84

S.W.H.


NOTE: P.K. NAIL IS
2.4' RT. OF & RW

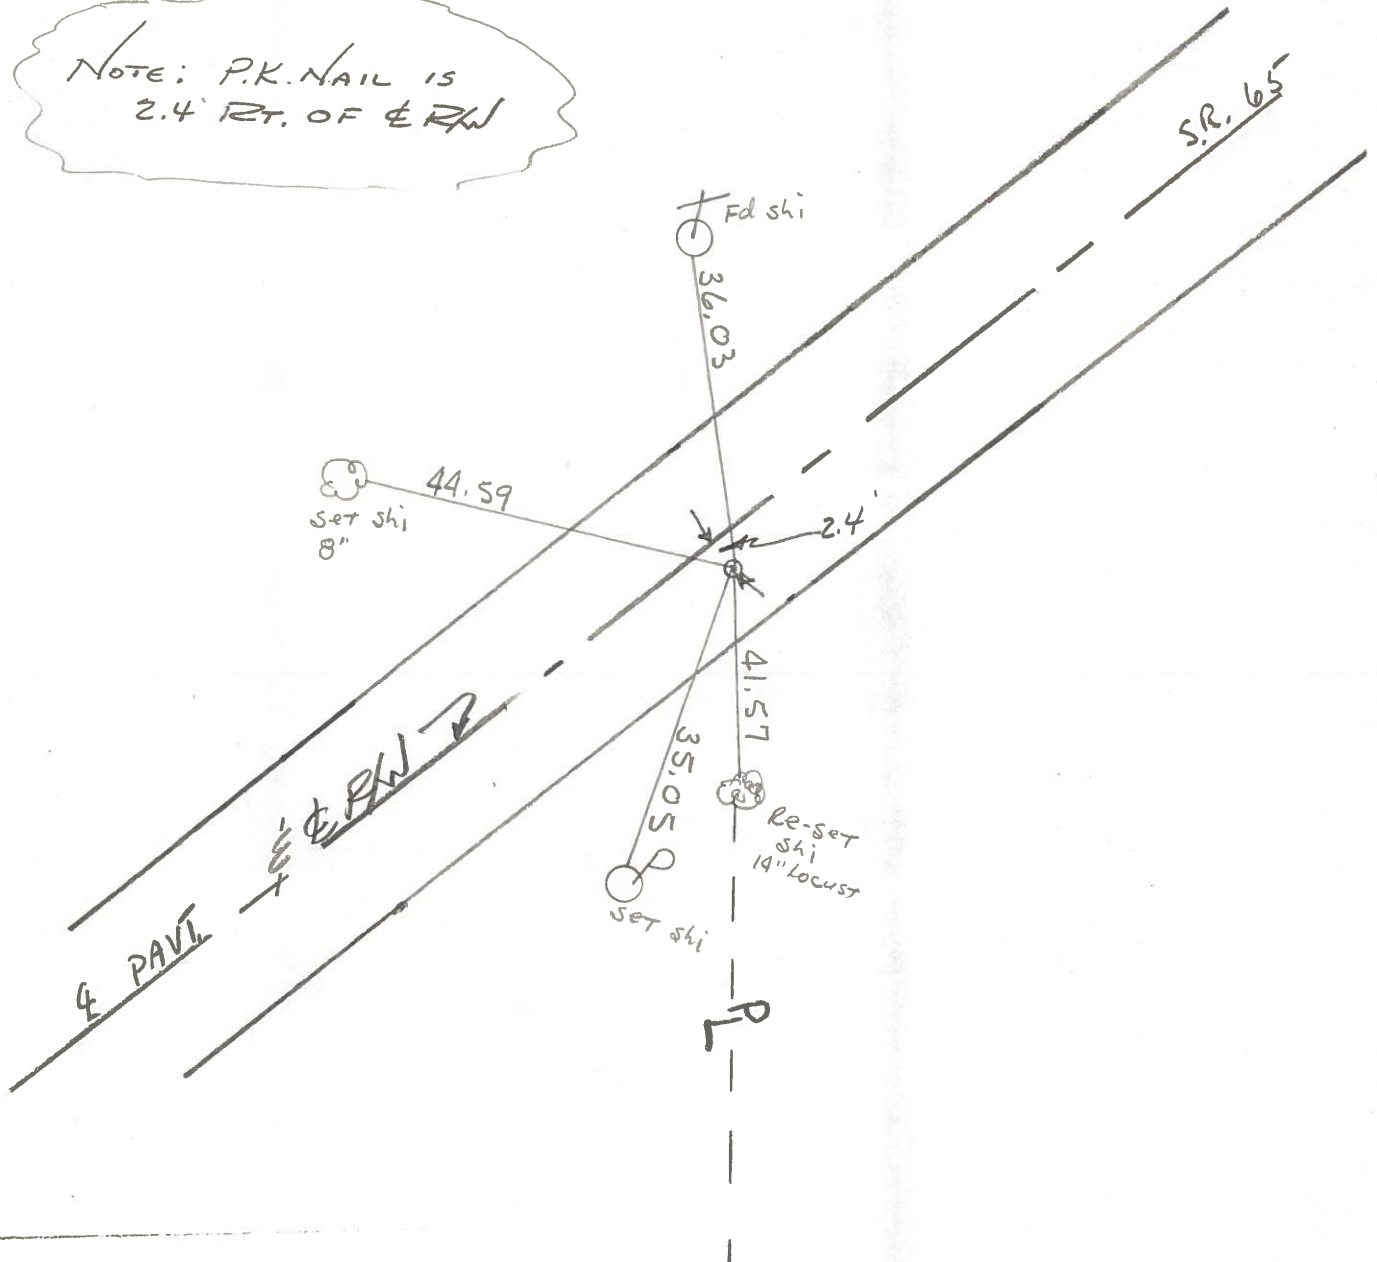

PERSONNEL TITLE PERSONNEL TITLE
BURNSIDE _____
SMITH _____
BOWERS _____
SARDEJA _____

COUNTY WOOD DATE 4-30-71
 S. R. #65 WEATHER CLEAR
 SEC. 11.96 To 15.53 TEMP. +60°

DESCRIPTION CONTROL POINTS PERRYSBURG TWP JOB NO. _____
 LEFT CENTER LINE RIGHT

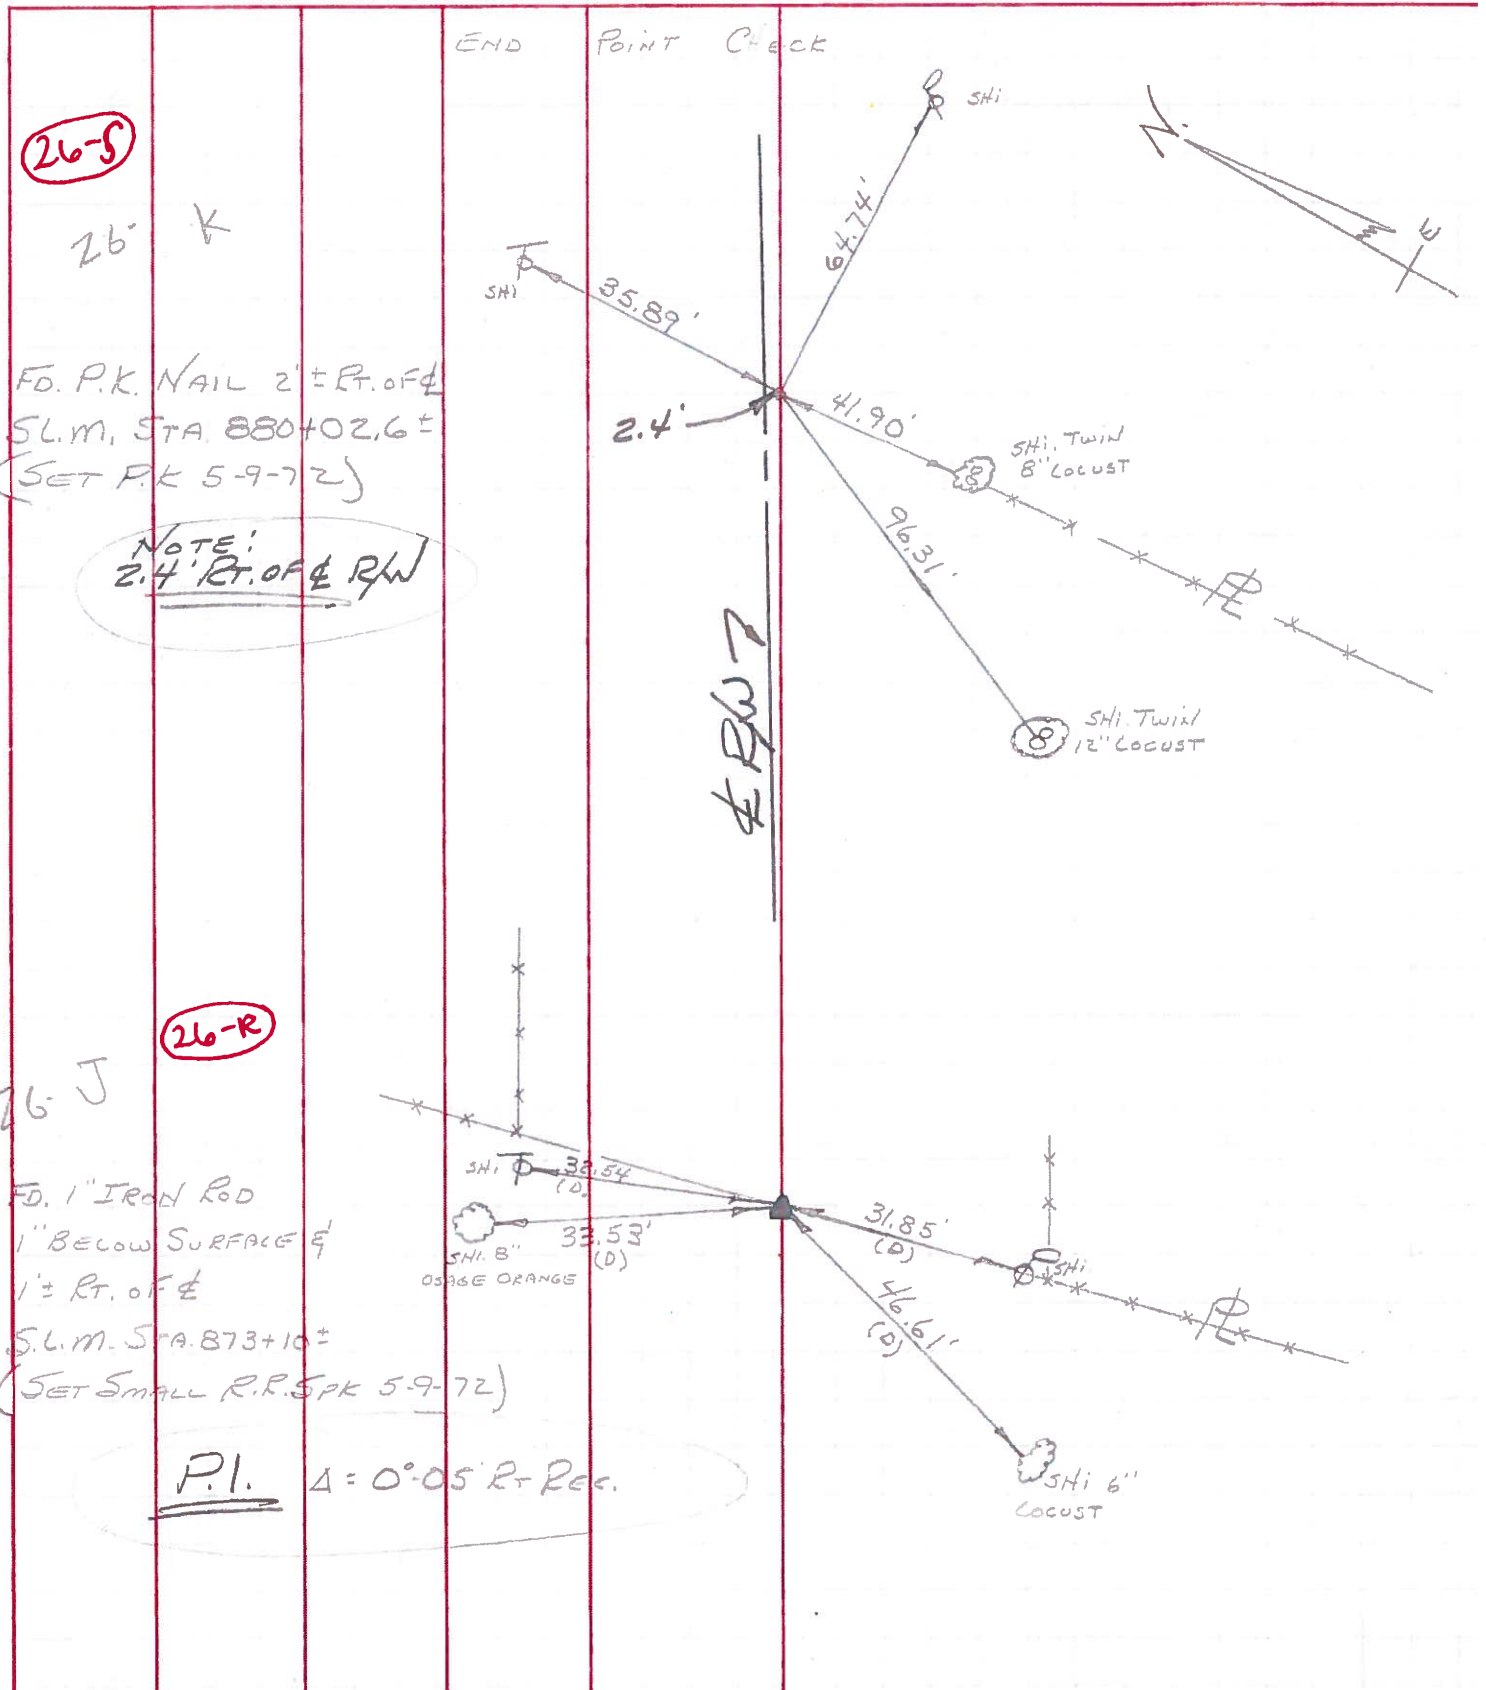

26-S

26' K

9-72
 FD. P.K. NAIL 2' ± RT. OF C'
 S.L.M. STA. 880+02.6 ±
 (SET P.K. 5-9-72)

NOTE:
2.4' RT. OF C' R/W

26-R

26' J

9-72
 FD. 1" IRON ROD
 1" BELOW SURFACE 1/2
 1/2 ± RT. OF C'
 S.L.M. STA. 873+10 ±
 (SET SMALL R.R. SPK 5-9-72)

P.I. Δ = 0°-05' Rt Rec.