


O.D.O.T. DISTRICT 2 SURVEY OFFICE (USE ONLY)


PERSONNEL _____ REFERENCE NO. 26 T SHEET 16 OF 25
 NOTES LEU DATE 8/19/14 ROUTE SR 65
 H.C. WESTFALL WEATHER SUNNY COUNTY WOOD
 R.C. RHOADES TEMP. 70° TOWNSHIP PERRYSBURG
 _____ SECTION RT 64
 _____ T 7 N R 10 E

TYPE MONUMENT MONBOX
 ON SURFACE - ~~BELOW~~ ON
 LEFT - ☉ PAV'T - RIGHT ON
9.9' TO RT. EDGE PAVEMENT
 S.L.M. 885+11.60

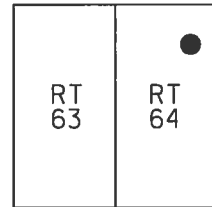

Grid: Northing: 687989.256 Easting: 1651794.392

RECORD: T.S.
 STA. 882+66.24
 FD MONBOX
 W/ "+" ON LID
 5/11/84, SAH
 FD MONBOX
 5/18/95, SAH
 FD MONBOX
 REFL26
 9/24/12, SAH
 FD MONBOX
 W/ "+" ON LID
 REFL26
 8/19/14, EBW

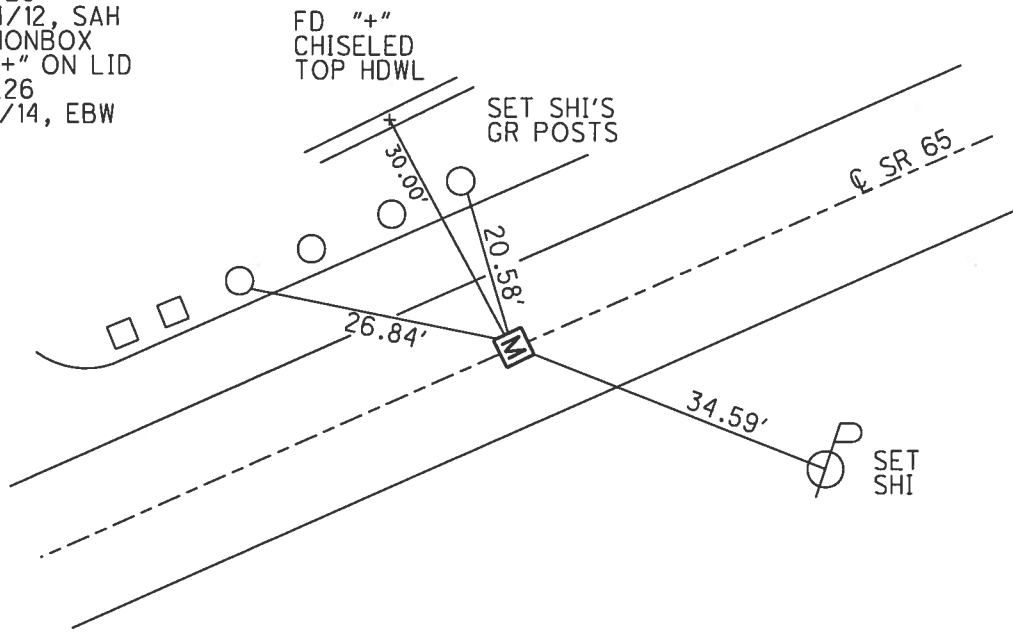

O.D.O.T. DISTRICT 2 SURVEY OFFICE

PERSONNEL

REFERENCE NO. 26-h

SHEET 84 OF 91

NOTES Van Dusen

H.C. Moser

R.C. Huss

DATE 5-18-95

WEATHER Cloudy

TEMP. +55° F.

ROUTE S.R. 65

COUNTY Wood

TOWNSHIP Perrysburg

SECTION RT-65

T.7 N. R. 10 E


TYPE MONUMENT Mon box

ON SURFACE - ~~BELOW~~ on surface


LEFT - (E) PAV'T - RIGHT on E

10.2 TO RT EDGE PAVEMENT

S.L.M. 883+05

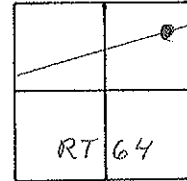

*Fd on Surface
5-18-95 B.U.*

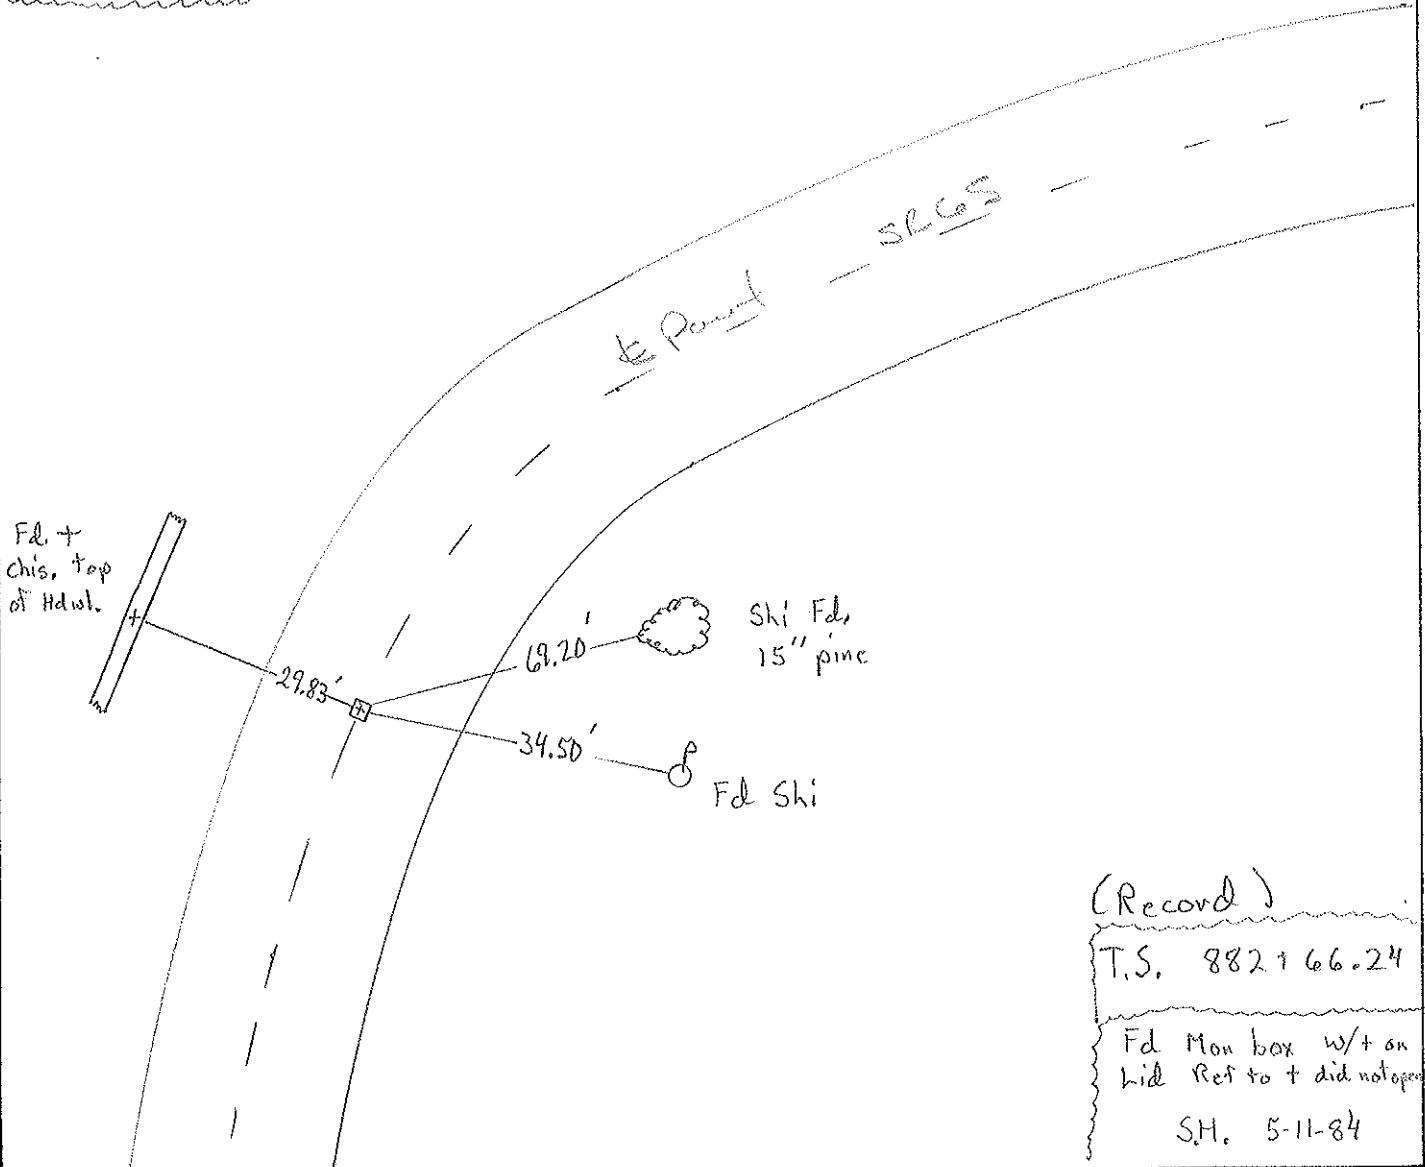

County WOOD S.R. 65

Date 5-11-84

Township PERRYSBURG

Weather P. CLEAR

Section R.T. 65

Temp. 60°

T7N, R10E


Personnel HOFFMAN

LOEHRKE

HOUSEHOLDER H.C.

BARNHISEL R.C.

26-T

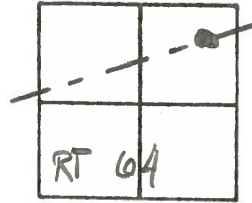


Fd mon. box w/ "+" on lid
Ref to "+"; DID NOT OPEN

SLM 883+05

ON ♀ PAUT
12.0' TO LT. EP.
11.7' TO RT. EP

Q SURFACE
11-5-84
S.W.H.

RECORD!
T.S. STA. 882+66.24

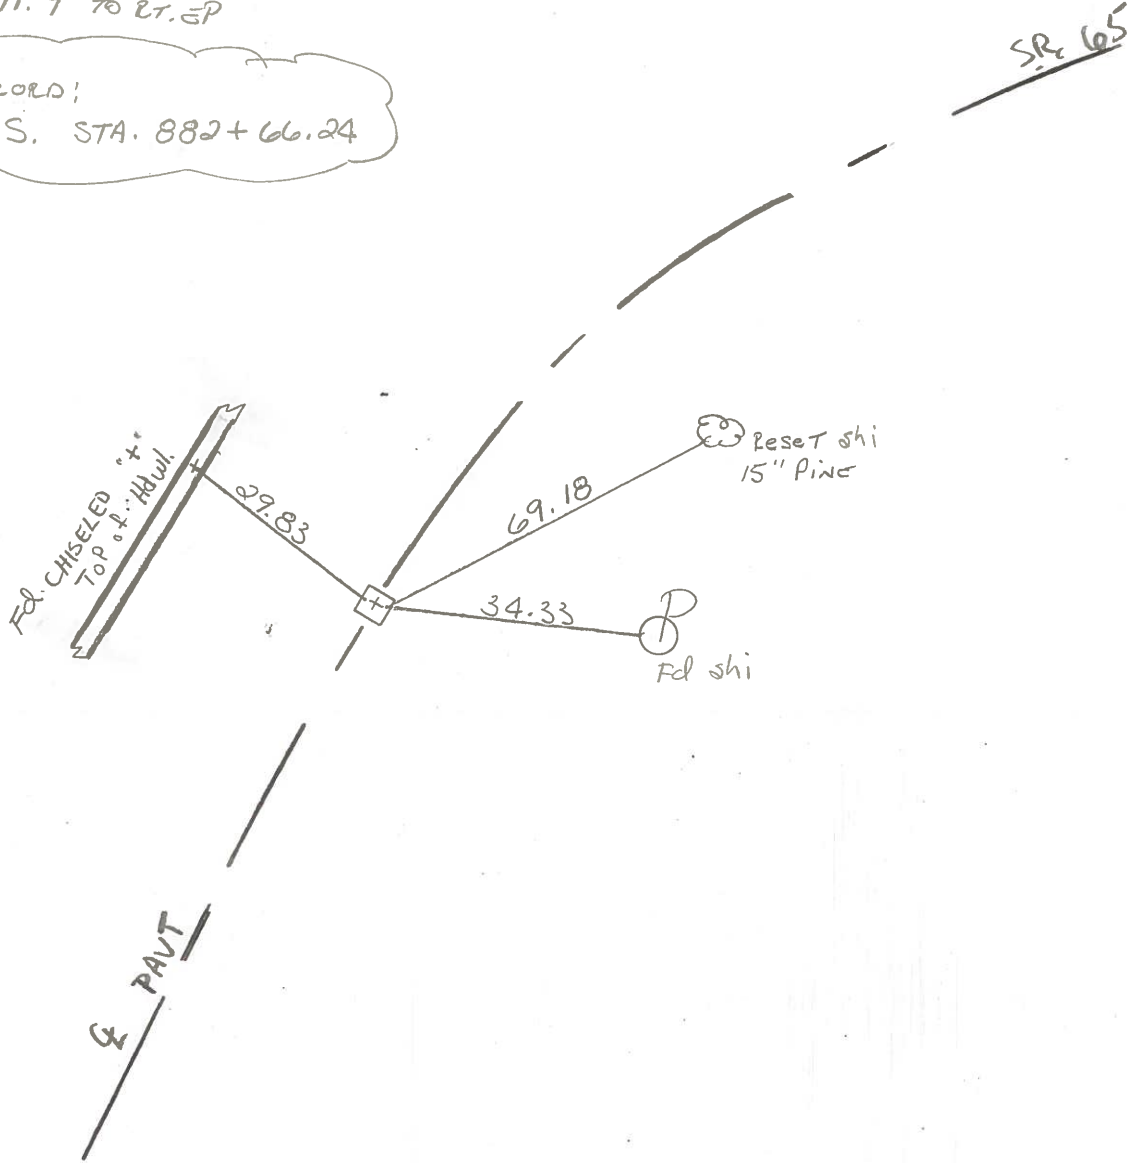

O.D.O.T. DISTRICT 2 SURVEY OFFICE

SHEET _____ OF _____

County Wood S.R. # 65

Date 5 Aug. 80

Township Kingsburg

Weather Humid

Section RT. 64

Temp. 80°

T N, R E


Personnel I. Stone

P. Neuse

R. Michalski


D. Curtis

26-T

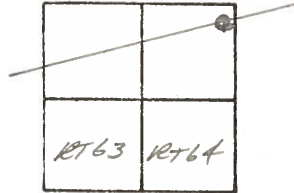

26-L

RT. 64 S.Y.

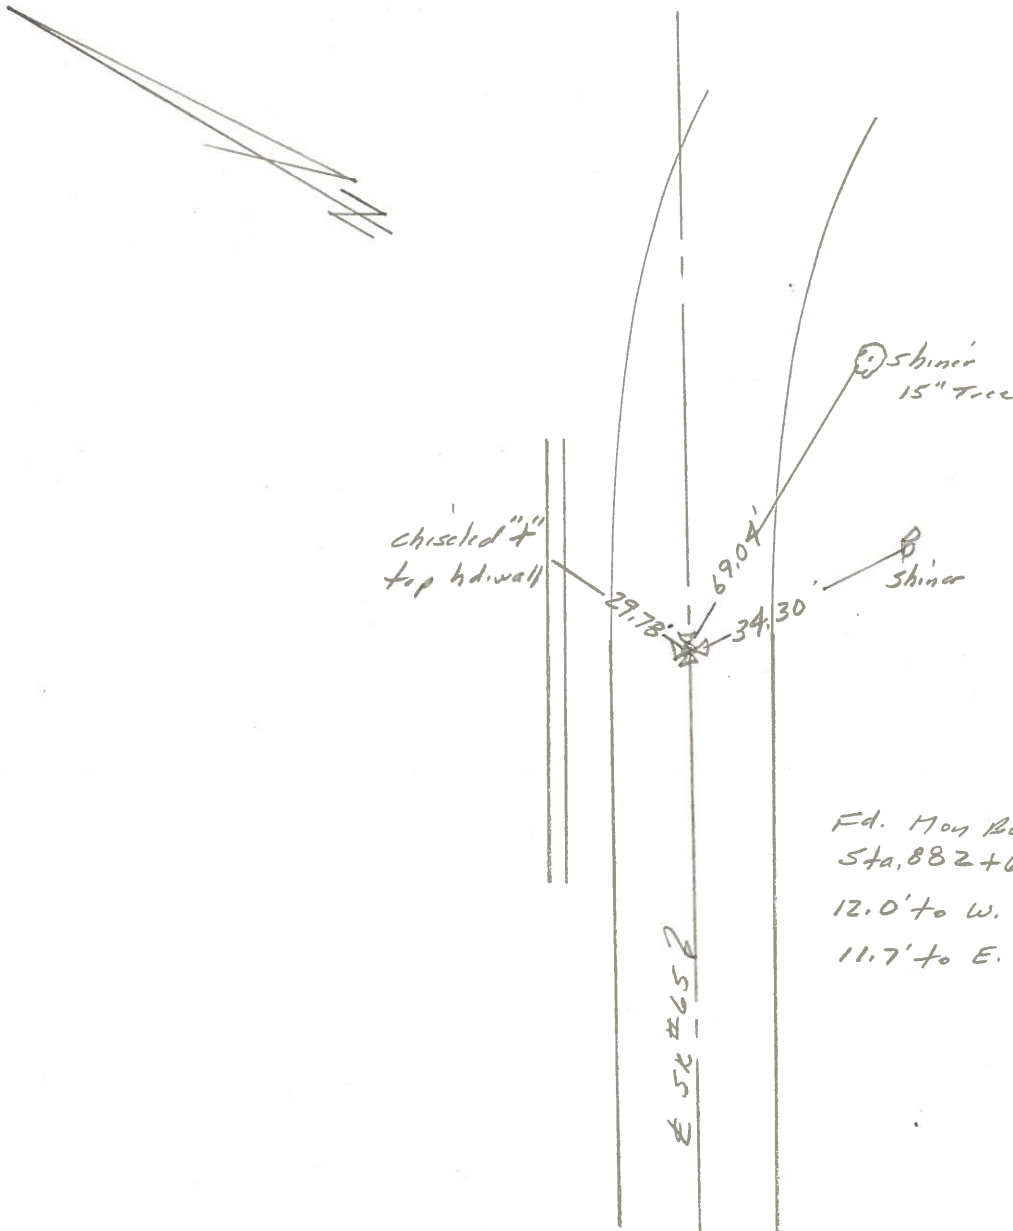

Fd. Man Box To Surface
 Sta. 882+66.24 = T.S.
 12.0' to W. edge put.
 11.7' to E. edge put.